
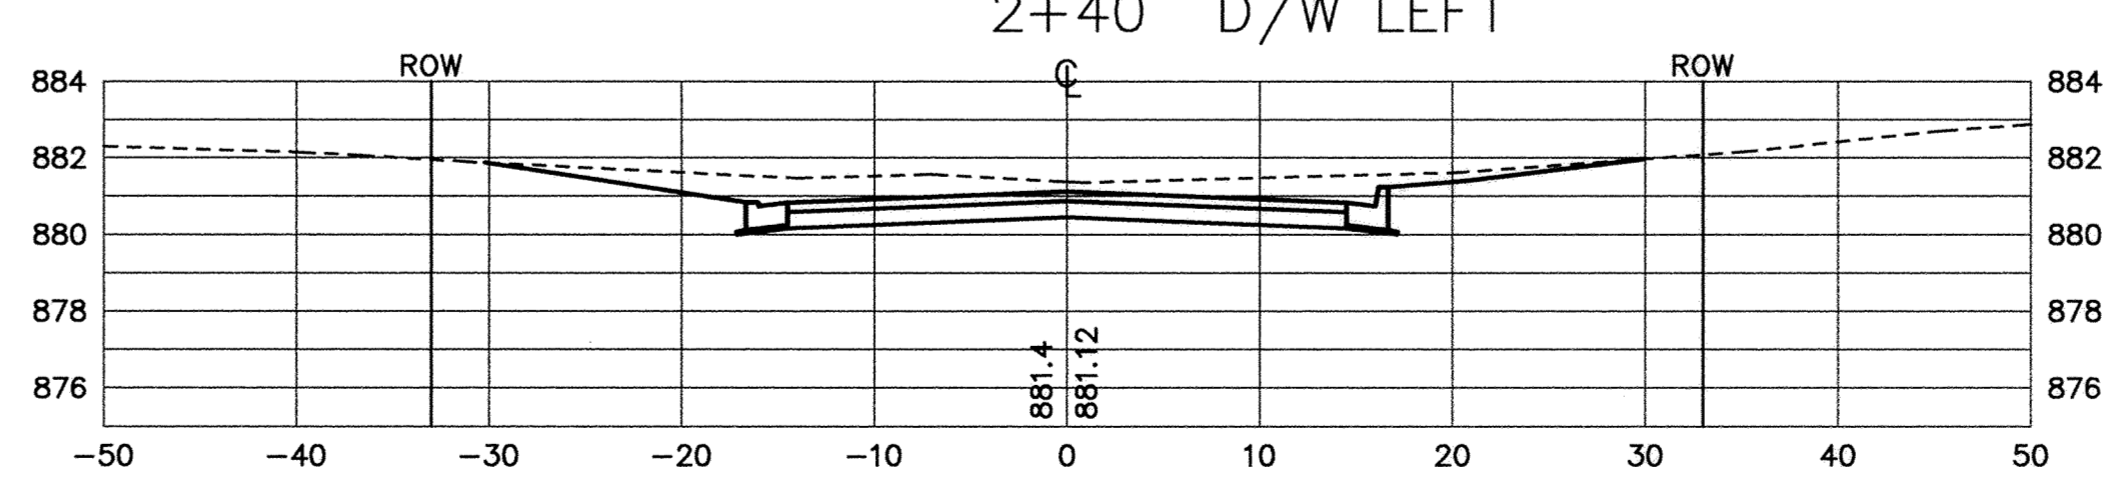
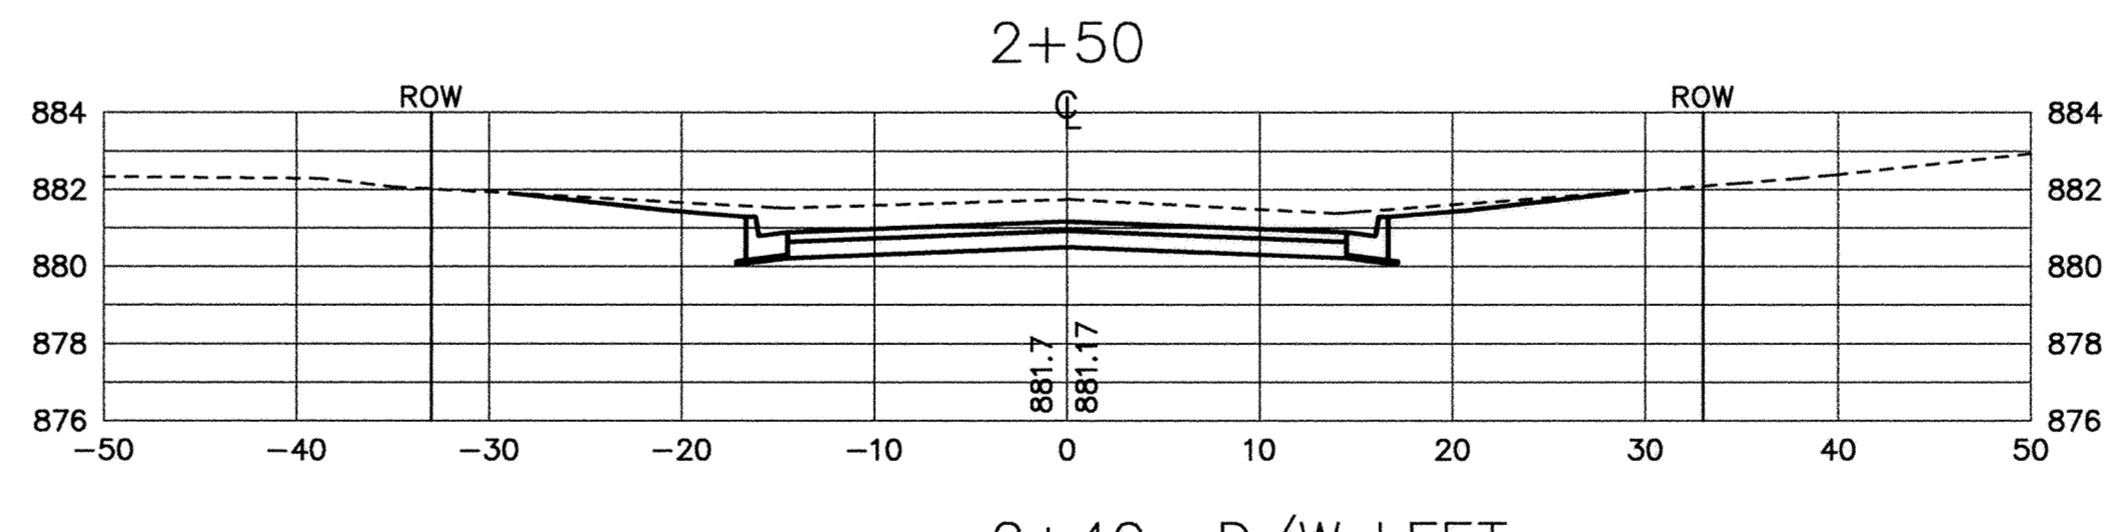
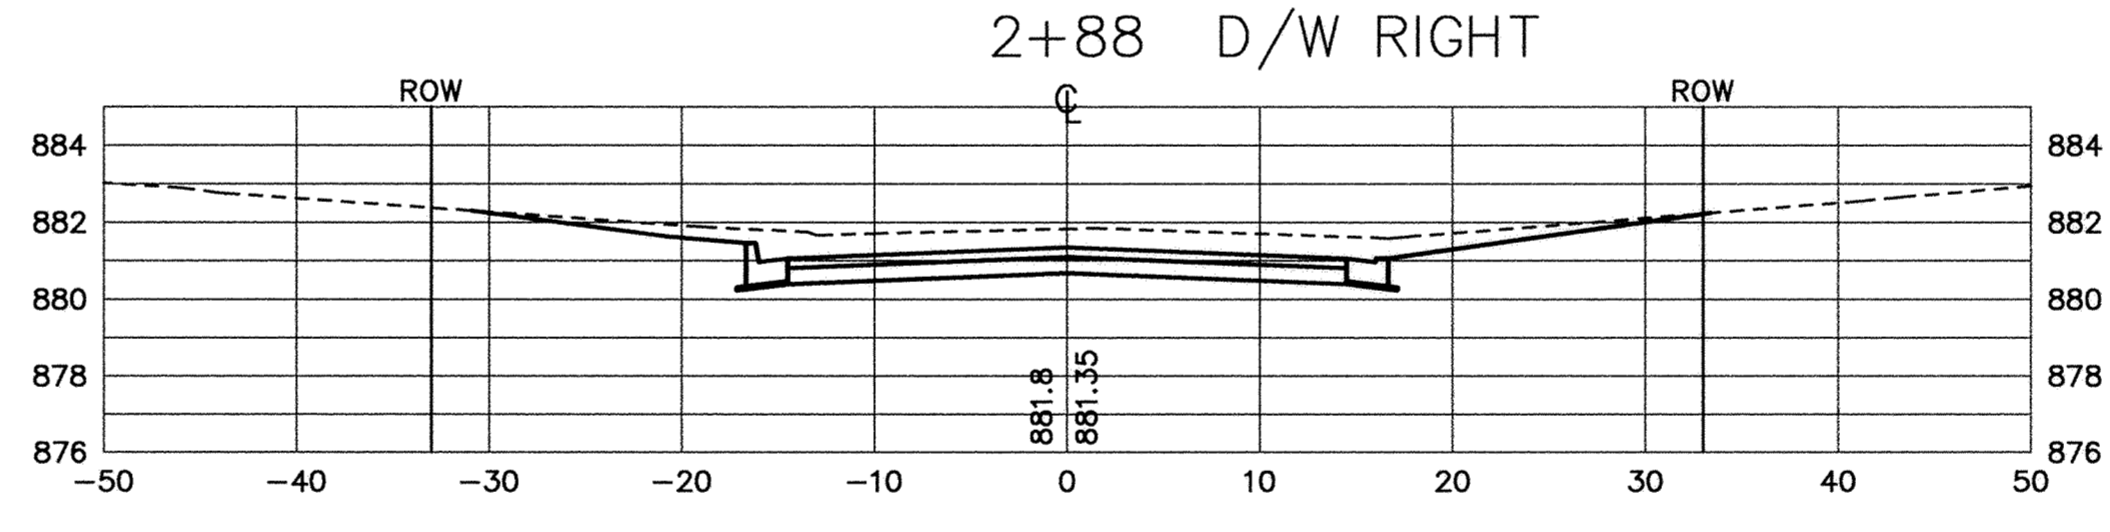
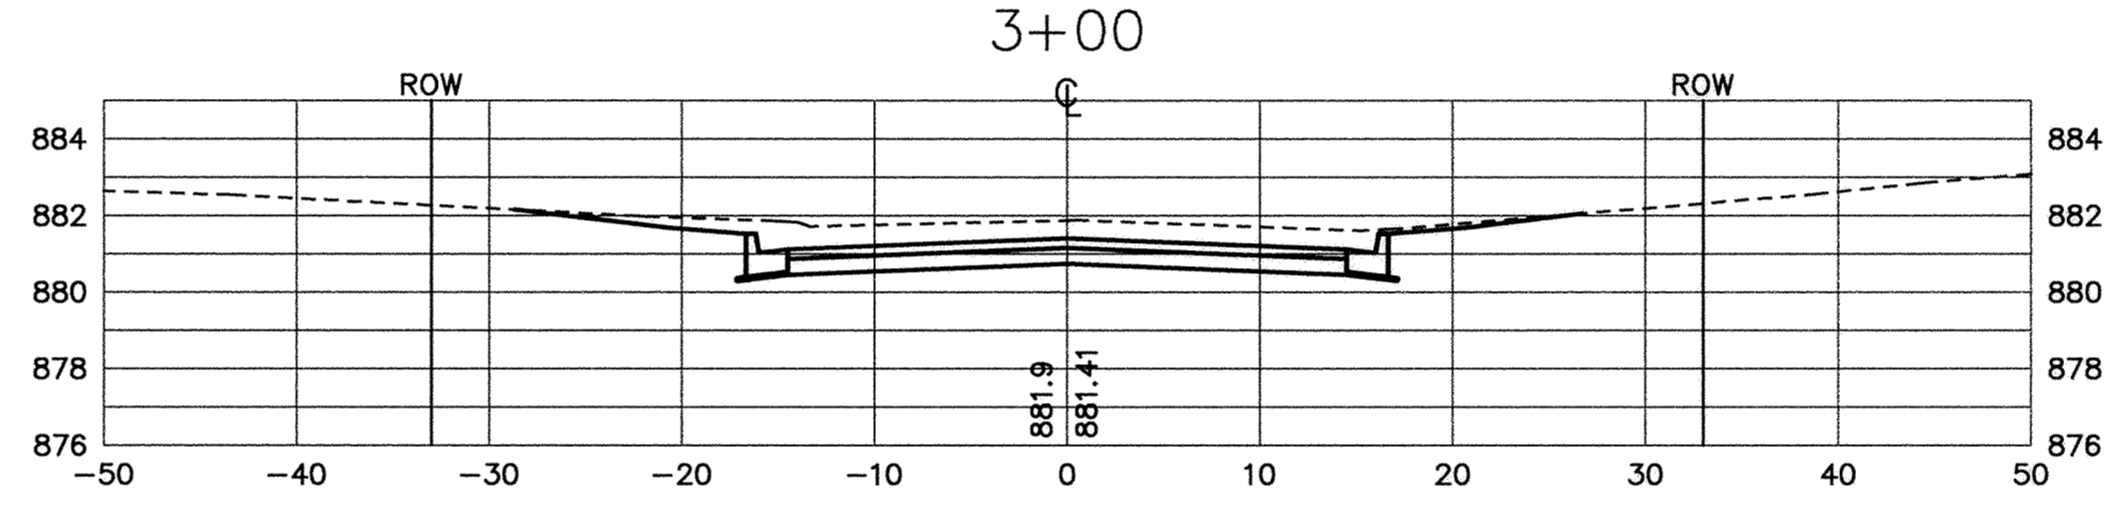
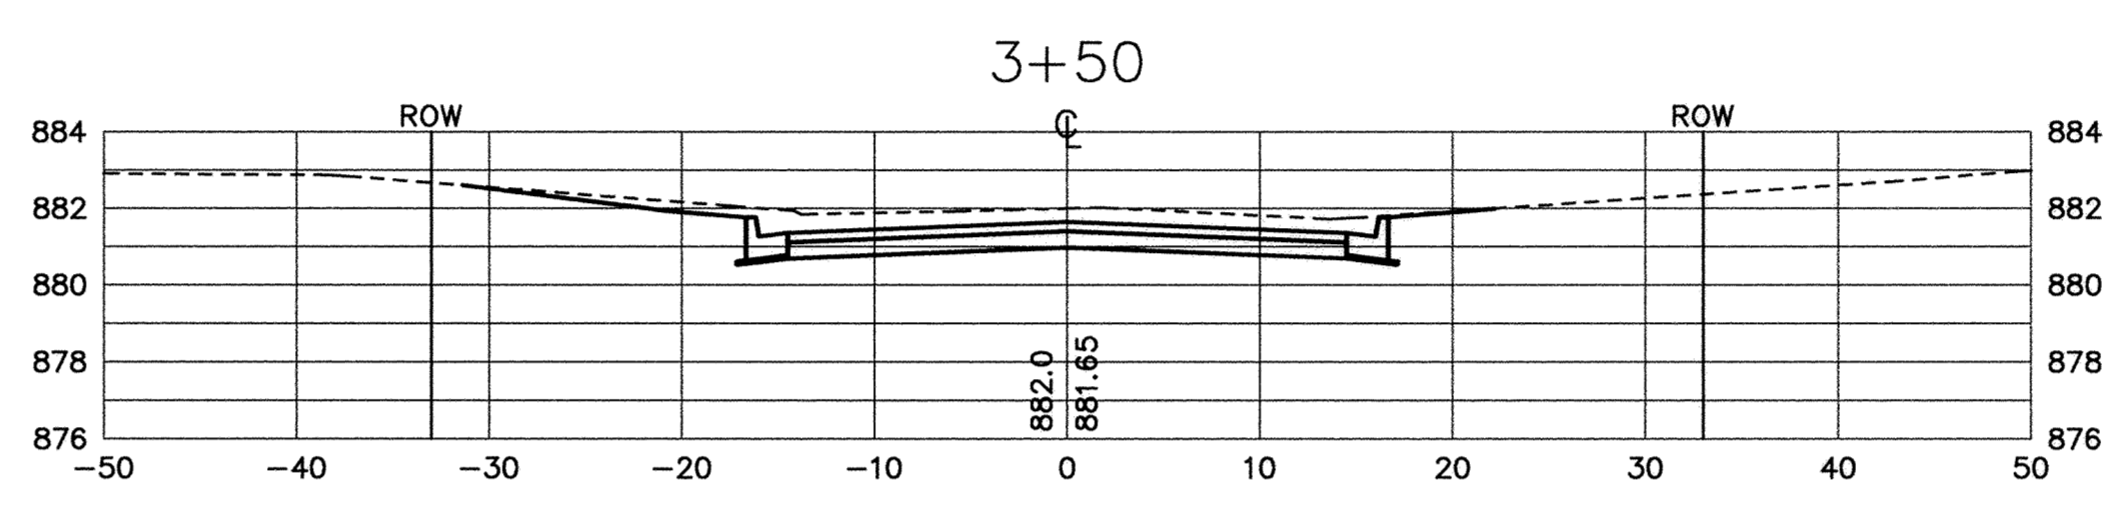
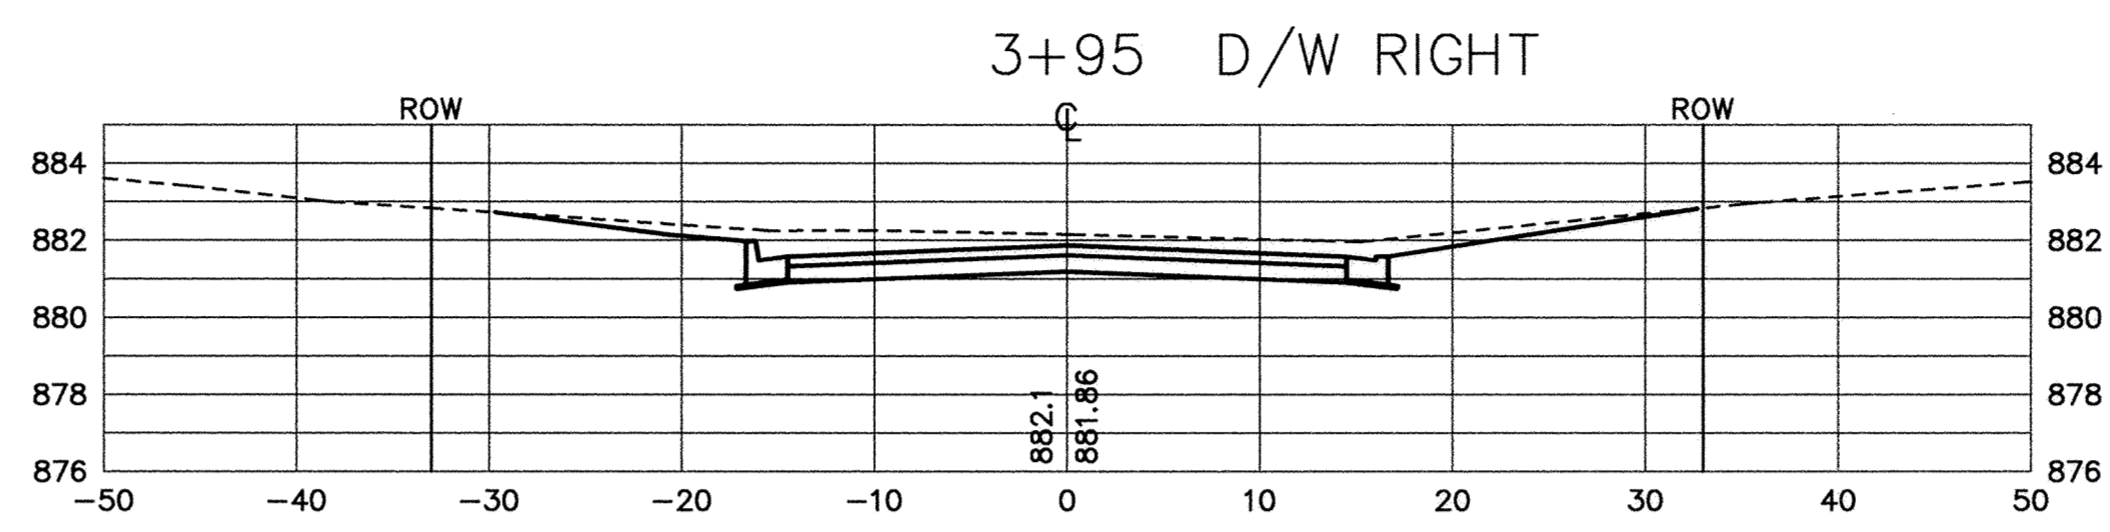
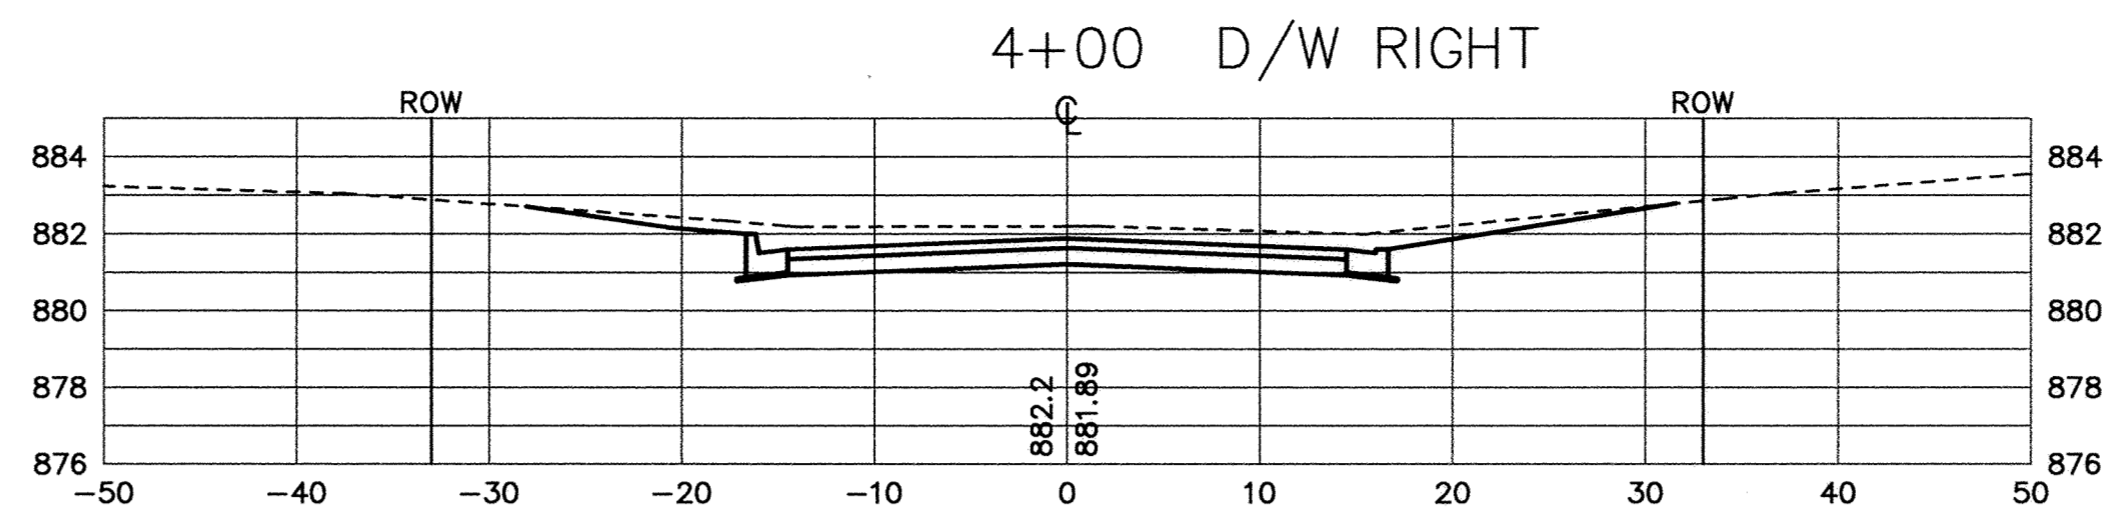
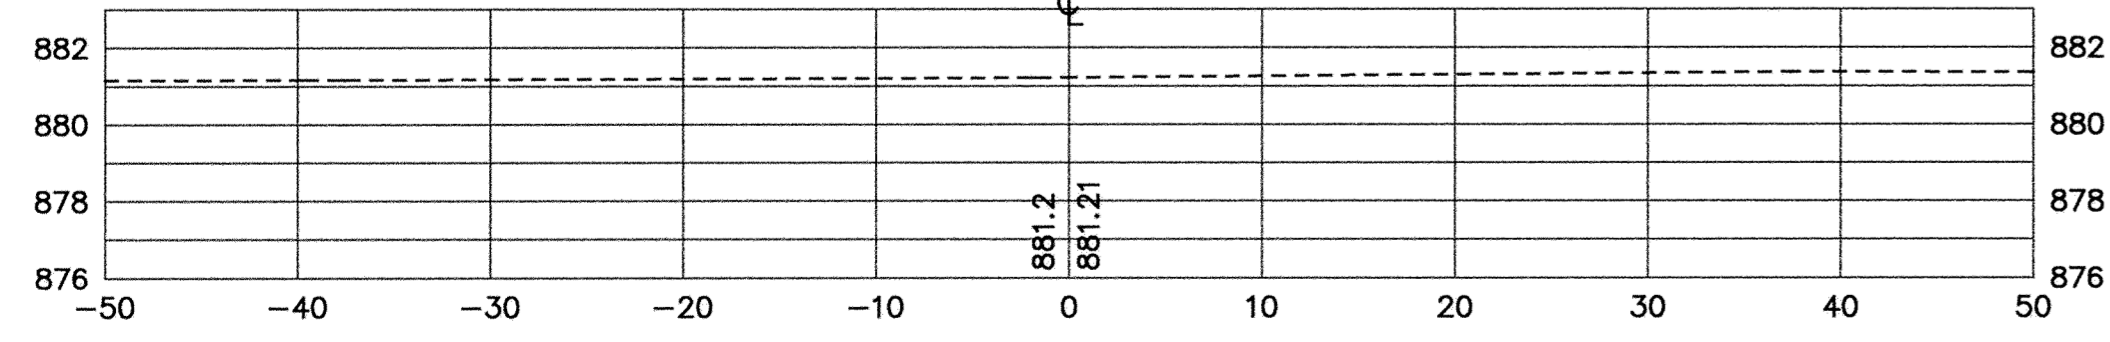
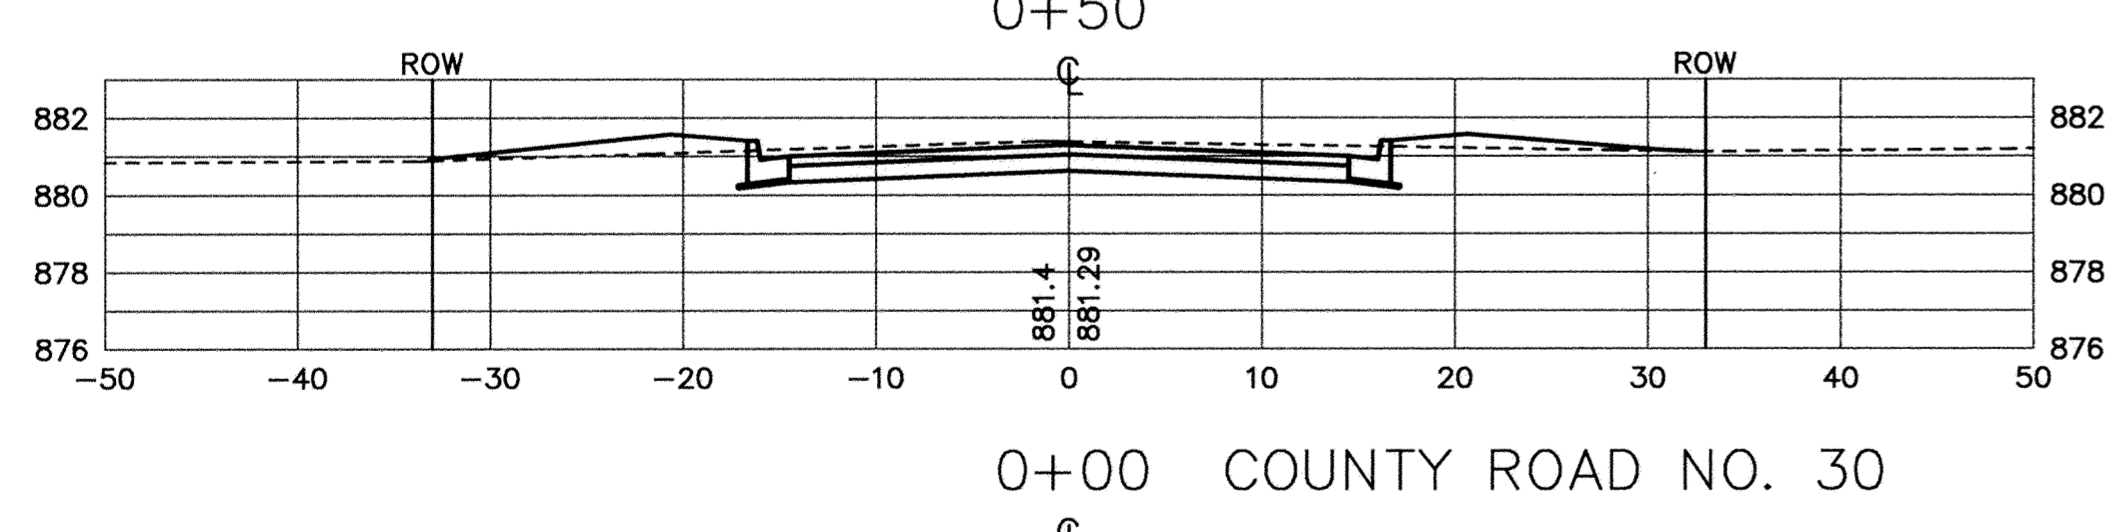
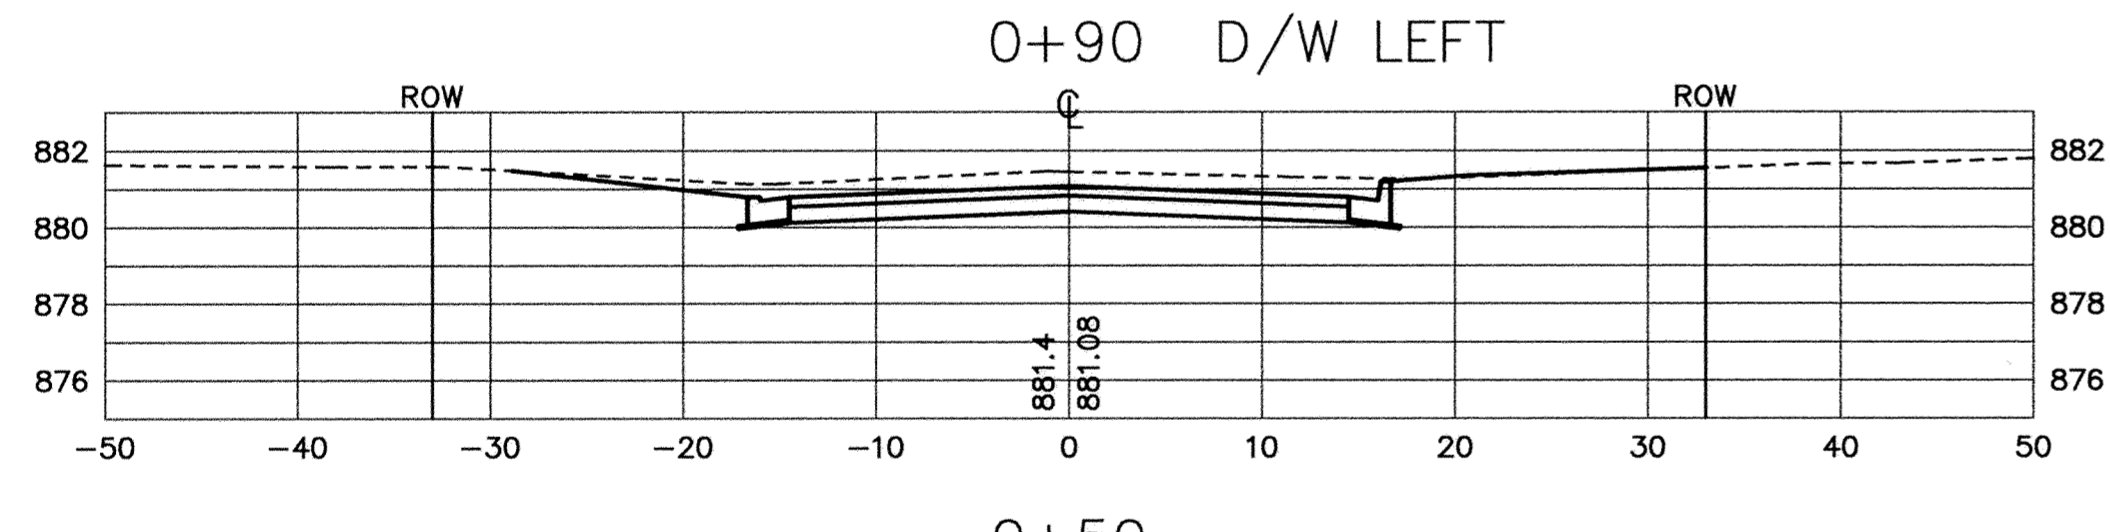
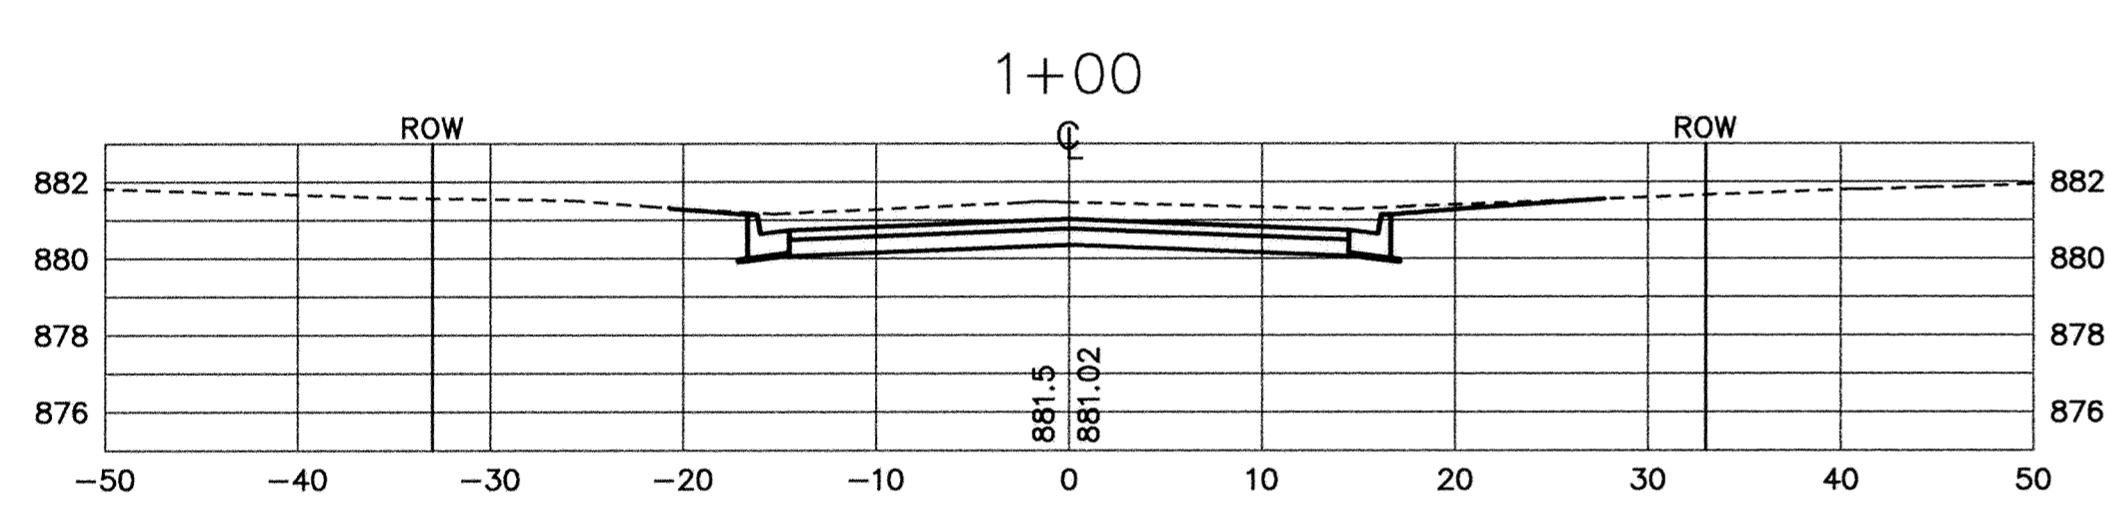
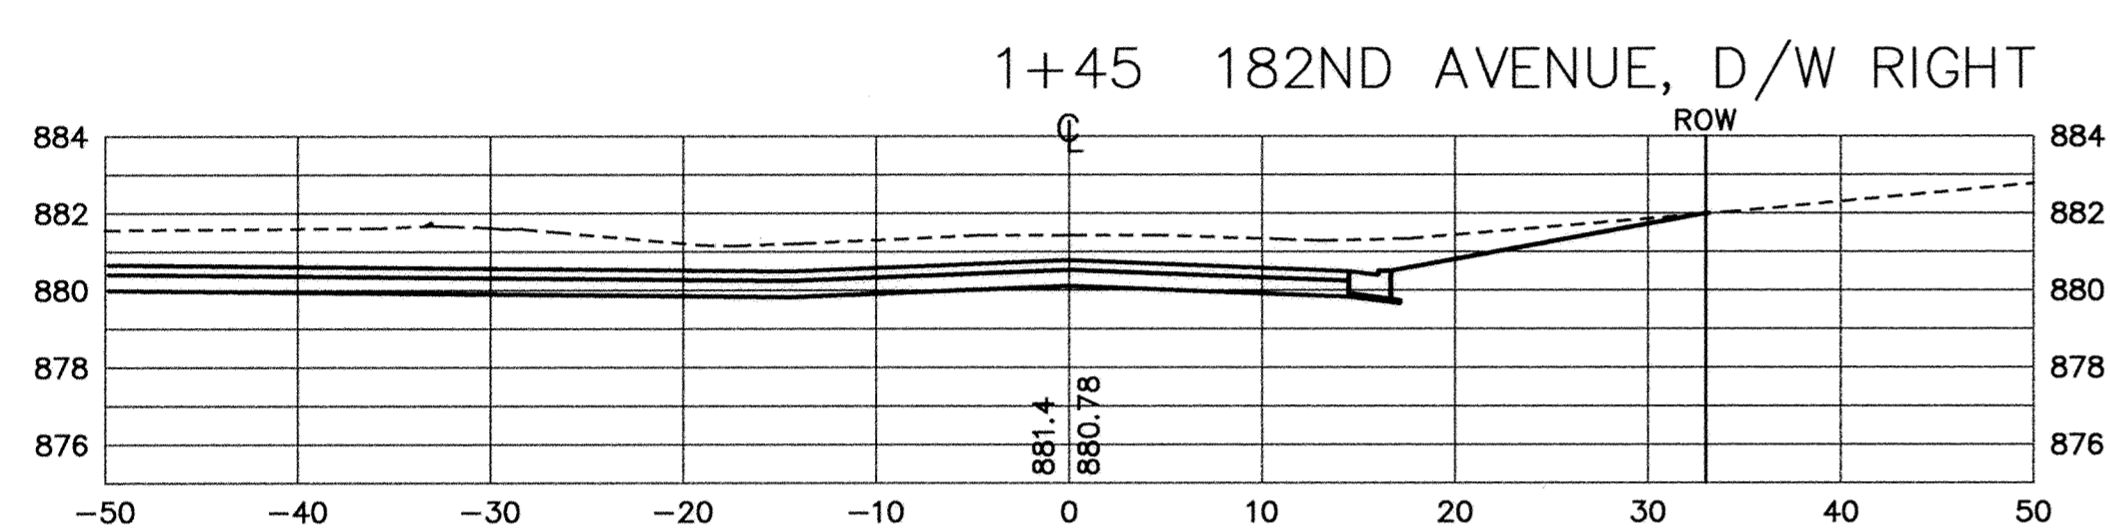
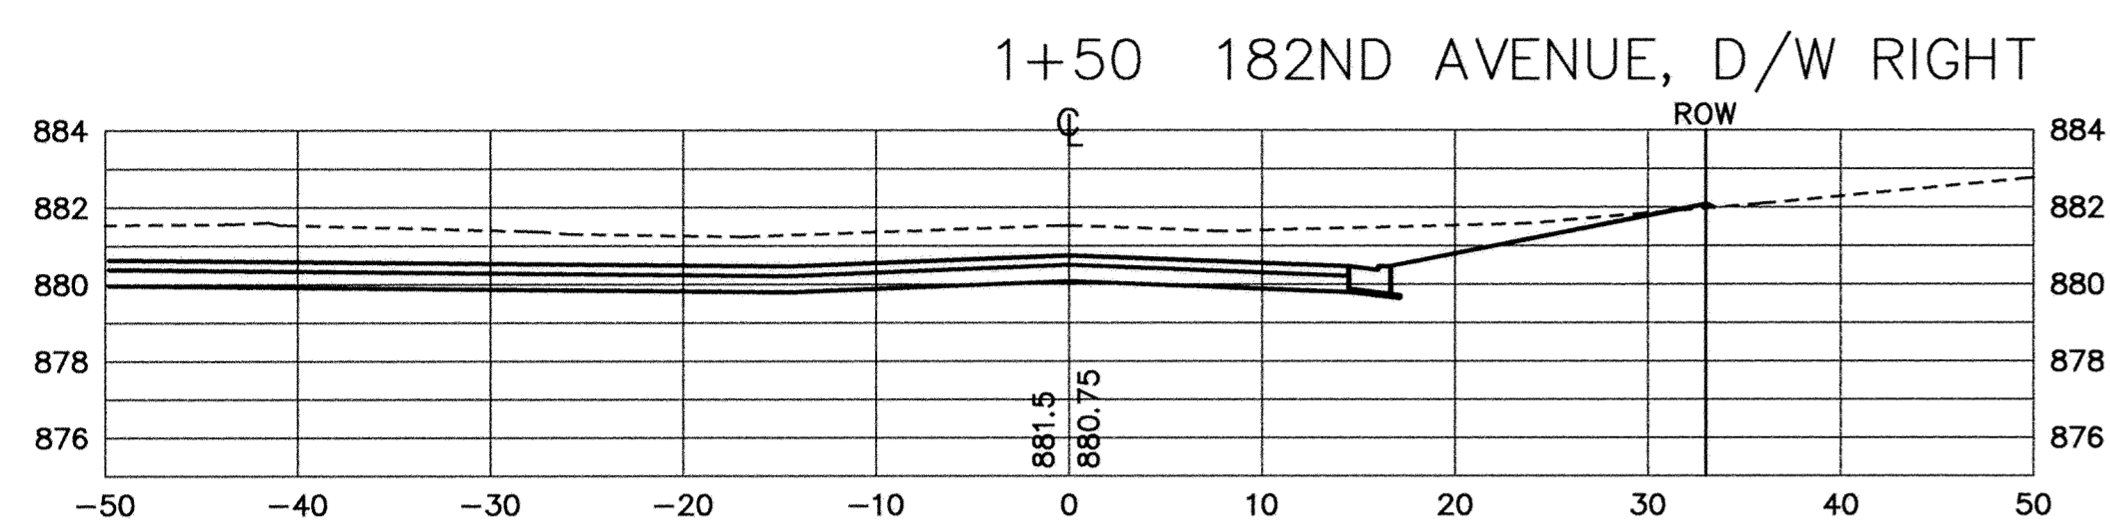


SD PRODUCTS - NEW HOPE, MINNESOTA  
REQUESTED BY: MARTIN NUMBER 0202

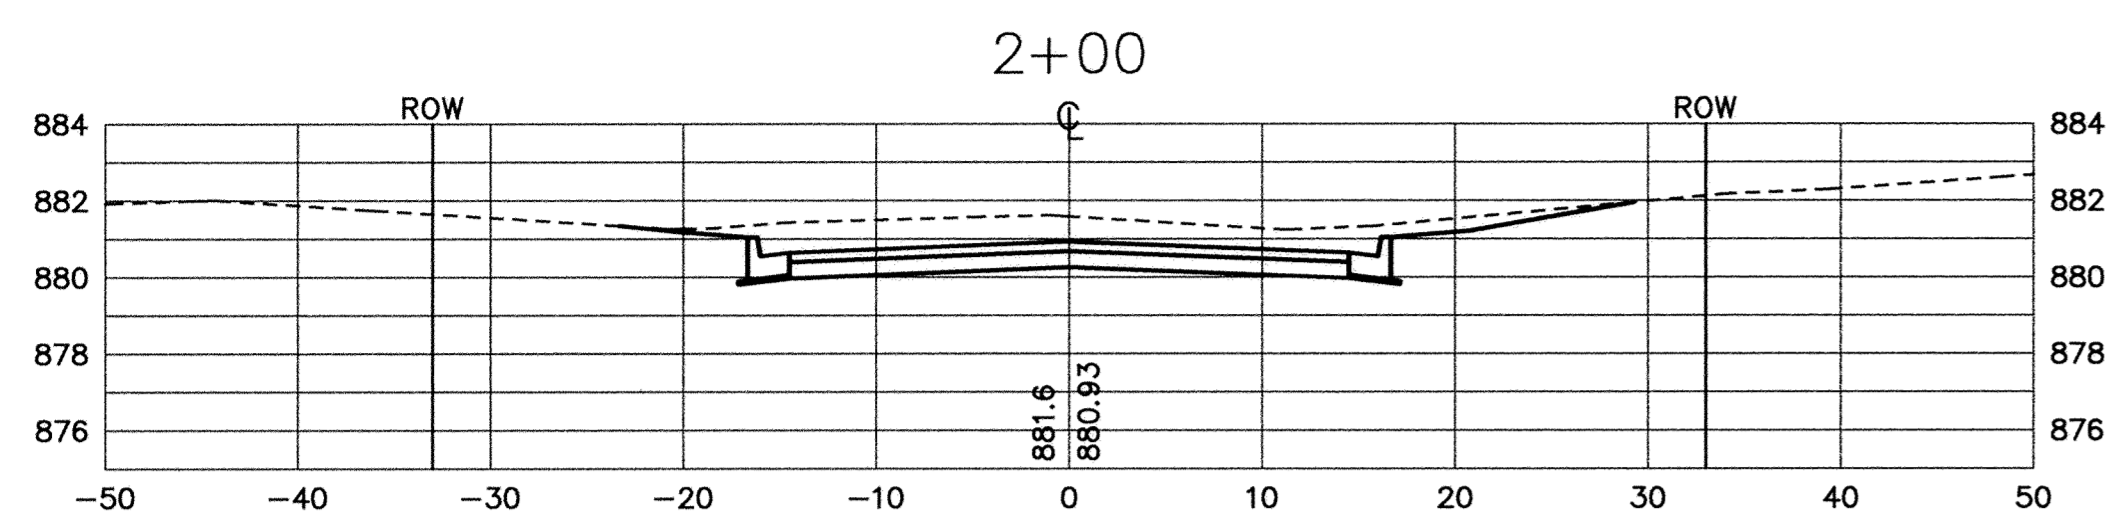


RECORD DRAWING  
OCTOBER 1997

I HEREBY CERTIFY THAT THIS PLAN, SPECIFICATION, OR REPORT WAS PREPARED BY ME OR UNDER MY DIRECT SUPERVISION AND THAT I AM A DULY REGISTERED PROFESSIONAL ENGINEER UNDER THE LAWS OF THE STATE OF MINNESOTA.

*Kevin A. Mauer*

DATE 12/9/96 REG. NO. 15316

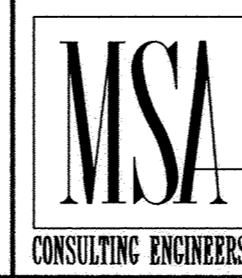

1326 ENERGY PARK DRIVE  
ST. PAUL, MINNESOTA 55108  
(612) 644-4389

REVISIONS	DATE	DESCRIPTION

DESIGNED	SE
CHECKED	RB
DRAWN	RKM
GRAPHIC SCALE	0 10
VERT.	0 5

CITY OF ELK RIVER ORONO LAKE 3RD ADDITION STREET AND UTILITY IMPROVEMENTS DENVER STREET CROSS SECTIONS			0+00 TO 4+00
DATE	NOV. 1996	SHEET 15 OF 31 SHEETS	PROJECT NO. 230-320