
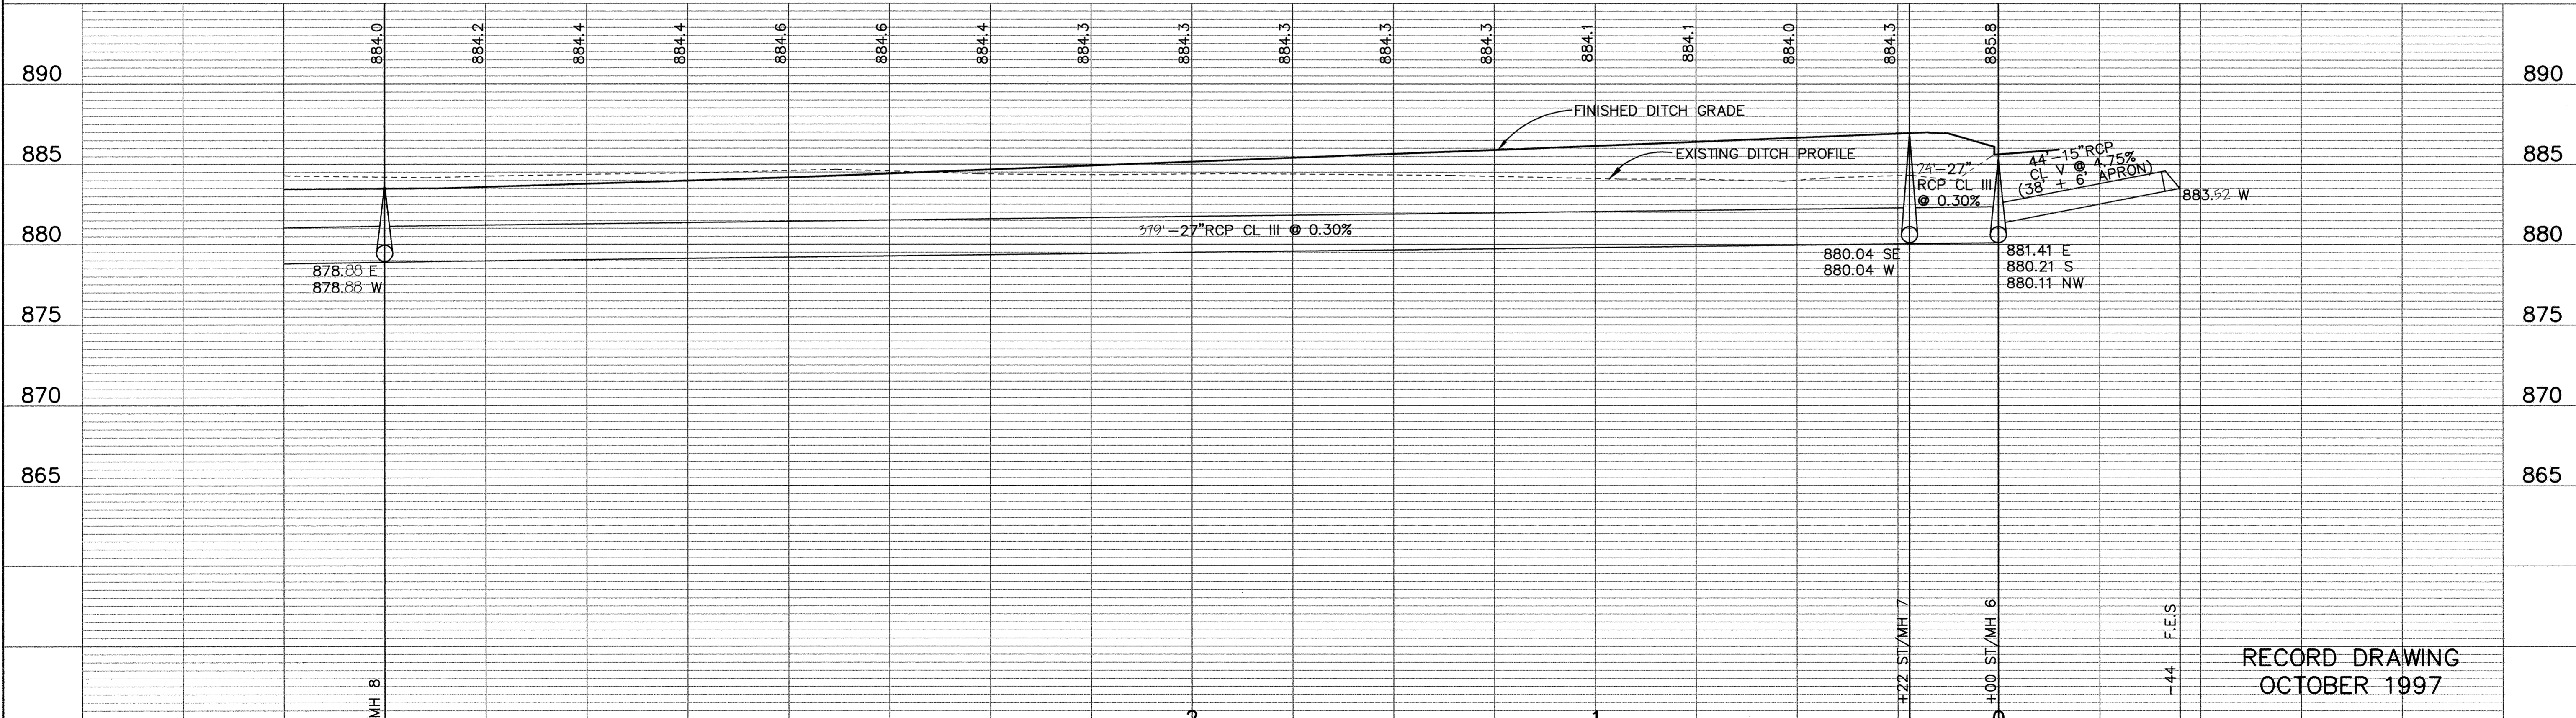


# COUNTY ROAD 30

SEE SHEET 21

SEE SHEET 17

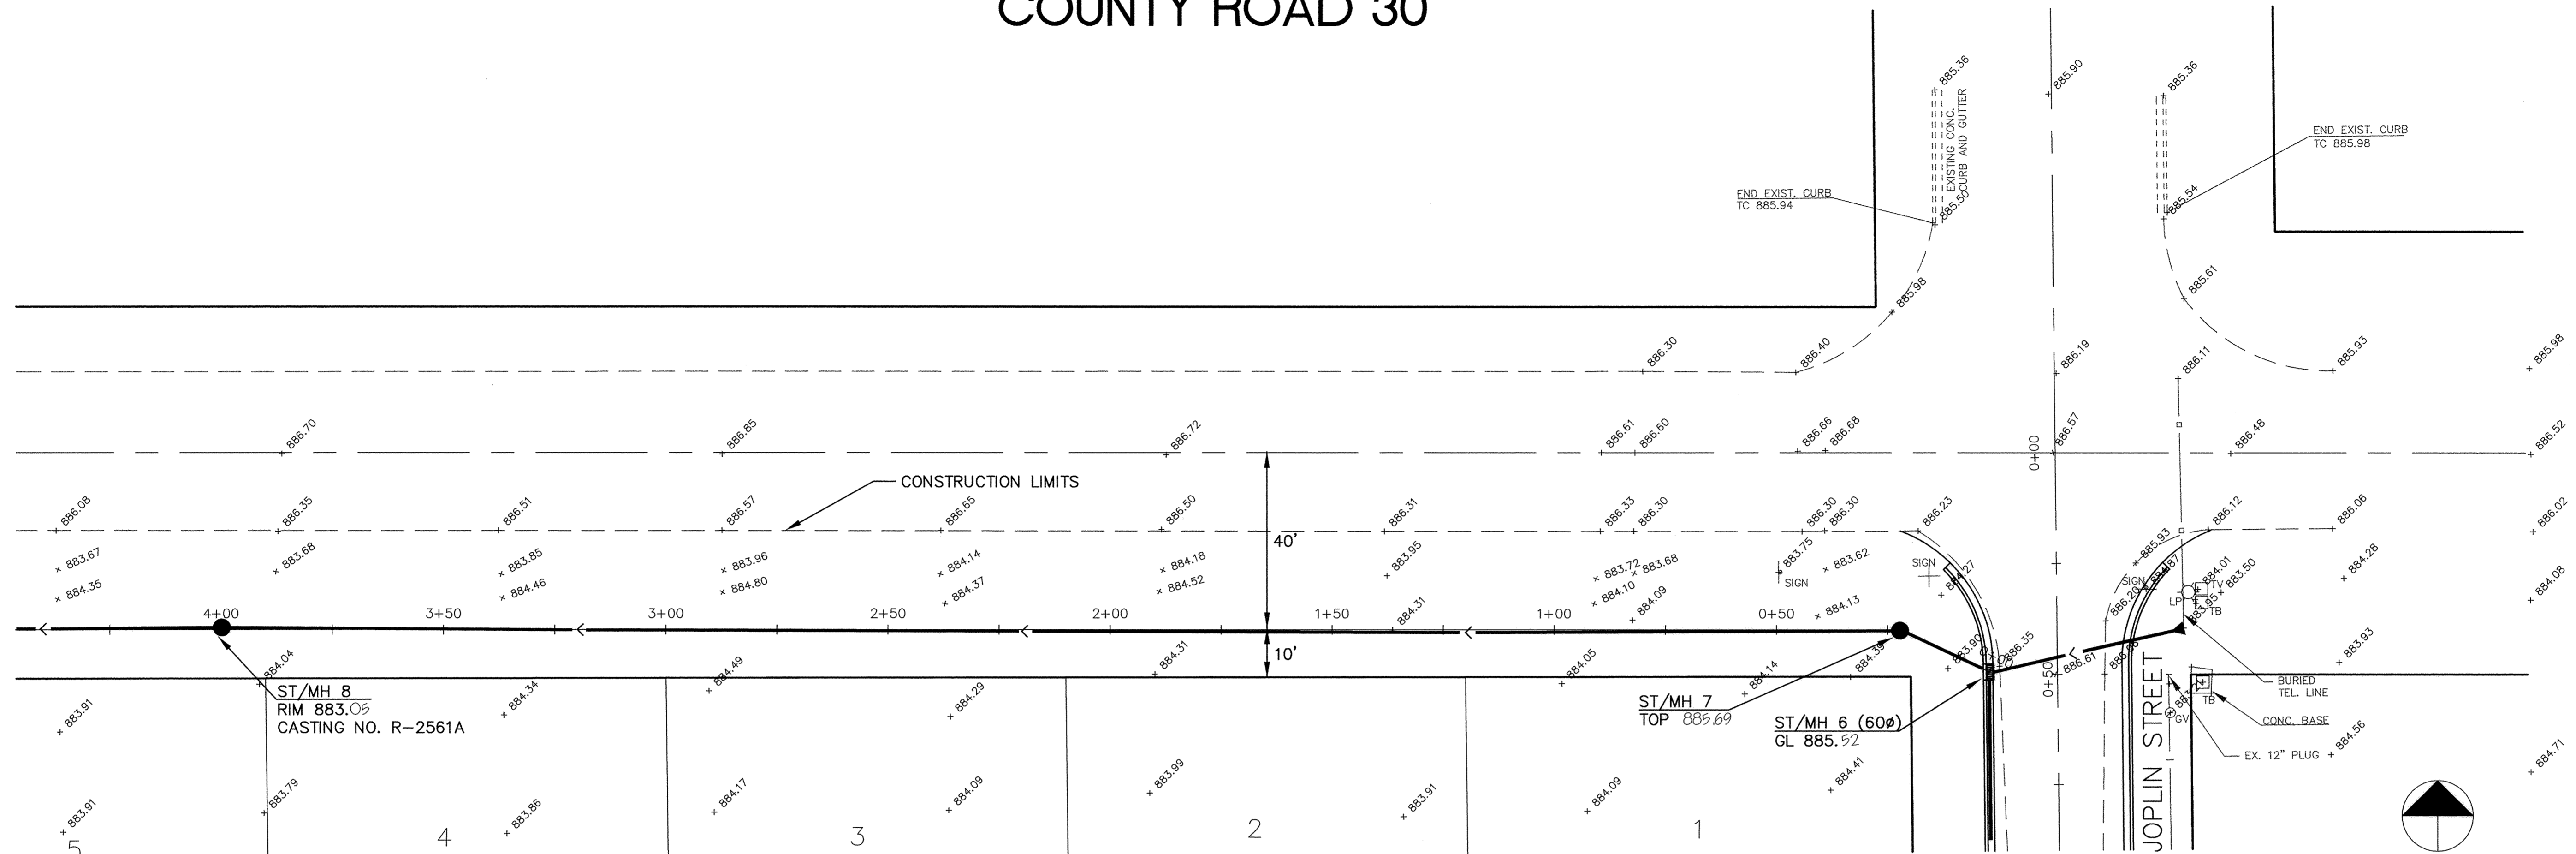

STATION	ELEVATION
4+00	884.0
3+50	884.2
3+00	884.4
2+50	884.4
2+00	884.6
1+50	884.6
1+00	884.4
0+50	884.3
0+00	884.3
0+00	884.3
0+00	884.1
0+00	884.1
0+00	884.0
0+00	884.3
0+00	885.8

I HEREBY CERTIFY THAT THIS PLAN, SPECIFICATION, OR REPORT WAS PREPARED BY ME OR UNDER MY DIRECT SUPERVISION AND THAT I AM A DULY REGISTERED PROFESSIONAL ENGINEER UNDER THE LAWS OF THE STATE OF MINNESOTA.

*Kevin J. Mauer*  
DATE 12/1/94 REG. NO. 15316

1326 ENERGY PARK DRIVE  
ST. PAUL, MINNESOTA 55108  
(612) 644-4389

REVISIONS	DATE	DESCRIPTION

DESIGNED	SEF
CHECKED	
DRAWN	RKM

GRAPHIC SCALE  
0 5 10 20  
VERT. 5

**RECORD DRAWING  
OCTOBER 1997**

DATE NOV. 1996 SHEET 20 OF 31 SHEETS PROJECT NO. 230-340

0+00 TO 4+00

DRAWING NUMBER ORON03.96 20