
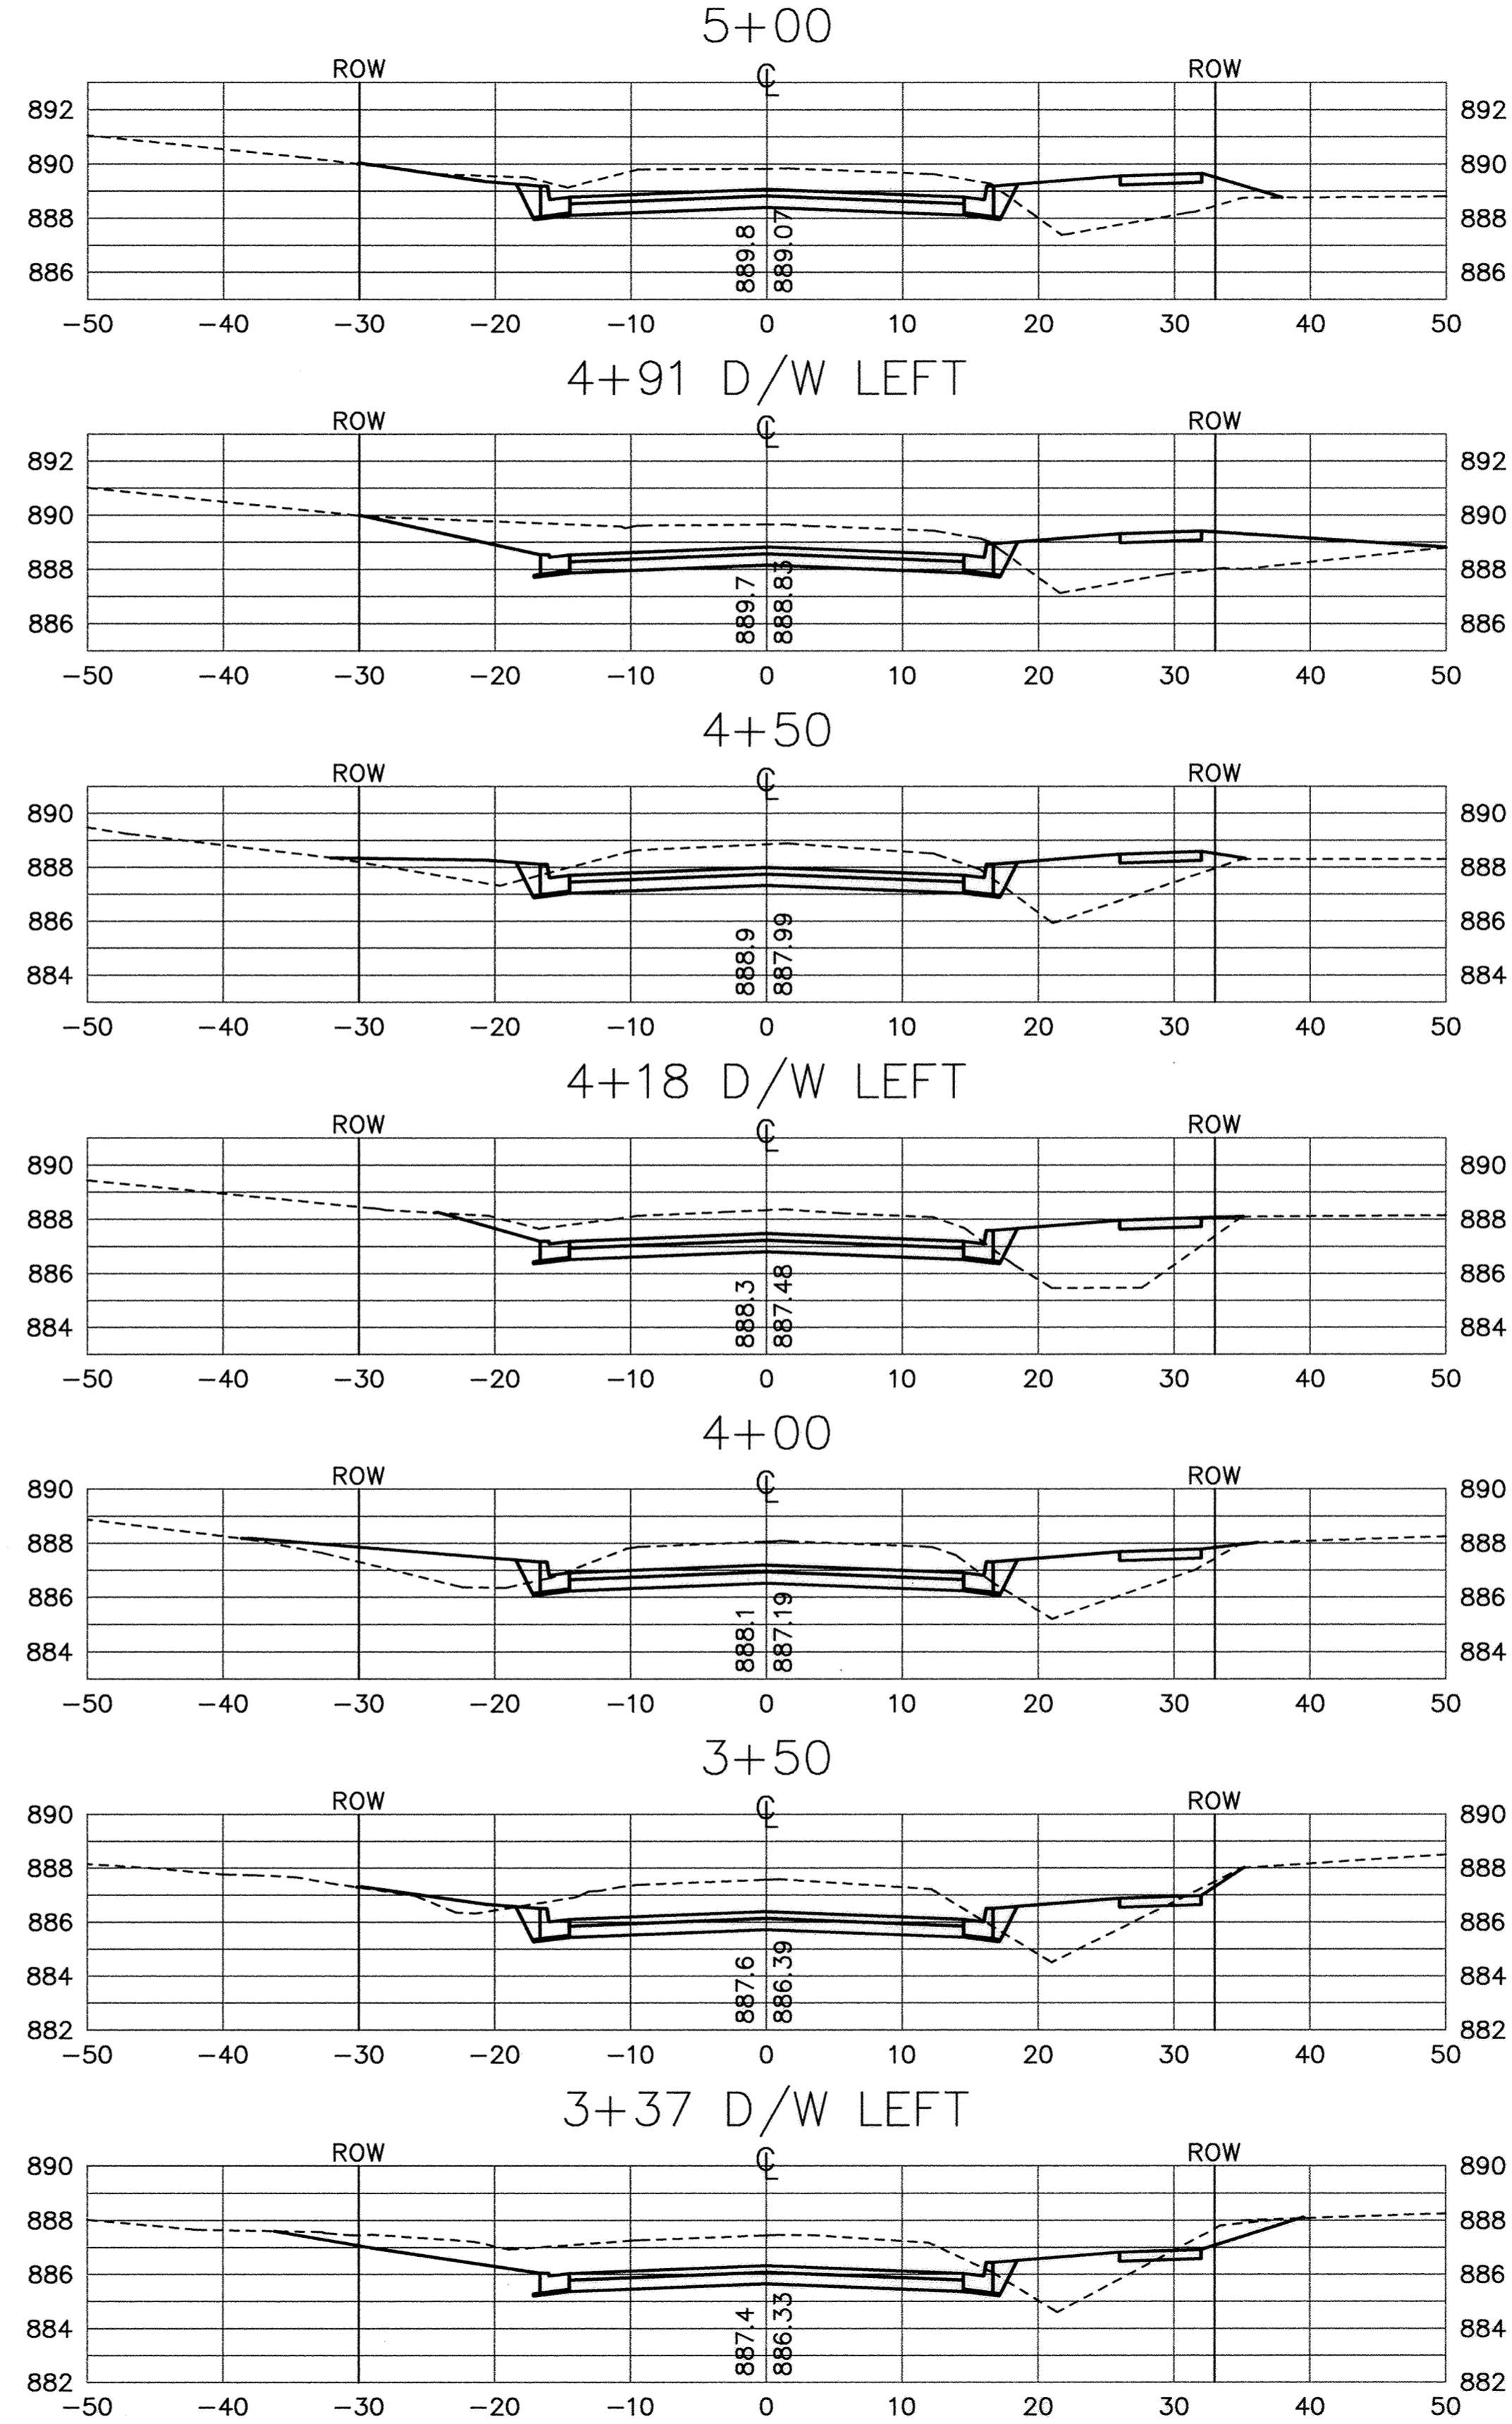


SAECO PRODUCTS - NEW HOPE, MINNESOTA
REQUESTED BY PART NUMBER 0350
SAECO PRODUCTS - NEW HOPE, MINNESOTA
REQUESTED BY PART NUMBER 0350
SAECO PRODUCTS - NEW HOPE, MINNESOTA
REQUESTED BY PART NUMBER 0350
SAECO PRODUCTS - NEW HOPE, MINNESOTA
REQUESTED BY PART NUMBER 0350

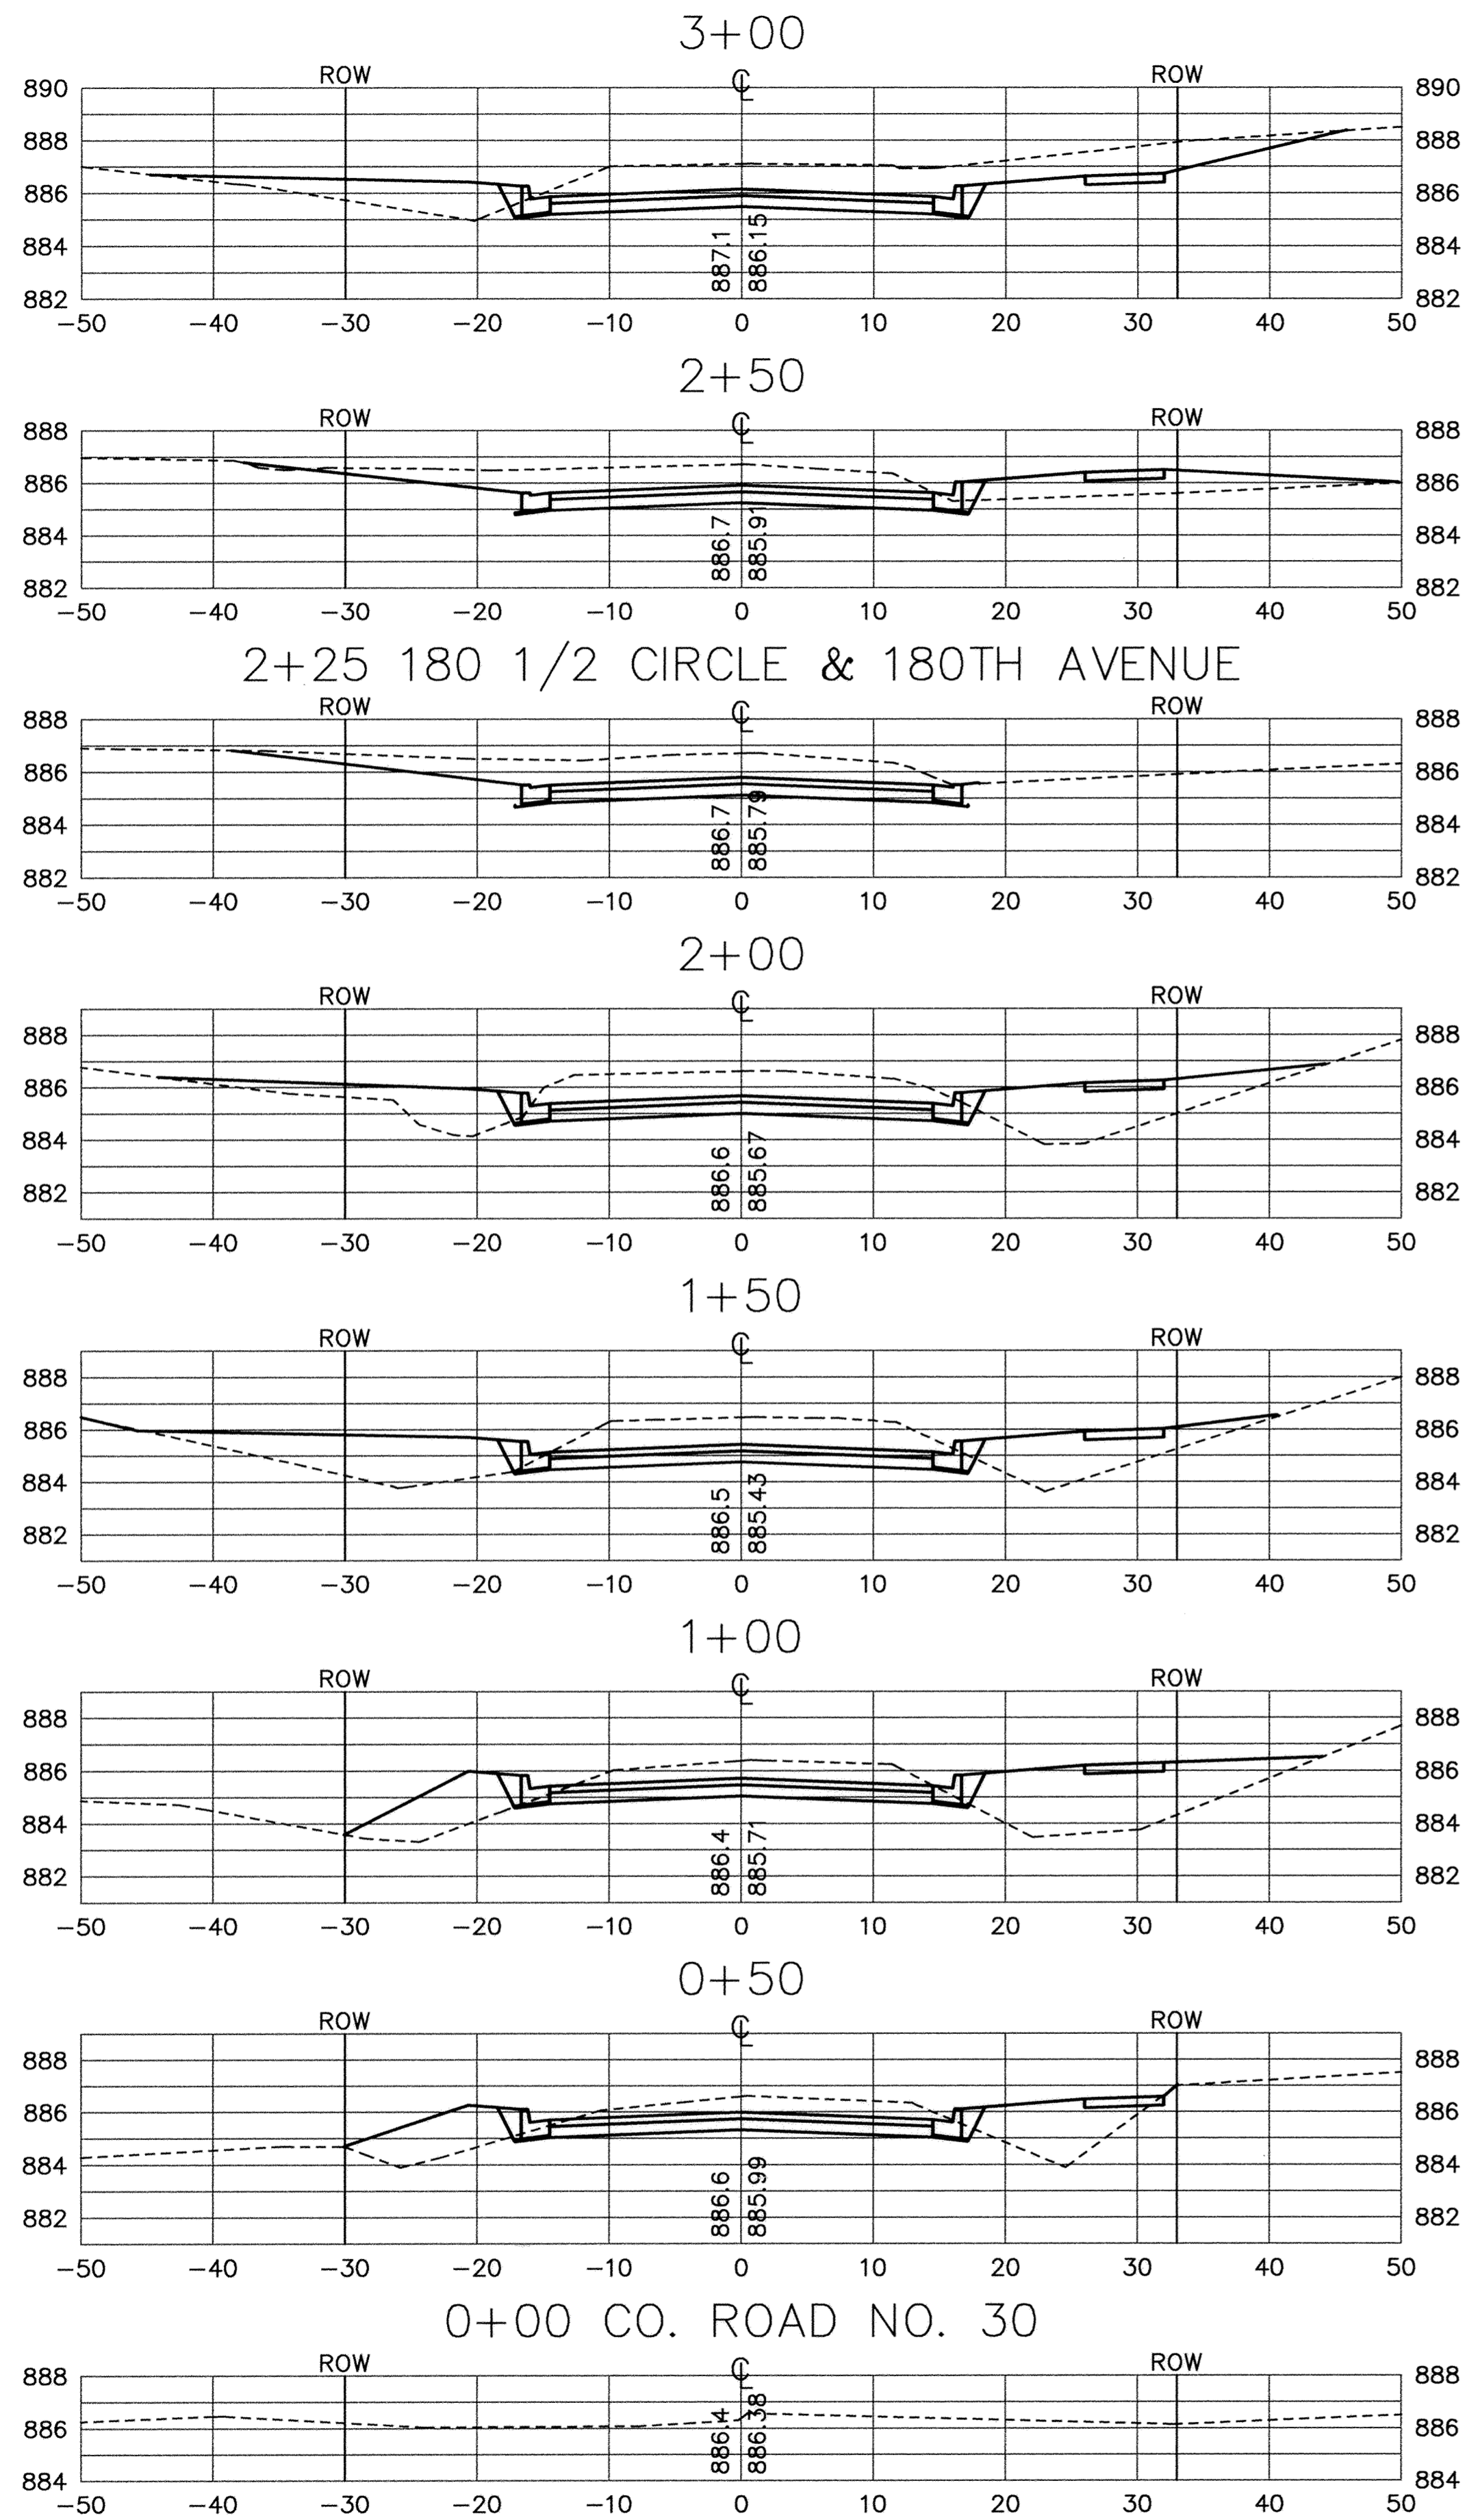

RECORD DRAWING
OCTOBER 1997

I HEREBY CERTIFY THAT THIS PLAN, SPECIFICATION, OR REPORT WAS PREPARED BY ME OR UNDER MY DIRECT SUPERVISION AND THAT I AM A DULY REGISTERED PROFESSIONAL ENGINEER UNDER THE LAWS OF THE STATE OF MINNESOTA.

DATE 12/9/96 REG. NO. 15316

MSA
CONSULTING ENGINEERS

1326 ENERGY PARK DRIVE
ST. PAUL, MINNESOTA 55108
(612) 644-4389

REVISIONS	DATE	DESCRIPTION	DESIGNED	SEE

CHECKED RKM
DRAWN RKM

GRAPHIC SCALE
0 10
VERT. 5

CITY OF ELK RIVER
STREET AND UTILITY IMPROVEMENTS
JOPLIN STREET
CROSS SECTIONS
0+00 TO 5+00

DATE NOV. 1996 SHEET 22 OF 31 SHEETS PROJECT NO. 230-340