


RECORD DRAWING  
OCTOBER 1997

I HEREBY CERTIFY THAT THIS PLAN, SPECIFICATION, OR REPORT WAS PREPARED BY ME OR UNDER MY DIRECT SUPERVISION AND THAT I AM A DULY REGISTERED PROFESSIONAL ENGINEER UNDER THE LAWS OF THE STATE OF MINNESOTA.  
*Larry J. Meurer*  
DATE 12/9/96 REG. NO. 15316

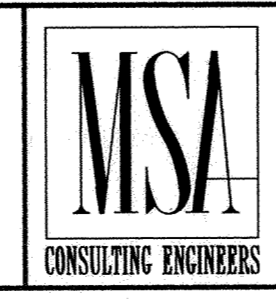

1326 ENERGY PARK DRIVE  
ST. PAUL, MINNESOTA 55108  
(612) 644-4389

REVISIONS	DATE	DESCRIPTION	DESIGNED	SEE

CHECKED RB  
DRAWN RKM  
GRAPHIC SCALE  
0 20  
VERT. 5

CITY OF ELK RIVER STREET IMPROVEMENTS LOWELL AVENUE CROSS SECTIONS		
DATE <u>NOV. 1996</u>	SHEET <u>26</u> OF <u>31</u> SHEETS	PROJECT NO. <u>230-331</u>
0+00 TO 3+75		