


STATION	AREAS Square Feet		VOLUMES Cubic Yards		CUMULATIVE VOLUMES Cubic Yards	
	CUT	FILL	CUT	FILL	CUT	FILL
0+00	0.00	0.00	43.77	0.90	43.77	0.90
0+50	47.27	0.97	102.63	2.31	146.40	3.21
1+00	63.57	1.53	116.64	1.77	263.05	4.98
1+50	62.40	0.39	48.26	0.23	311.30	5.21
1+70	67.89	0.23	67.33	0.36	378.64	5.58
2+00	53.31	0.43	49.30	0.56	427.94	6.13
2+25	53.18	0.77	44.56	1.69	472.50	7.83
2+50	43.07	2.89	68.58	8.64	541.08	16.47
3+00	30.99	6.45	21.11	4.30	562.18	20.77
3+20	26.00	5.16	23.83	8.36	586.02	29.13
3+50	16.90	9.89	13.62	8.17	599.64	37.30
3+75	12.51	7.76	13.30	9.73	612.93	47.03
4+00	16.20	13.26	55.02	14.39	667.95	61.42
4+50	43.21	2.28	25.77	1.36	693.72	62.78
4+82.21	0.00	0.00	0.00	0.00	693.72	62.78



RECORD DRAWING
OCTOBER 1997

I HEREBY CERTIFY THAT THIS PLAN, SPECIFICATION, OR REPORT WAS PREPARED BY ME OR UNDER MY DIRECT SUPERVISION AND THAT I AM A DULY REGISTERED PROFESSIONAL ENGINEER UNDER THE LAWS OF THE STATE OF MINNESOTA.
Lenny J. Maurer
DATE 12/9/96 REG. NO. 15316

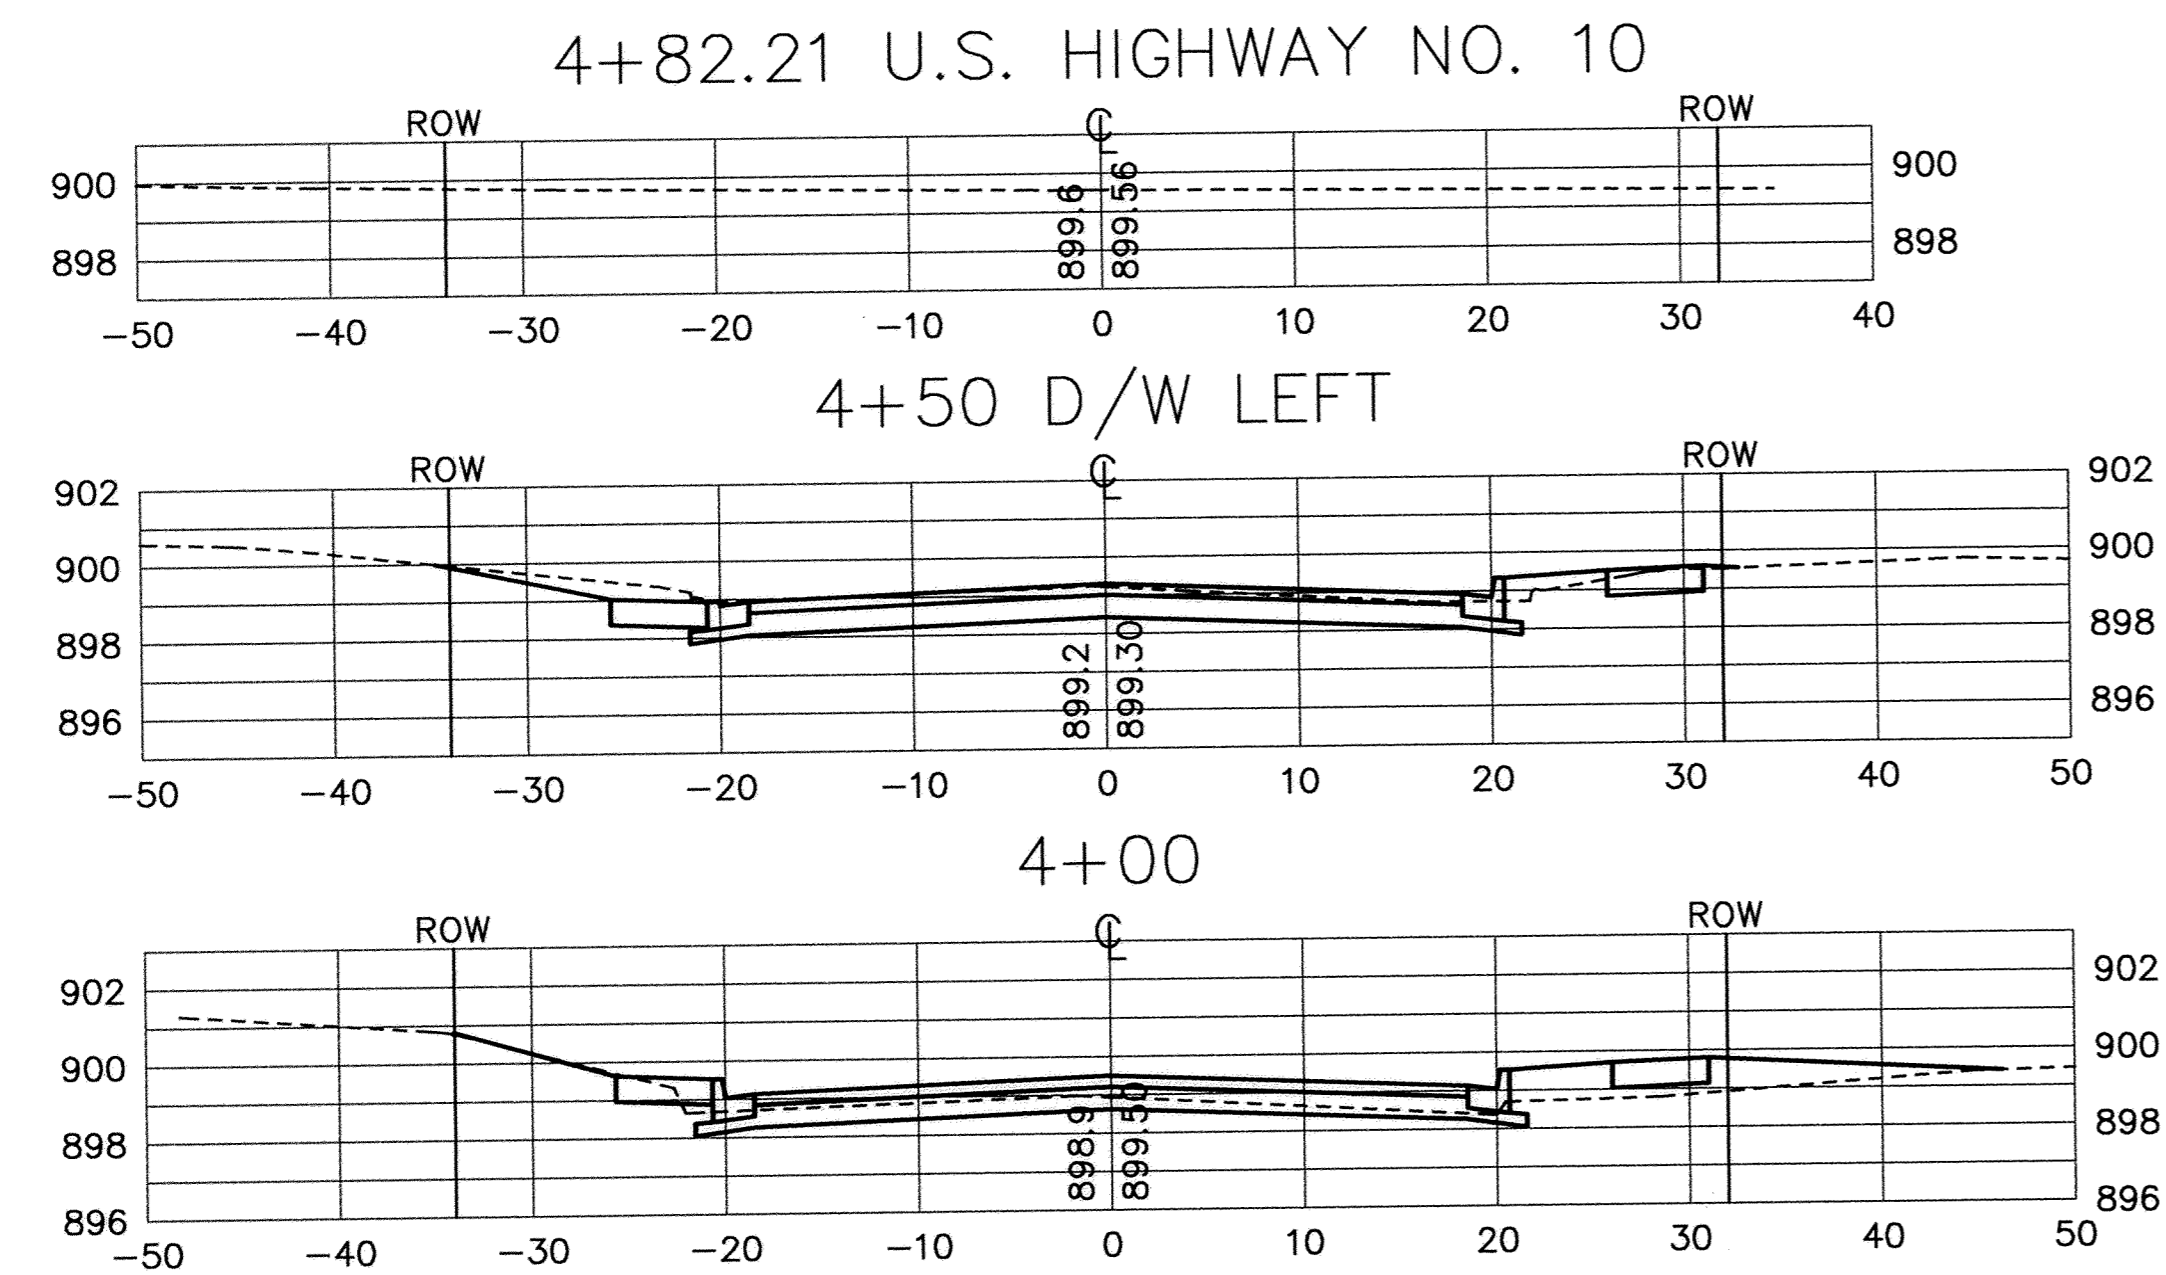

1326 ENERGY PARK DRIVE
ST. PAUL, MINNESOTA 55108
(612) 644-4389

REVISIONS	DATE	DESCRIPTION	DESIGNED	SEF
			CHECKED	PB
			DRAWN	RKM
			GRAPHIC SCALE	
			0 20	
			0 VERT. 5	

CITY OF ELK RIVER STREET IMPROVEMENTS LOWELL AVENUE CROSS SECTIONS				4+00 TO 4+82.21
DATE	NOV. 1996	SHEET	27 OF 31 SHEETS	PROJECT NO. 230-331