




SARGO PRODUCTS • NEW HOPE, MINNESOTA
REFER TO DRAW NUMBER 808
SARGO PRODUCTS • NEW HOPE, MINNESOTA
REFER TO DRAW NUMBER 808
SARGO PRODUCTS • NEW HOPE, MINNESOTA
REFER TO DRAW NUMBER 808
SARGO PRODUCTS • NEW HOPE, MINNESOTA
REFER TO DRAW NUMBER 808

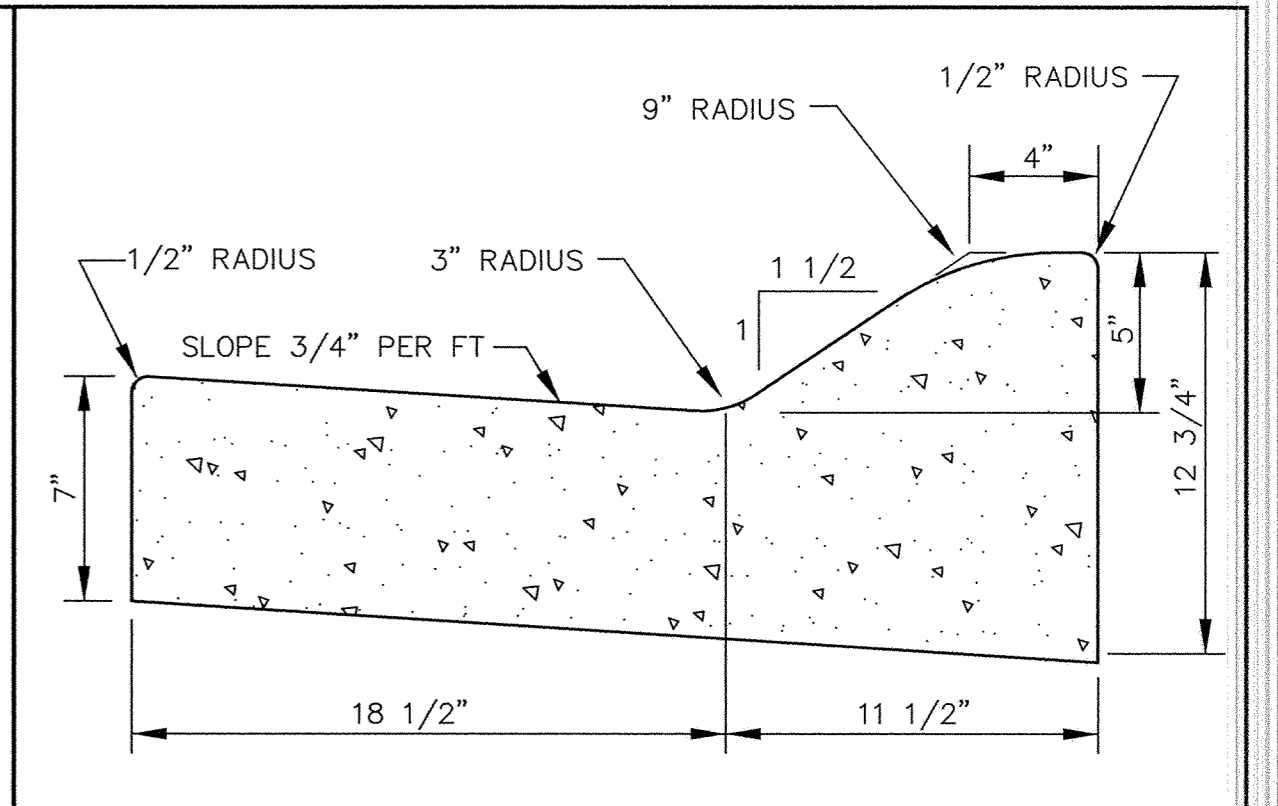


CONCRETE CURB AND GUTTER S518

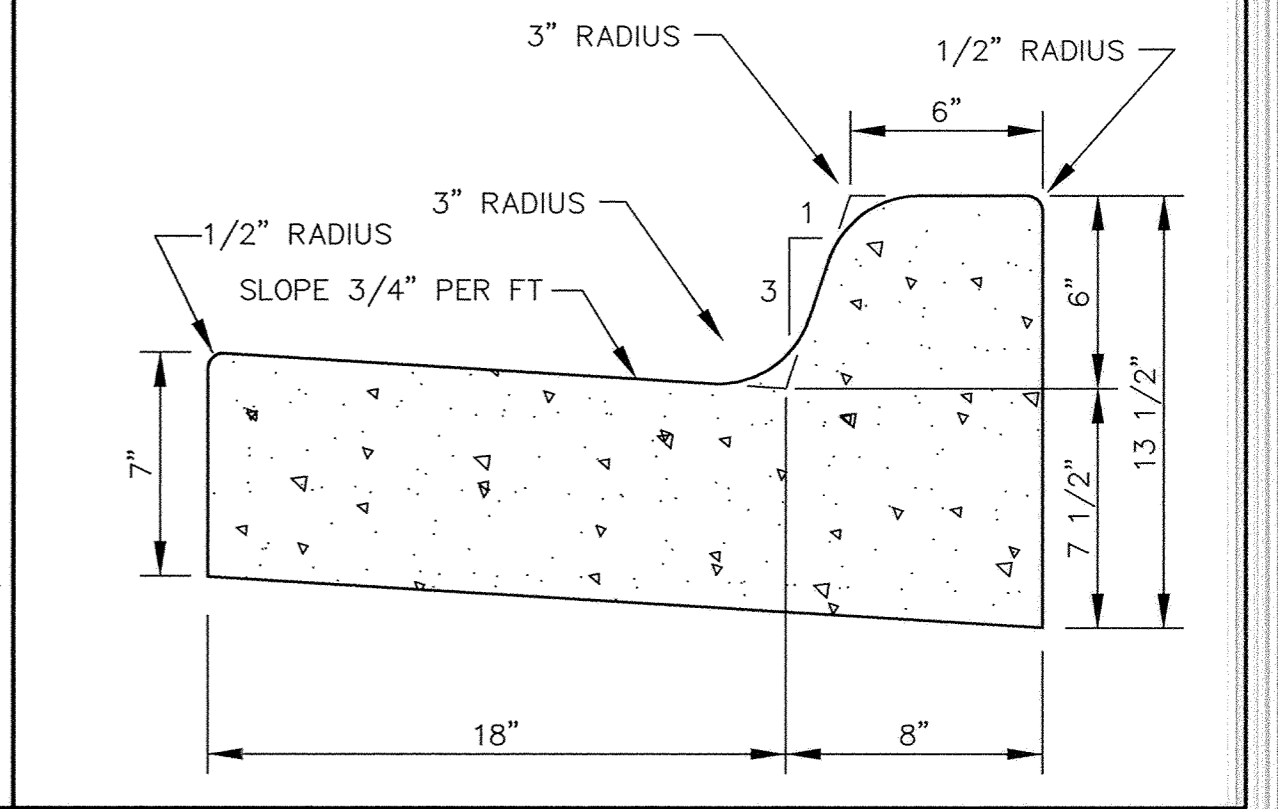


CONCRETE CURB AND GUTTER B618

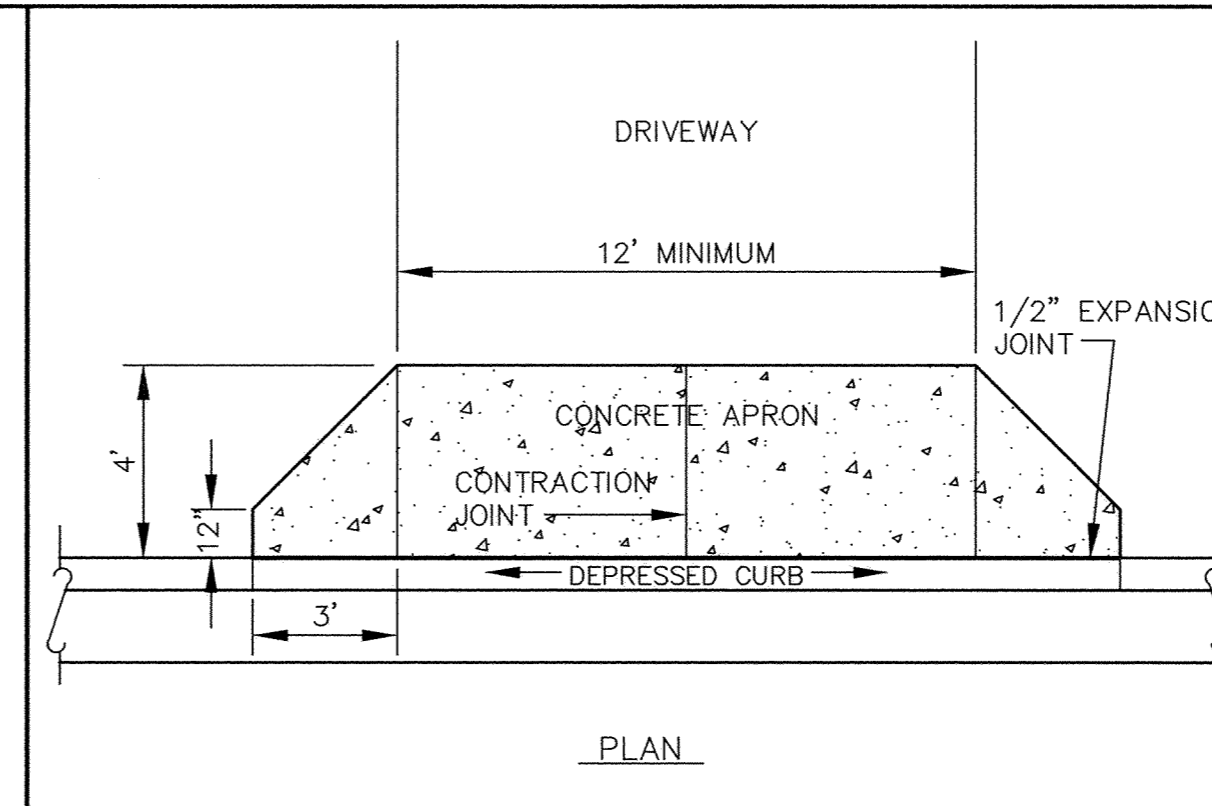


DEPRESSED CURB WITH DRIVEWAY APRON

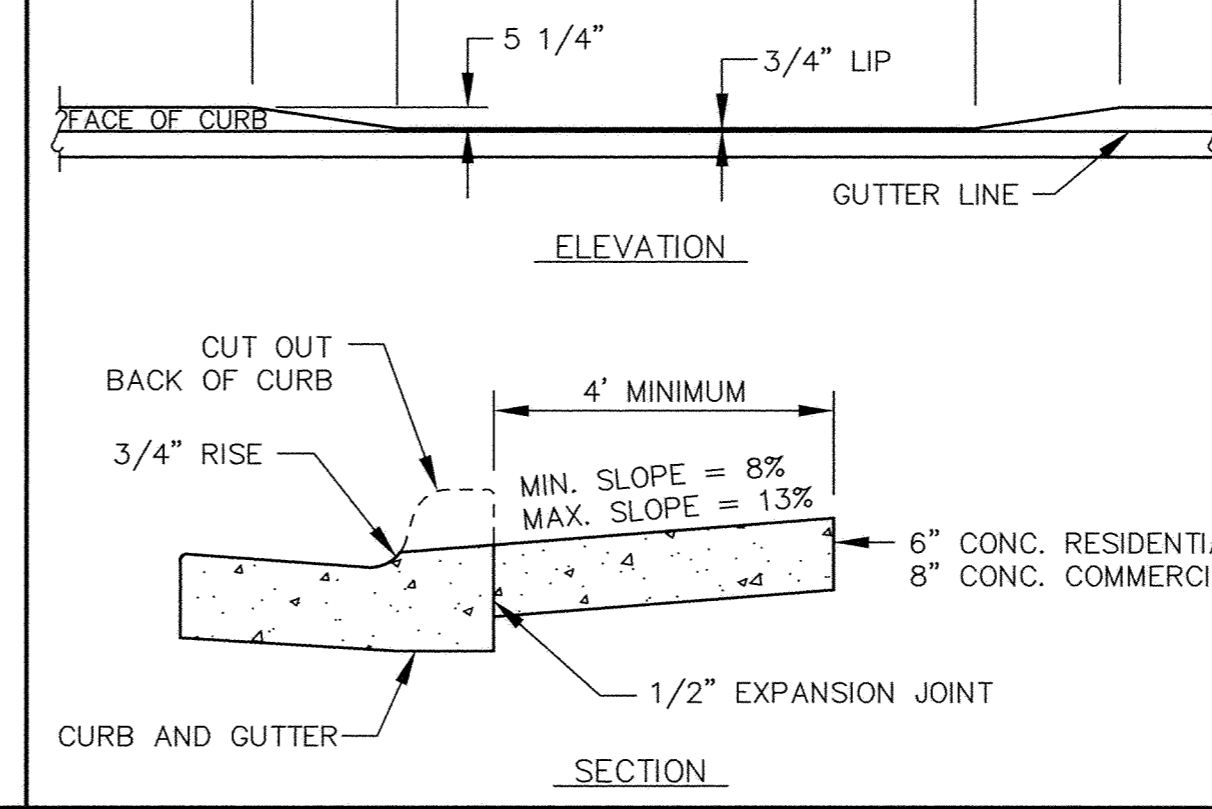

DEPRESSED CURB DETAIL

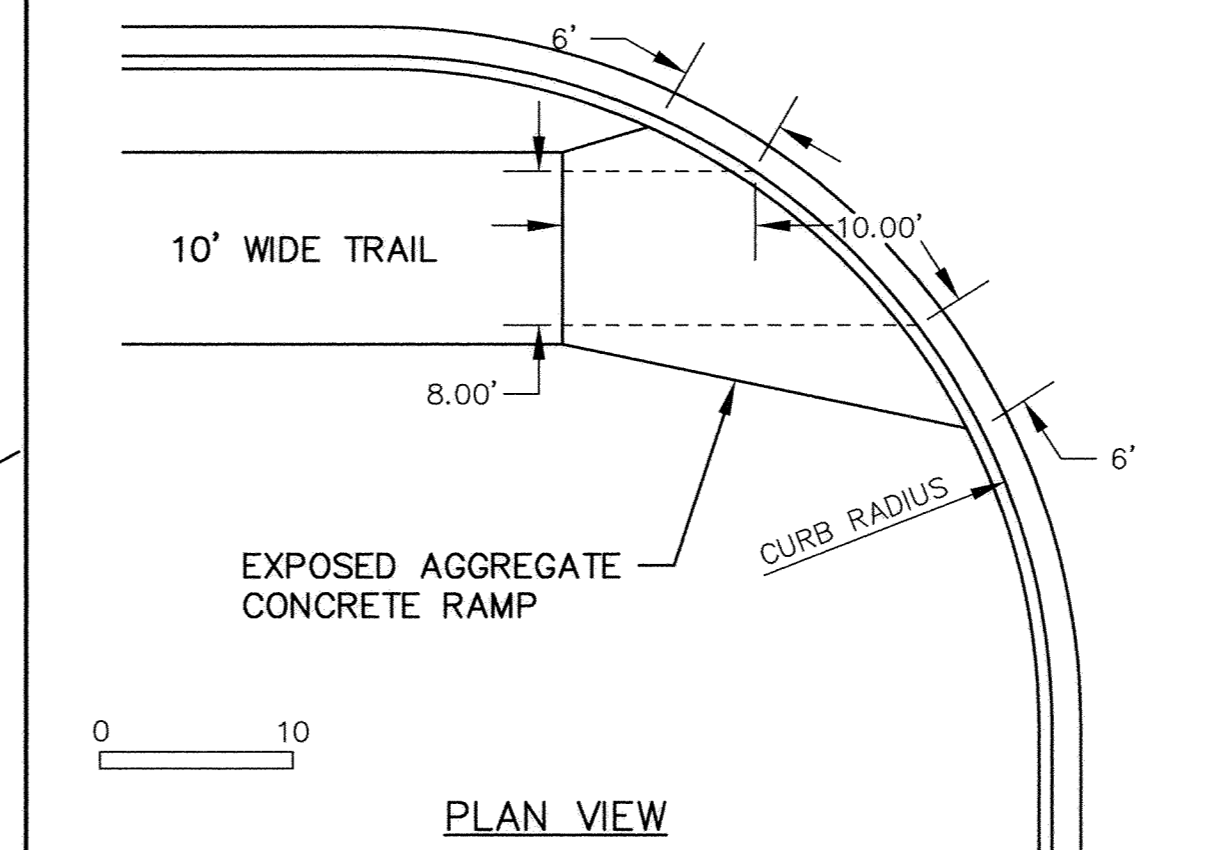


MATCH EXISTING BITUMINOUS SURFACING

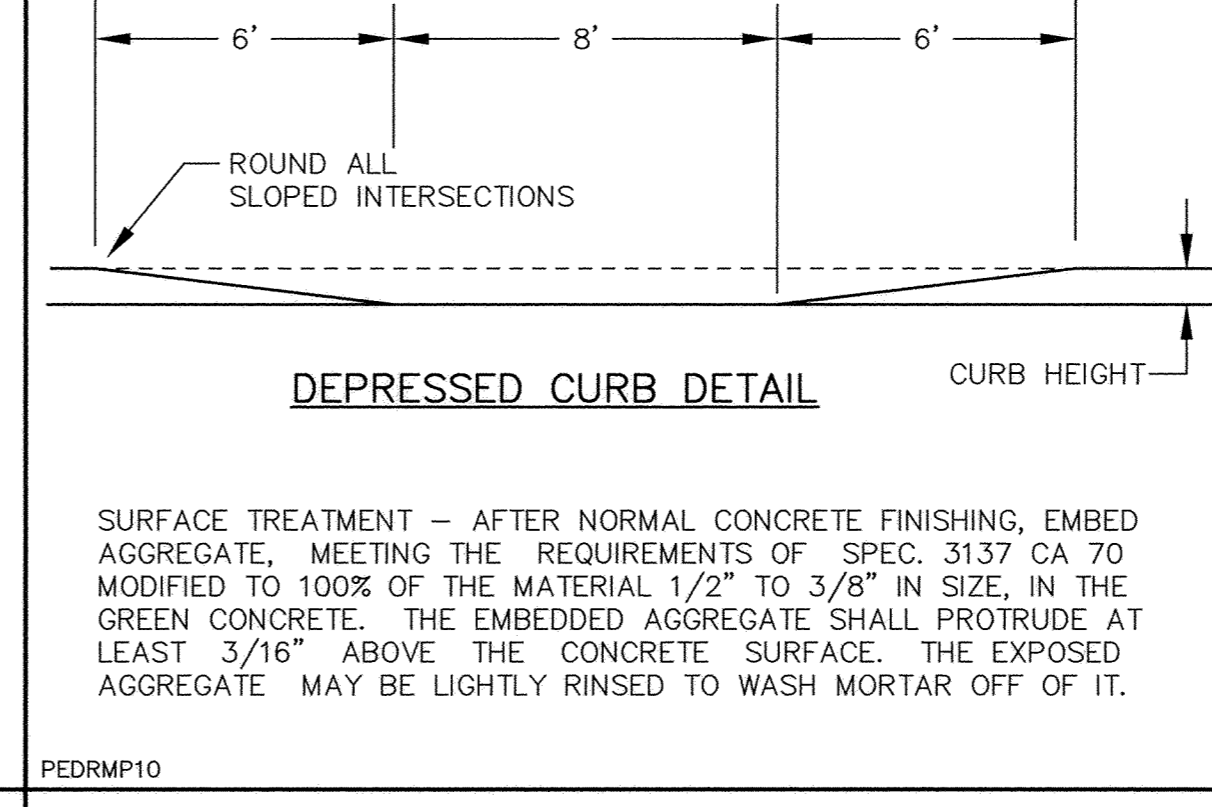


RECORD DRAWING
OCTOBER 1997


CITY OF ELK RIVER
ORONO LAKE 3RD ADD., JOPLIN STREET
& LOWELL STREET
STREET CONSTRUCTION DETAILS
DATE NOV. 1996 SHEET 28 OF 31 SHEETS PROJECT NO. 230-320

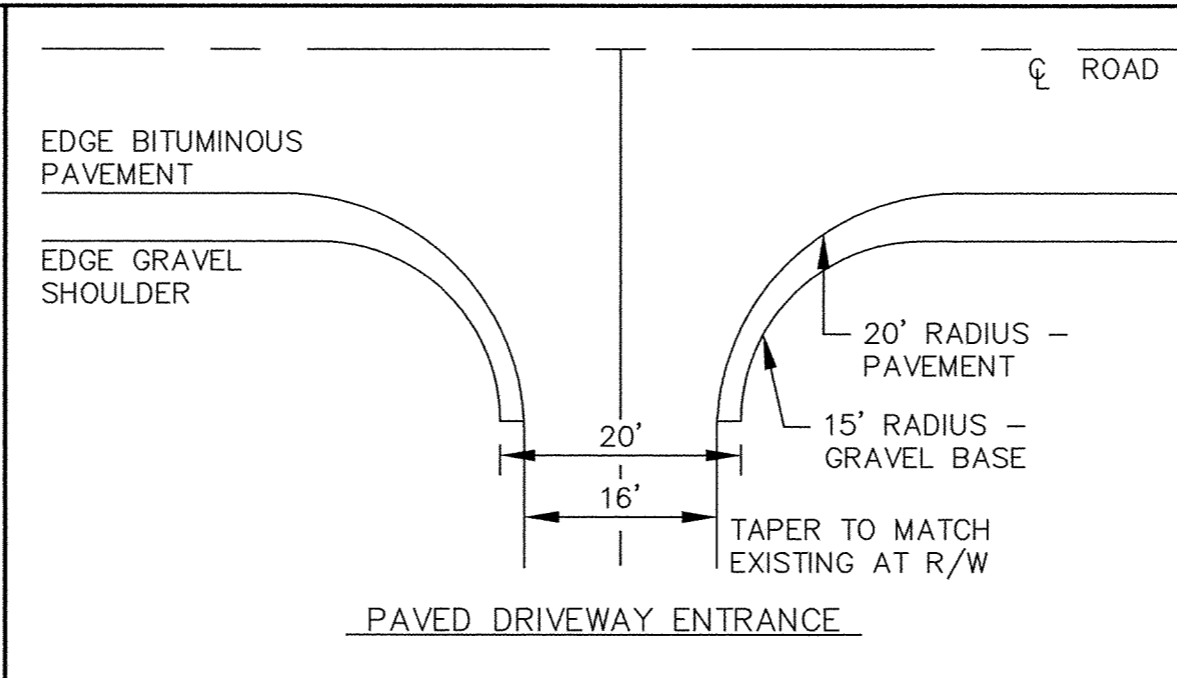


RURAL DRIVEWAY ENTRANCE

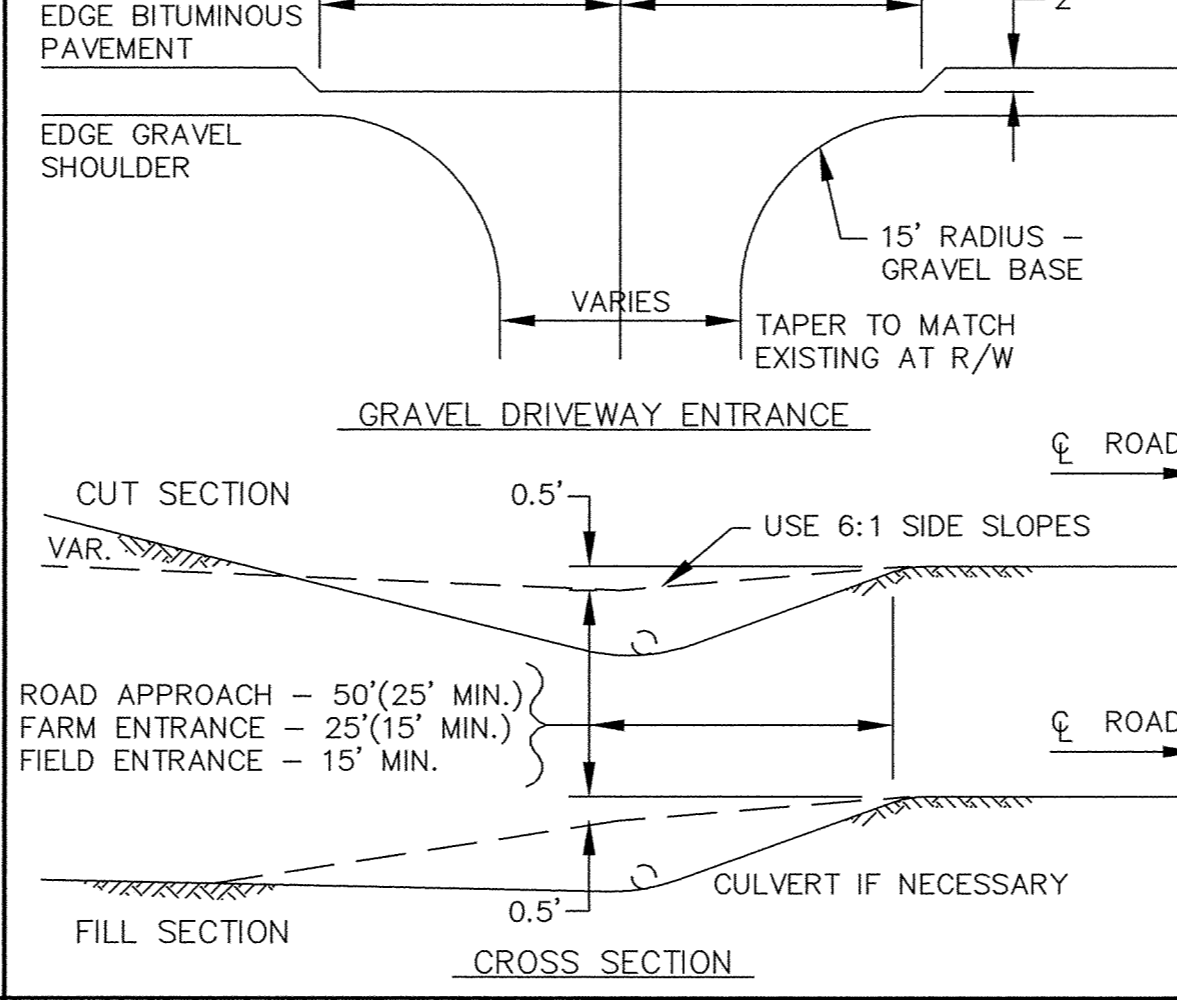


RURAL DRIVEWAY ENTRANCE

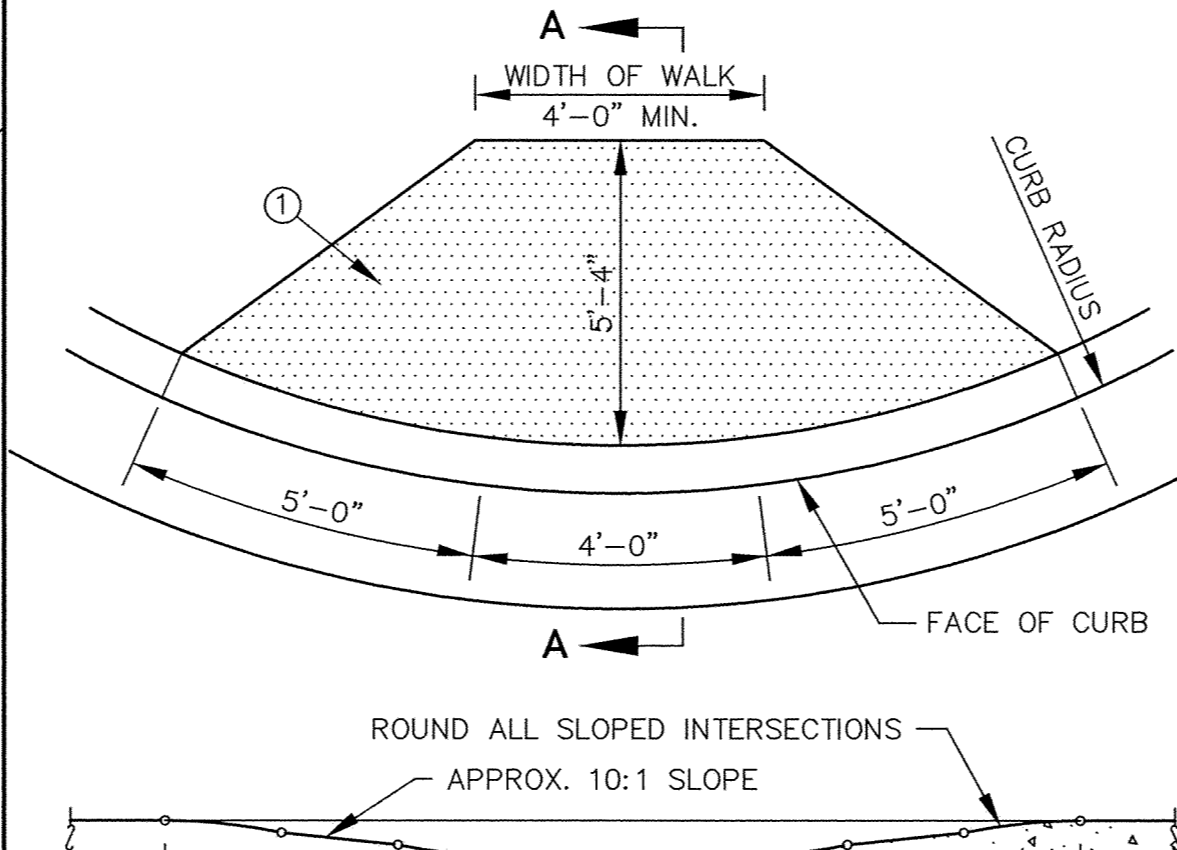


PEDESTRIAN CURB RAMPS

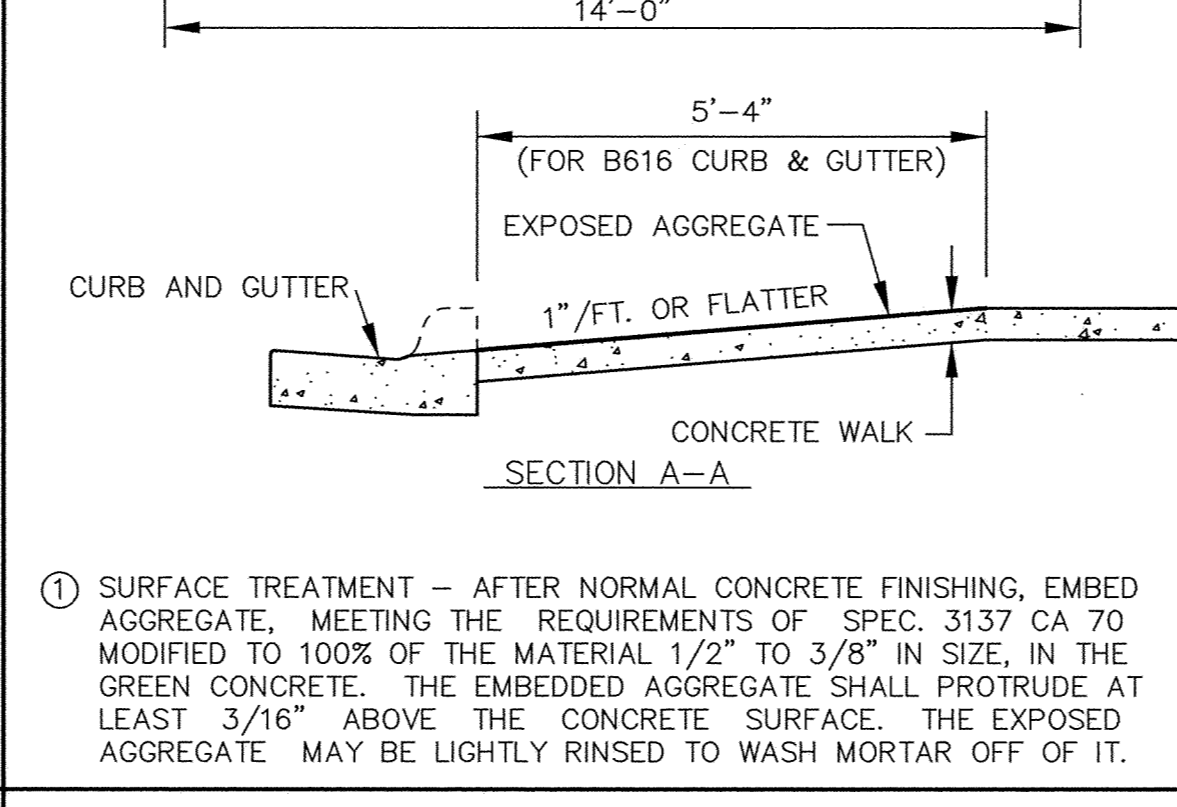


PEDESTRIAN CURB RAMPS

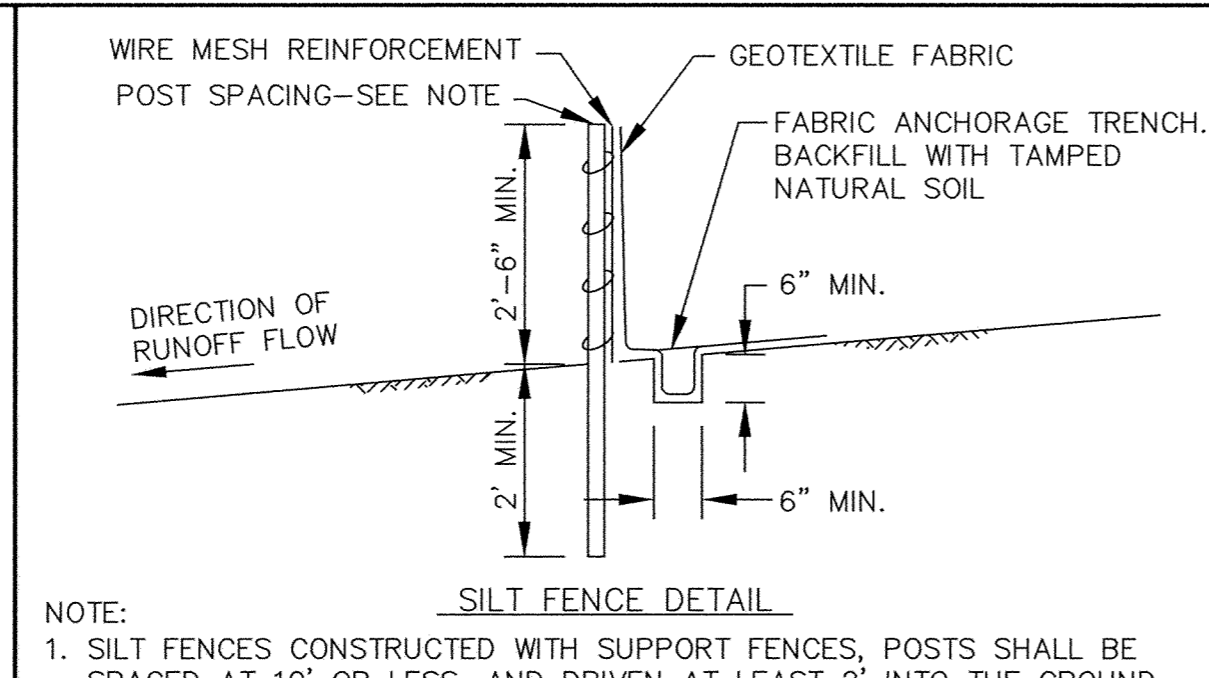


EROSION CONTROL DETAIL

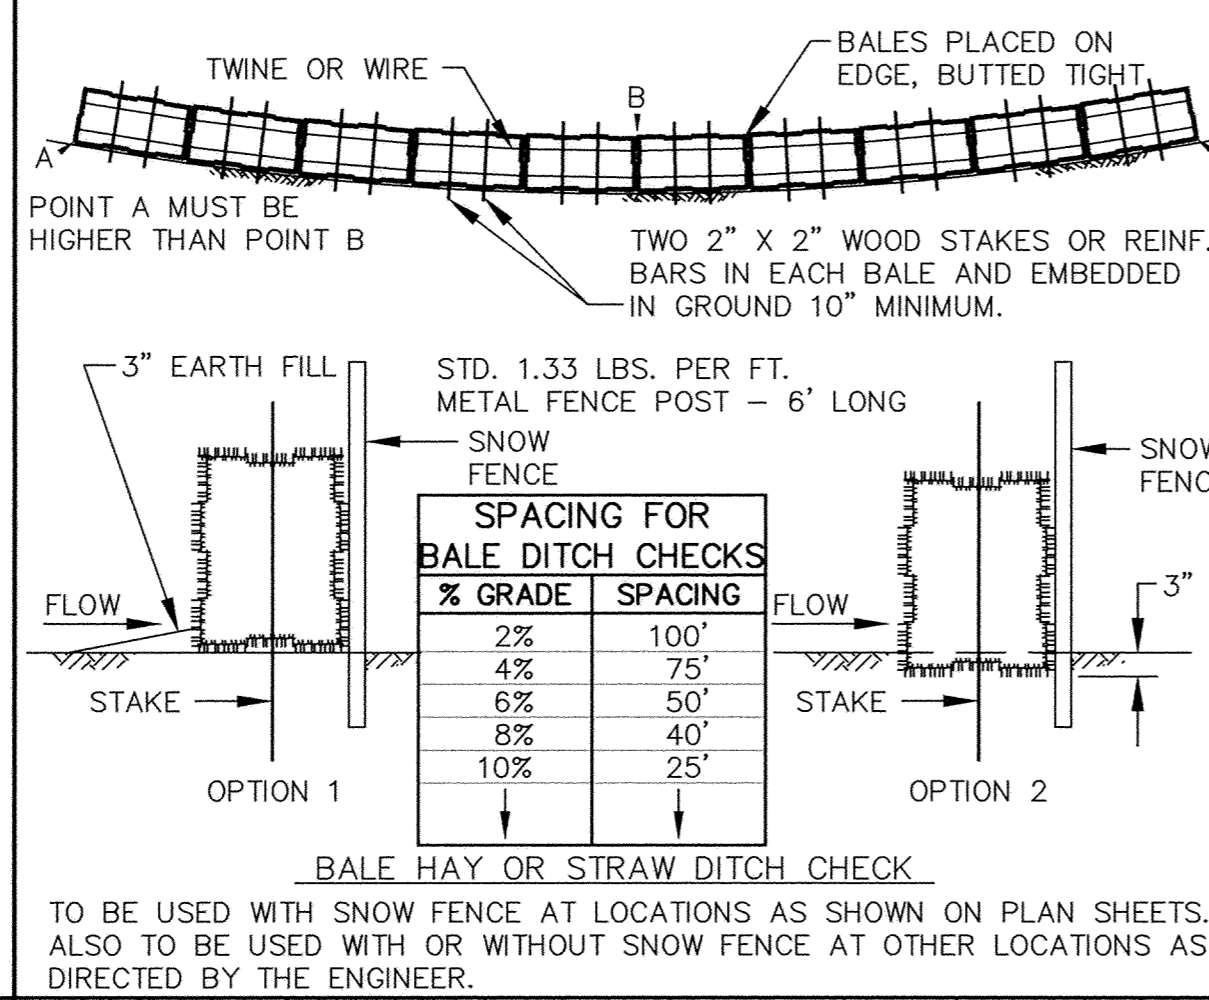

EROSION CONTROL DETAIL

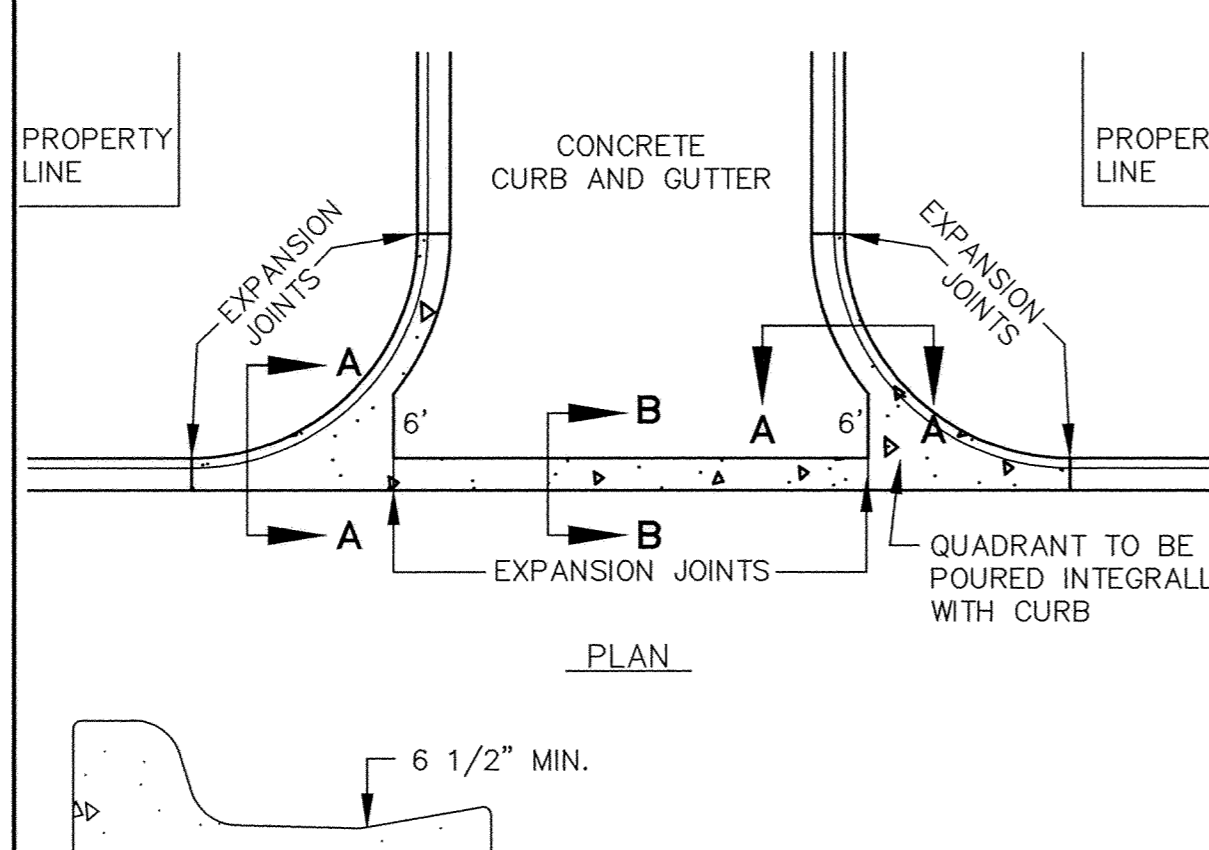


CONCRETE V GUTTER

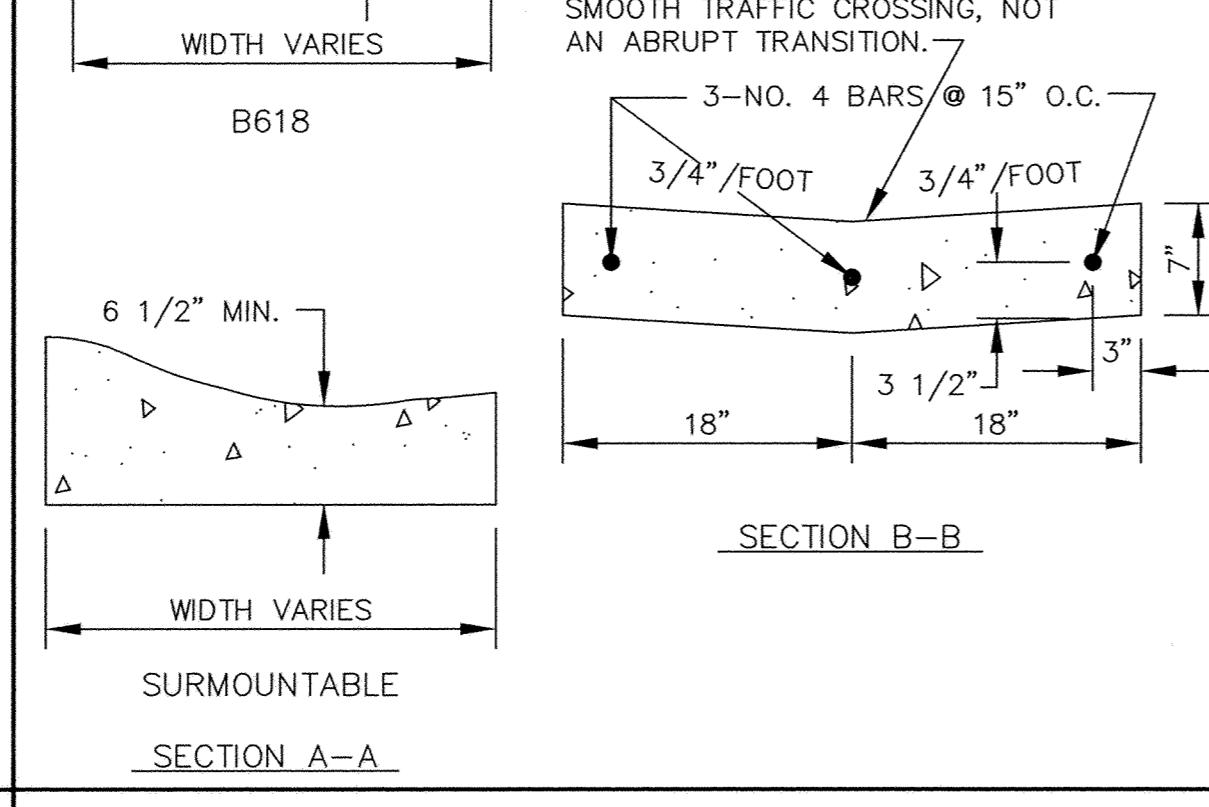


CONCRETE V GUTTER


I HEREBY CERTIFY THAT THIS PLAN, SPECIFICATION, OR REPORT WAS PREPARED BY ME OR UNDER MY DIRECT SUPERVISION AND THAT I AM A DULY REGISTERED PROFESSIONAL ENGINEER UNDER THE LAWS OF THE STATE OF MINNESOTA.
DATE 12/9/96 REG. NO. 15316
M.S.A. CONSULTING ENGINEERS

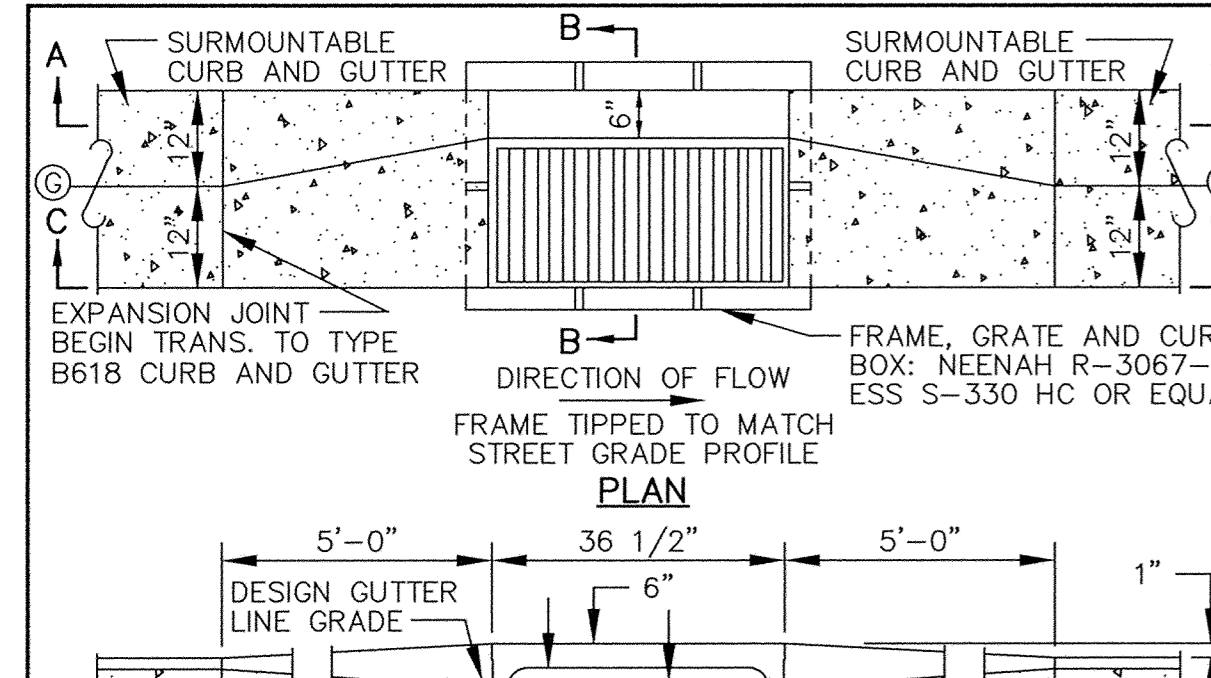


CATCH BASIN FRAME PLACEMENT

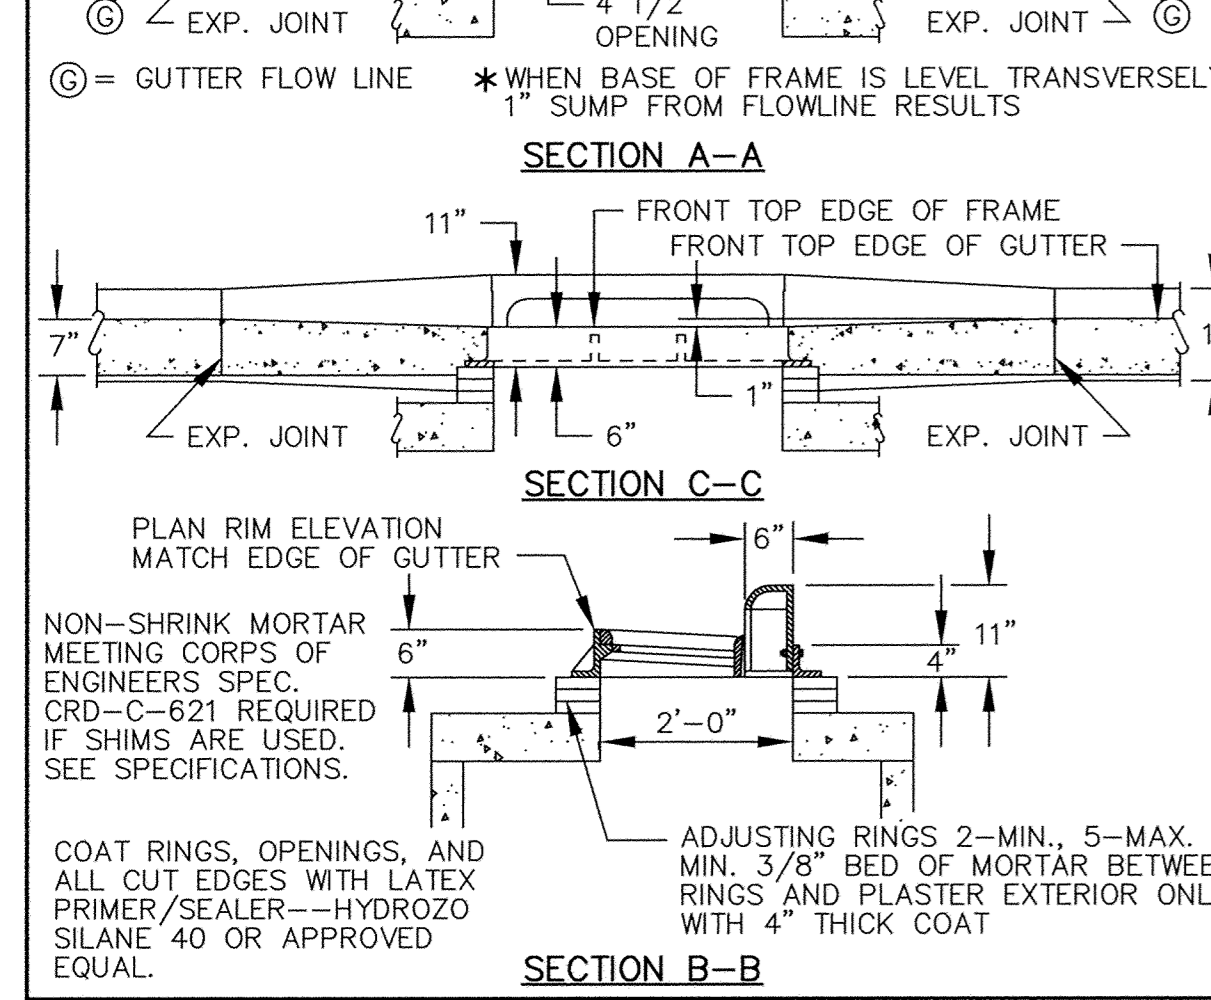

CATCH BASIN FRAME PLACEMENT

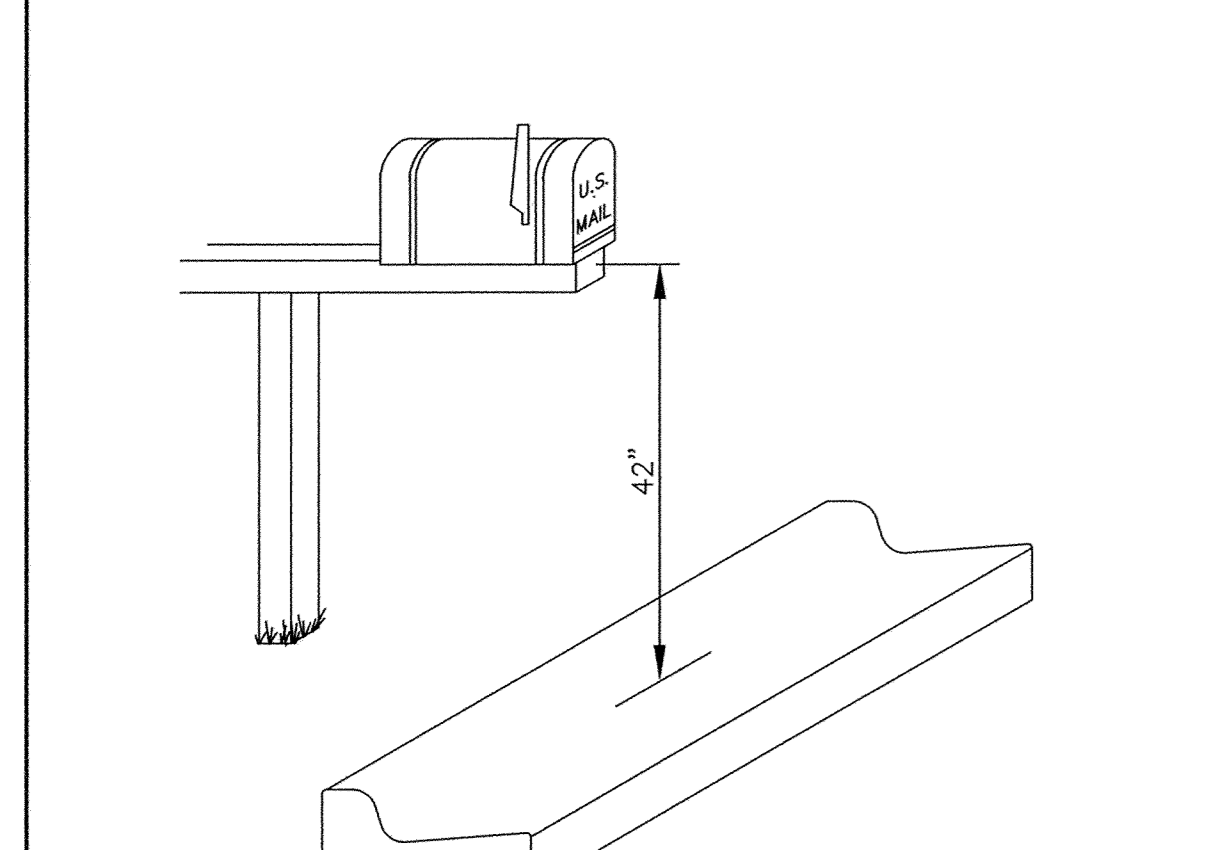

MAIL BOX

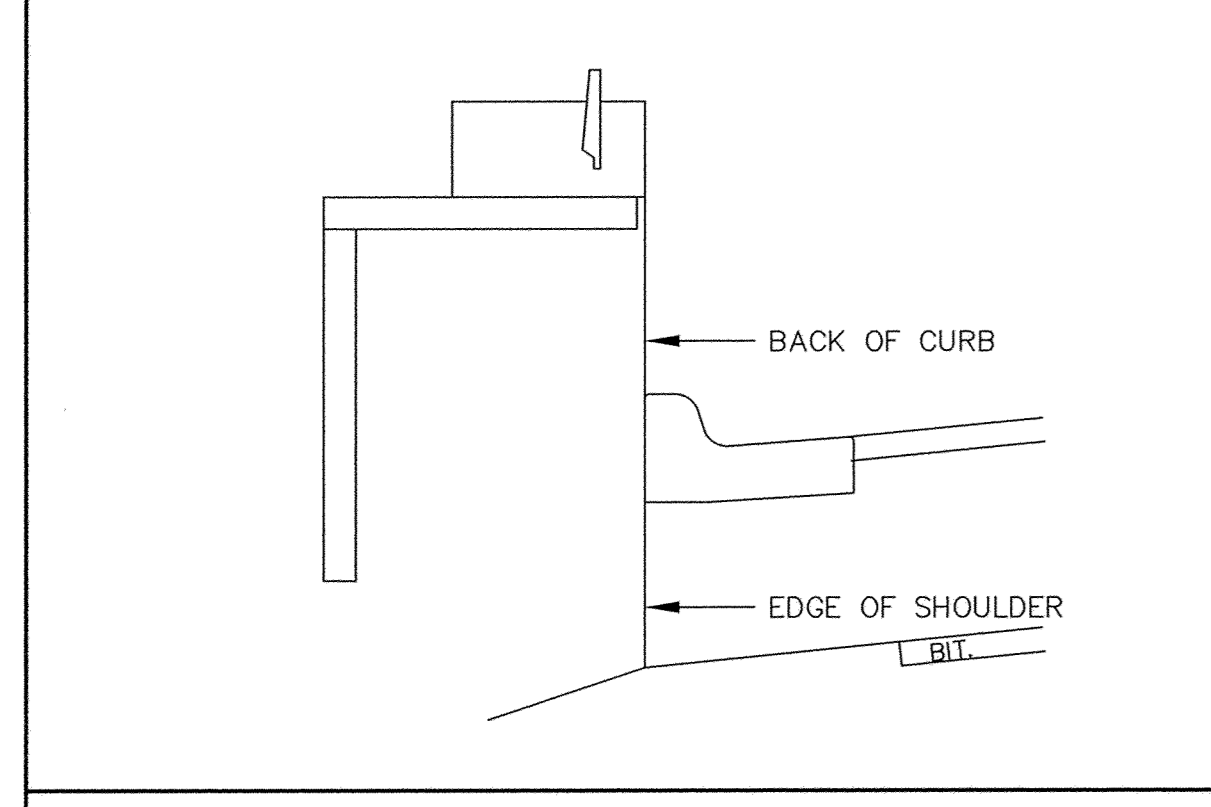

MAIL BOX

ER320-ST

Table with columns: DATE, DESCRIPTION, DESIGNED, CHECKED, DRAWN, GRAPHIC SCALE, HORIZ., VERT.