



175TH COURT

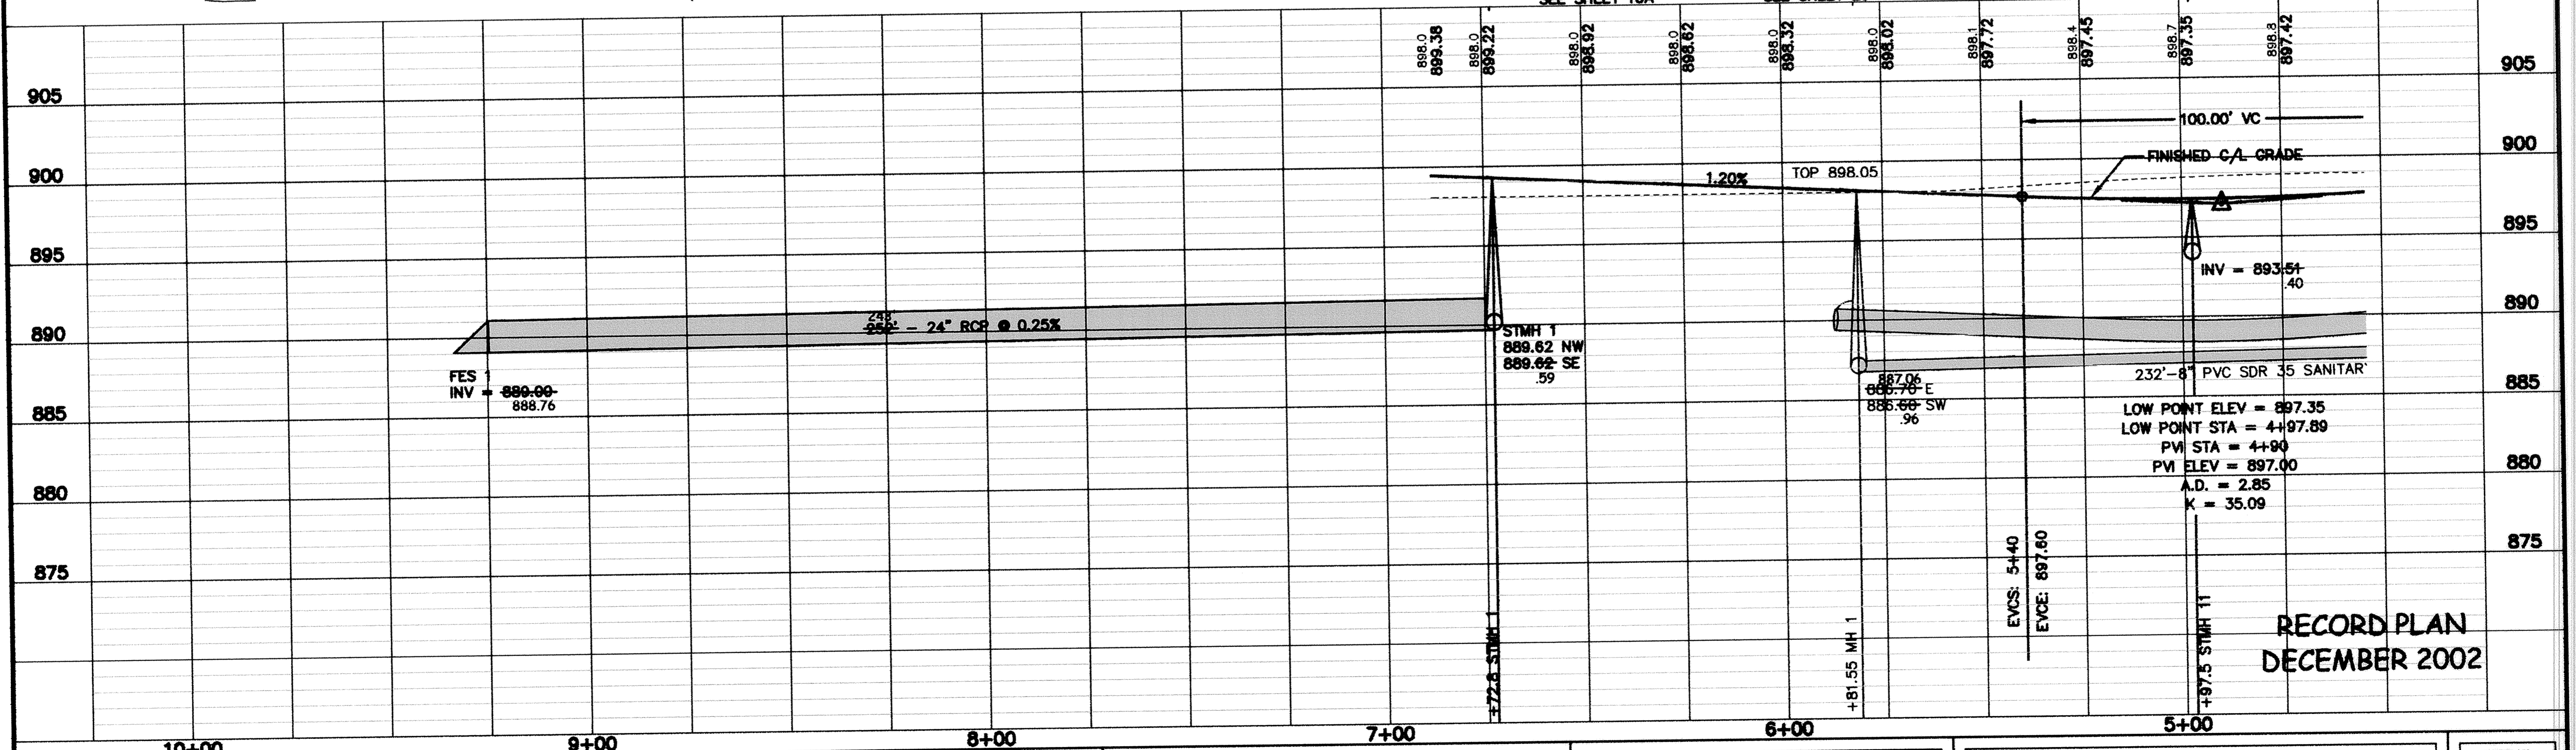

0 20
0 VERT. 5

SEE SHEET 9

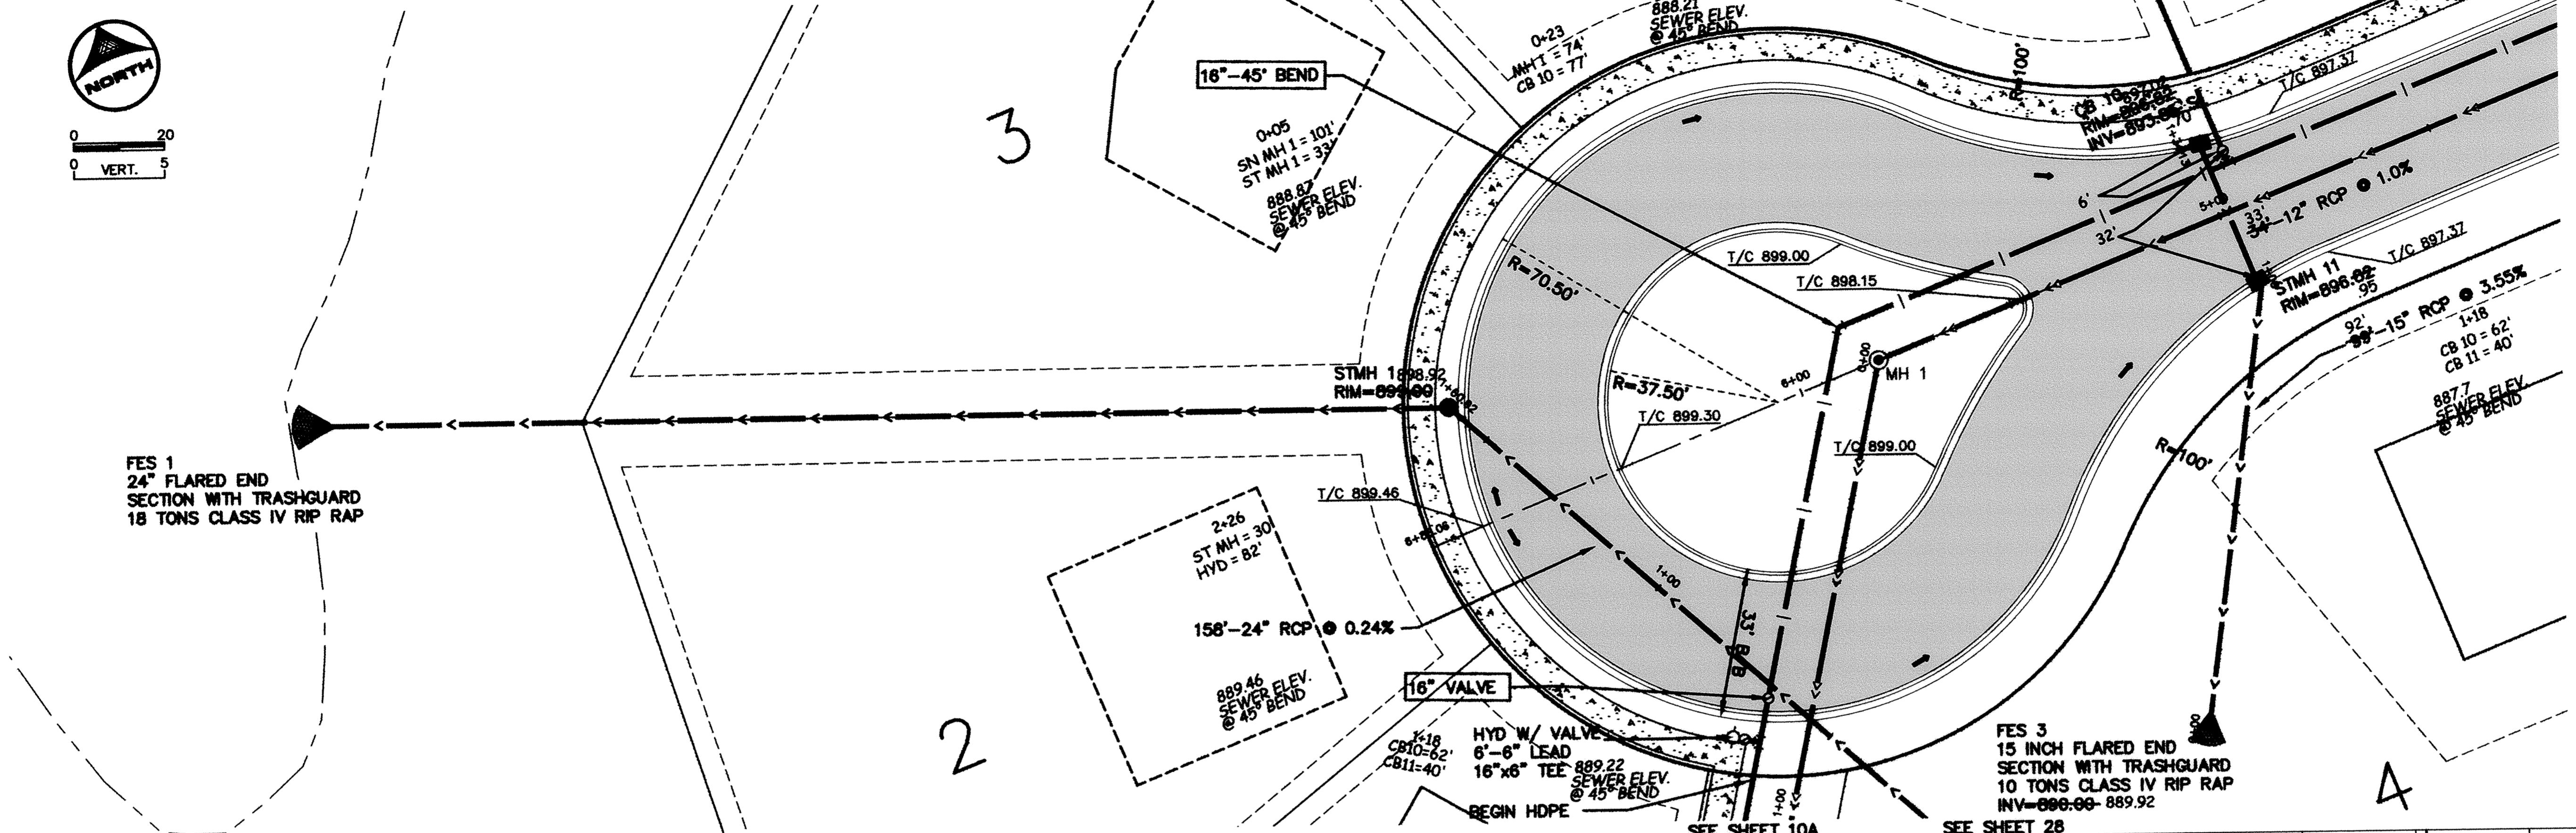

RECORD PLAN
DECEMBER 2002

DESIGNED BY: KI/EY DRAWN BY: EY/JIM
 APPROVED BY: APPROVED BY JOB NUMBER 815361J
 CAD DATE: April 04, 2003 7:57:14 a.m.
 CAD FILE: 815361J.dwg\175TH-COURT.DWG (JLALLEN)

I HEREBY CERTIFY THAT THIS PLAN, SPECIFICATION, OR REPORT
 WAS PREPARED BY ME OR UNDER MY DIRECT SUPERVISION AND
 THAT I AM A DULY LICENSED PROFESSIONAL ENGINEER UNDER
 THE LAWS OF THE STATE OF MINNESOTA.

SIGNATURE: _____ DATE: _____
 PRINTED NAME: TERRY J. MAURER LIC. NO. 15316

NO.	DATE	BY	REVISION DESCRIPTION

1326 ENERGY PARK DRIVE
 ST. PAUL, MINNESOTA 55108
 (651) 644-4389

Howard R. Green Company
 CONSULTING ENGINEERS

PARK POINTE
 CITY OF ELK RIVER

175TH COURT
 STREET AND UTILITY IMPROVEMENTS 5+00 TO 6+88.06

SHEET NO.
10