



175TH LANE

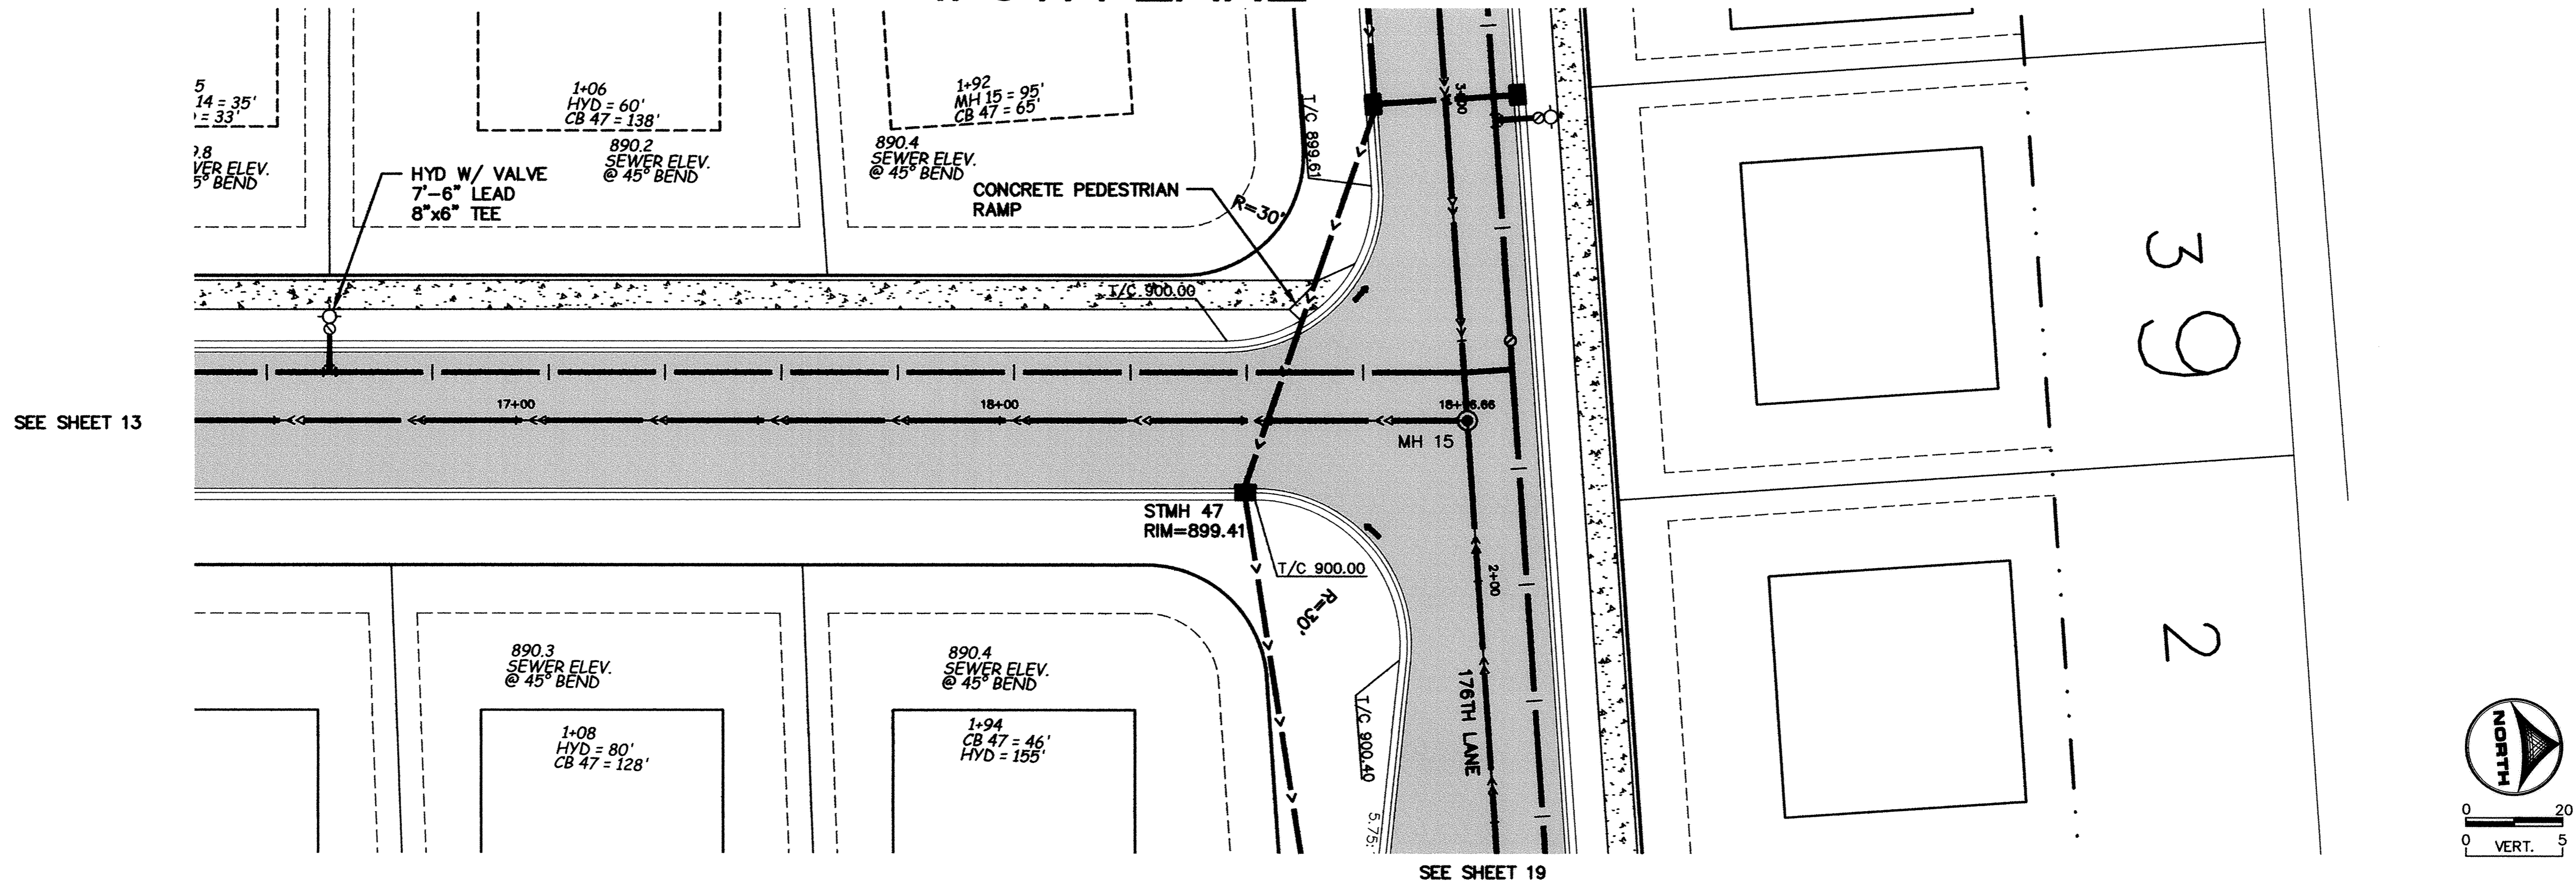

SEE SHEET 13

SEE SHEET 19

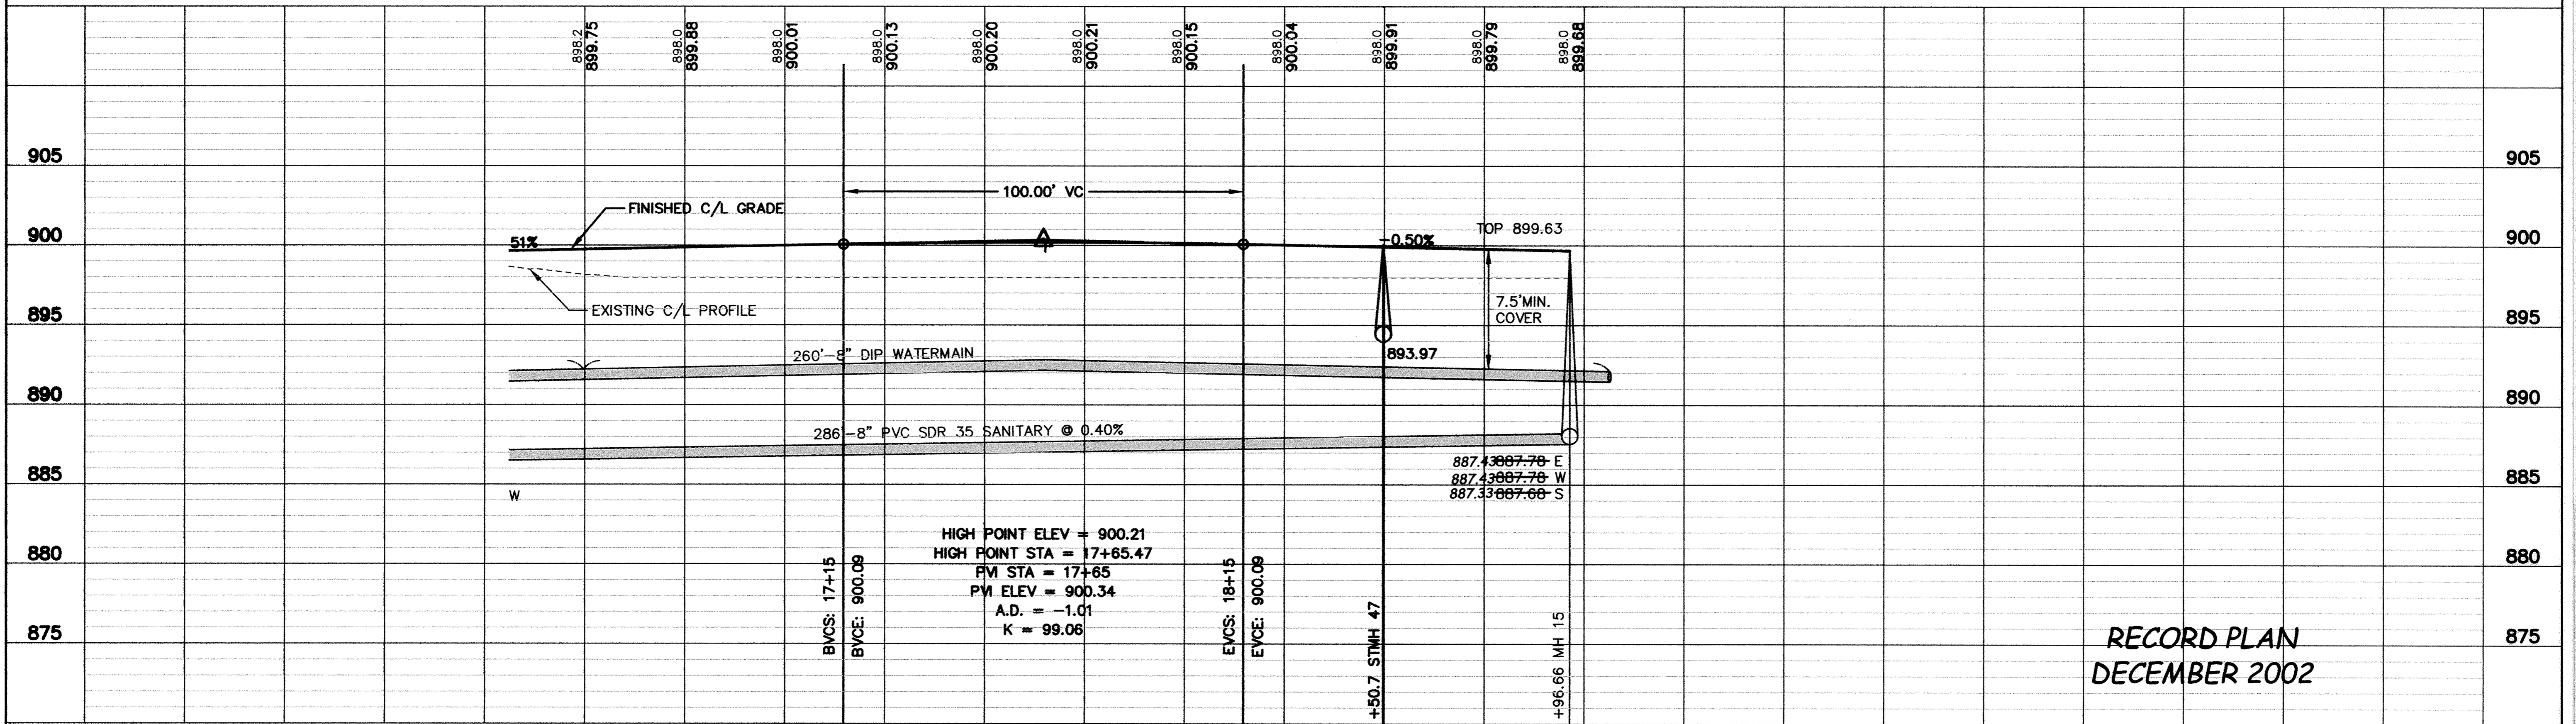

RECORD PLAN
DECEMBER 2002

DESIGNED BY: KT/EY DRAWN BY: EY/JM
 APPROVED BY: APPROVED BY JOB NUMBER 815361J
 CAD DATE: April 04, 2003 7:38:20 a.m.
 CAD FILE: 815361J\dwg\175TH-LANE.DWG (JLALLEN)

I HEREBY CERTIFY THAT THIS PLAN, SPECIFICATION, OR REPORT WAS PREPARED BY ME OR UNDER MY DIRECT SUPERVISION AND THAT I AM A DULY LICENSED PROFESSIONAL ENGINEER UNDER THE LAWS OF THE STATE OF MINNESOTA.

SIGNATURE: _____ DATE: _____
 PRINTED NAME: TERRY J. MAURER UC.NO.: 15316

NO.	DATE	BY	REVISION DESCRIPTION

1326 ENERGY PARK DRIVE
 ST. PAUL, MINNESOTA 55108
 (651) 644-4389

Howard R. Green Company
 CONSULTING ENGINEERS

PARK POINTE
 CITY OF ELK RIVER

175TH LANE
 STREET AND UTILITY IMPROVEMENTS 16+50 TO 19+00

SHEET NO.
14