
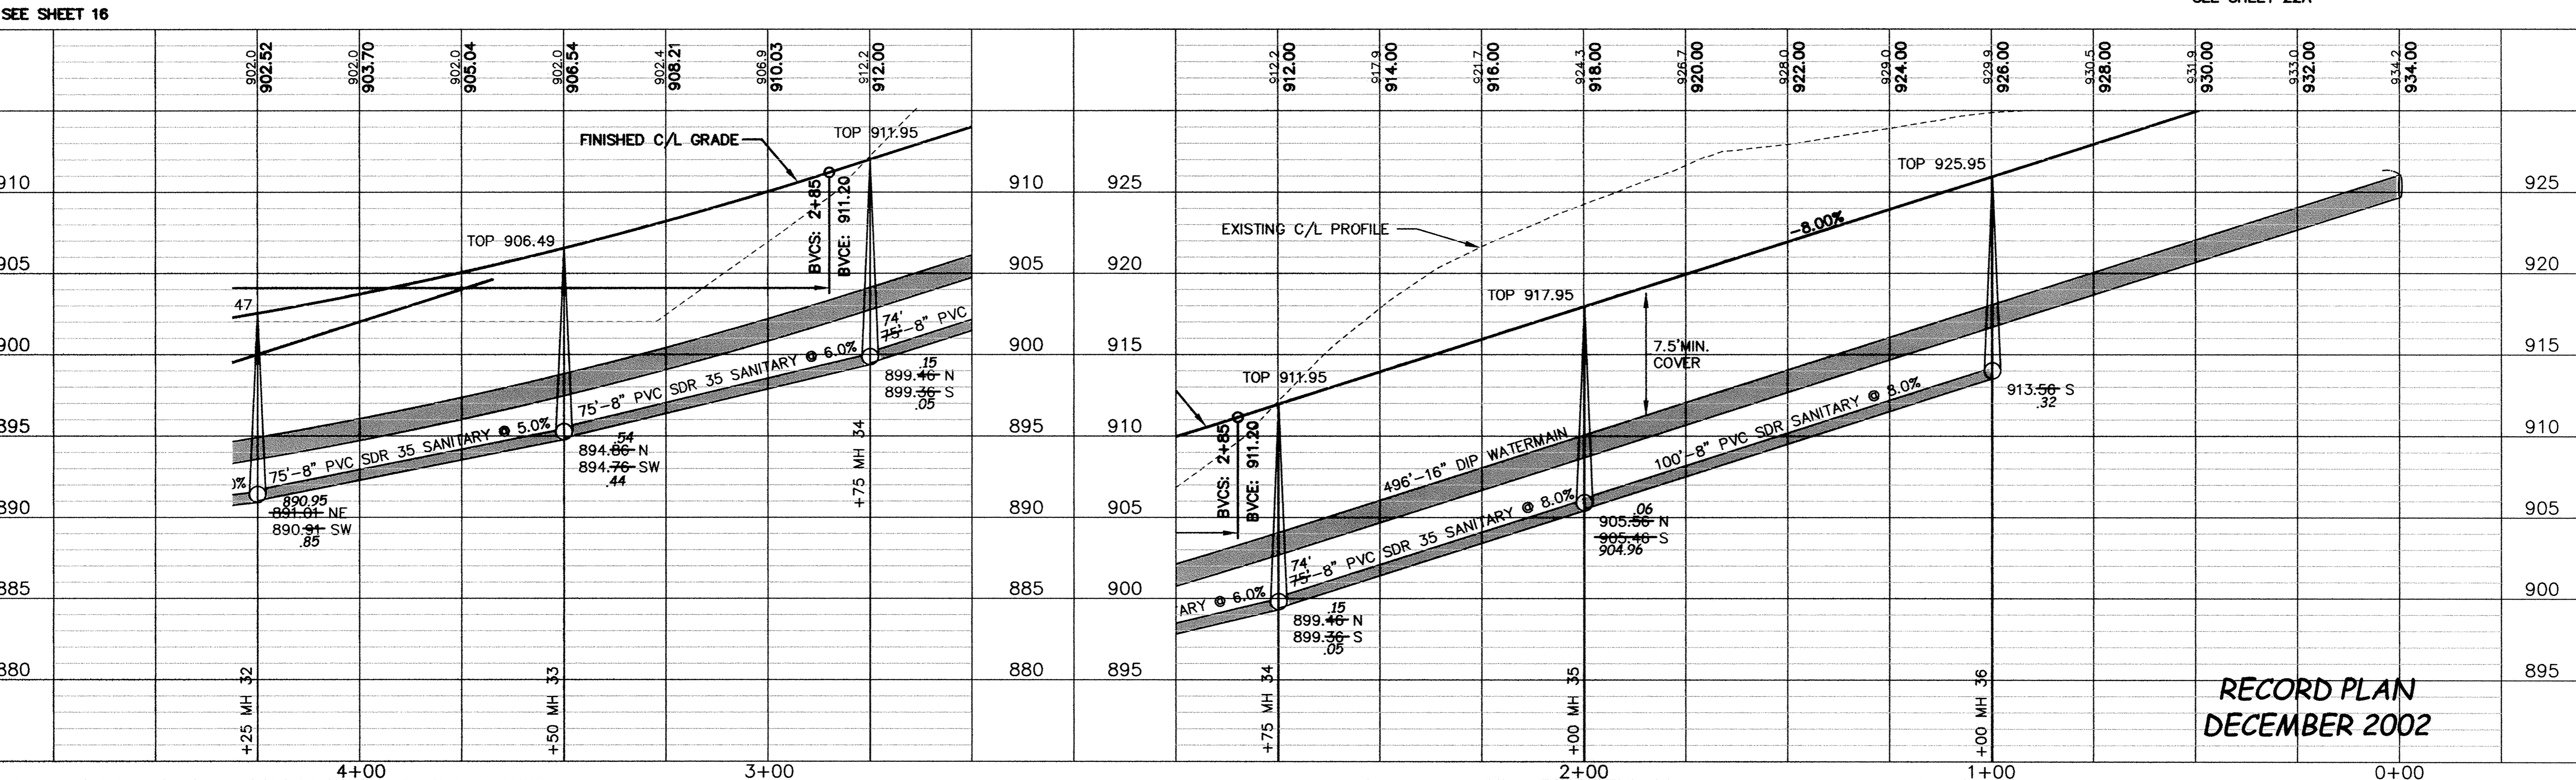


176TH COURT

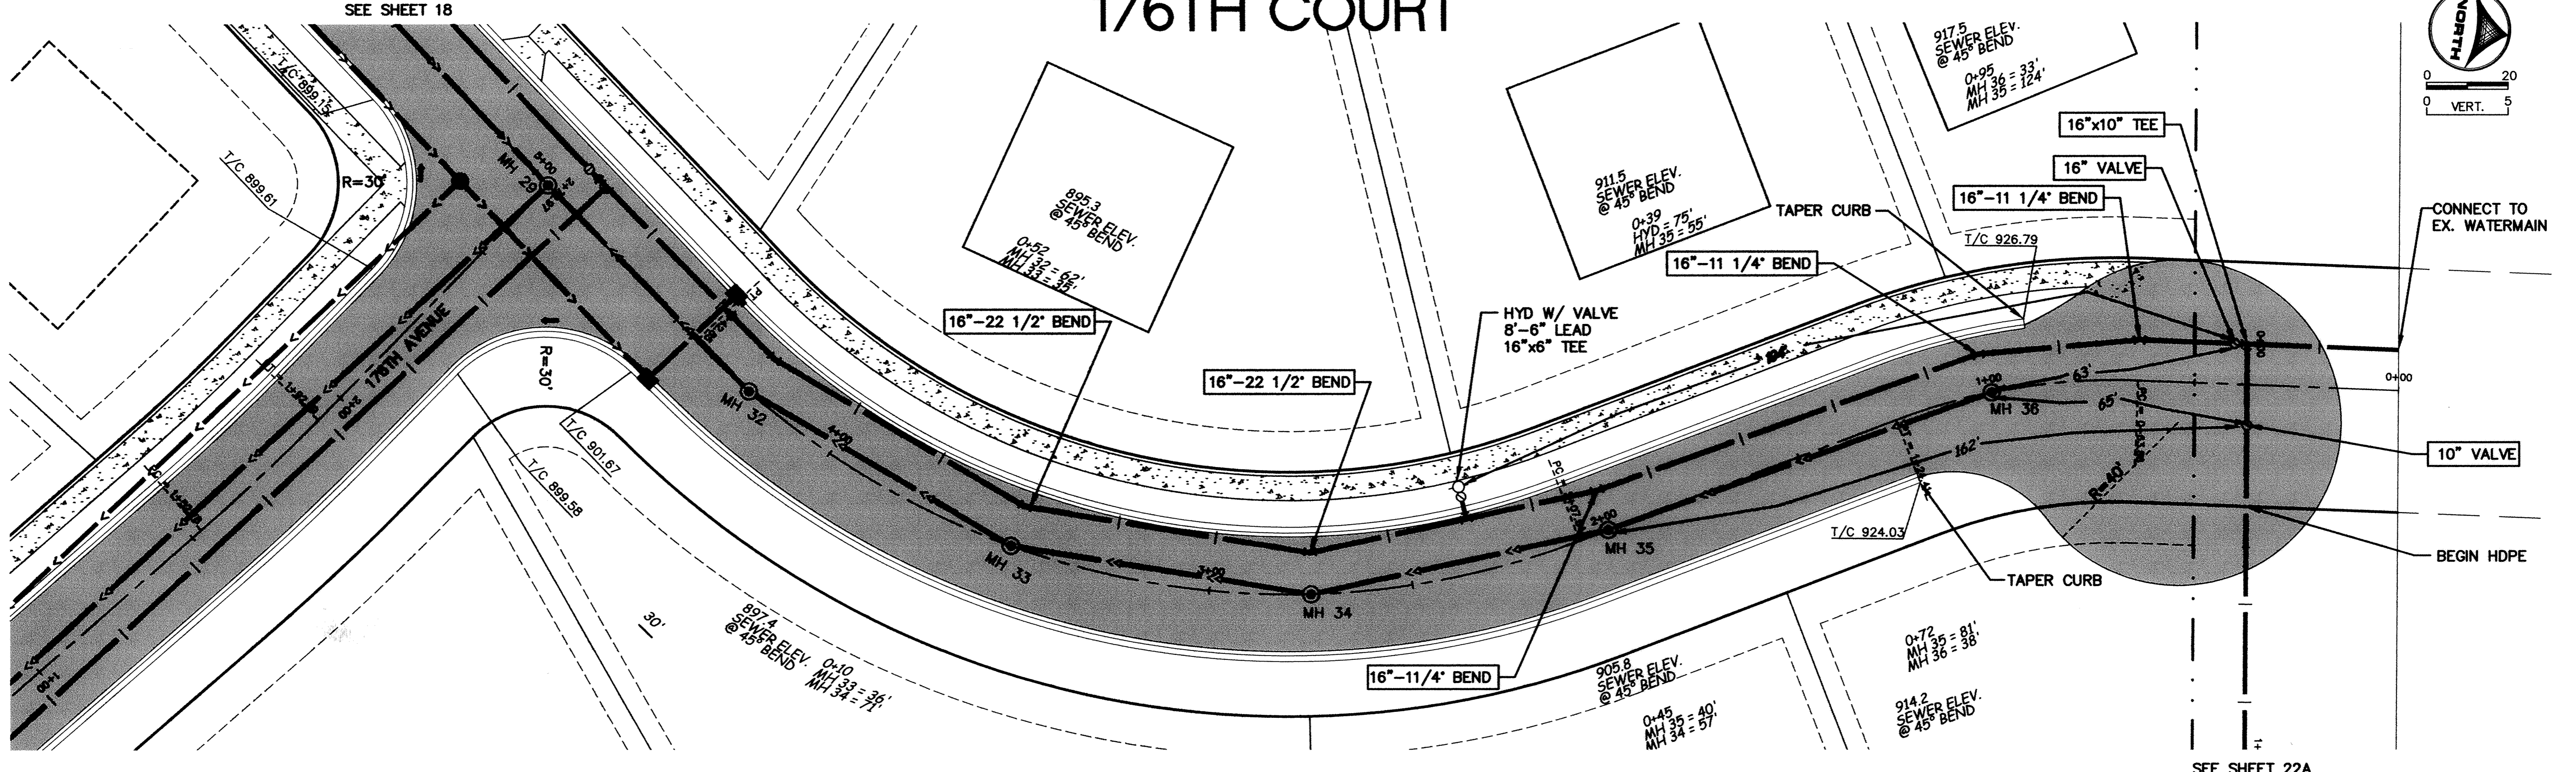

**RECORD PLAN
DECEMBER 2002**

DESIGNED BY: KT/EY DRAWN BY: EY/JM
 APPROVED BY: APPROVED BY JOB NUMBER 815361J
 CAD DATE: April 04, 2003 8:10:23 a.m.
 CAD FILE: 815361J.dwg\176TH COURT.DWG (JLALLEN)

I HEREBY CERTIFY THAT THIS PLAN, SPECIFICATION, OR REPORT WAS PREPARED BY ME OR UNDER MY DIRECT SUPERVISION AND THAT I AM A DULY LICENSED PROFESSIONAL ENGINEER UNDER THE LAWS OF THE STATE OF MINNESOTA.
 SIGNATURE: _____ DATE: _____
 PRINTED NAME: TERRY J. MAURER LIC. NO. 15316

| NO. | DATE | BY | REVISION DESCRIPTION |
|-----|------|----|----------------------|
| | | | |
| | | | |
| | | | |

Howard R. Green Company
 CONSULTING ENGINEERS
 1326 ENERGY PARK DRIVE
 ST. PAUL, MINNESOTA 55108
 (651) 644-4389

PARK POINTE
 CITY OF ELK RIVER


176TH COURT
 STREET AND UTILITY IMPROVEMENTS 0+00 TO 4+00

SHEET NO.
17

SEE SHEET 16

SEE SHEET 22A

SEE SHEET 18

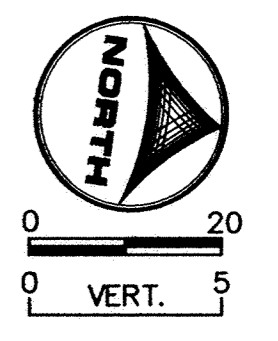

SD&CO PRODUCTS • NEW HOPKINS, MINNESOTA
 REVISION BY PART NUMBER 8592
 SD&CO PRODUCTS • NEW HOPKINS, MINNESOTA
 REVISION BY PART NUMBER 8592
 SD&CO PRODUCTS • NEW HOPKINS, MINNESOTA
 REVISION BY PART NUMBER 8592
 SD&CO PRODUCTS • NEW HOPKINS, MINNESOTA
 REVISION BY PART NUMBER 8592