
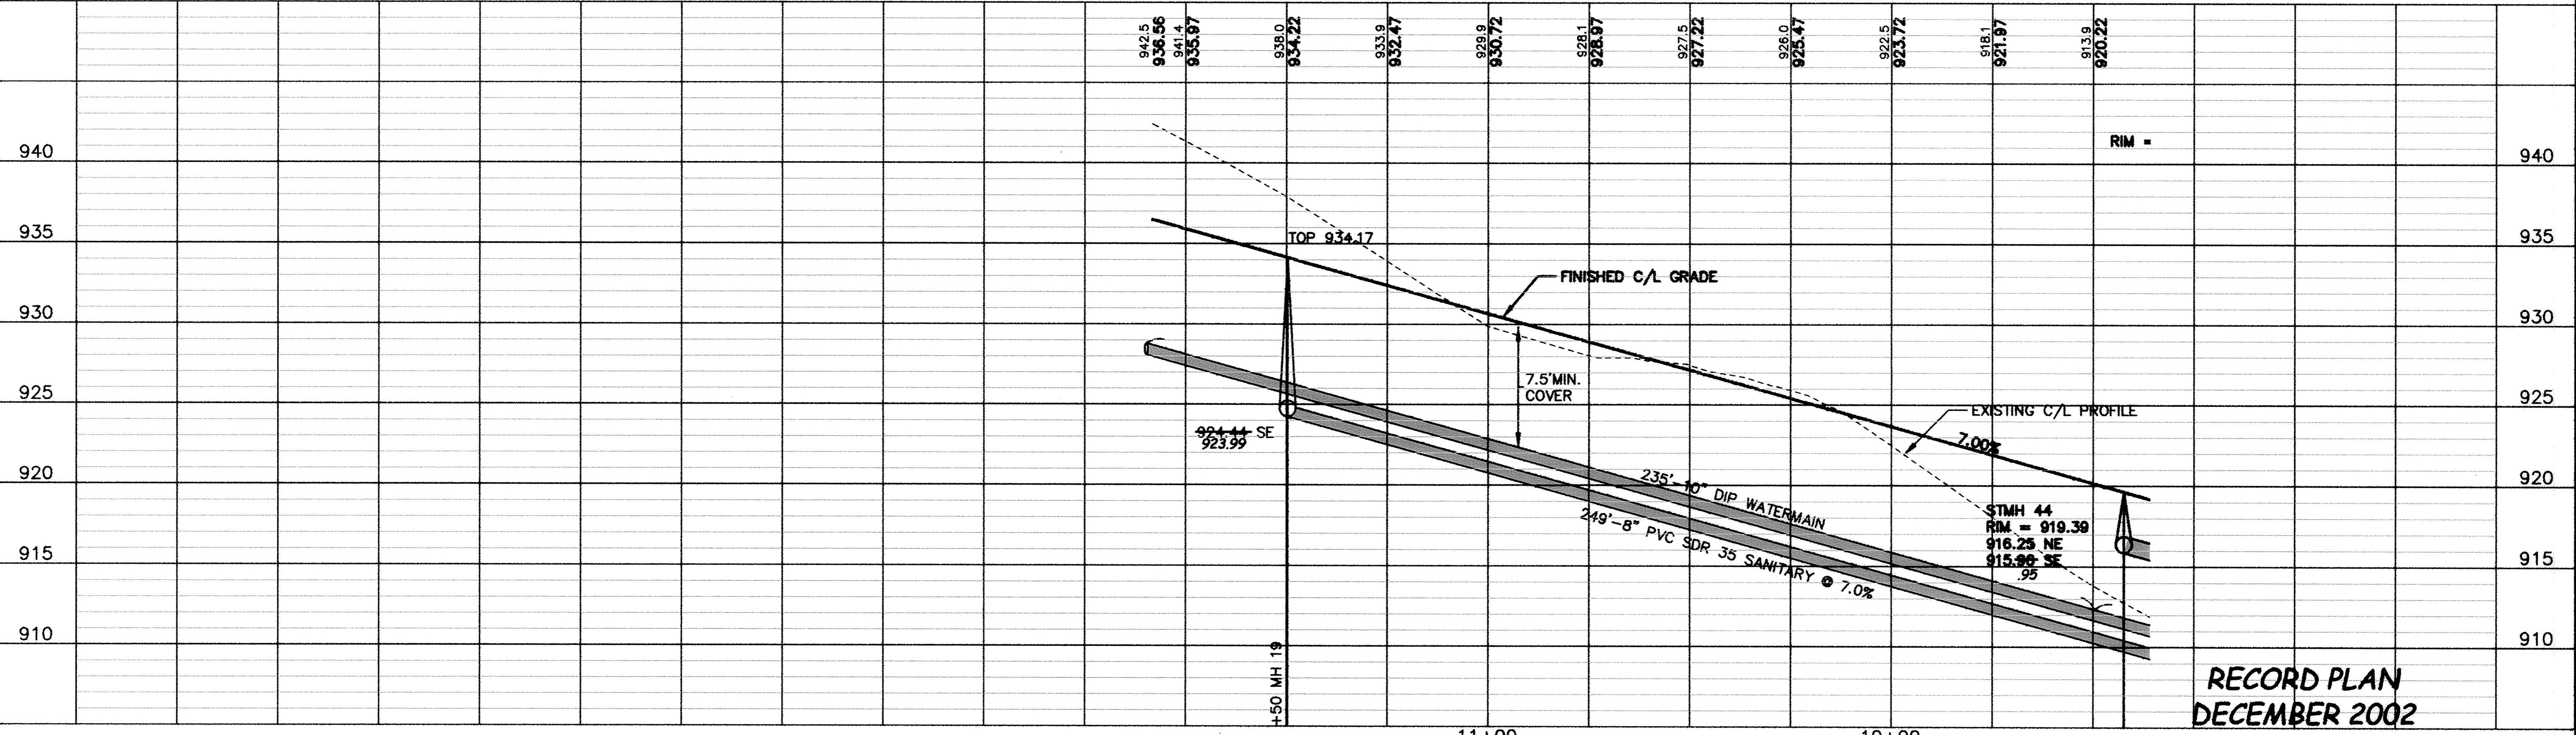
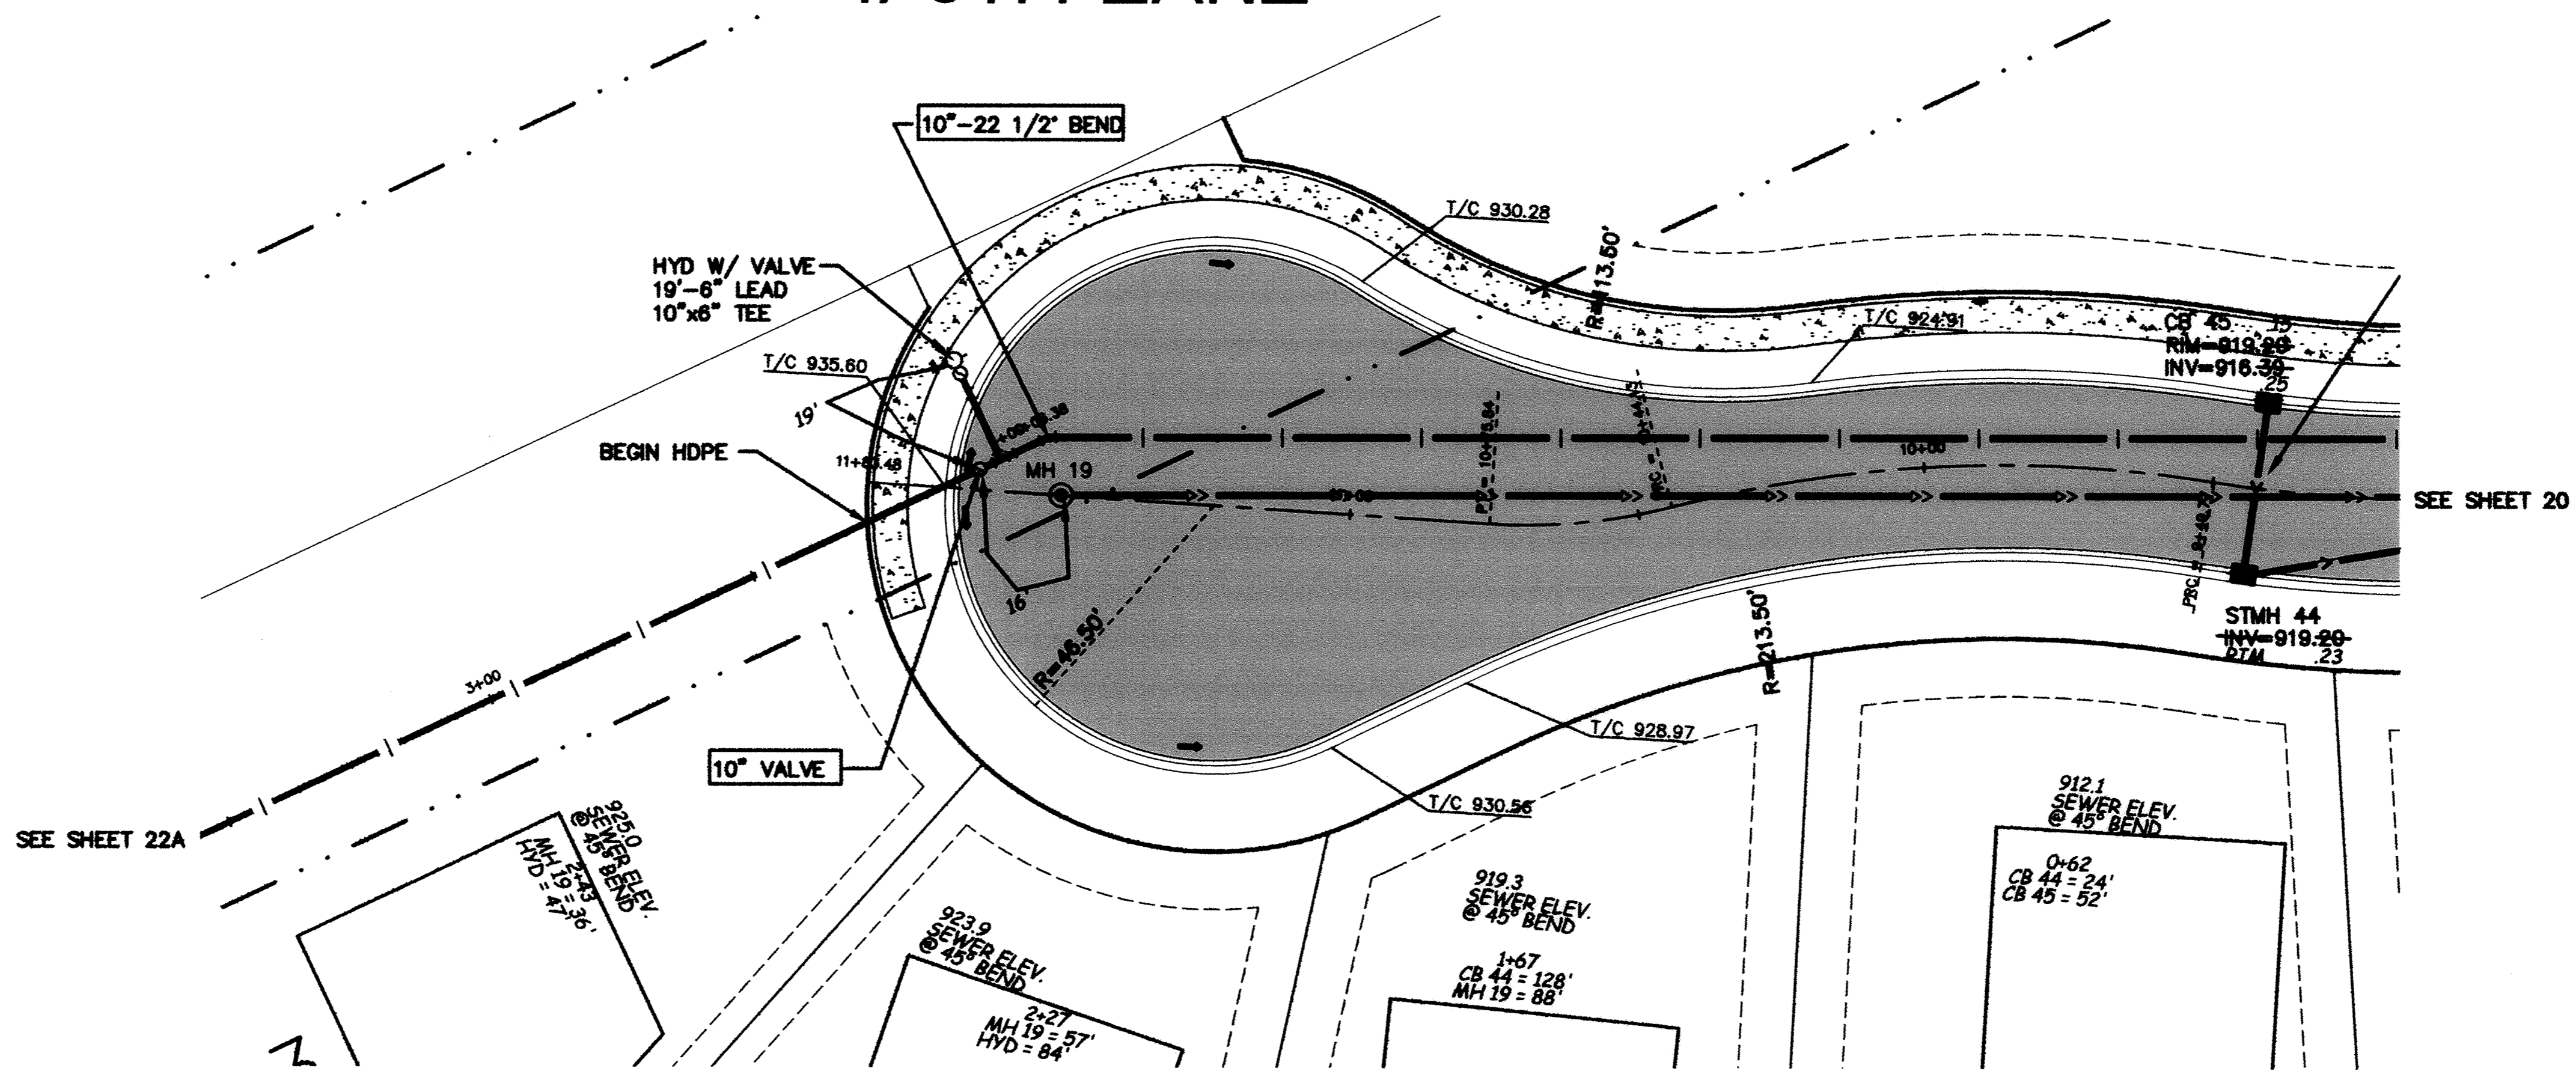


# 176TH LANE

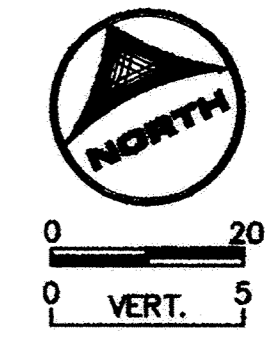

**RECORD PLAN  
DECEMBER 2002**

DESIGNED BY: KT/EY DRAWN BY: EY/JM  
 APPROVED BY: APPROVED BY JOB NUMBER 815361J  
 CAD DATE: April 04, 2003 8:25:52 a.m.  
 CAD FILE: 815361J\dwg\176TH.DWG (JLALLEN)

I HEREBY CERTIFY THAT THIS PLAN, SPECIFICATION, OR REPORT WAS PREPARED BY ME OR UNDER MY DIRECT SUPERVISION AND THAT I AM A DULY LICENSED PROFESSIONAL ENGINEER UNDER THE LAWS OF THE STATE OF MINNESOTA.  
 SIGNATURE: \_\_\_\_\_ DATE: \_\_\_\_\_  
 PRINTED NAME: TERRY J. MAURER LIC. NO. 15316

NO.	DATE	BY	REVISION DESCRIPTION

1326 ENERGY PARK DRIVE  
 ST. PAUL, MINNESOTA 55108  
 (651) 644-4389

**Howard R. Green Company**  
 CONSULTING ENGINEERS

**PARK POINTE**  
 CITY OF ELK RIVER

**176TH LANE**  
 STREET AND UTILITY IMPROVEMENTS 9+50 TO 12+00

SHEET NO.  
**21**