


SEE SHEET 21

SEE SHEET 17

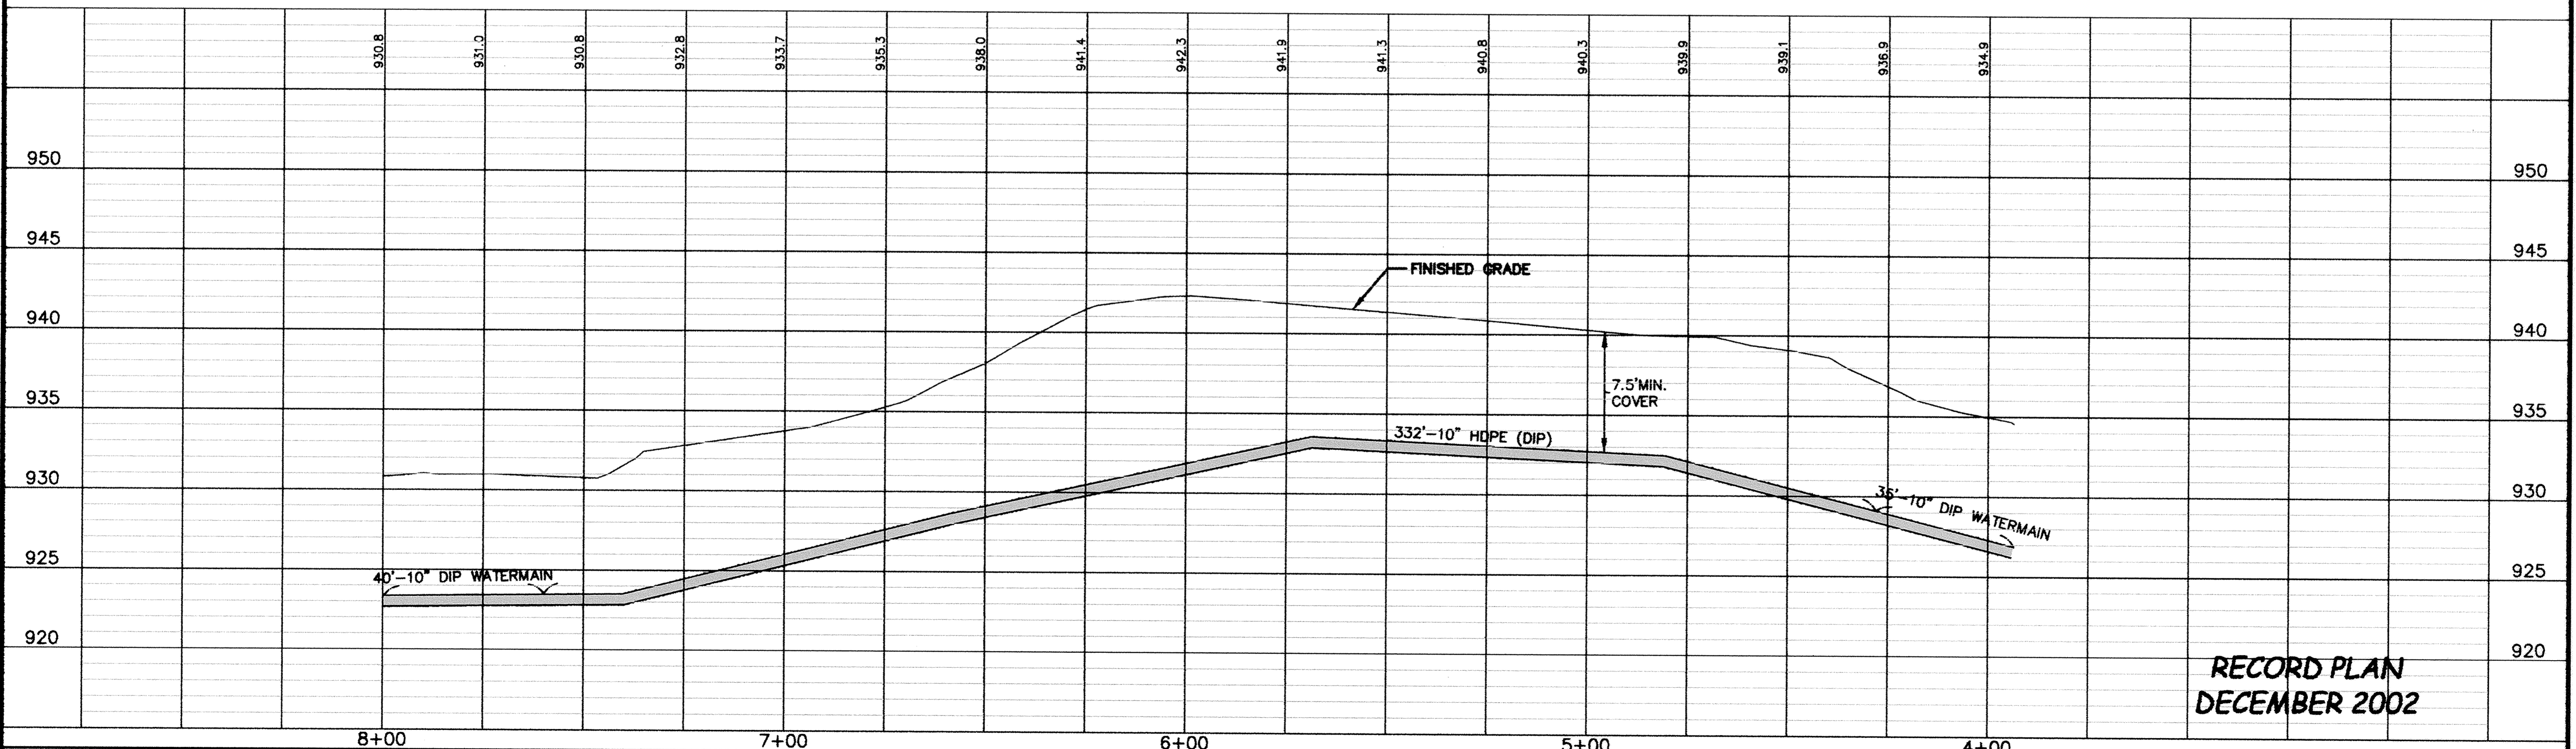

**RECORD PLAN
DECEMBER 2002**

DESIGNED BY: <u>KT/EY</u> DRAWN BY: <u>EY/JM</u> APPROVED BY: <u>APPROVED BY</u> JOB NUMBER <u>815361J</u> CAD DATE: <u>January 22, 2003 10:41:41 a.m.</u> CAD FILE: <u>815361J\dwg\WATERMAIN-CONN.DWG (JLALLIN)</u>	SIGNATURE: _____ DATE: _____ PRINTED NAME: <u>TERRY J. MAURER</u> LIC. NO.: <u>15316</u>	<table border="1" style="width:100%; border-collapse: collapse;"> <thead> <tr> <th style="width:5%;">NO.</th> <th style="width:15%;">DATE</th> <th style="width:15%;">BY</th> <th style="width:65%;">REVISION DESCRIPTION</th> </tr> </thead> <tbody> <tr><td> </td><td> </td><td> </td><td> </td></tr> <tr><td> </td><td> </td><td> </td><td> </td></tr> <tr><td> </td><td> </td><td> </td><td> </td></tr> </tbody> </table>	NO.	DATE	BY	REVISION DESCRIPTION													 Howard R. Green Company CONSULTING ENGINEERS <small>1326 ENERGY PARK DRIVE ST. PAUL, MINNESOTA 55108 (651) 644-4389</small>	PARK POINTE CITY OF ELK RIVER	176TH COURT AND 176 LANE WATERMAIN CONNECTION STREET AND UTILITY IMPROVEMENTS 4+00 TO 8+48.63	SHEET NO. 22A
NO.	DATE	BY	REVISION DESCRIPTION																			