
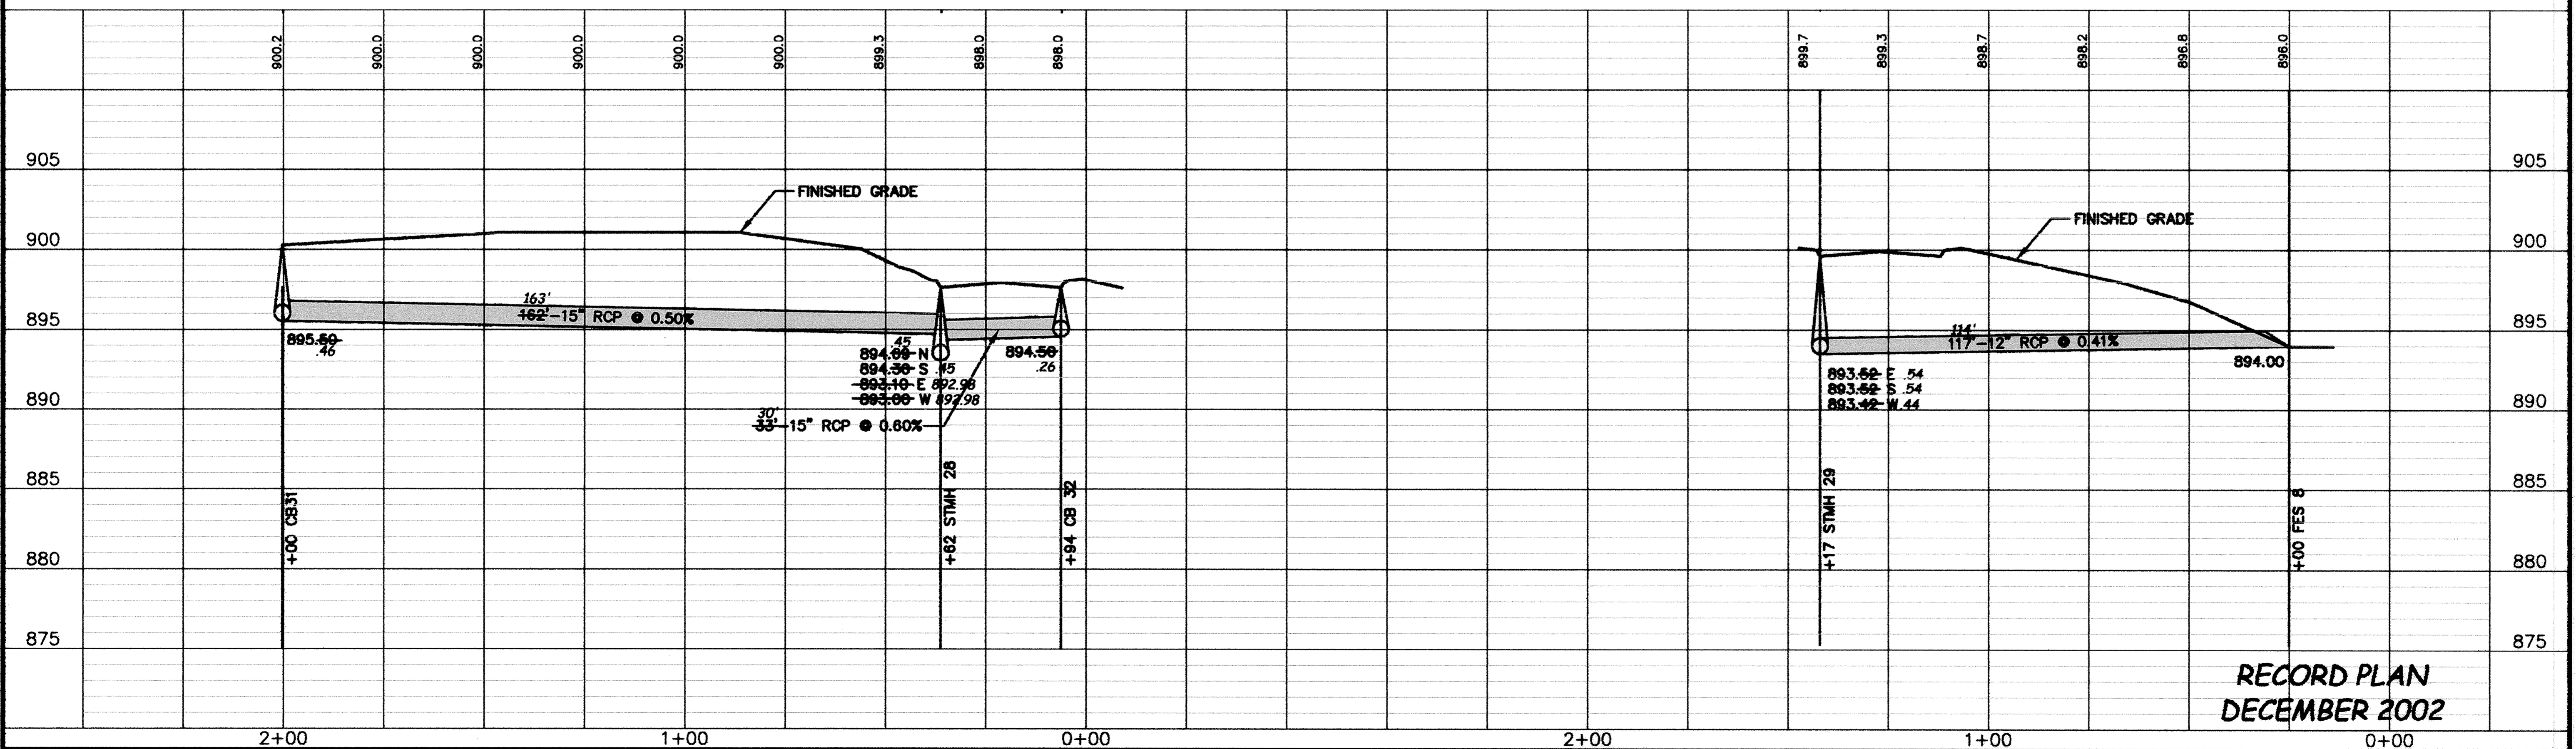
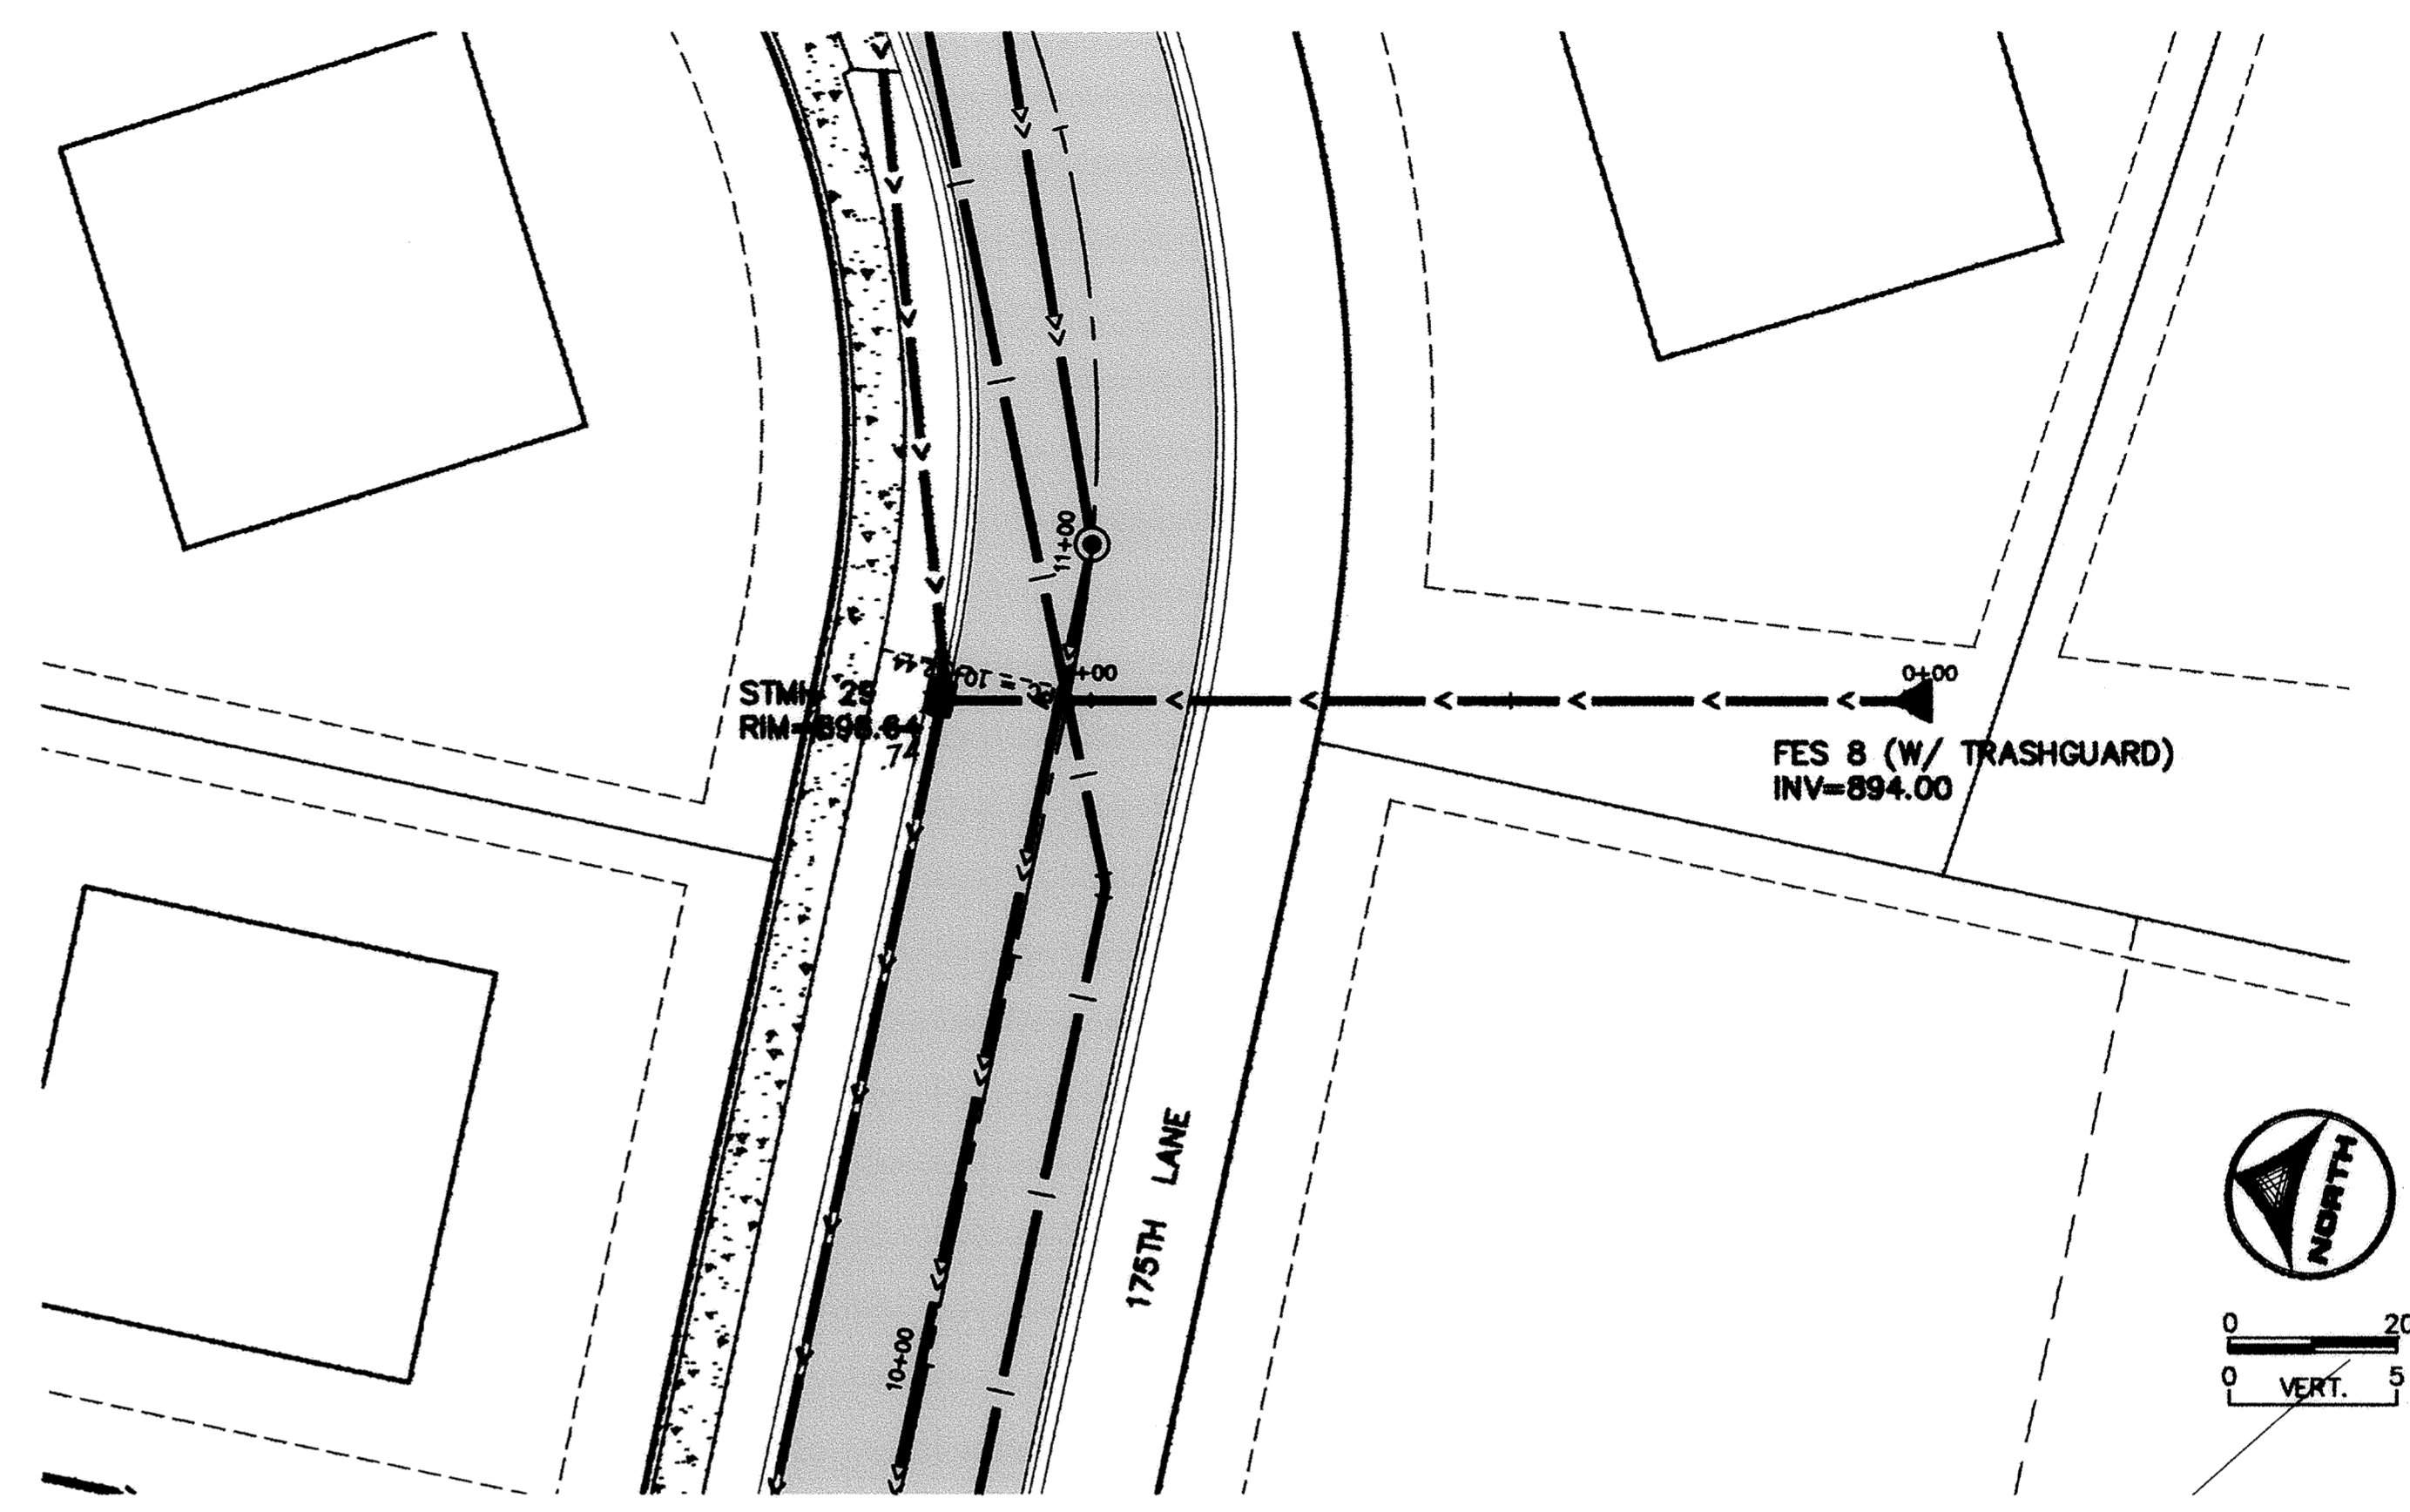


SDACO PRODUCTS • NEW HOPE, MINNESOTA
 PROJECTS BY PART NUMBER 8552
 SDACO PRODUCTS • NEW HOPE, MINNESOTA
 PROJECTS BY PART NUMBER 8552
 SDACO PRODUCTS • NEW HOPE, MINNESOTA
 PROJECTS BY PART NUMBER 8552
 SDACO PRODUCTS • NEW HOPE, MINNESOTA
 PROJECTS BY PART NUMBER 8552

SEE SHEET 12

SEE SHEET 12

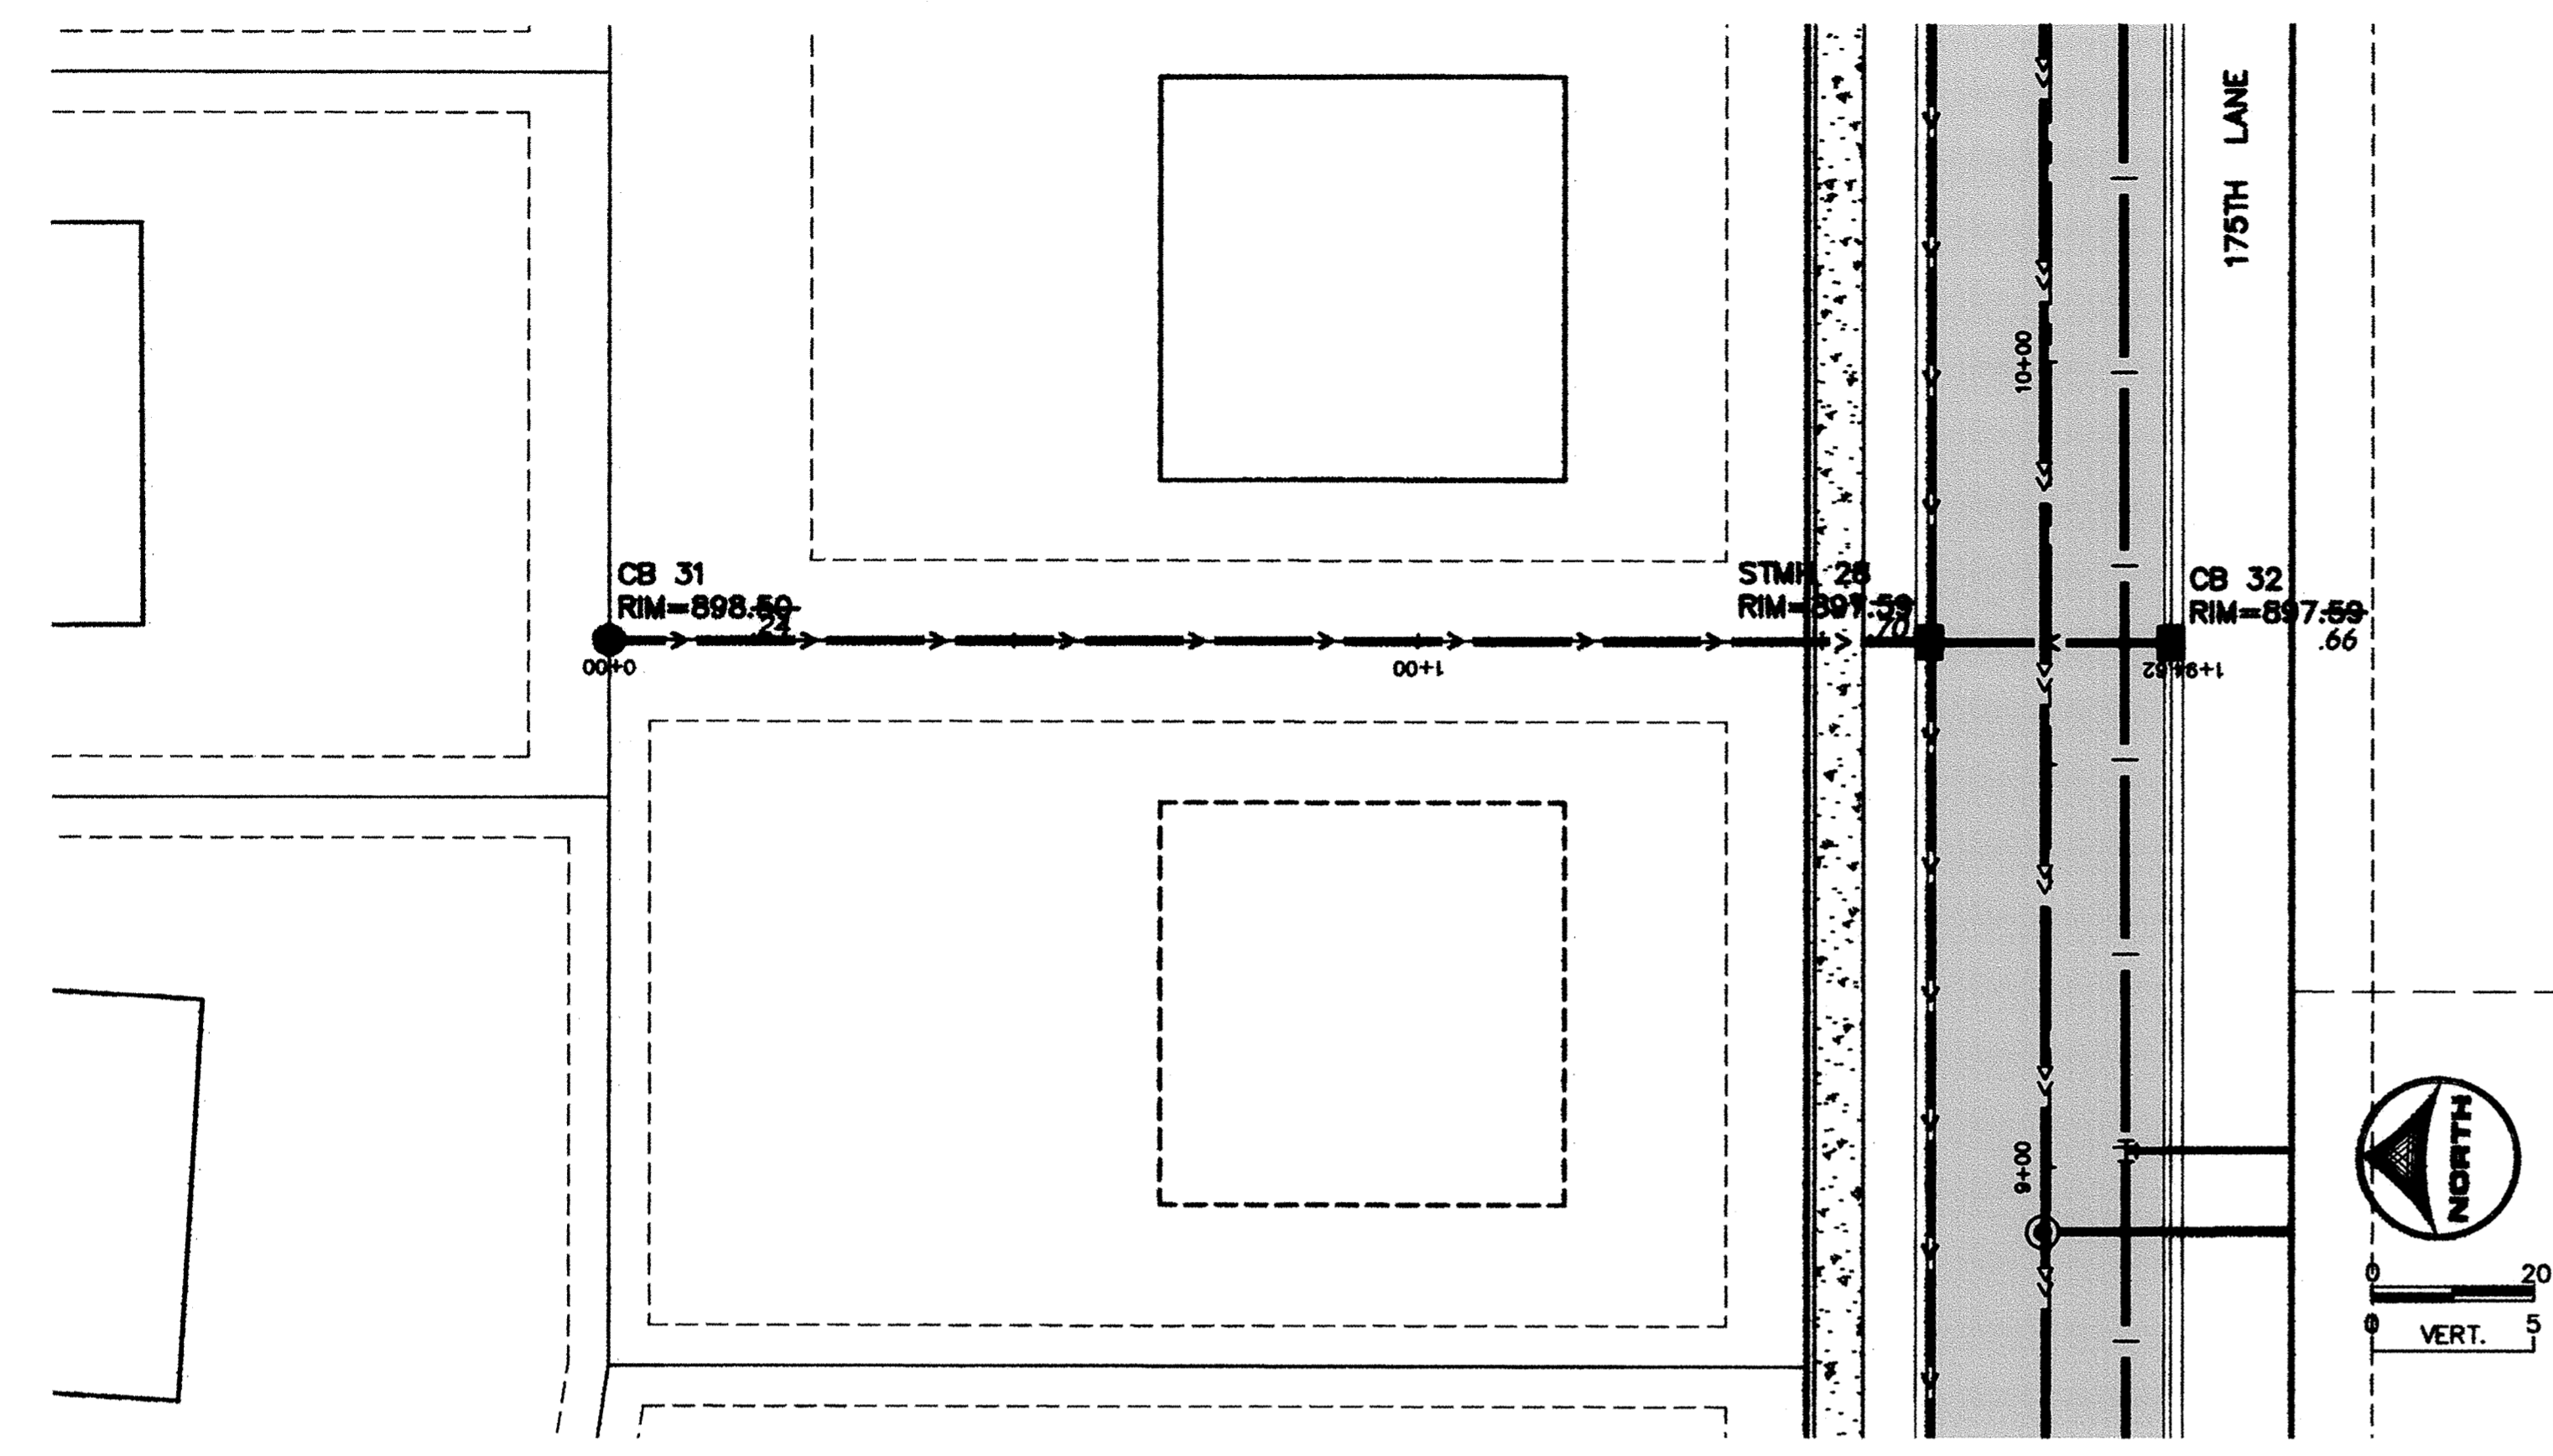

**RECORD PLAN
DECEMBER 2002**

DESIGNED BY: KT/EY DRAWN BY: EY/JM
 APPROVED BY: APPROVED BY JOB NUMBER 815361J
 CAD DATE: January 09, 2003 8:47:39 a.m.
 CAD FILE: 815361J\dwg\STORM_3.DWG (JLALLEN)

I HEREBY CERTIFY THAT THIS PLAN, SPECIFICATION, OR REPORT WAS PREPARED BY ME OR UNDER MY DIRECT SUPERVISION AND THAT I AM A DULY LICENSED PROFESSIONAL ENGINEER UNDER THE LAWS OF THE STATE OF MINNESOTA.
 SIGNATURE: _____ DATE: _____
 PRINTED NAME: TERRY J. MAURER LIC. NO. 15316

NO.	DATE	BY	REVISION DESCRIPTION

1326 ENERGY PARK DRIVE
 ST. PAUL, MINNESOTA 55108
 (651) 644-4389
Howard R Green Company
 CONSULTING ENGINEERS

PARK POINTE
 CITY OF ELK RIVER

STORM SEWER
 STREET AND UTILITY IMPROVEMENTS 0+00 TO END

SHEET NO.
26