
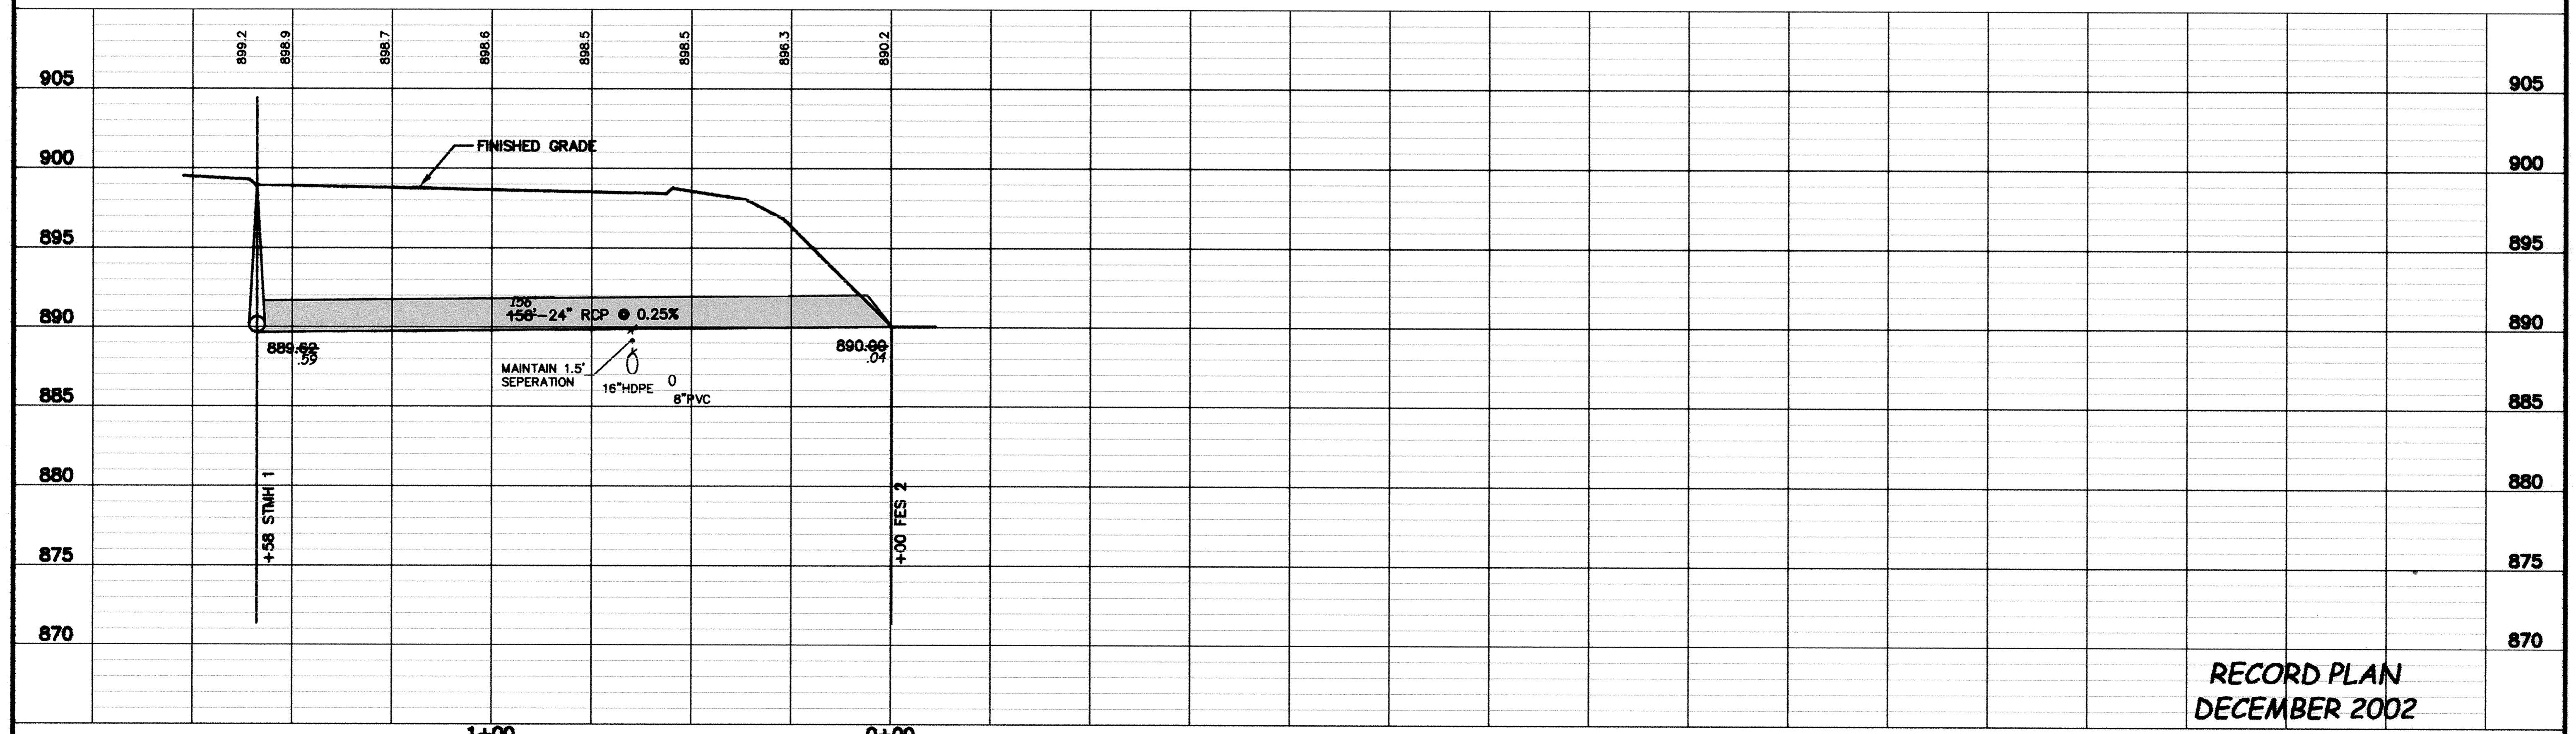
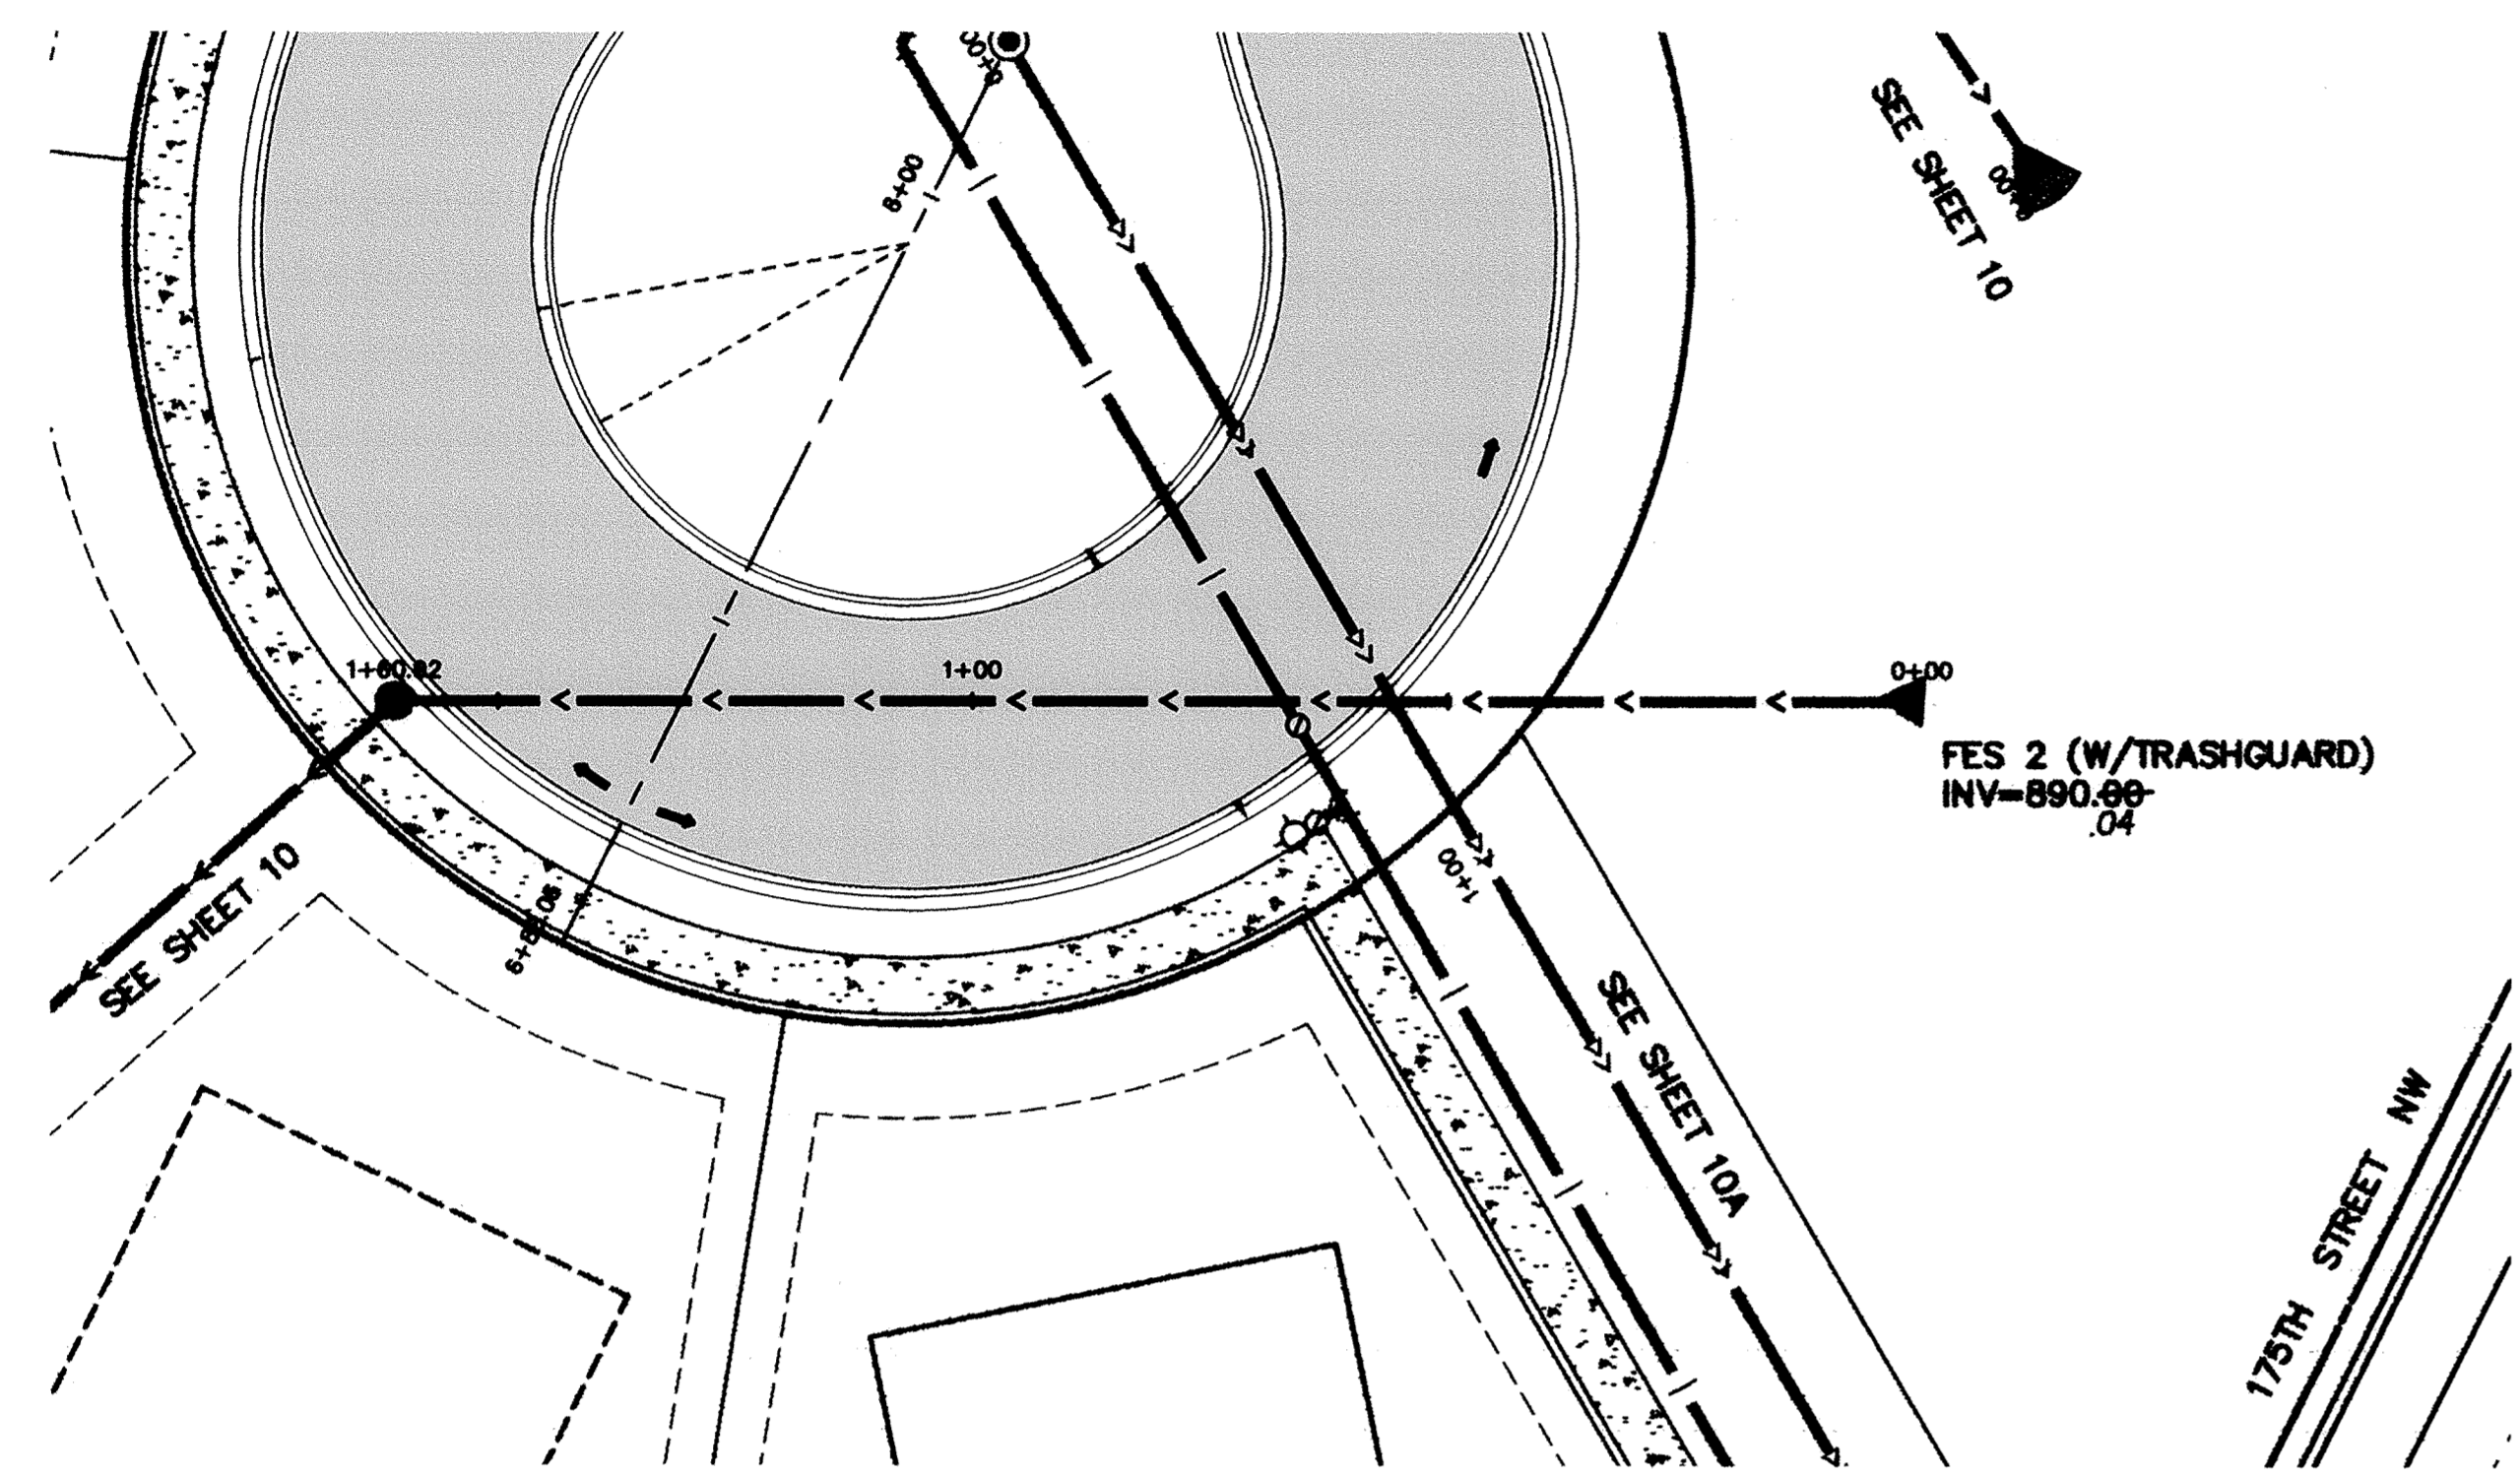


CO. PRODUCTS • NEW HOPE, MINNESOTA  
REQUESTED BY: PARK NUMBER 8582  
SANDOZ PRODUCTS • NEW HOPE, MINNESOTA  
REQUESTED BY: PARK NUMBER 8582  
SANDOZ PRODUCTS • NEW HOPE, MINNESOTA  
REQUESTED BY: PARK NUMBER 8582  
SANDOZ PRODUCTS • NEW HOPE, MINNESOTA  
REQUESTED BY: PARK NUMBER 8582

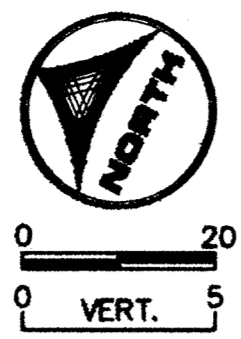

RECORD PLAN  
DECEMBER 2002

DESIGNED BY: KT/EY    DRAWN BY: EY/JM  
APPROVED BY: APPROVED BY    JOB NUMBER 815361J  
CAD DATE: January 09, 2003 8:52:20 a.m.  
CAD FILE: 815361J.dwg\STORMB.DWG (JLALLEN)

I HEREBY CERTIFY THAT THIS PLAN, SPECIFICATION, OR REPORT  
WAS PREPARED BY ME OR UNDER MY DIRECT SUPERVISION AND  
THAT I AM A DULY LICENSED PROFESSIONAL ENGINEER UNDER  
THE LAWS OF THE STATE OF MINNESOTA.  
SIGNATURE: \_\_\_\_\_ DATE: \_\_\_\_\_  
PRINTED NAME: TERRY J. MAURER    LIC. NO. 15316

NO.	DATE	BY	REVISION DESCRIPTION

1326 ENERGY PARK DRIVE  
ST. PAUL, MINNESOTA 55108  
(651) 644-4389  
**Howard R. Green Company**  
CONSULTING ENGINEERS

**PARK PONTE**  
CITY OF ELK RIVER

STORM SEWER  
STREET AND UTILITY IMPROVEMENTS    0+00 TO END

SHEET NO.  
**28**