


- NOTES:**
1. STATIONING SHOWN FOR MANHOLE IS CENTERLINE STREET STATIONING.
 2. SERVICE WYE STATIONING IS FROM DOWNSTREAM MANHOLE.
 3. EXTEND SERVICES TO PROPERTY WHERE NO SIDEWALK IS PROPOSED AND TO 9' BEHIND PROPERTY LINE WHERE SIDEWALK IS PROPOSED.
 4. STATIONING FOR CURB STOPS IS CENTERLINE STREET STATIONING.
 5. FUTURE SINGLE FAMILY LOT WATER SERVICES SHALL BE 1" TYPE K COPPER TUBE. TOWNHOME BUILDING SERVICES SHALL BE 6" DIP.
 6. SANITARY SEWER SERVICES SHALL BE 4" PVC, SCH. 40 UNLESS NOTED AS DEEP, THEN SERVICE SHALL BE DIP TO THE TOP OF THE MAIN RISER THEN TRANSITION TO PVC. TOWNHOME BUILDING SEWER SERVICES SHALL BE 6" PVC, SCH. 40.

WARNING
 THE CONTRACTOR SHALL CONTACT ALL PUBLIC UTILITIES FOR LOCATIONS OF ALL UNDERGROUND WIRES, CABLES, CONDUITS, PIPES, MANHOLES, VALVES, OR OTHER BURIED STRUCTURES BEFORE DIGGING. HE SHALL REPAIR OR REPLACE THE ABOVE WHEN DAMAGED DURING CONSTRUCTION AT NO COST TO OWNER.

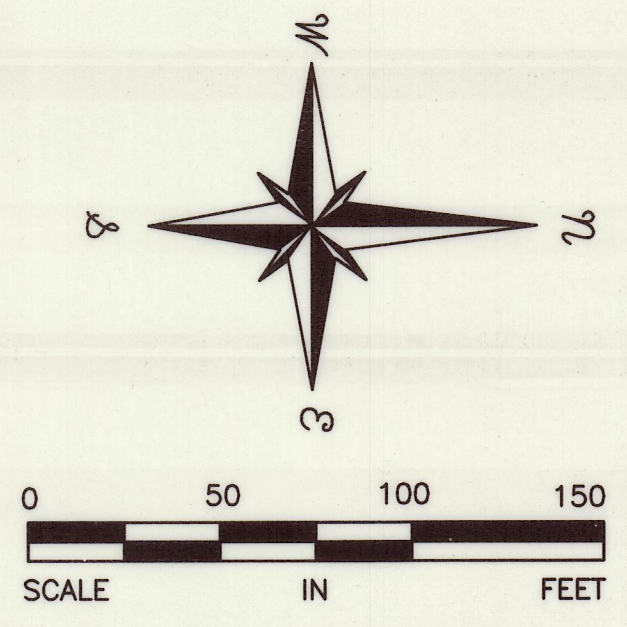


FOSTER PROPERTY

SANITARY WYES AND RISER PIPE ONLY - NO WATER SERVICES

FUTURE STREET

MH3 - MH17 & MH1F - MH7F RIM ELEVATIONS ARE NOT TO FINAL GRADE. ROAD IS UNDER CONSTRUCTION.

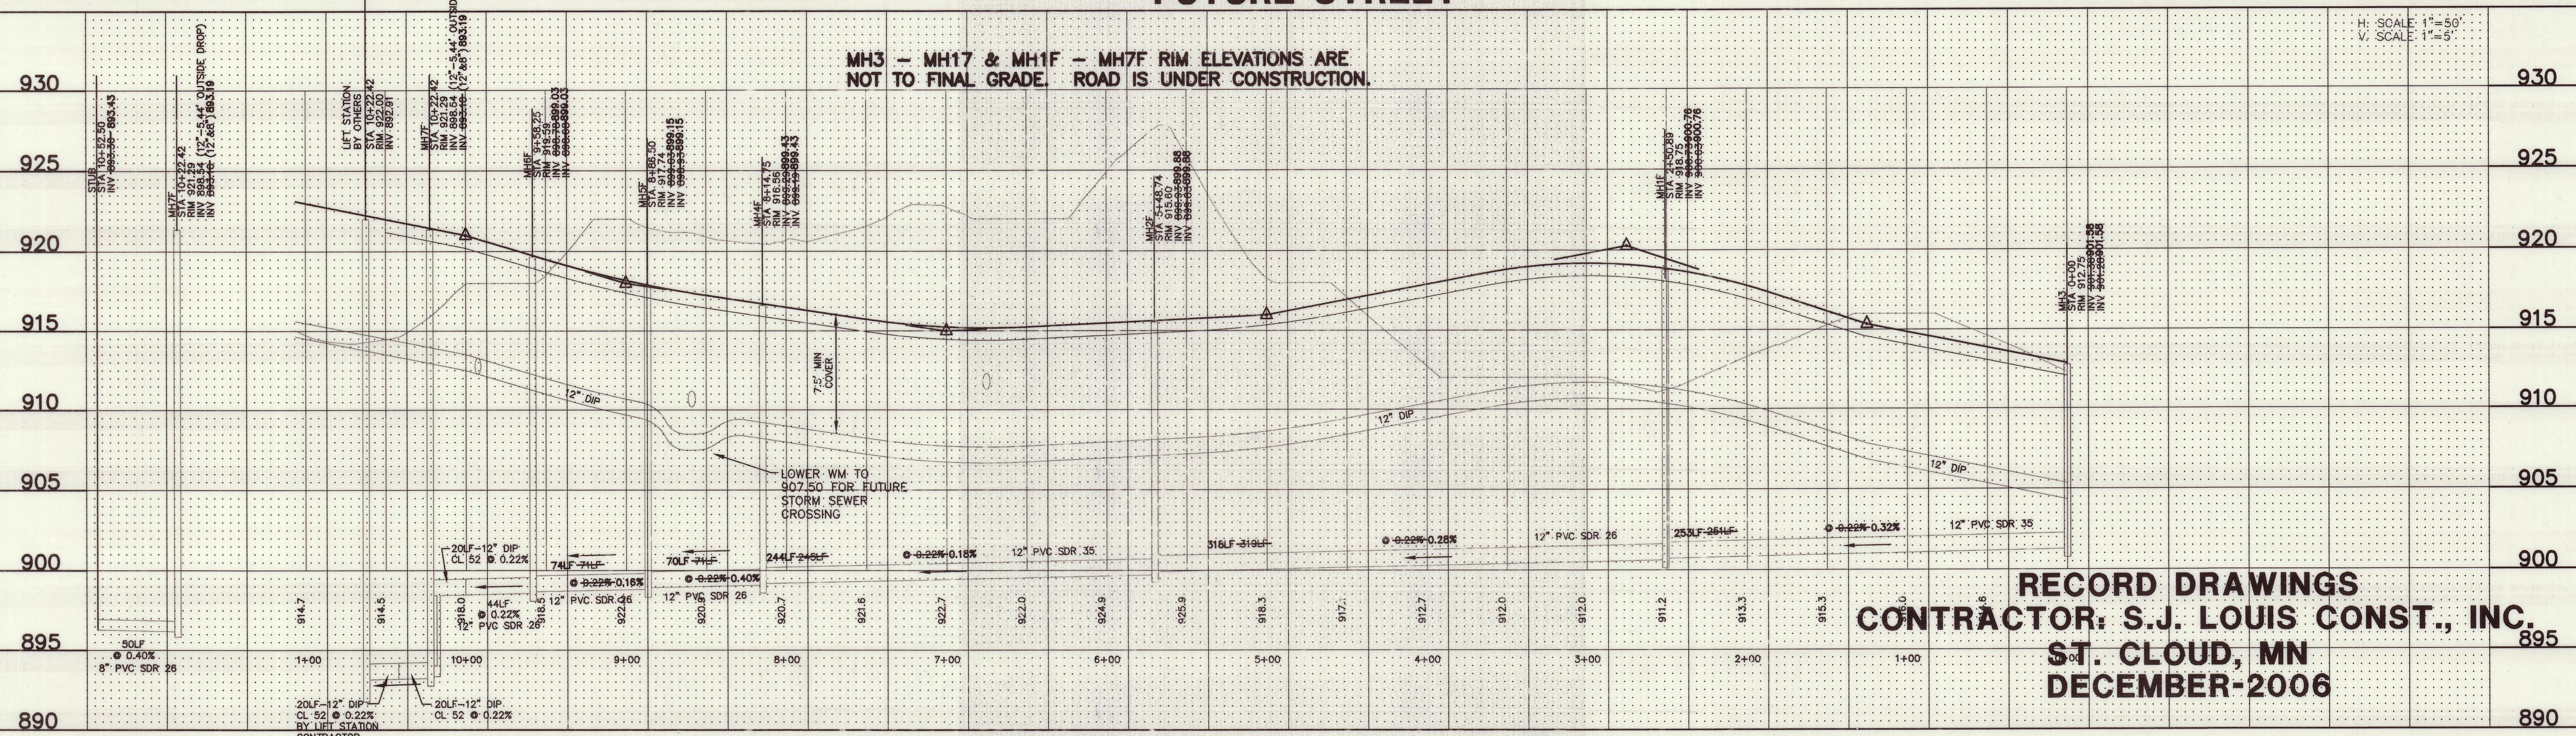

RECORD DRAWINGS
CONTRACTOR: S.J. LOUIS CONST., INC.
ST. CLOUD, MN
DECEMBER-2006

Date:	Description:	By:	Date:	Description:	By:
9-20-05	REVISIONS PER CITY COMMENTS	BDR	12-21-06	UTILITY ASBUILTS	BB
10-05-05	SERVICES, RIMS, GV LOCATIONS	CB			
10-18-05	CITY COMMENTS	BDR			
11-07-05	GENERAL REVISIONS	BDR			

I hereby certify that this plan was prepared by me or under my direct supervision and that I am a Licensed Professional Engineer under the laws of the State of Minnesota.
 Brian Robideau
 Date: 08/23/05 Reg. No. 43382

Designed By: BDR
 Drawn By: BDR
 Checked By: KA

Schoell & Madson, Inc.
 Engineering • Surveying • Planning
 www.schoellmadson.com
 10580 Wayzata Boulevard, Suite 1 Minneapolis, Minnesota 55305-1525 phone: (952) 546-7601 - fax: (952) 546-9065
 554 Third Street NW, Suite 100 Elk River, Minnesota 55330-1409 phone: (763) 241-9106 - fax: (652) 546-9065

Client: **Orrin Thompson Homes**
 935 East Wayzata Boulevard
 Wayzata, Minnesota 55391
 19521 249-3076

Project Name/Location: **River Park**
 Elk River, Minnesota
 Date: **08/23/05**
 Sheet Title: **UTILITY CONSTRUCTION**
FOSTER PROPERTY
 Sheet: **UTIL2**