


**WARNING**

THE CONTRACTOR SHALL CONTACT ALL PUBLIC UTILITIES FOR LOCATIONS OF ALL UNDERGROUND WIRES, CABLES, CONDUITS, PIPES, MANHOLES, VALVES, OR OTHER BURIED STRUCTURES BEFORE DIGGING. HE SHALL REPAIR OR REPLACE THE ABOVE WHEN DAMAGED DURING CONSTRUCTION AT NO COST TO OWNER.

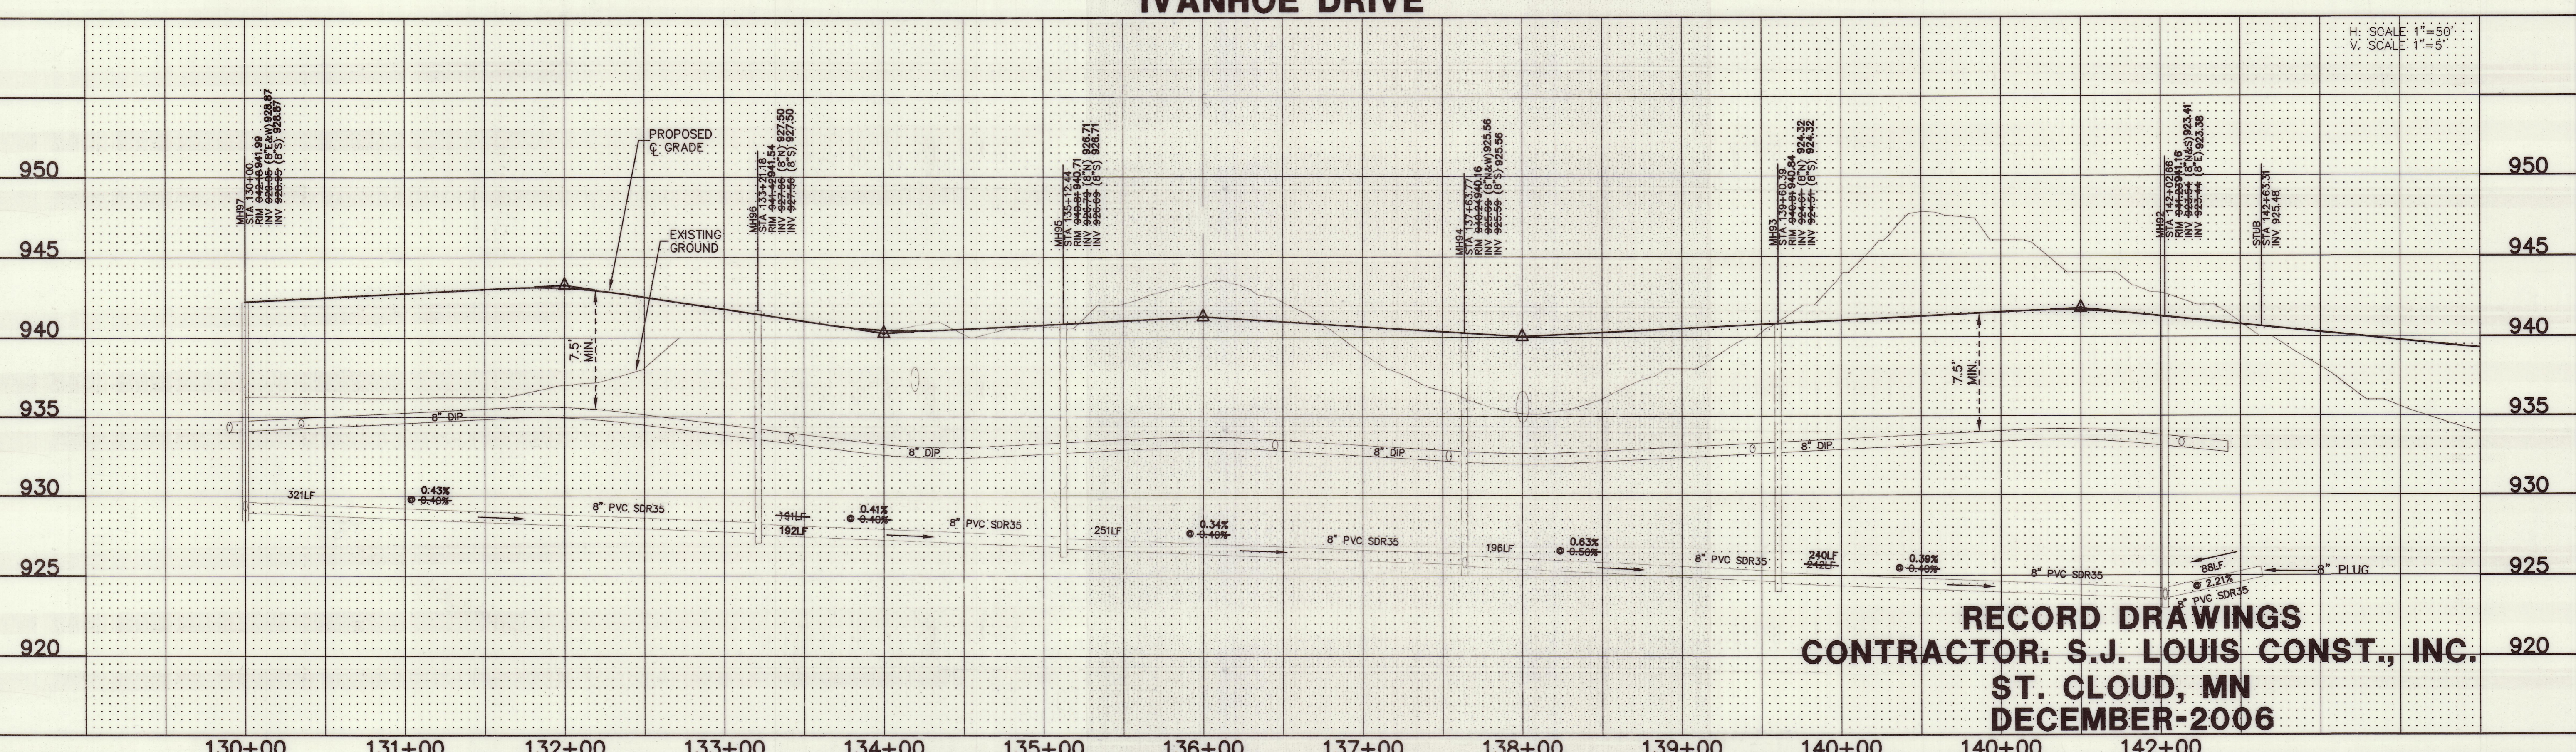

**RECORD DRAWINGS**  
**CONTRACTOR: S.J. LOUIS CONST., INC.**  
**ST. CLOUD, MN**  
**DECEMBER-2006**

Revisions	Date:	Description:	By:	Date:	Description:	By:
9-20-05		REVISIONS PER CITY COMMENTS	BDR			
10-12-05		CITY COMMENTS	BDR			
11-07-05		GENERAL REVISIONS	BDR			
12-22-06		UTILITY ASBULTS	BB			

I hereby certify that this plan was prepared by me or under my direct supervision and that I am a Licensed Professional Engineer under the laws of the State of Minnesota.

Brian Robideau  
 Date: 08/23/05 Reg. No. 43382

Designed By: BDR  
 Drawn By: BDR  
 Checked By: KA

**Schoell & Madson, Inc.**  
 Engineering • Surveying • Planning

www.schoellmadson.com

10580 Wayzata Boulevard, Suite 1  
 Minneapolis, Minnesota 55305-1525  
 phone: (952) 546-7601 - fax: (952) 546-9065

554 Third Street NW, Suite 100  
 Elk River, Minnesota 55330-1409  
 phone: (763) 241-0008 - fax: (952) 546-9065

Client:

**Orrln Thompson Homes**  
 935 East Wayzata Boulevard  
 Wayzata, Minnesota 55391  
 19521 249-3076

Project Name/Location:  
**River Park**  
 Elk River, Minnesota

Sheet Title:  
**UTILITY CONSTRUCTION**  
**FILLMORE ST / 192nd LA**

Date:  
**08/23/05**

Sheet:  
**UTIL9**