

DRAWING NUMBER

DRAWING NUMBER

DRAWING NUMBER

DRAWING NUMBER  
RIVER.97  
1

SAICO PRODUCTS • NEW HOPE, MINNESOTA  
DESIGNED BY PAUL NAMBERTSON  
REPRODUCED BY PAUL NAMBERTSON

# RIVERVIEW DRIVE MACON STREET

## SANITARY SEWER, WATERMAIN, STORM SEWER AND STREET RECONSTRUCTION

I HEREBY CERTIFY THAT THIS PLAN, SPECIFICATION,  
OR REPORT WAS PREPARED BY ME OR UNDER MY DIRECT  
SUPERVISION AND THAT I AM A DULY REGISTERED  
PROFESSIONAL ENGINEER UNDER THE LAWS OF THE  
STATE OF MINNESOTA.

*Mark V. Graham*  
DATE 6/6/97 REG. NO. 19130



1326 ENERGY PARK DRIVE  
ST. PAUL, MINNESOTA 55108  
(612) 644-4389





PREPARED FOR:



JUNE 1997

SHEET 1 OF 20

RECORD PLAN  
FEBRUARY 1998

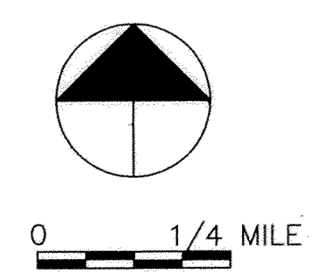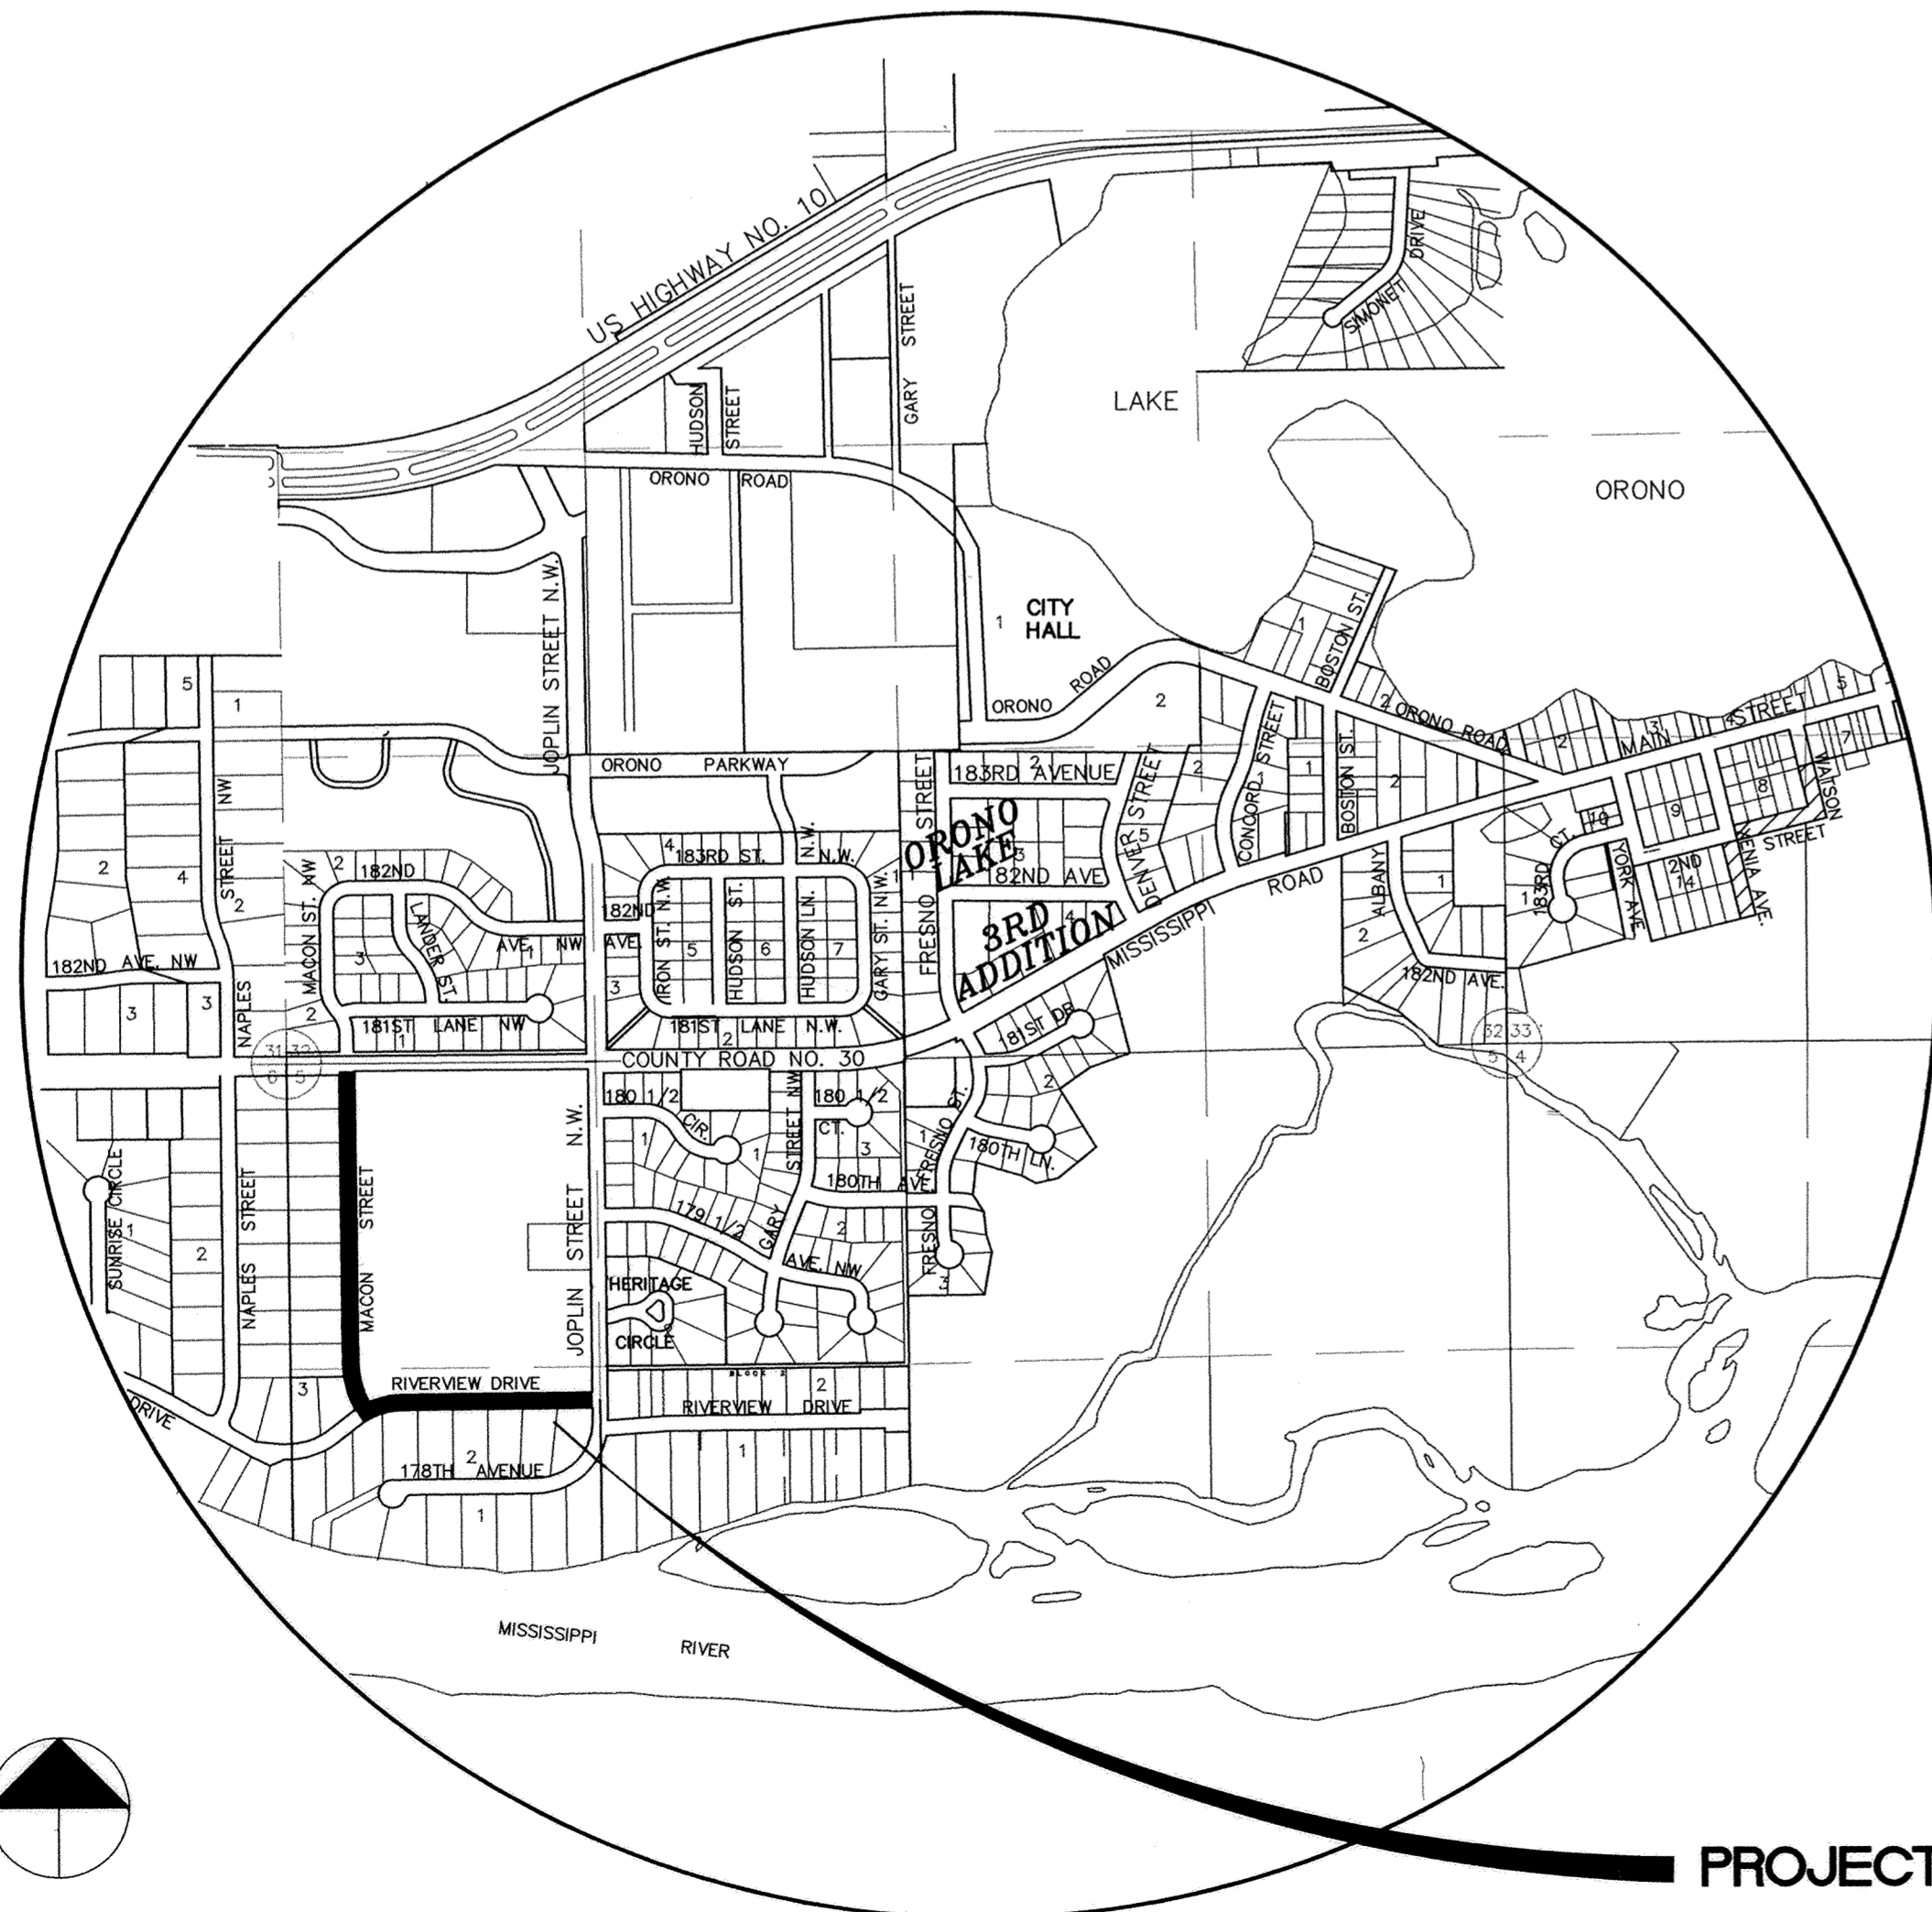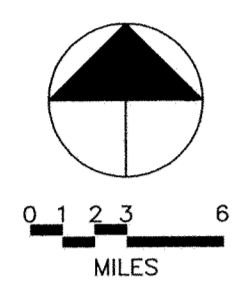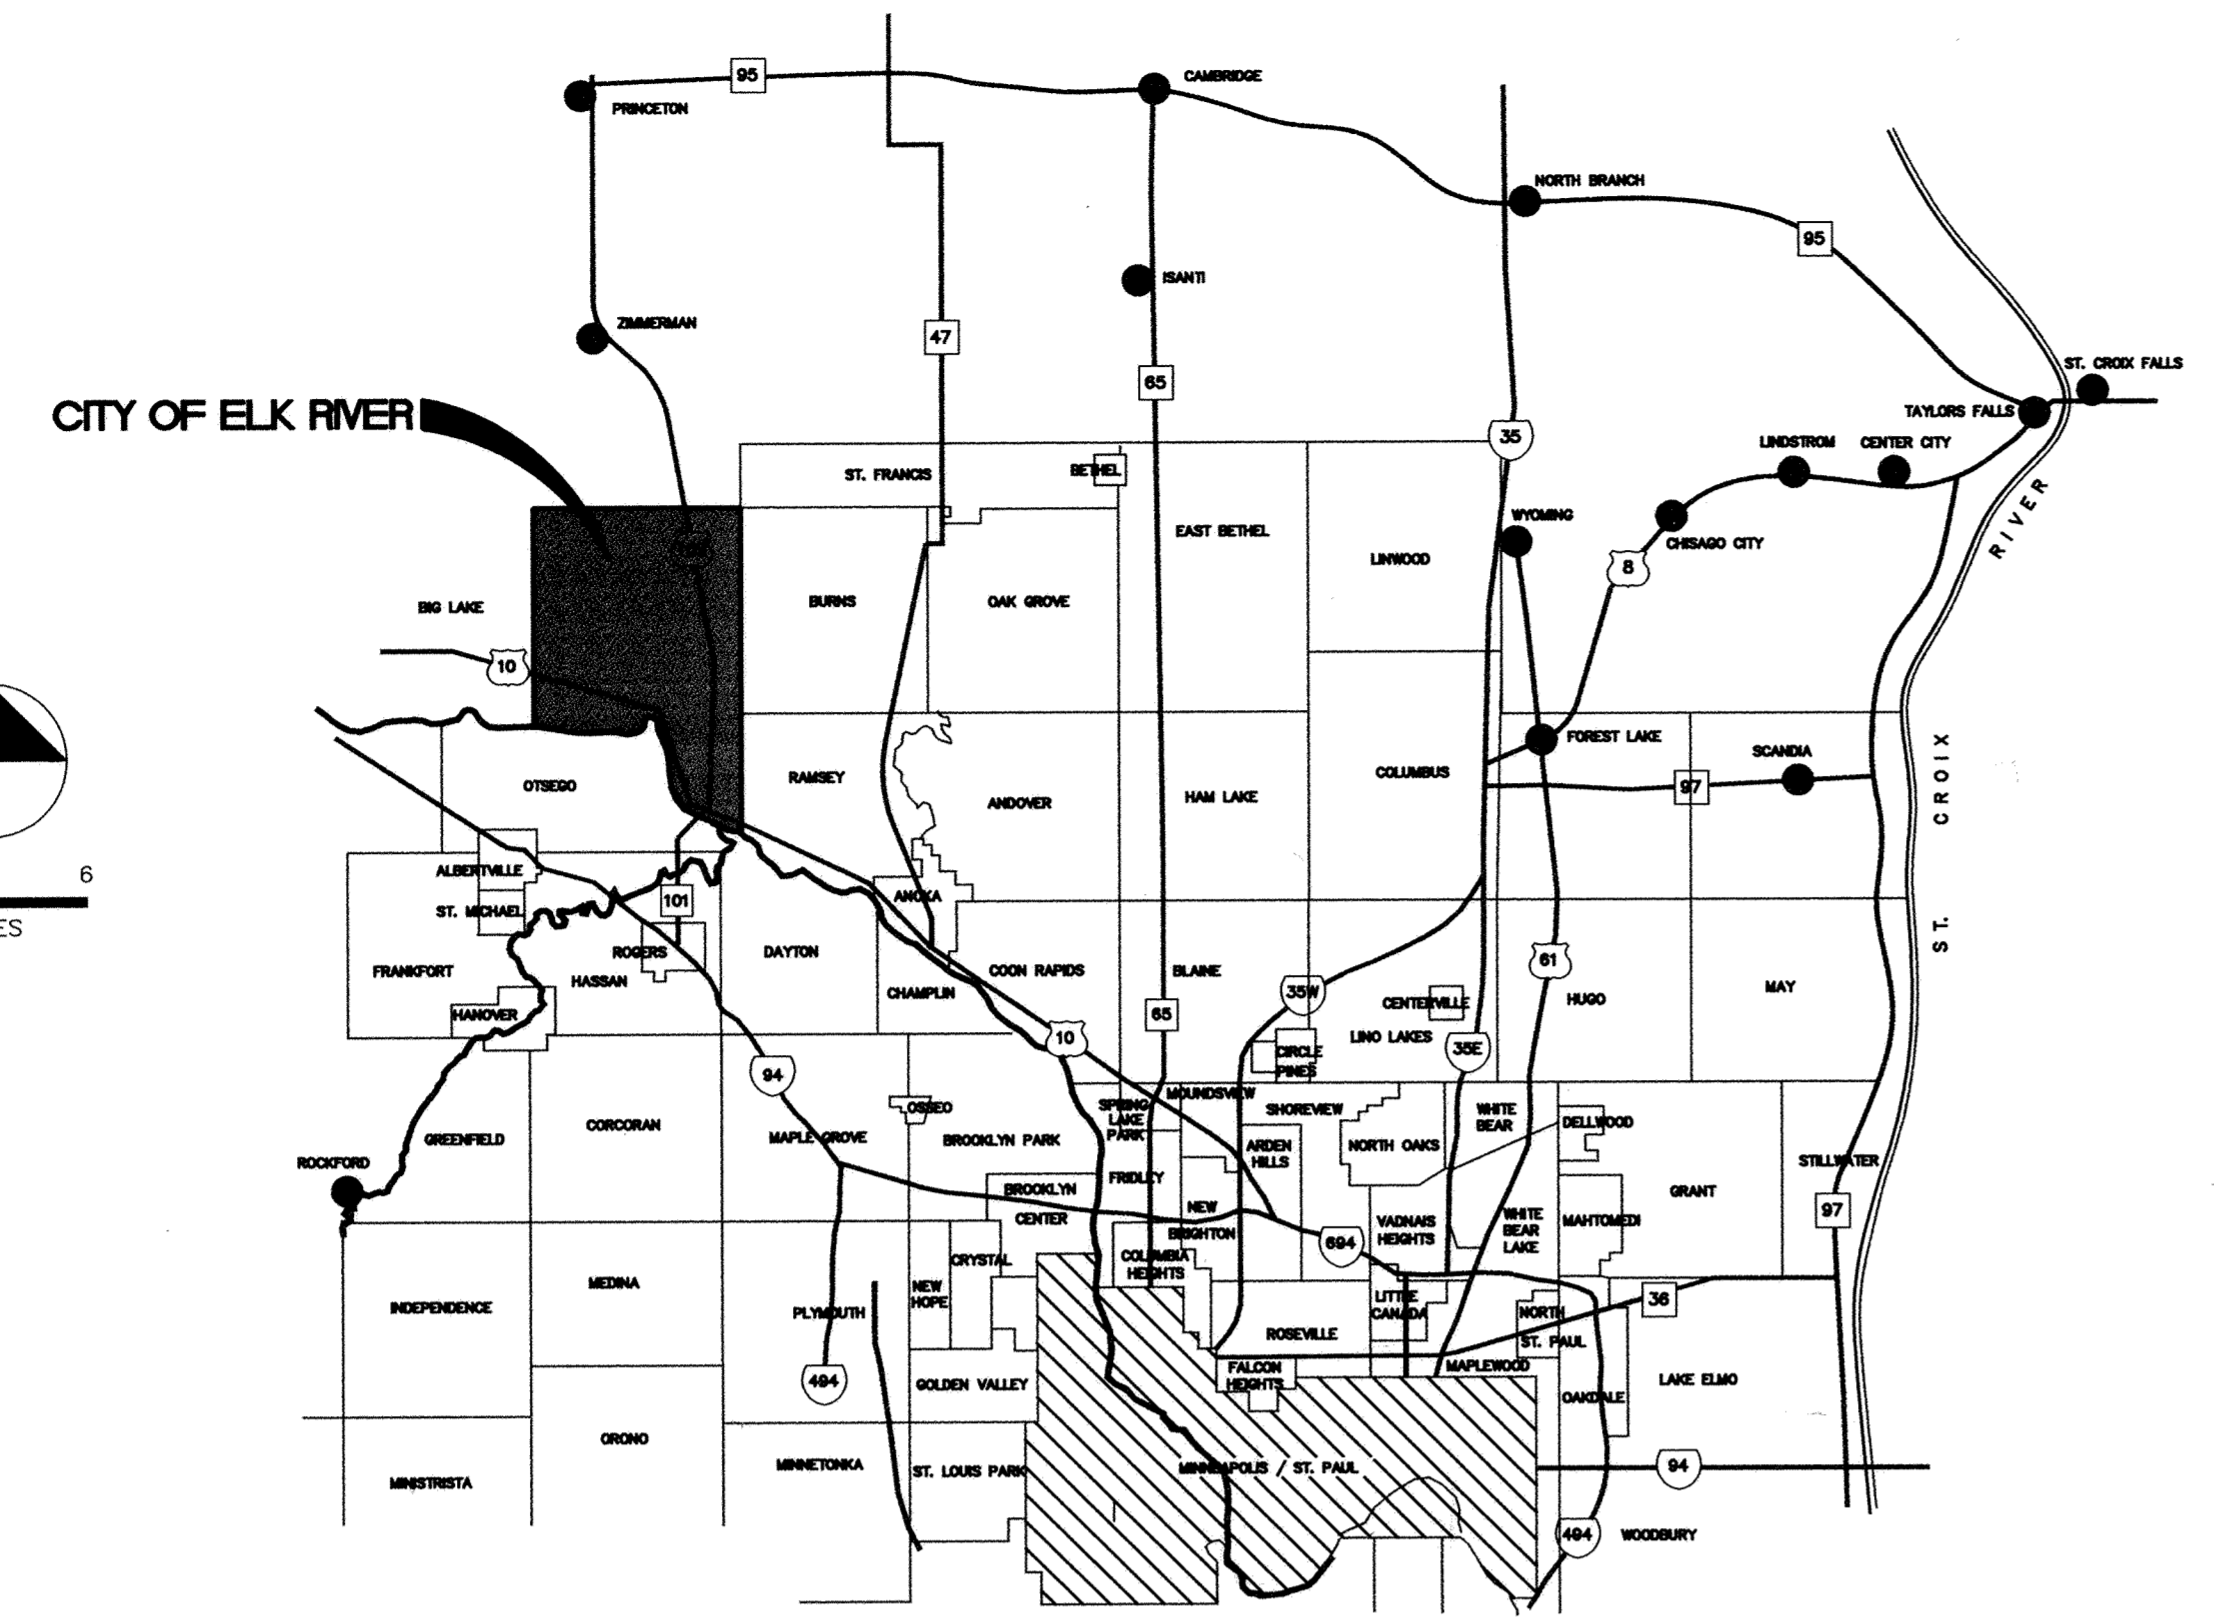

RIVERVIEW DRIVE/MACON STREET  
LOCATION MAP

PROJECT LOCATION