



COUNTY ROAD NO. 30

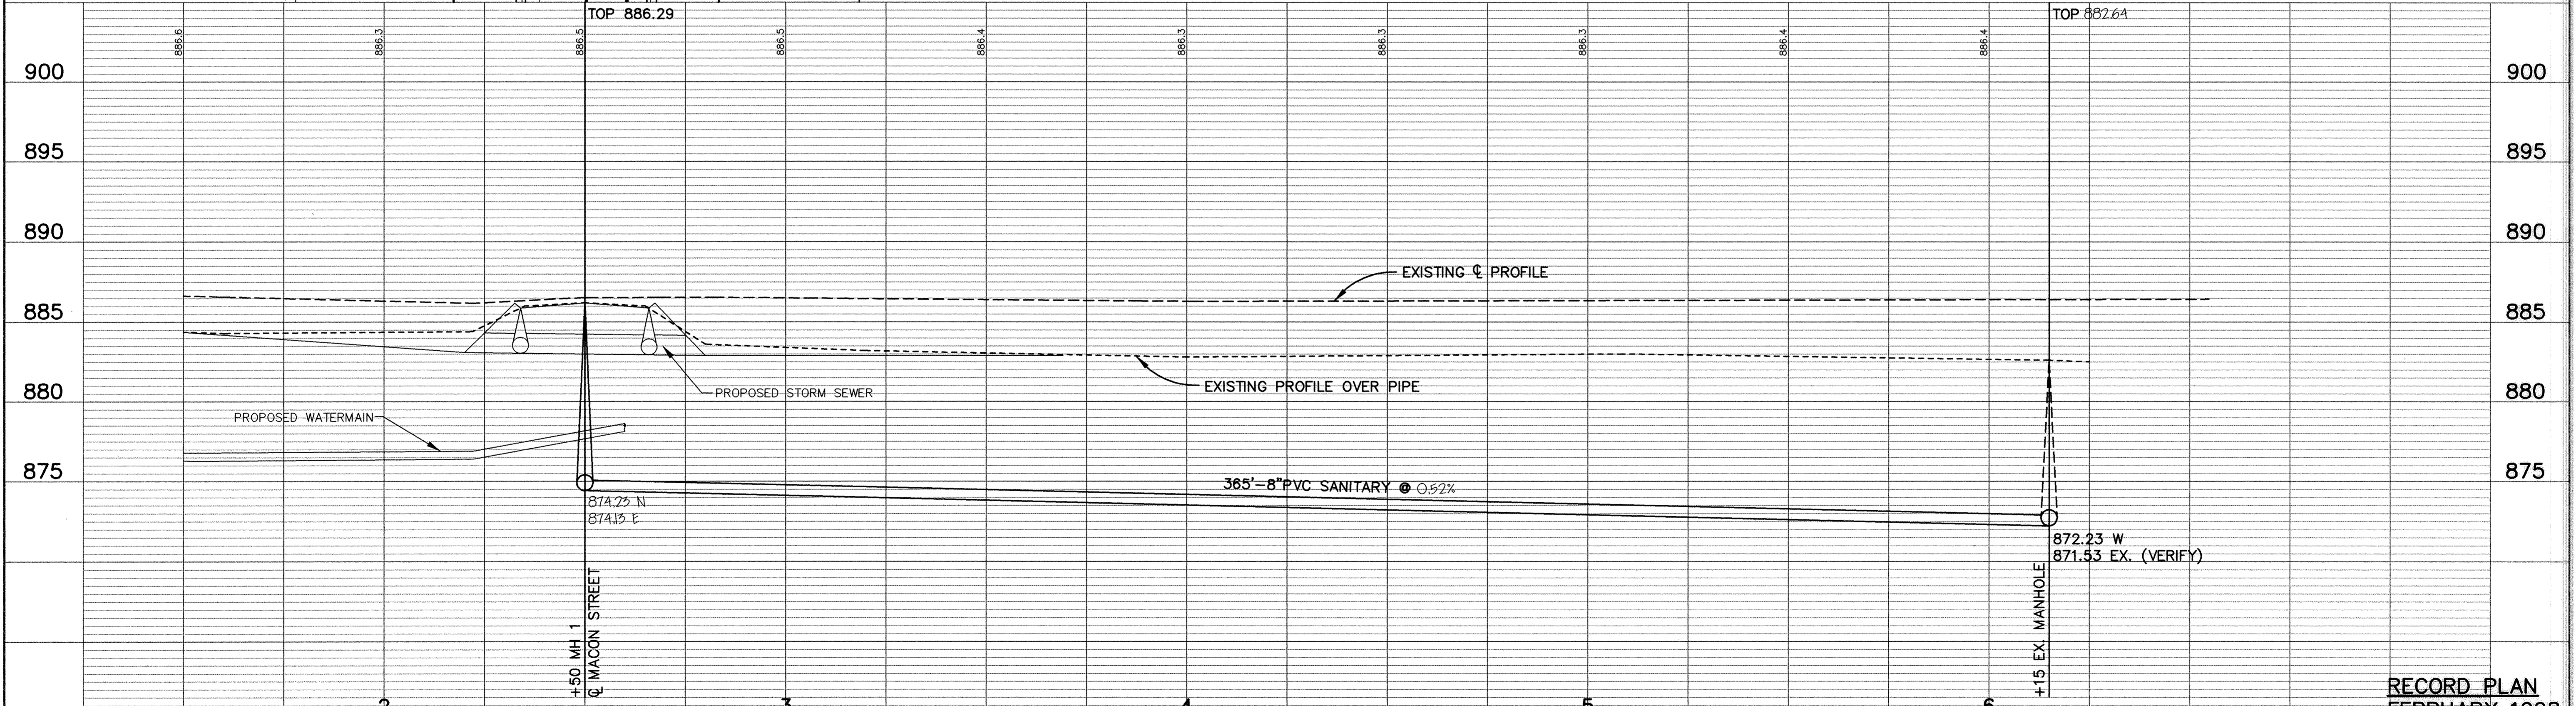

I HEREBY CERTIFY THAT THIS PLAN, SPECIFICATION, OR REPORT WAS PREPARED BY ME OR UNDER MY DIRECT SUPERVISION AND THAT I AM A DULY REGISTERED PROFESSIONAL ENGINEER UNDER THE LAWS OF THE STATE OF MINNESOTA.
Mark J. Graham
 DATE 3/16/98 REG. NO. 19130

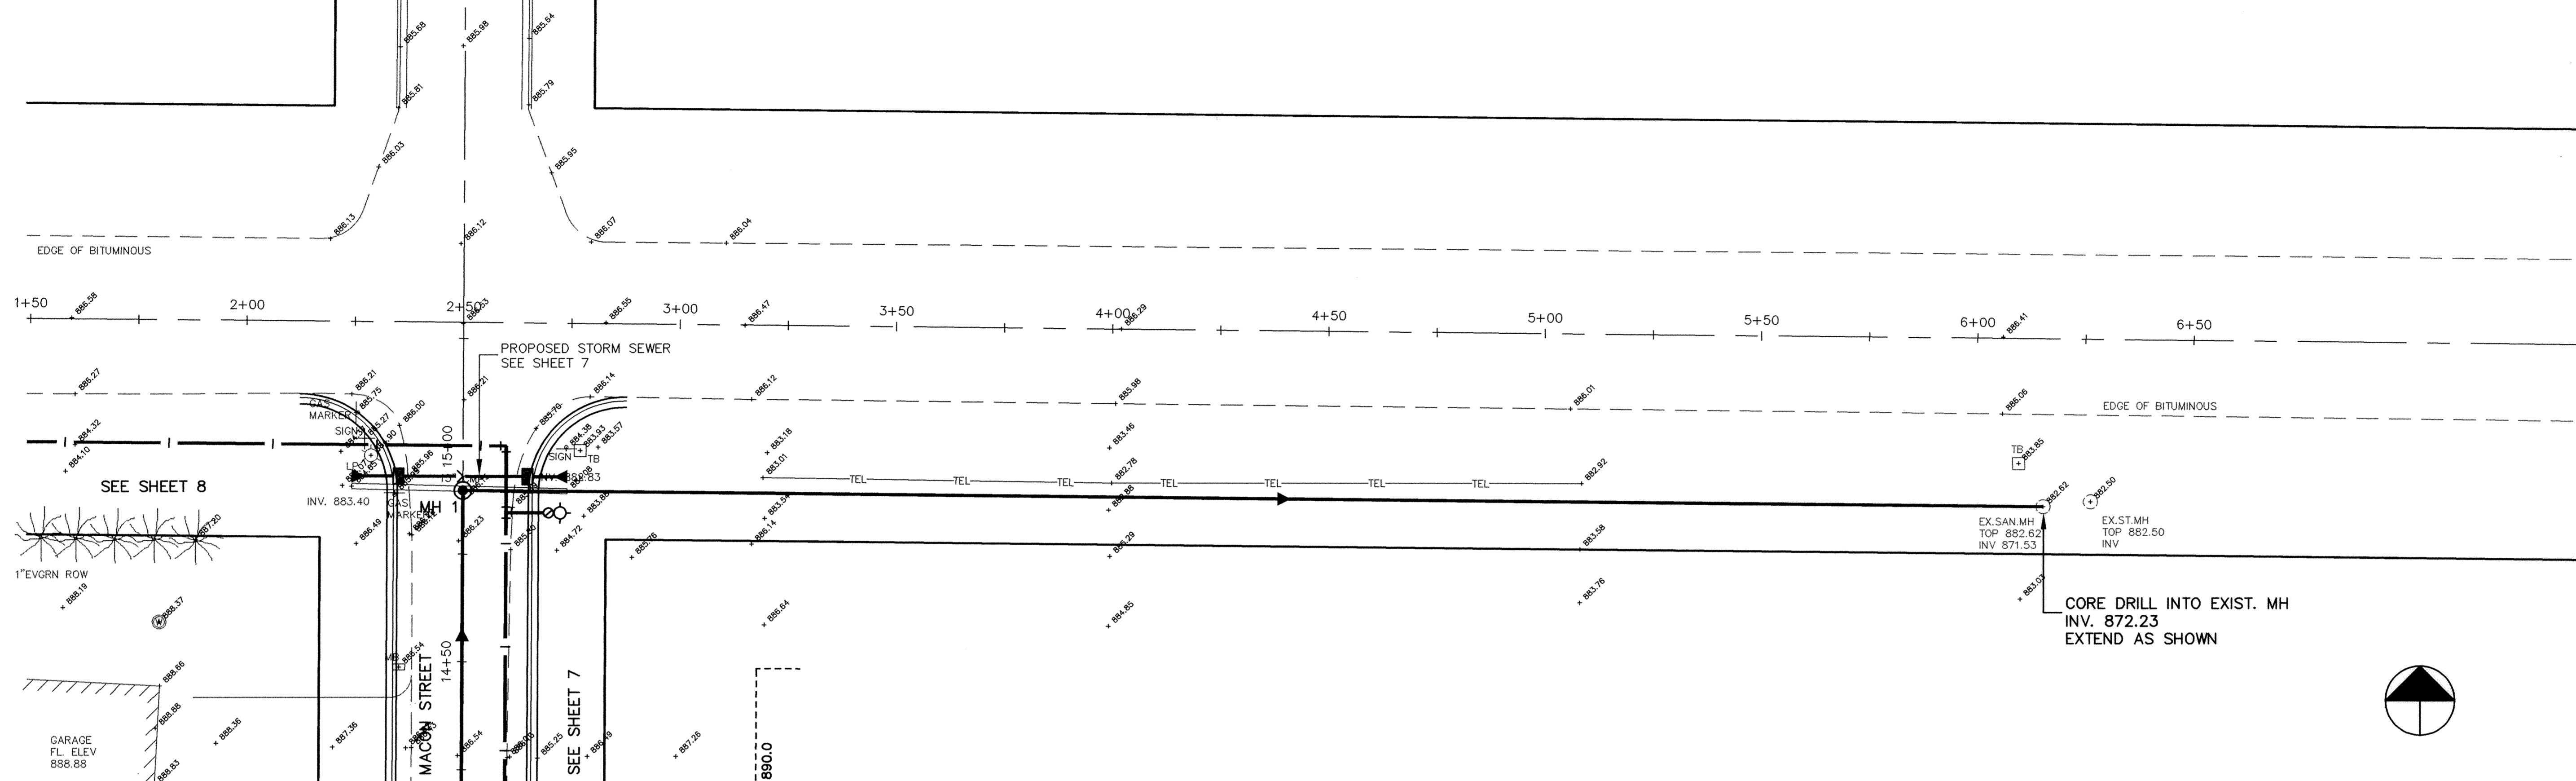

1326 ENERGY PARK DRIVE
 ST. PAUL, MINNESOTA 55108
 (612) 644-4389

REVISIONS	DATE	DESCRIPTION

DESIGNED _____
 CHECKED _____
 DRAWN _____
 GRAPHIC SCALE
 0 20
 0 5
 VERT.

CITY OF ELK RIVER
 RIVERVIEW DRIVE/MACON STREET
 SANITARY SEWER CONSTRUCTION
 COUNTY ROAD NO. 30

RECORD PLAN
 FEBRUARY 1998

DATE MAY 1997 SHEET 9 OF 20 SHEETS PROJECT NO. 230-365-20