


STATION	AREAS		VOLUMES		CUMULATIVE VOLUMES	
	CUT	FILL	CUT	FILL	CUT	FILL
-1+00	0.00	0.00	34.44	5.38	34.44	5.38
-0+50	37.20	5.81	34.60	3.58	69.04	8.96
-0+25	37.47	2.03	34.47	3.15	103.51	12.11
0+00	36.59	5.29	69.25	5.47	172.76	17.59
0+50	37.87	1.08	68.91	5.93	241.67	23.51
1+00	36.38	5.80	61.12	10.01	302.79	33.53
1+50	29.46	5.72	50.76	9.21	353.55	42.74
2+00	25.36	4.23	53.09	4.96	406.64	47.70
2+50	31.98	1.13	50.40	4.83	457.04	52.54
2+94	29.88	4.80	6.64	1.09	463.68	53.63
3+00	29.90	5.02	61.58	4.65	525.27	58.27
3+50	36.61	0.00	65.59	5.52	590.86	63.79
4+00	34.23	5.96	50.26	4.32	641.12	68.12
4+38	37.19	0.18	16.06	0.08	657.18	68.20
4+50	35.09	0.18	60.04	10.33	717.22	78.53
5+00	29.75	10.98	58.27	11.75	775.49	90.28
5+50	33.18	1.71	41.77	3.78	817.26	94.06
5+85	31.26	4.12	17.36	4.01	834.62	98.06
6+00	31.23	10.31	64.27	10.11	898.89	108.17
6+50	38.19	0.61	62.81	12.52	961.70	120.69
7+00	29.65	12.90	60.39	12.96	1022.09	133.65
7+50	35.57	1.09	62.64	15.63	1084.73	149.28
8+00	32.07	15.79	61.47	20.80	1146.19	170.08
8+50	34.31	6.68	26.95	4.37	1173.14	174.45
8+71	34.98	4.55	36.38	8.58	1209.52	183.03
9+00	32.75	11.43	63.51	17.99	1273.03	201.02
9+50	35.84	8.00	66.59	8.30	1339.63	209.32
10+00	36.08	0.97	11.38	0.31	1351.00	209.63
10+17.03	0.00	0.00	0.00	0.00	1351.00	209.63

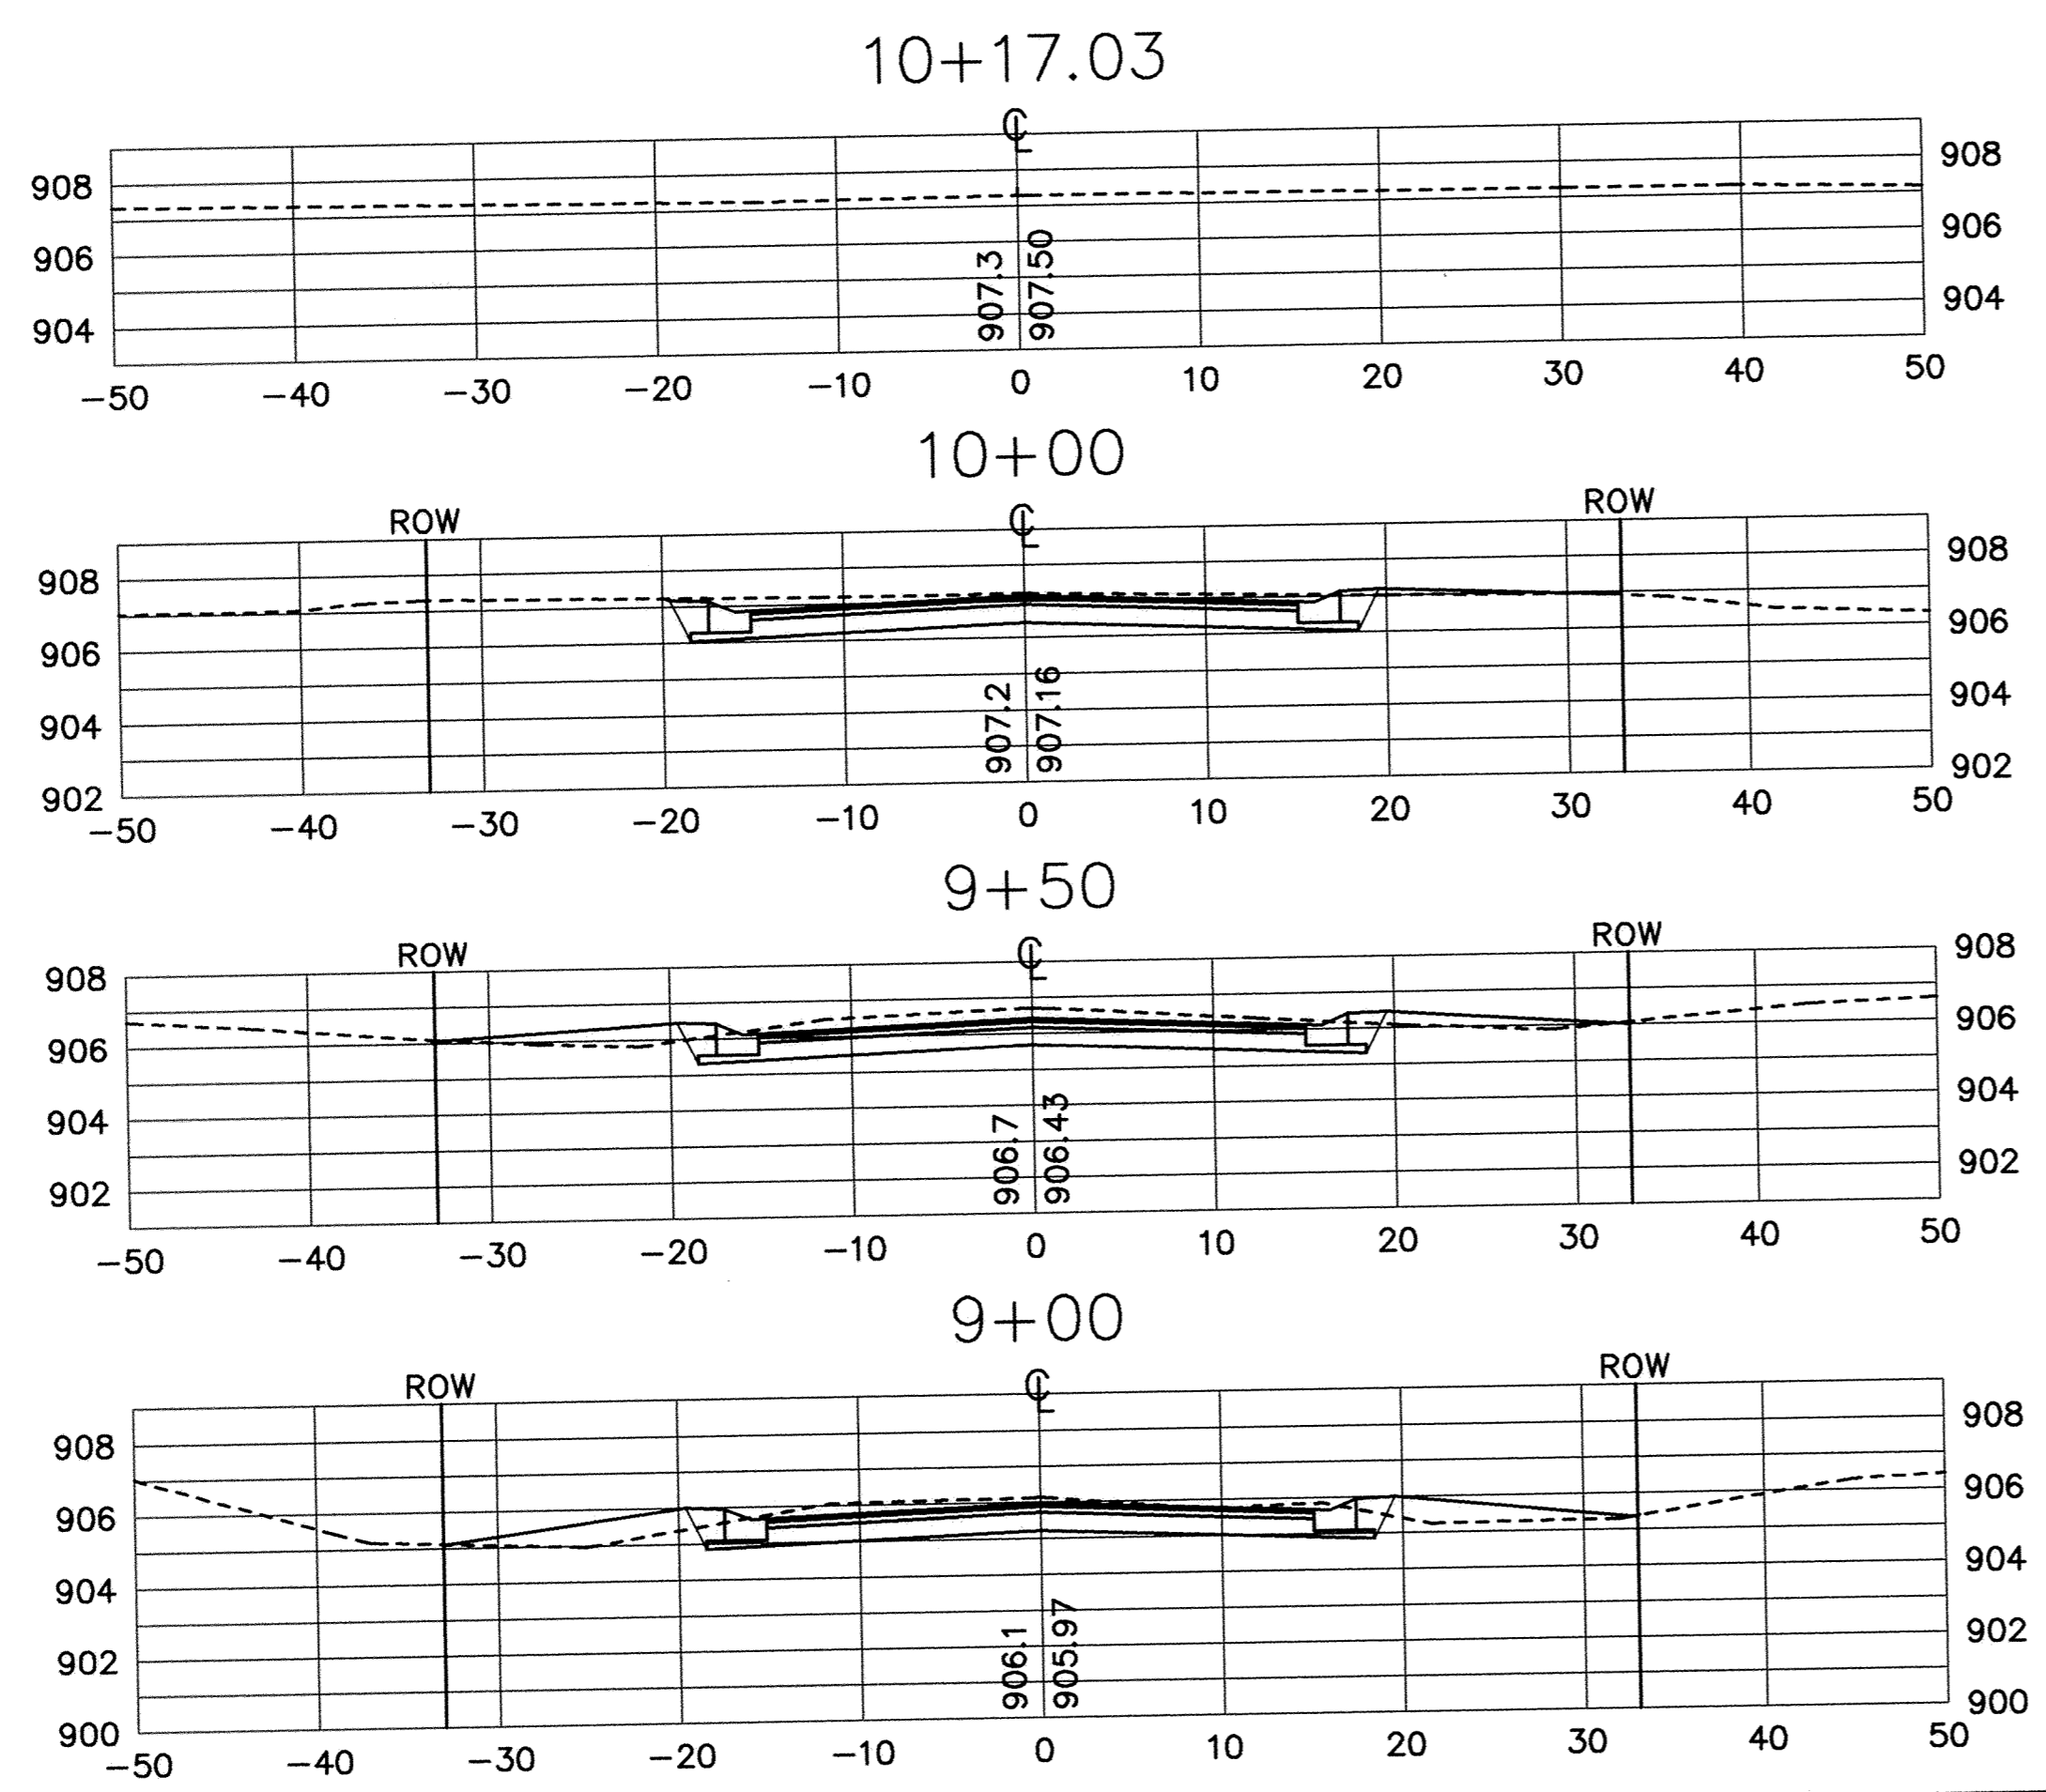

RECORD PLAN  
FEBRUARY 1998

CITY OF ELK RIVER  
RIVERVIEW DRIVE  
STREET AND UTILITY IMPROVEMENTS  
CROSS SECTIONS  
9+00 TO 10+17.03

DATE JUNE 1997 SHEET 12 OF 20 SHEETS PROJECT NO. 230-365-20

REVISIONS	DATE	DESCRIPTION	DESIGNED	CHECKED	DRAWN

GRAPHIC SCALE  
0 10  
0 5  
VERT.

1326 ENERGY PARK DRIVE  
ST. PAUL, MINNESOTA 55108  
(612) 644-4389



I HEREBY CERTIFY THAT THIS PLAN, SPECIFICATION, OR REPORT WAS PREPARED BY ME OR UNDER MY DIRECT SUPERVISION AND THAT I AM A DULY REGISTERED PROFESSIONAL ENGINEER UNDER THE LAWS OF THE STATE OF MINNESOTA.  
*Walter V. Stahard*  
DATE 3/16/98 REG. NO. 19130