
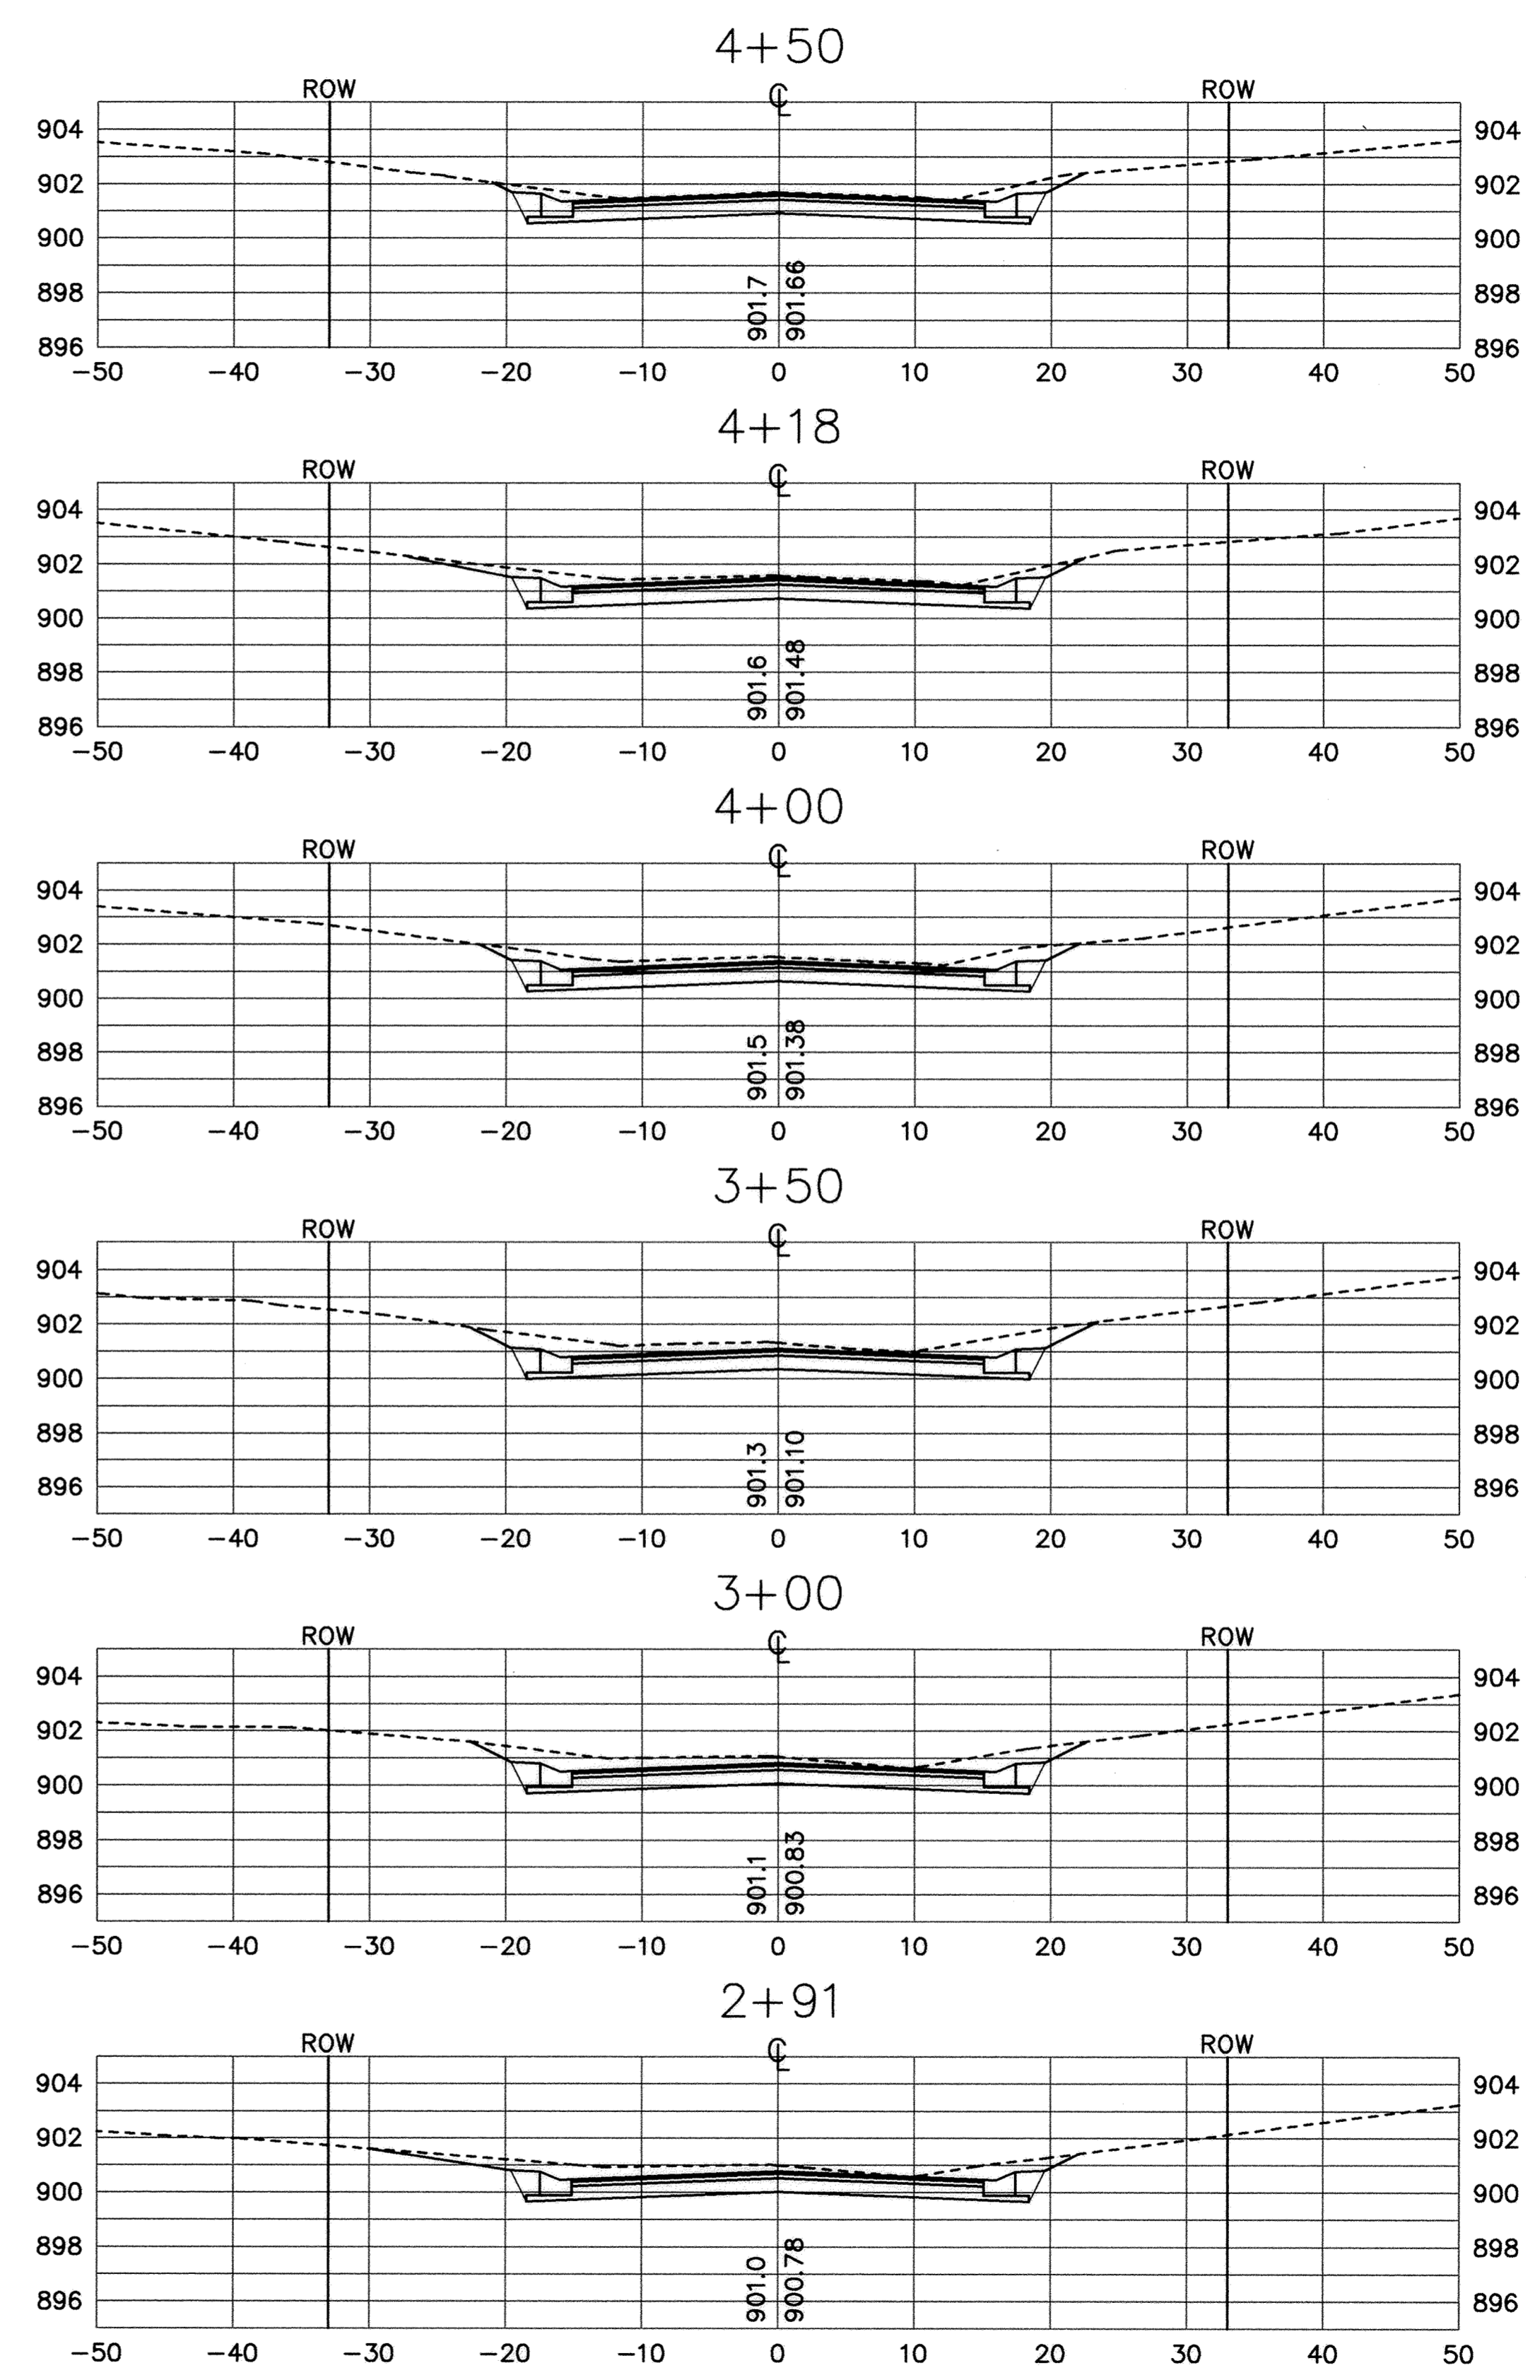


SDCO PRODUCTS • NEW HOPKINS, MINNESOTA
REVISION BY PART NUMBER 0502

SDCO PRODUCTS • NEW HOPKINS, MINNESOTA
REVISION BY PART NUMBER 0502

SDCO PRODUCTS • NEW HOPKINS, MINNESOTA
REVISION BY PART NUMBER 0502

SDCO PRODUCTS • NEW HOPKINS, MINNESOTA
REVISION BY PART NUMBER 0502

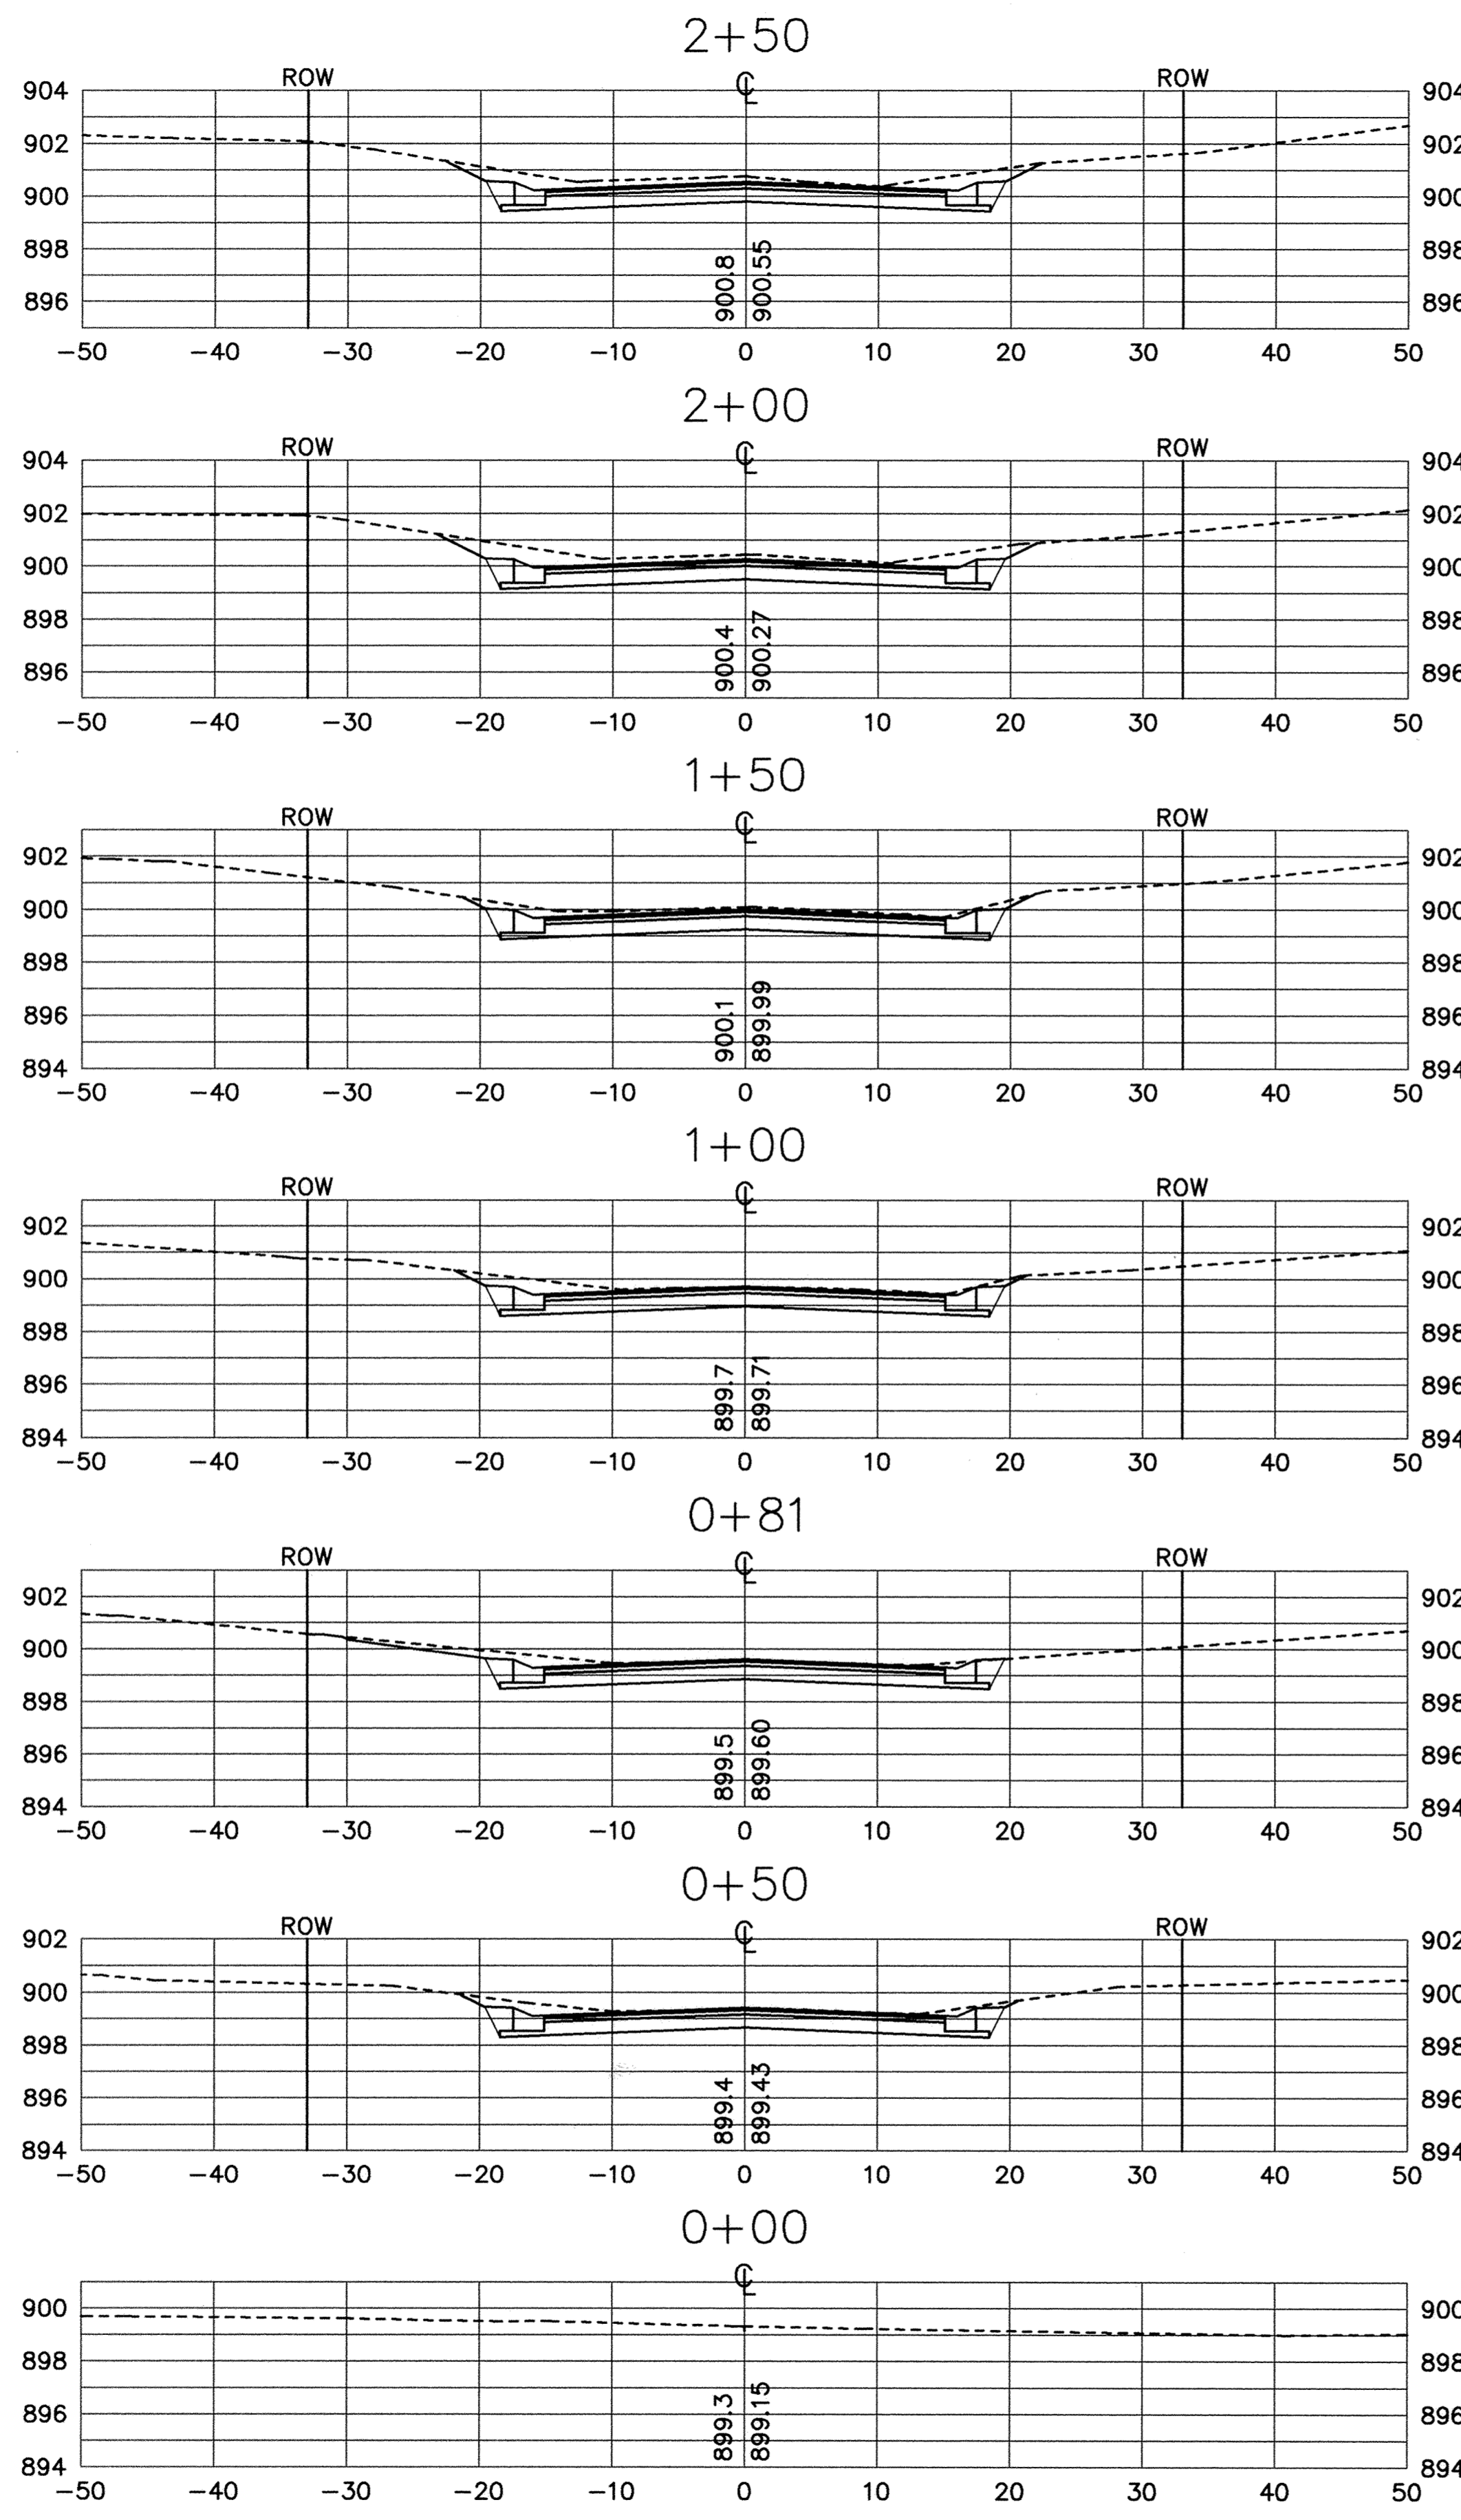

RECORD PLAN
FEBRUARY 1998

0+00 TO 4+50

I HEREBY CERTIFY THAT THIS PLAN, SPECIFICATION, OR REPORT WAS PREPARED BY ME OR UNDER MY DIRECT SUPERVISION AND THAT I AM A DULY REGISTERED PROFESSIONAL ENGINEER UNDER THE LAWS OF THE STATE OF MINNESOTA.

Mark V. Swanson
DATE 3/14/98 REG. NO. 19130



1326 ENERGY PARK DRIVE
ST. PAUL, MINNESOTA 55108
(612) 644-4389

REVISIONS	DATE	DESCRIPTION	DESIGNED	CHECKED	DRAWN

GRAPHIC SCALE
0 10
0 5
VERT.

CITY OF ELK RIVER MACON STREET STREET AND UTILITY IMPROVEMENTS CROSS SECTIONS		DATE	JUNE 1997	SHEET	13 OF 20 SHEETS	PROJECT NO.	230-365-20
--	--	------	-----------	-------	-----------------	-------------	------------