
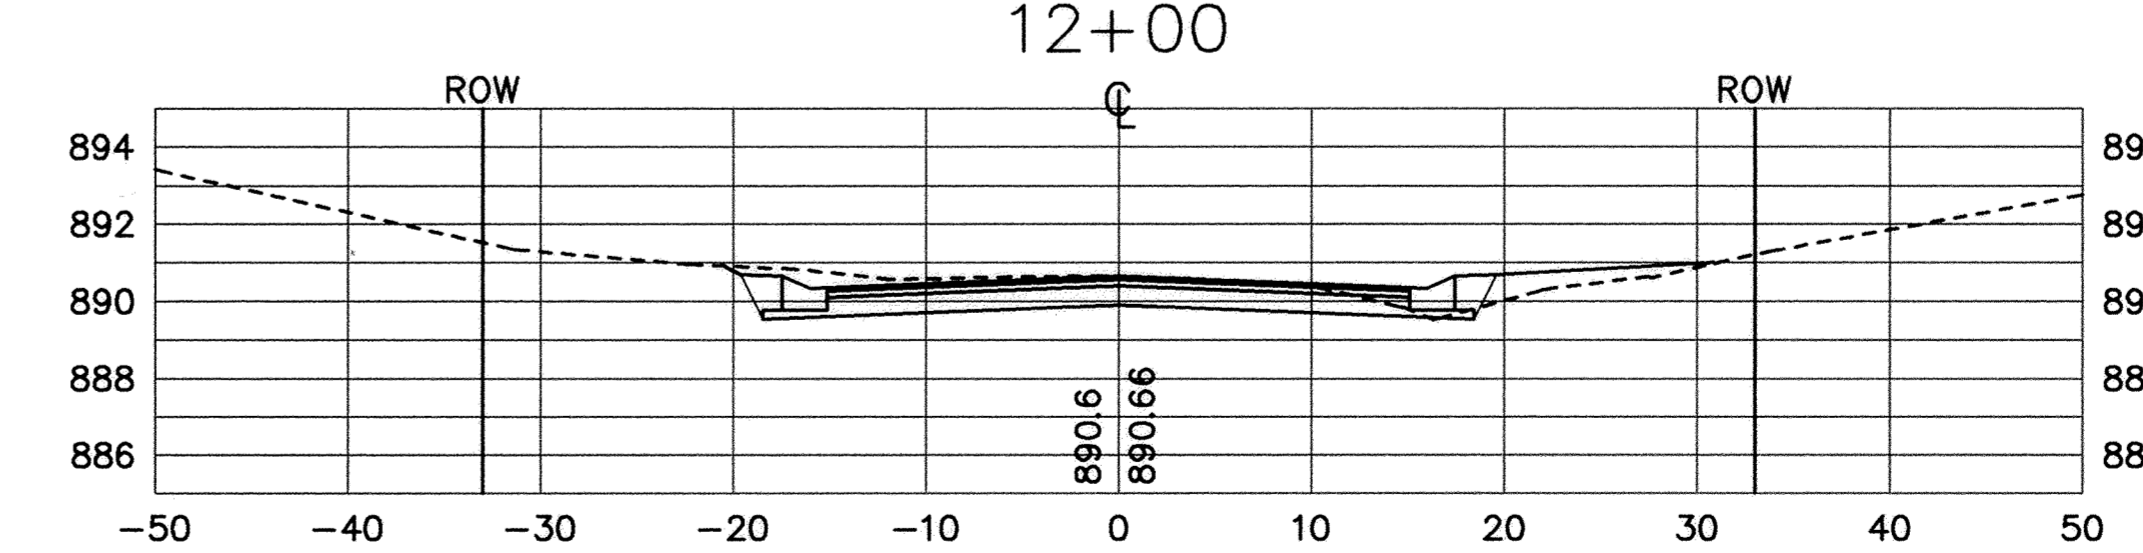
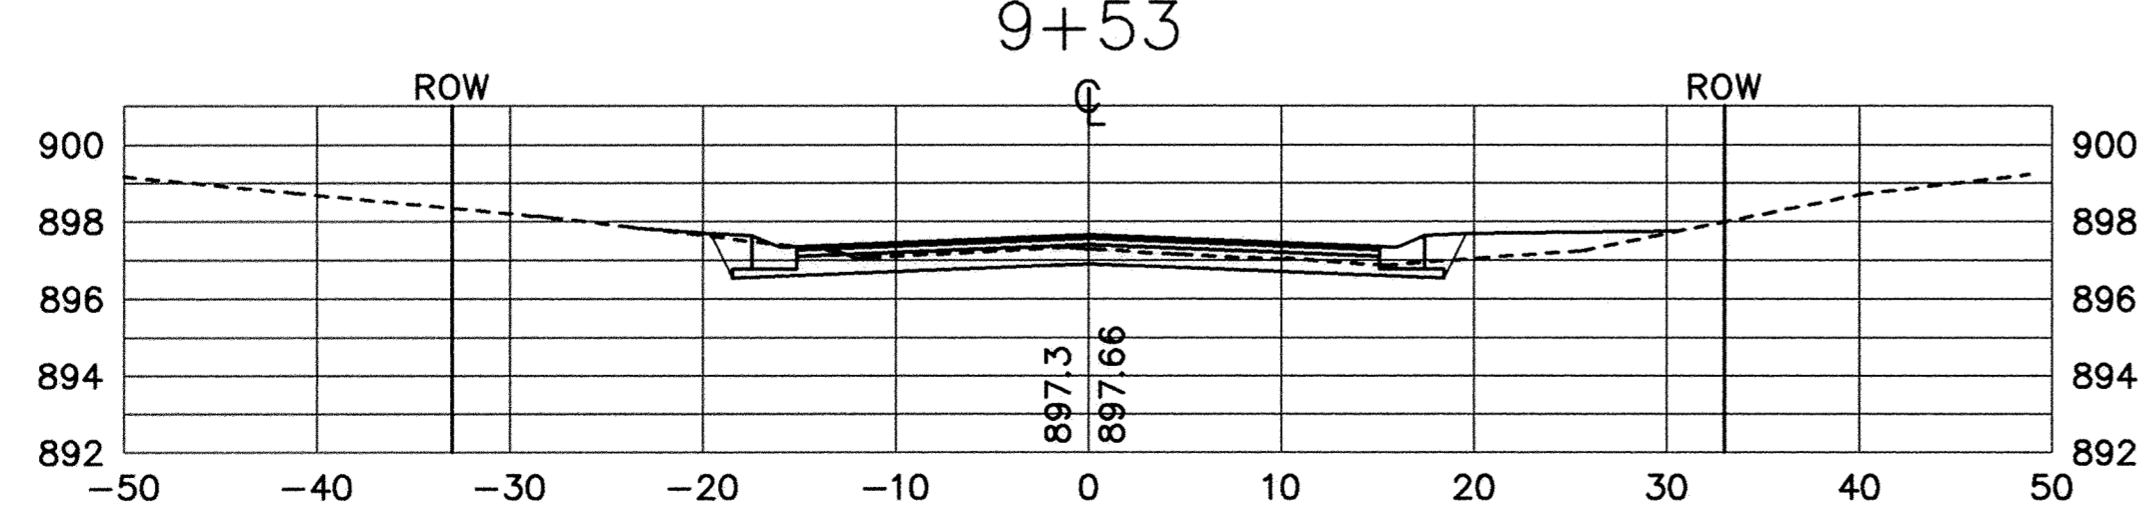
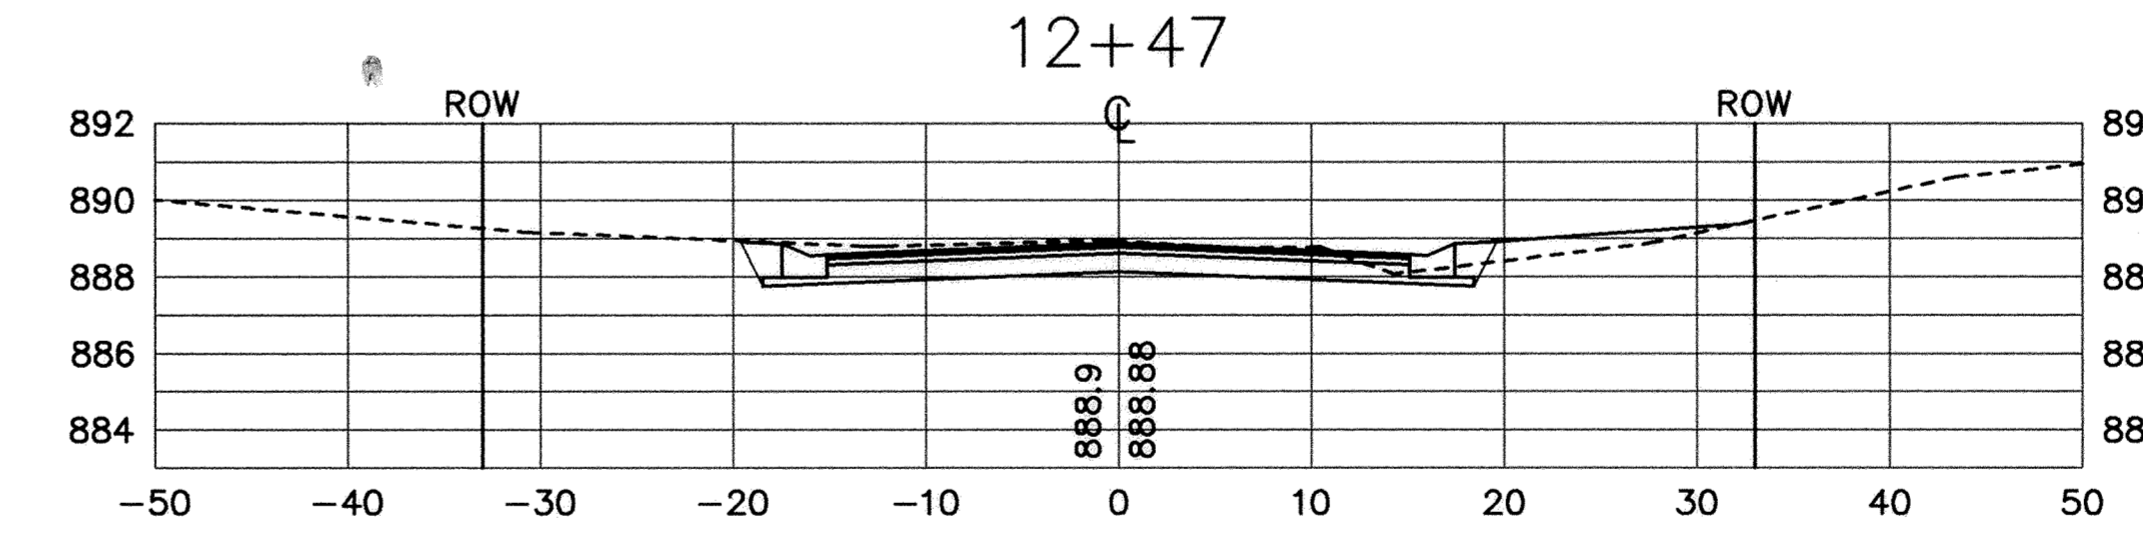
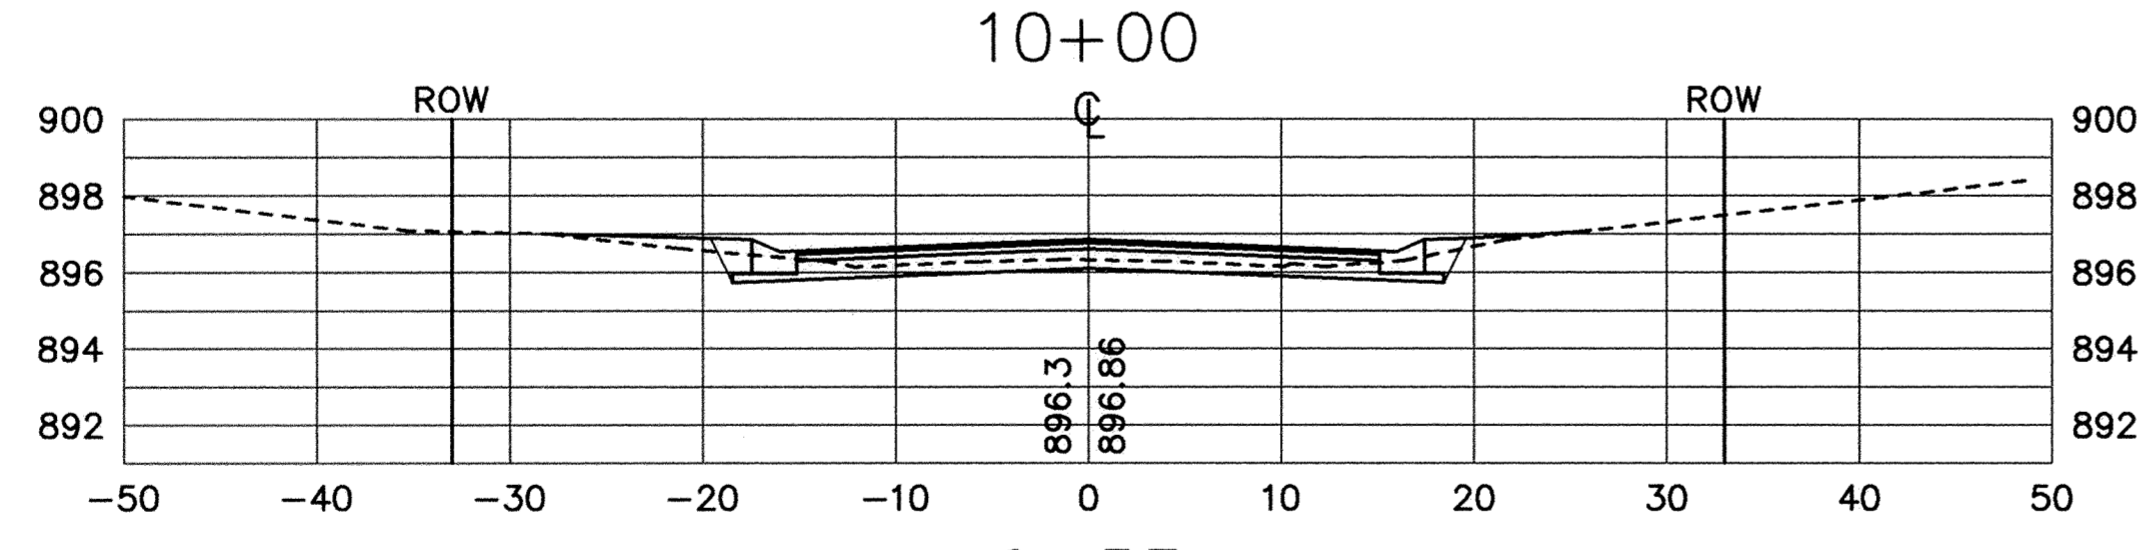
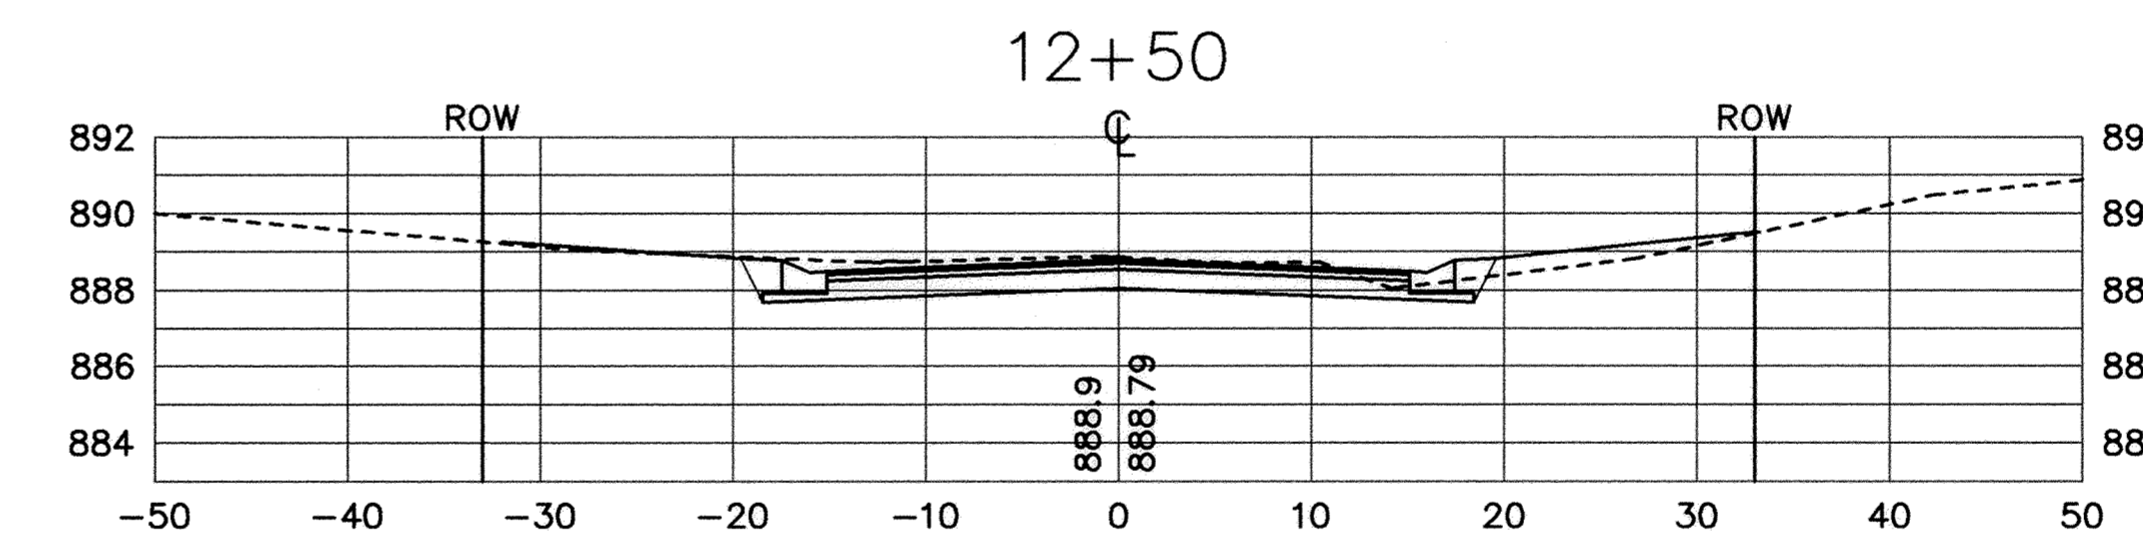
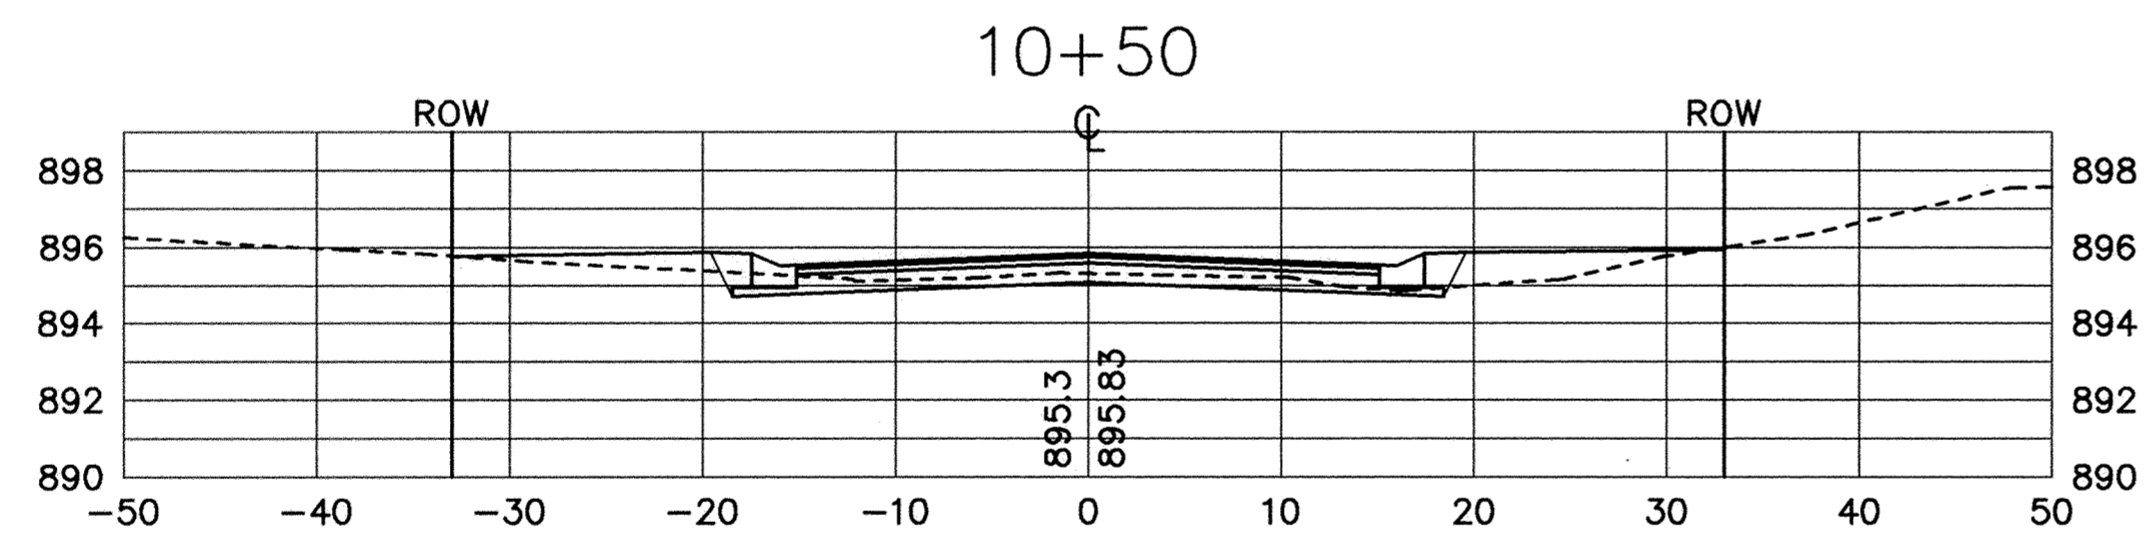
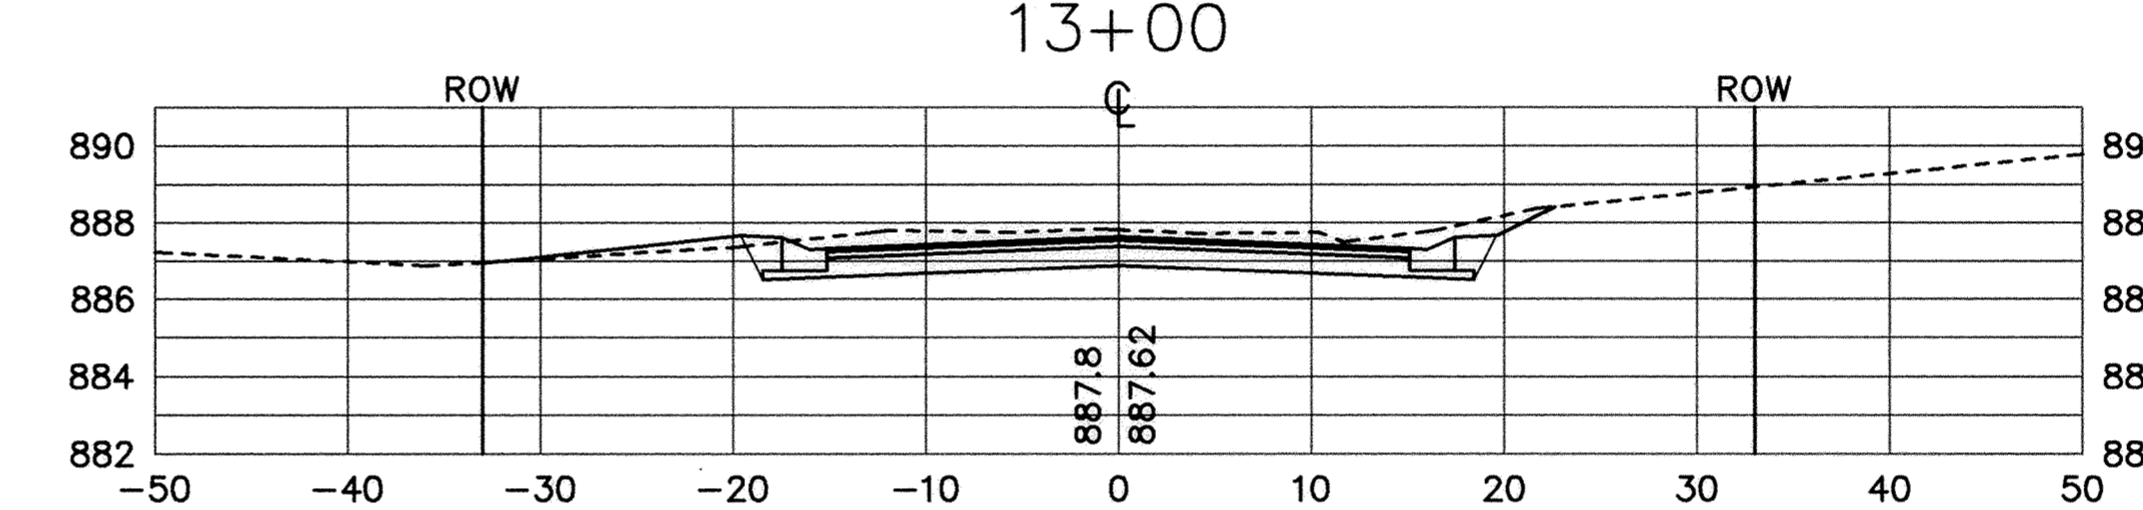
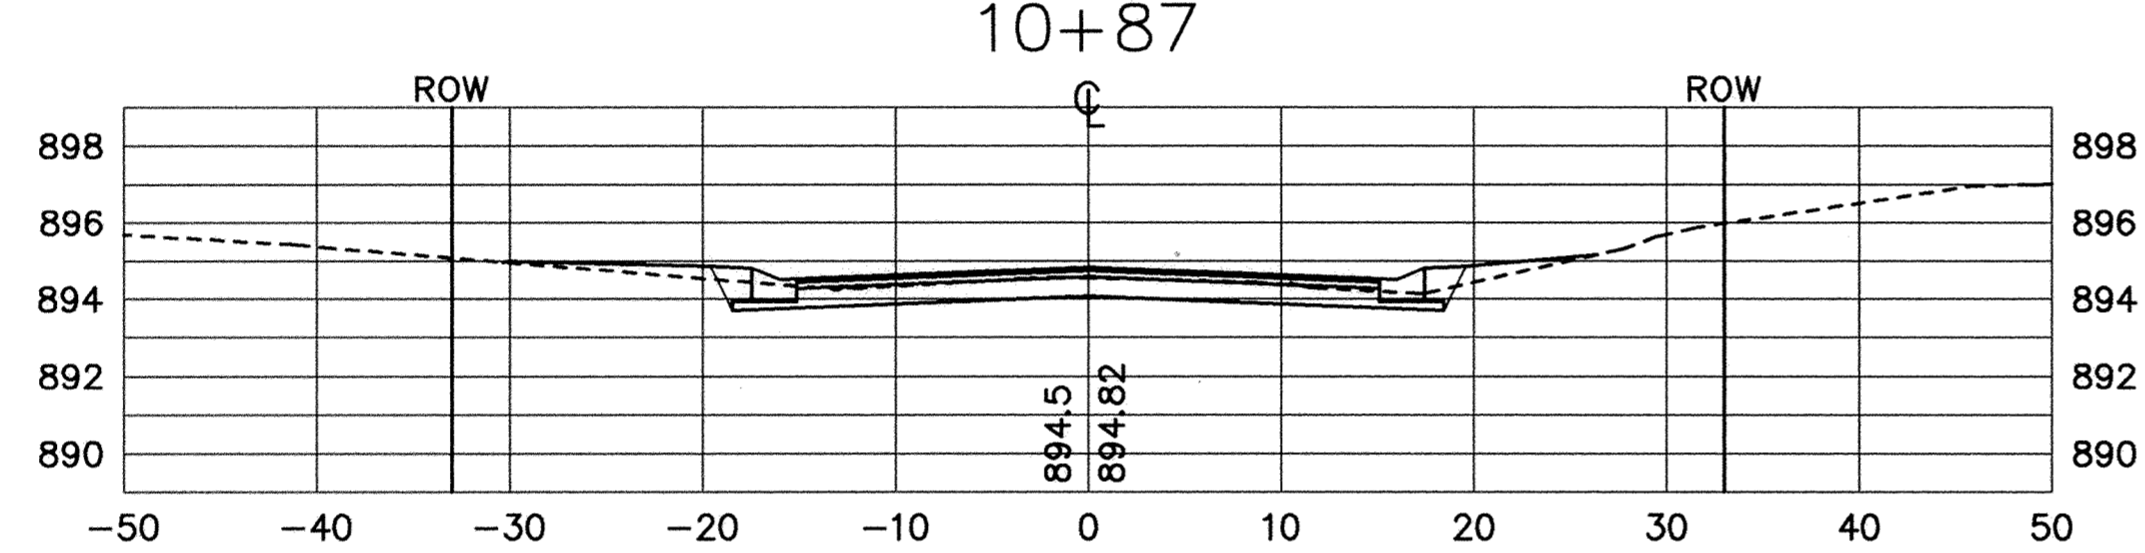
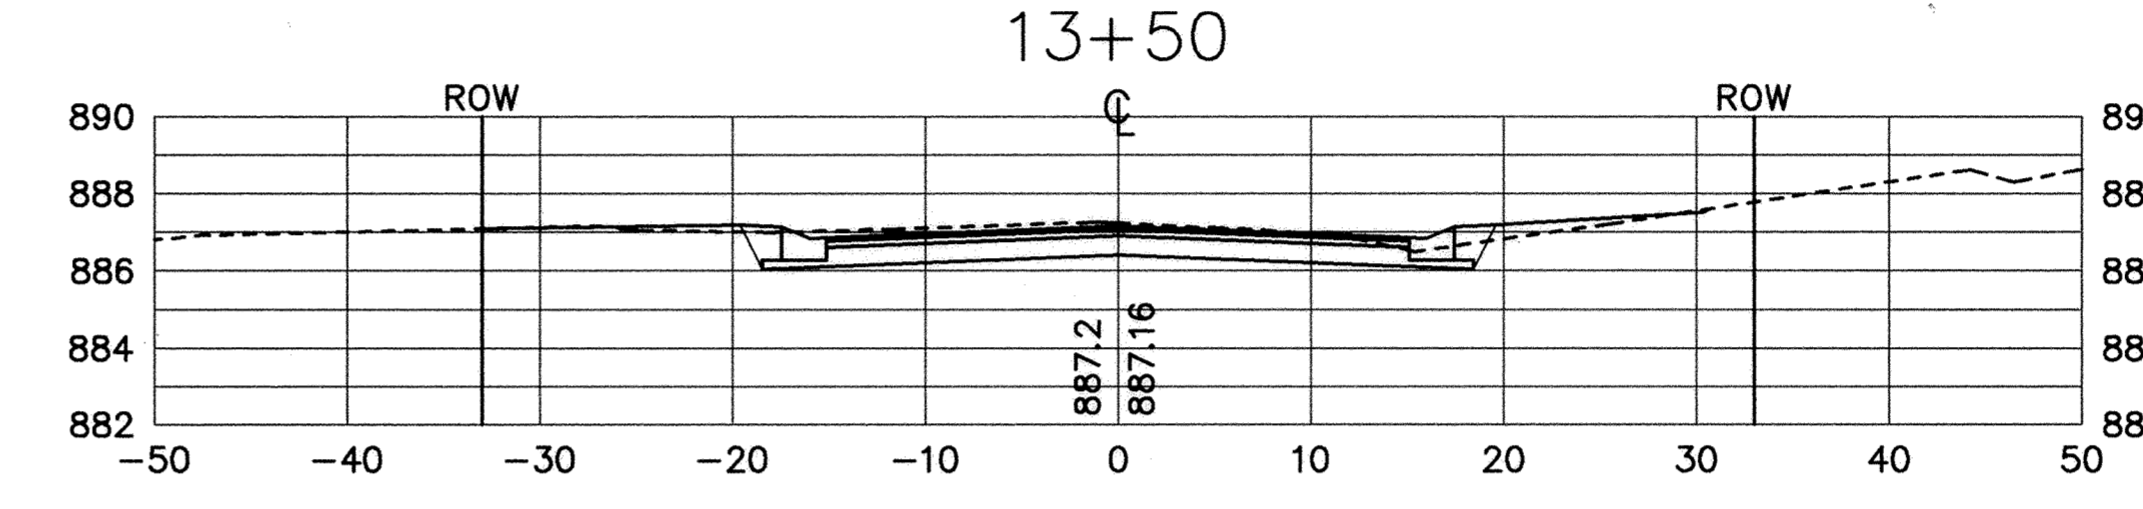
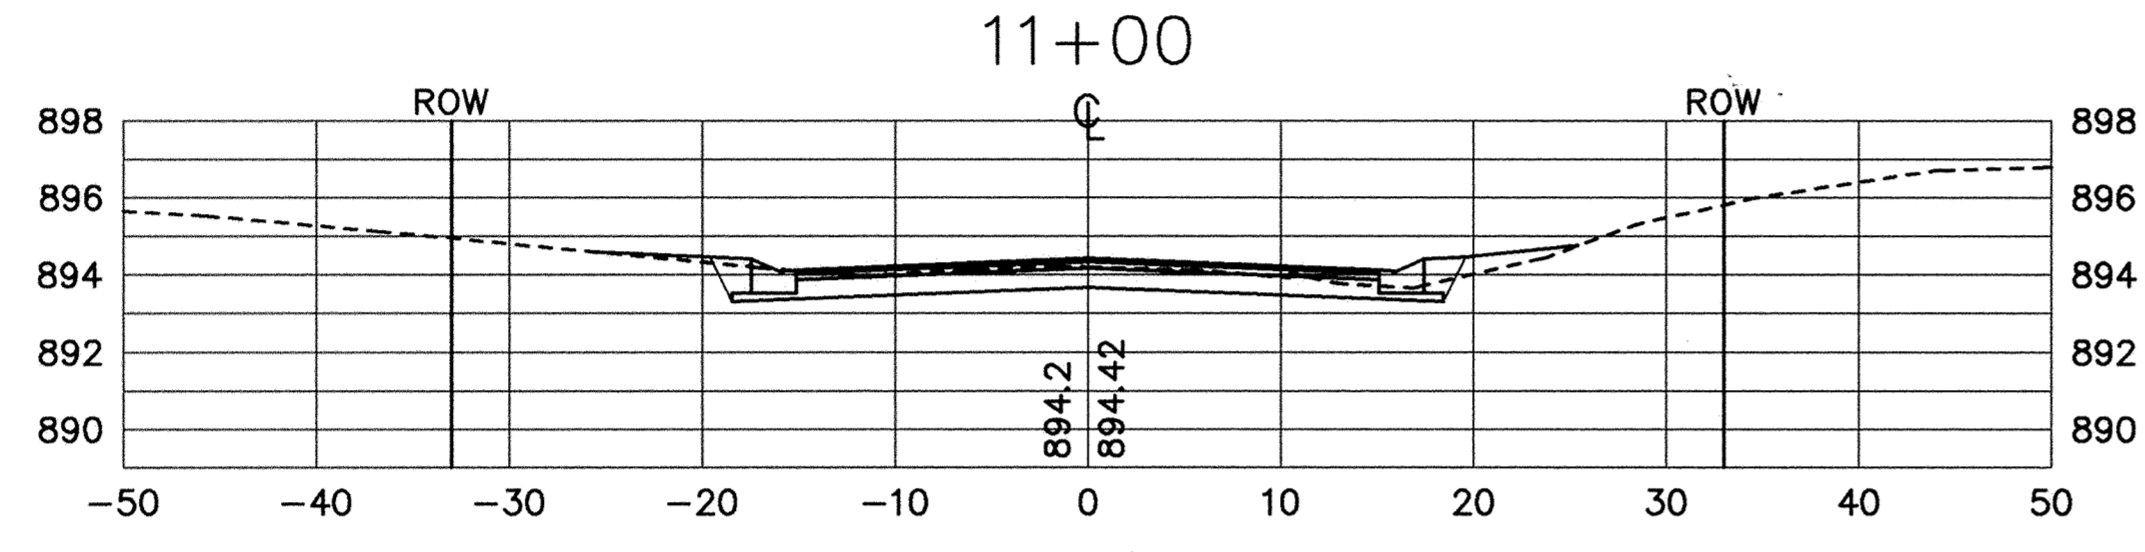
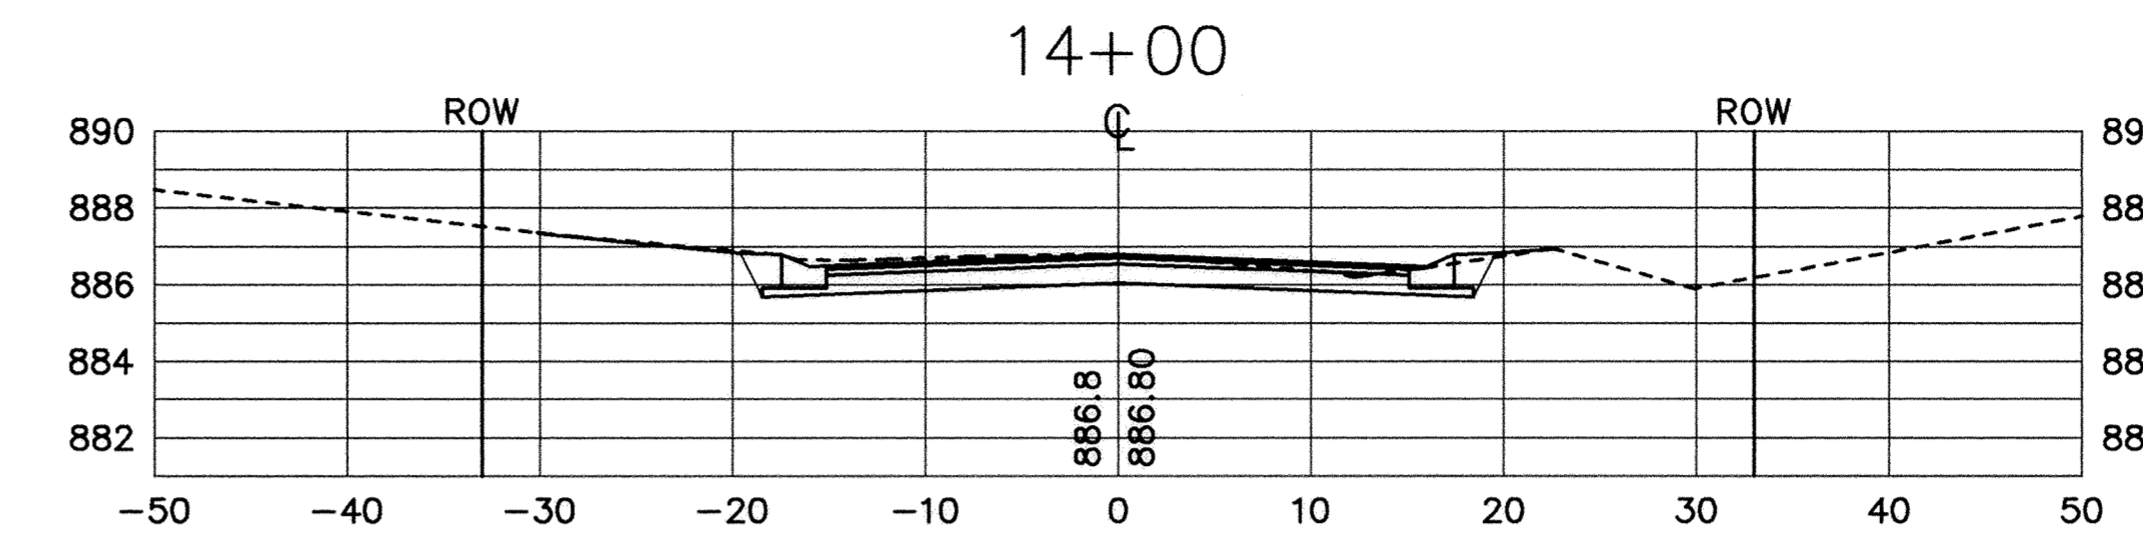


SDCO PRODUCTS • ARD, HOPE, MINNESOTA
REVISIONS BY PART NUMBER 0502
REVISIONS BY PART NUMBER 0502
REVISIONS BY PART NUMBER 0502
REVISIONS BY PART NUMBER 0502

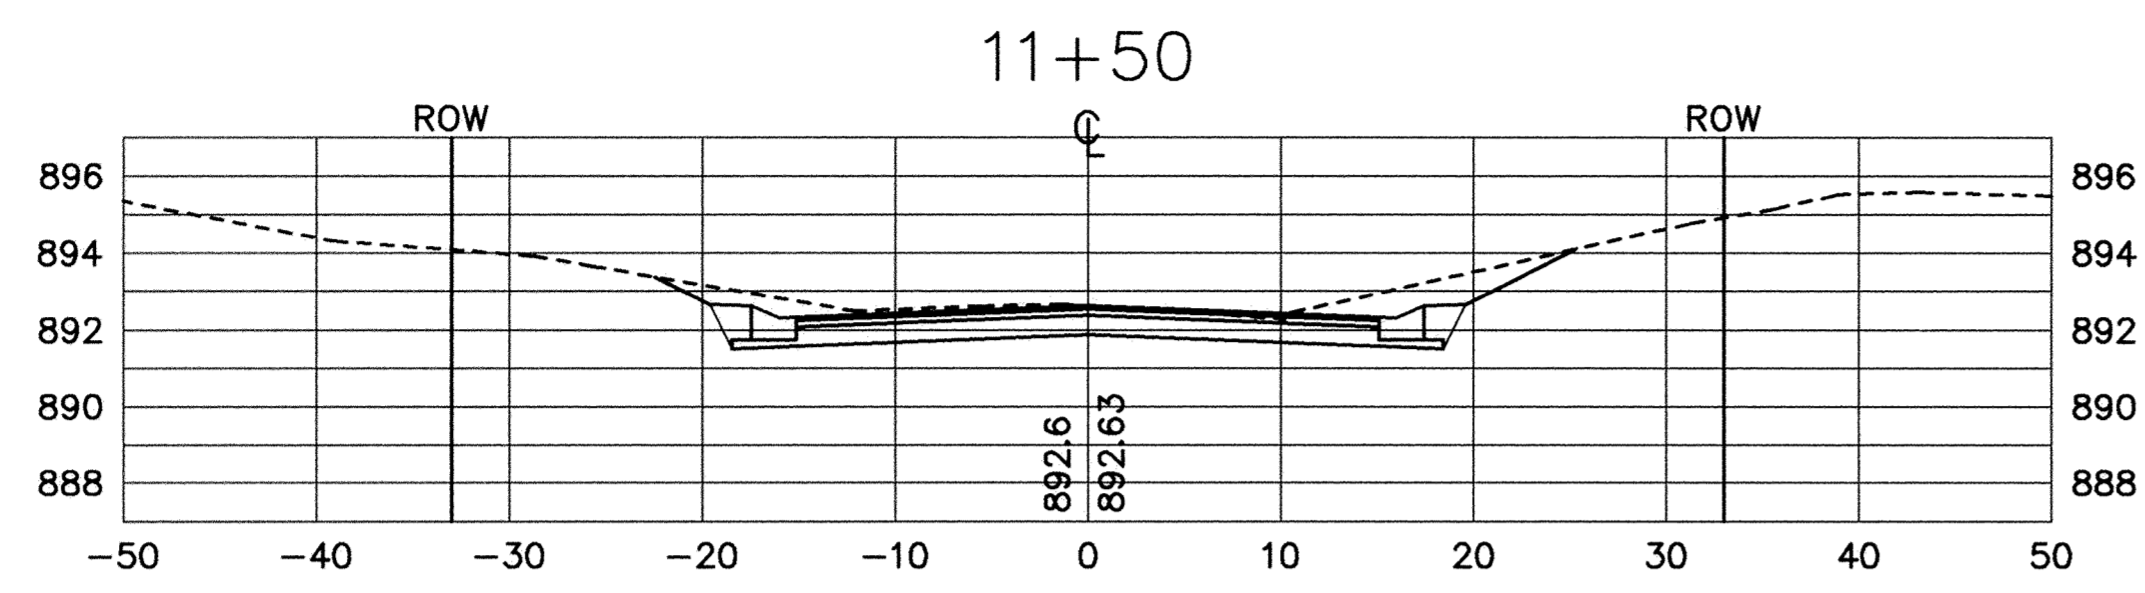

RECORD PLAN
FEBRUARY 1998


9+53 TO 14+00

CITY OF ELK RIVER
MACON STREET
STREET AND UTILITY IMPROVEMENTS
CROSS SECTIONS

DATE JUNE 1997 SHEET 15 OF 20 SHEETS PROJECT NO. 230-365-20

DATE	DESCRIPTION	DESIGNED
		CHECKED
		DRAWN
REVISIONS		GRAPHIC SCALE
		0 10
		0 VERT. 5

1326 ENERGY PARK DRIVE
ST. PAUL, MINNESOTA 55108
(612) 644-4389

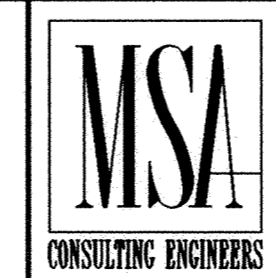

I HEREBY CERTIFY THAT THIS PLAN, SPECIFICATION, OR REPORT WAS PREPARED BY ME OR UNDER MY DIRECT SUPERVISION AND THAT I AM A DULY REGISTERED PROFESSIONAL ENGINEER UNDER THE LAWS OF THE STATE OF MINNESOTA.

Mark J. Stanton
DATE 3/14/98 REG. NO. 19130