

DRAWING NUMBER

SAICO PRODUCTS • NEW HOPE, MINNESOTA
REPORT BY PART NUMBER 8532
PROFESSIONAL SEAL OF PART ON THIS LINE

DRAWING NUMBER

SAICO PRODUCTS • NEW HOPE, MINNESOTA
REPORT BY PART NUMBER 8532
PROFESSIONAL SEAL OF PART ON THIS LINE

DRAWING NUMBER


SAICO PRODUCTS • NEW HOPE, MINNESOTA
REPORT BY PART NUMBER 8532
PROFESSIONAL SEAL OF PART ON THIS LINE

DRAWING NUMBER
ROYAL 88
1

SAICO PRODUCTS • NEW HOPE, MINNESOTA
REPORT BY PART NUMBER 8532
PROFESSIONAL SEAL OF PART ON THIS LINE

SANITARY SEWER, WATERMAIN, STORM DRAINAGE & STREET CONSTRUCTION

ROYAL OAKS RIDGE

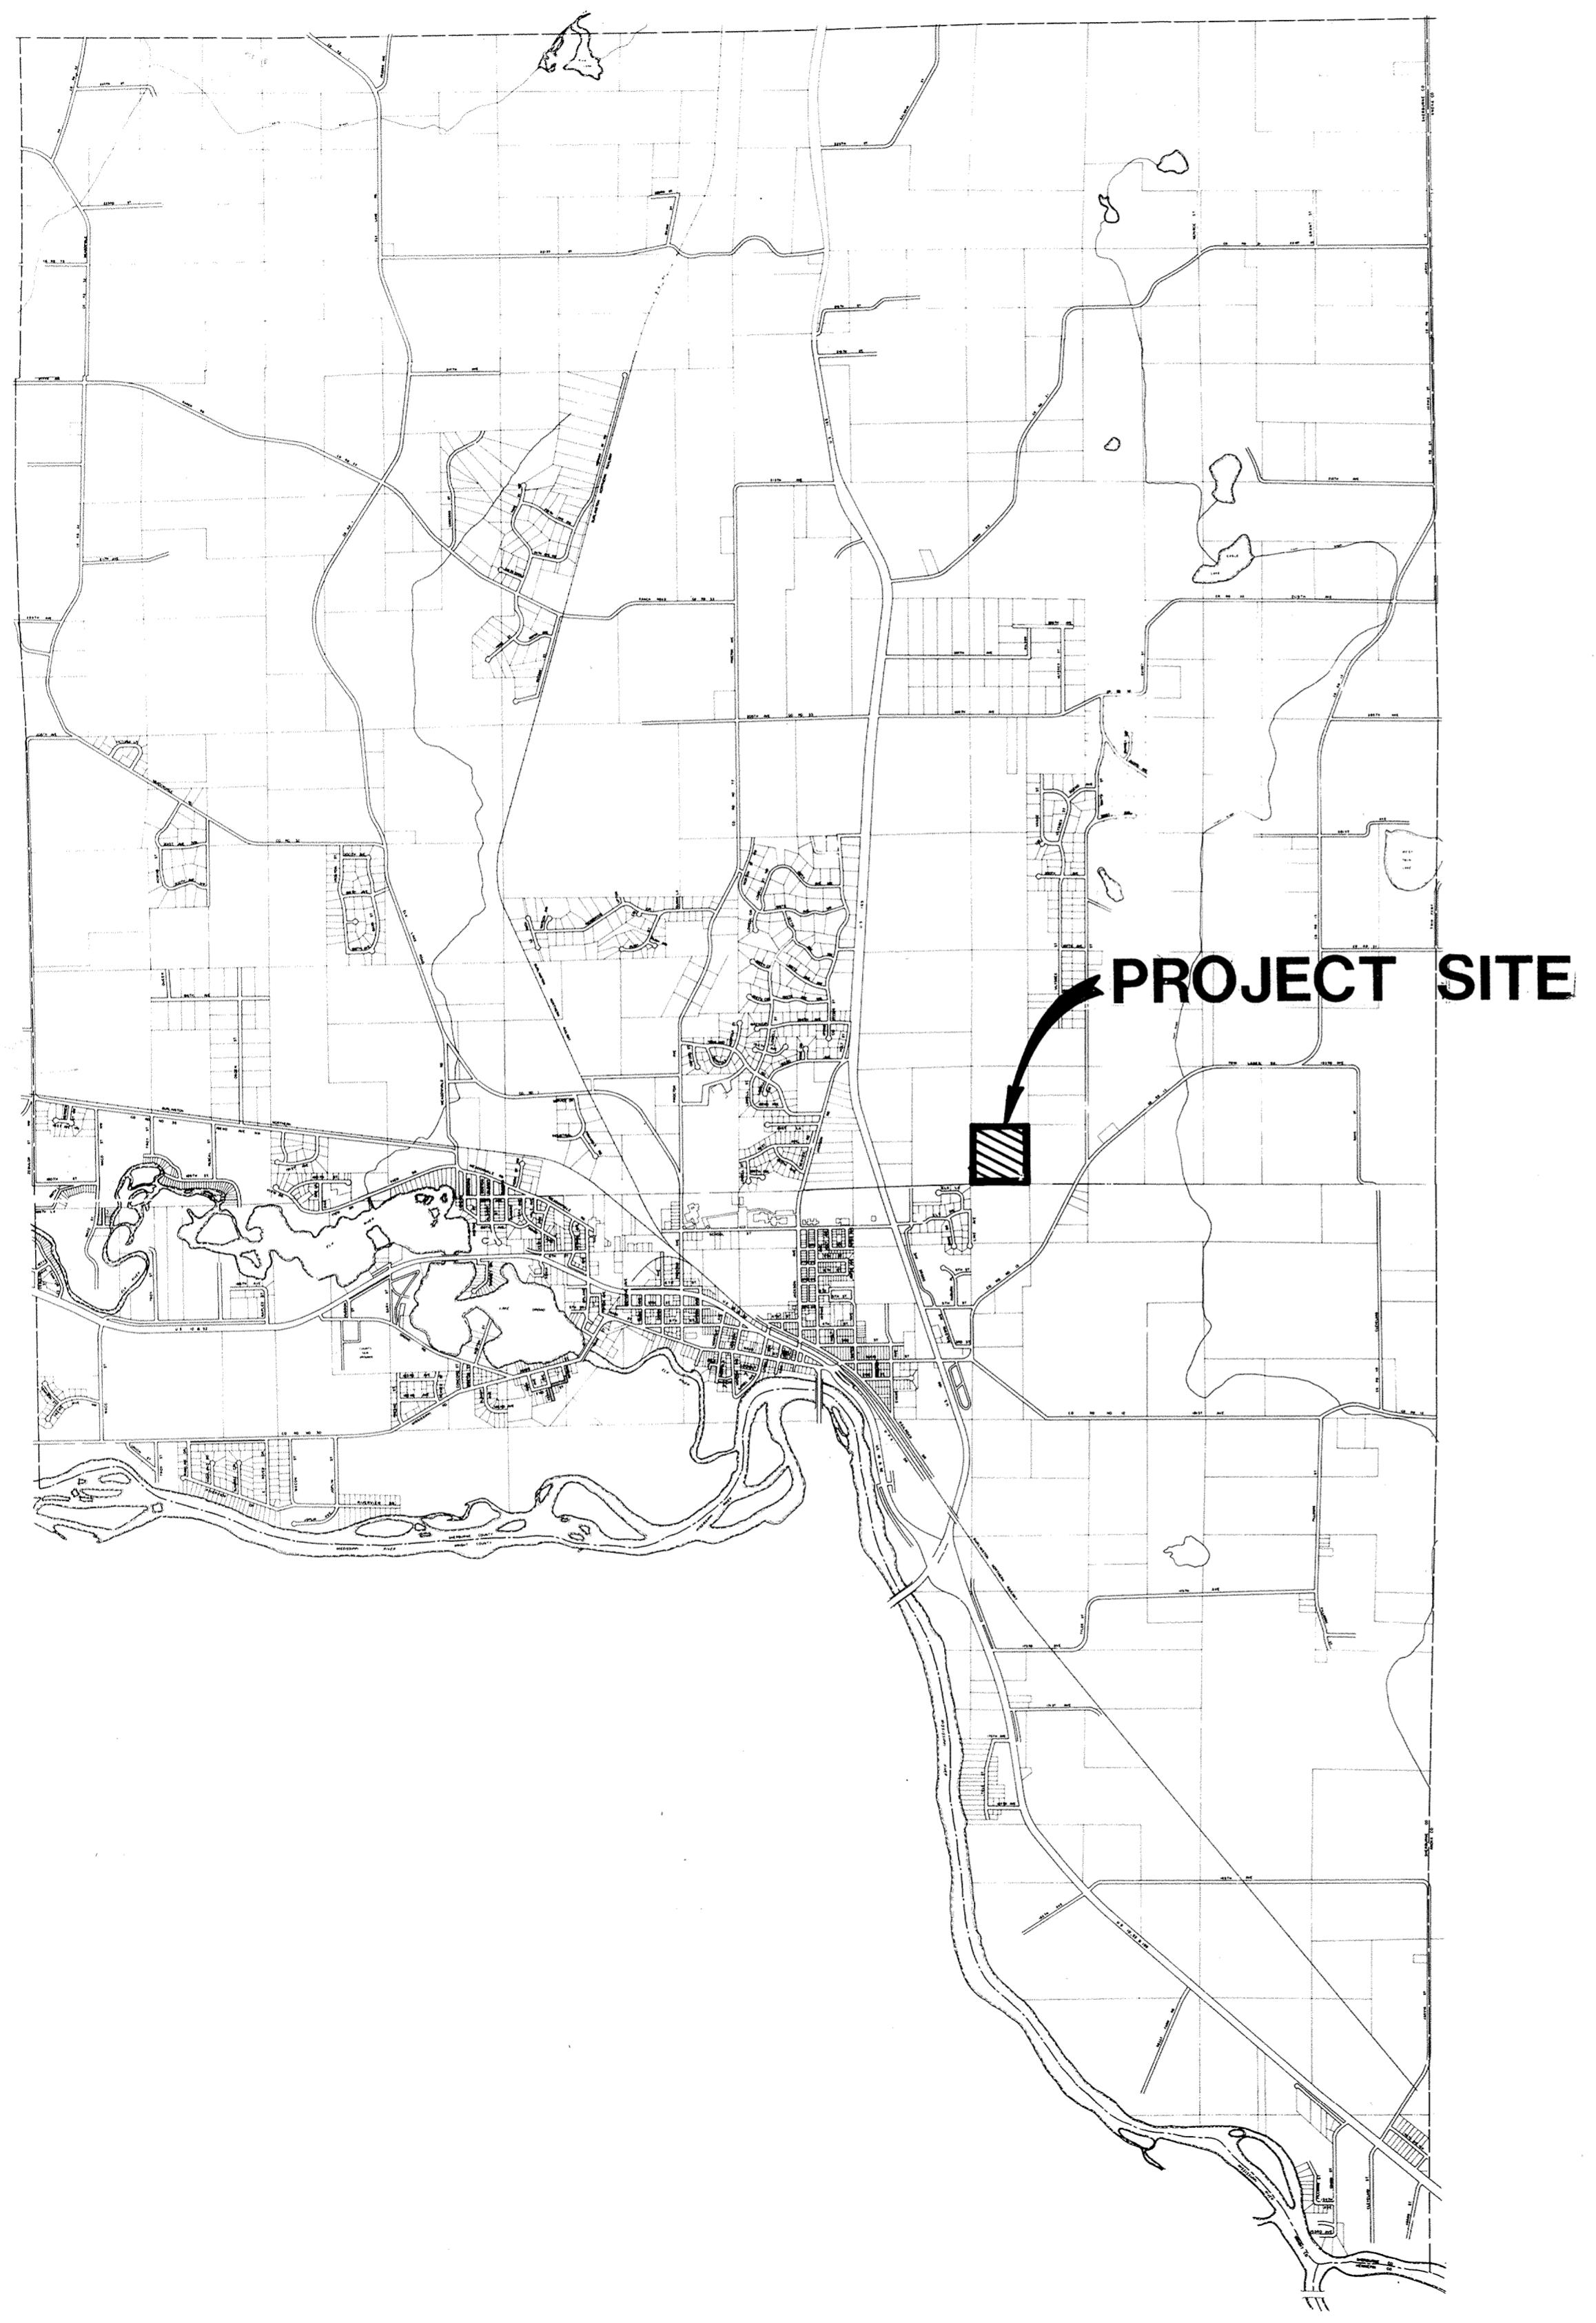

I HEREBY CERTIFY THAT THIS PLAN, SPECIFICATION, OR REPORT
WAS PREPARED BY ME OR UNDER MY DIRECT SUPERVISION AND I
AM A DULY REGISTERED PROFESSIONAL ENGINEER UNDER THE
LAWS OF THE STATE OF MINNESOTA.

Terry J. Maier
DATE 3/3/88 MINNESOTA REGISTRATION NO. 15314

MSA CONSULTING ENGINEERS
Maier Stewart & Associates Inc.
1959 SLOAN PLACE (612) 774-6021 ST. PAUL, MINNESOTA 55117

City of
Elk Riv
RECORD PLAN NOV. 1988
*OAKS
8861-1988*