
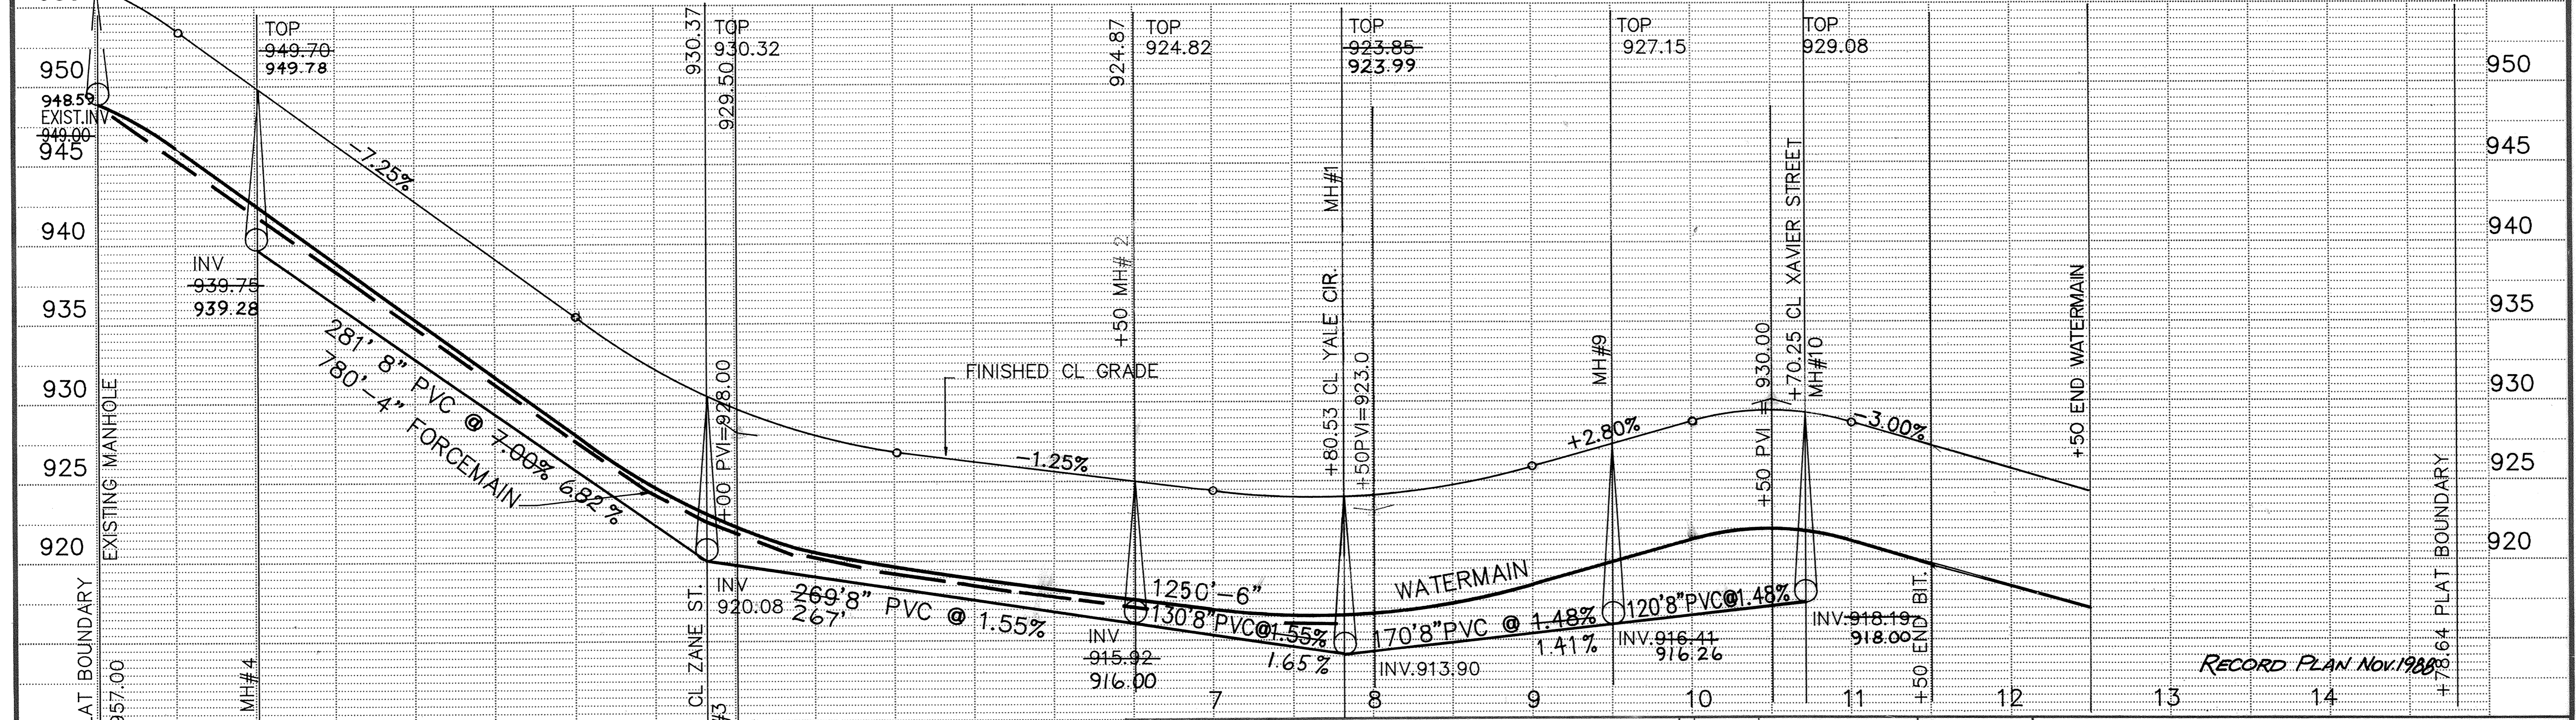


190TH AVENUE

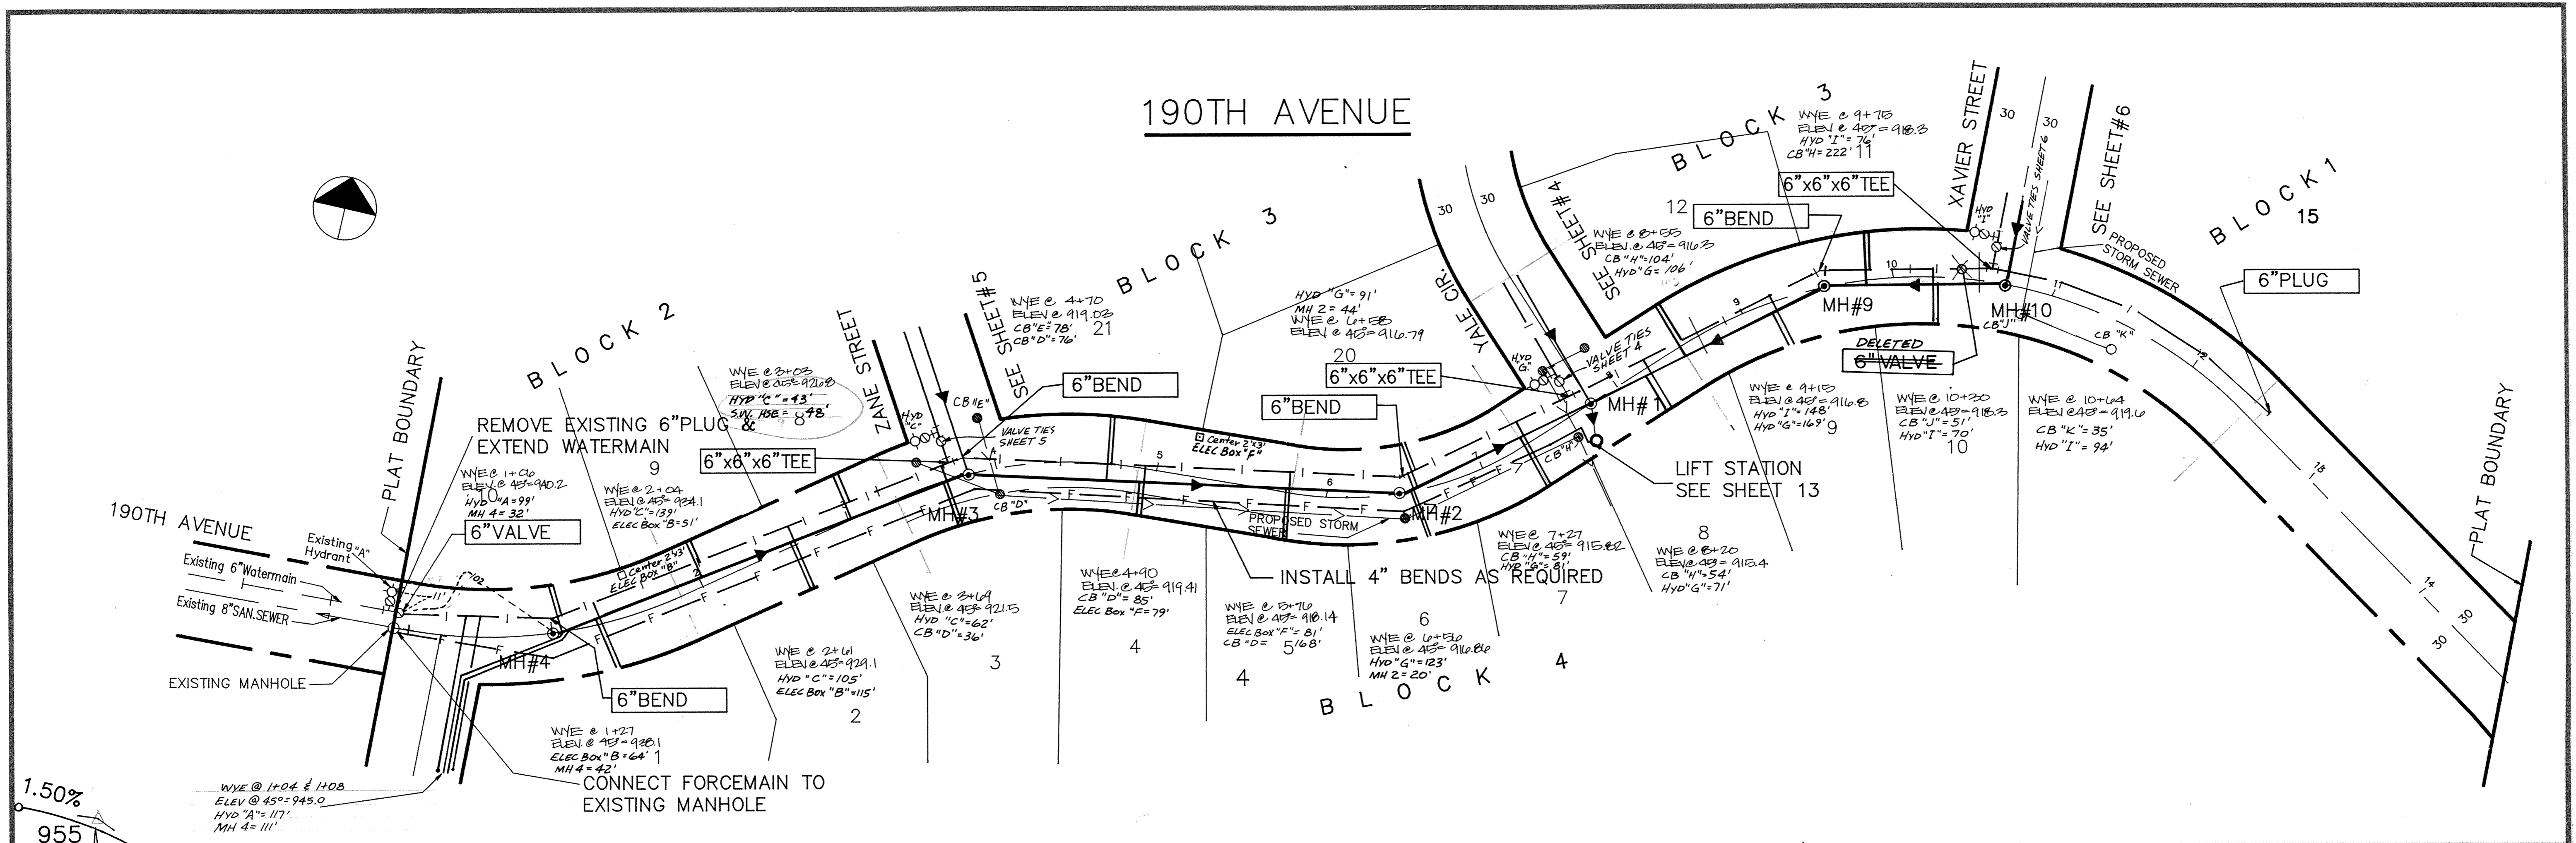

MSA CONSULTING ENGINEERS
Maier Stewart & Associates Inc.
 1959 SLOAN PLACE (612) 774-6021 ST. PAUL, MINNESOTA 55117

DATE	DESCRIPTION	DESIGNED
		CHECKED
		DRAWN MRJ
		GRAPHIC SCALE
		0 HORIZ
		0 VERT 5

CITY OF ELK RIVER
 SANITARY SEWER AND WATERMAIN
 190TH AVENUE

RECORD PLAN NOV 1988

DATE MAR 1988 SHEET 3 OF 17 SHEETS PROJECT NO. 230-034