
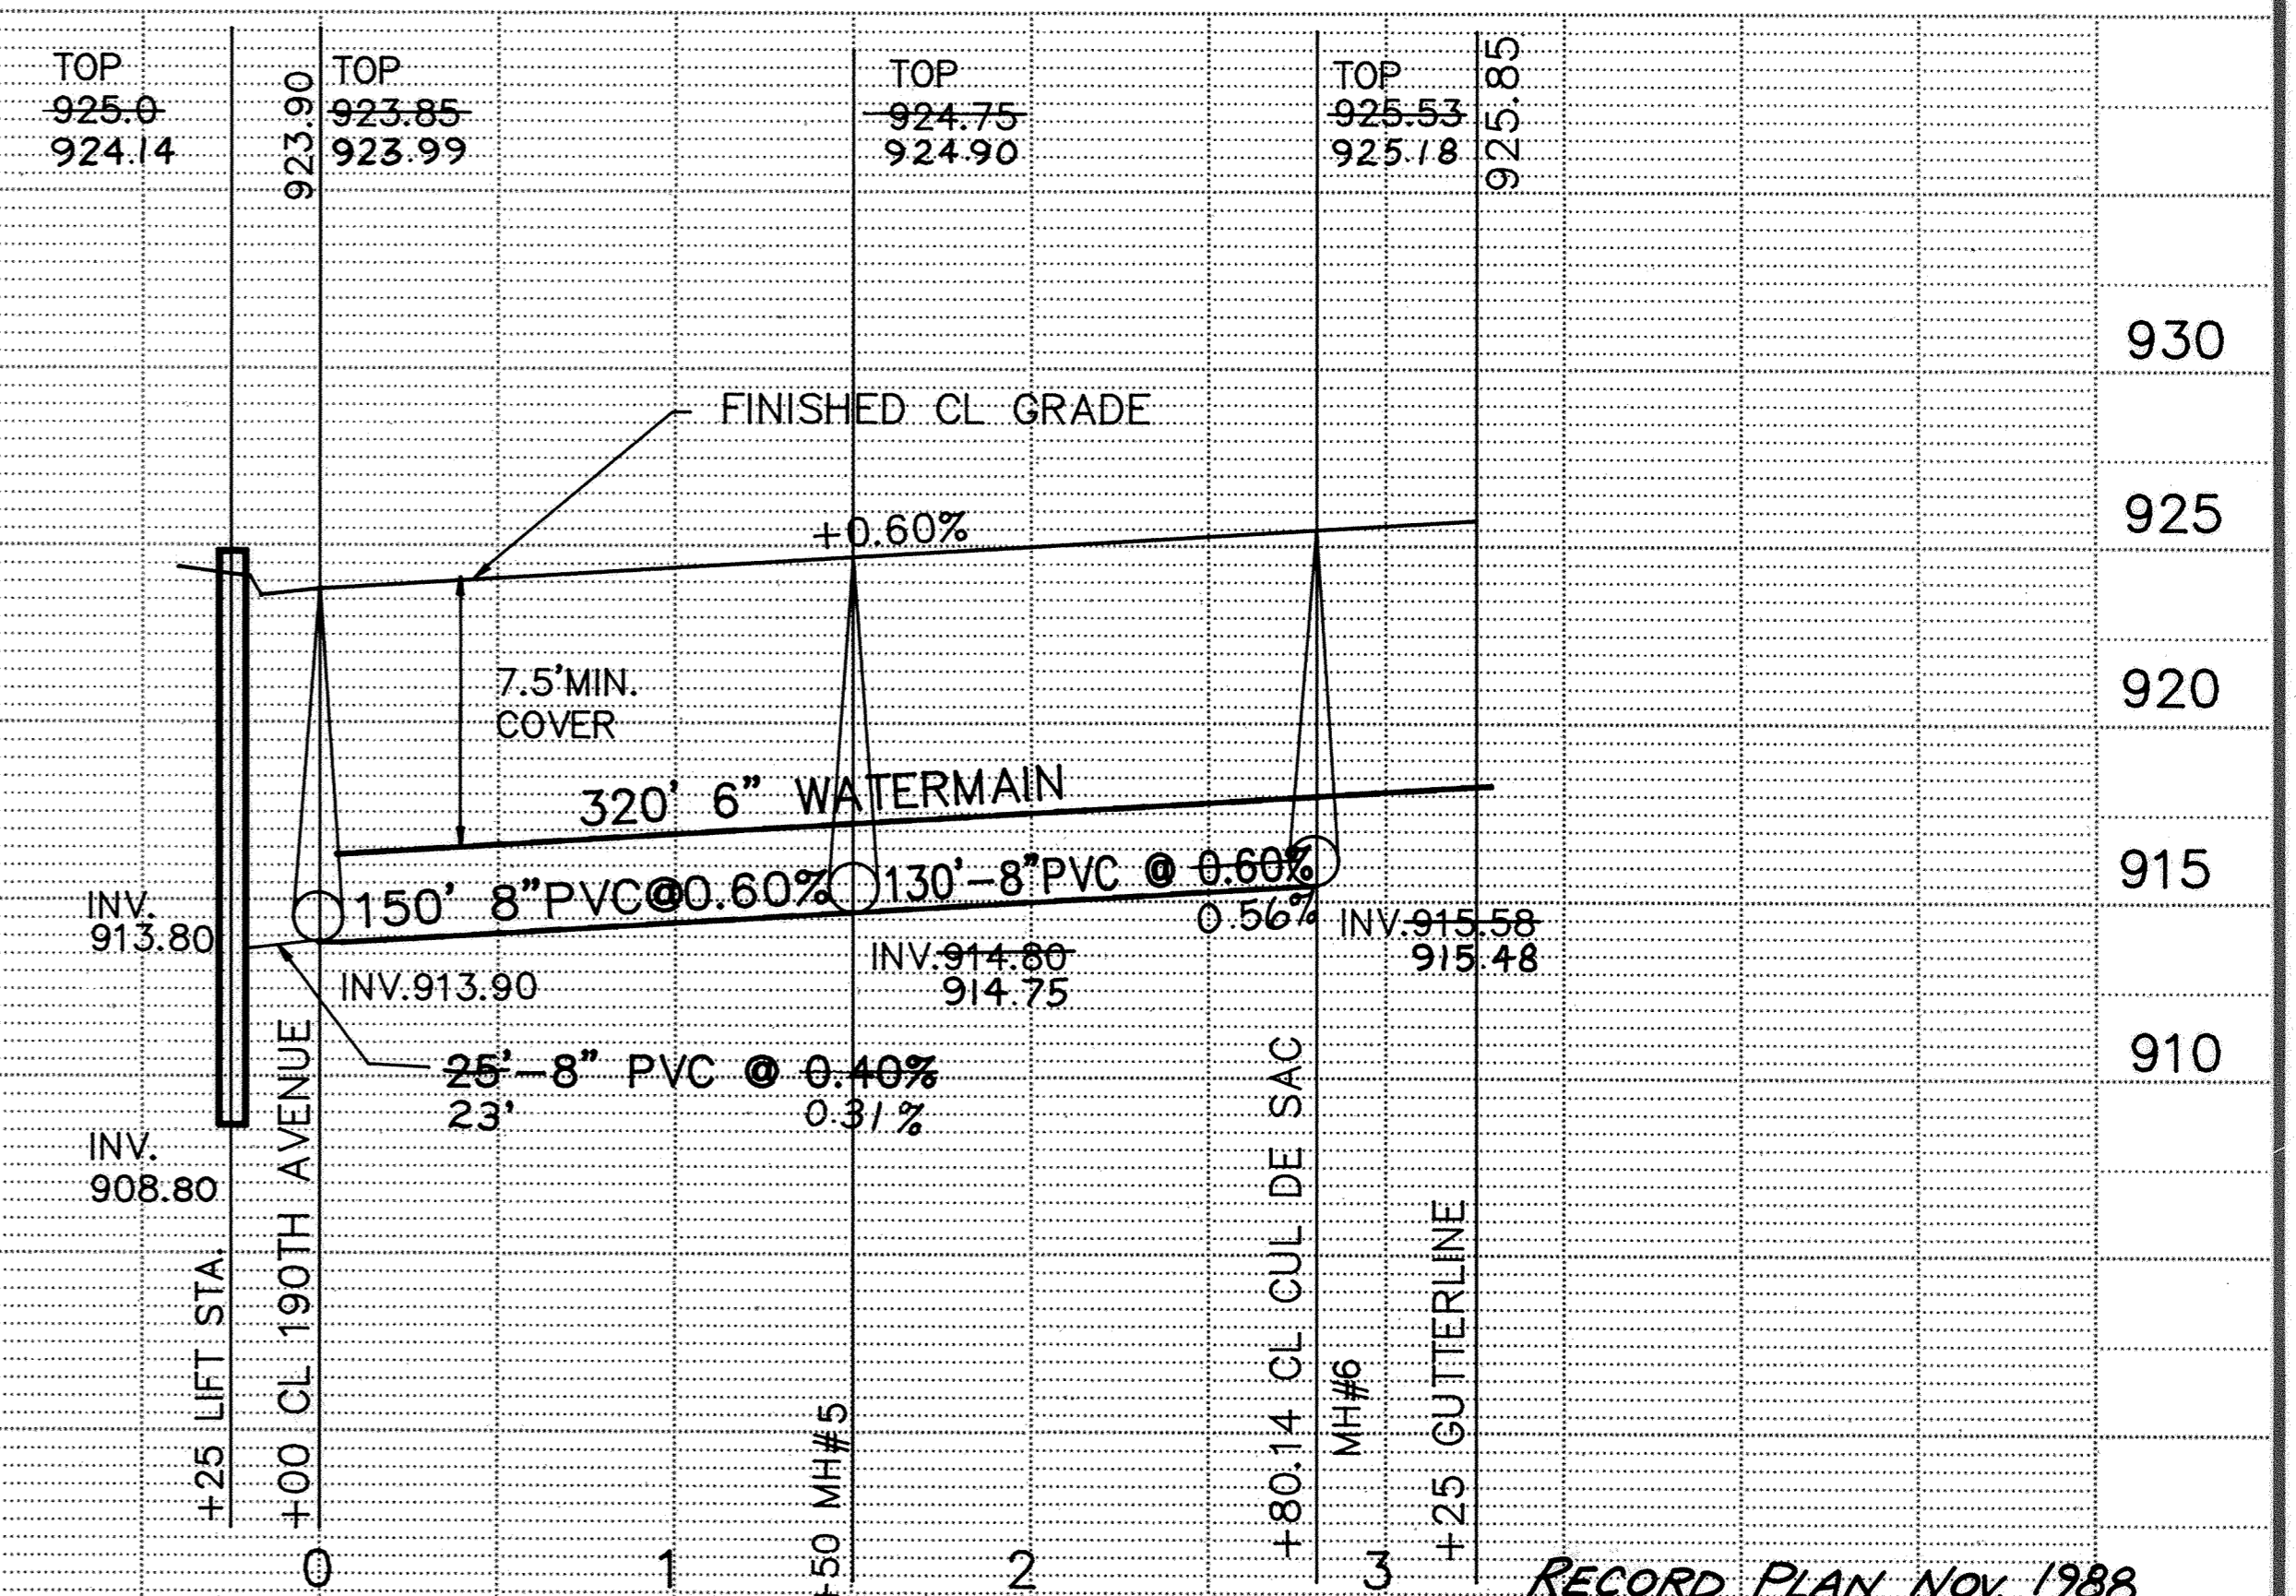
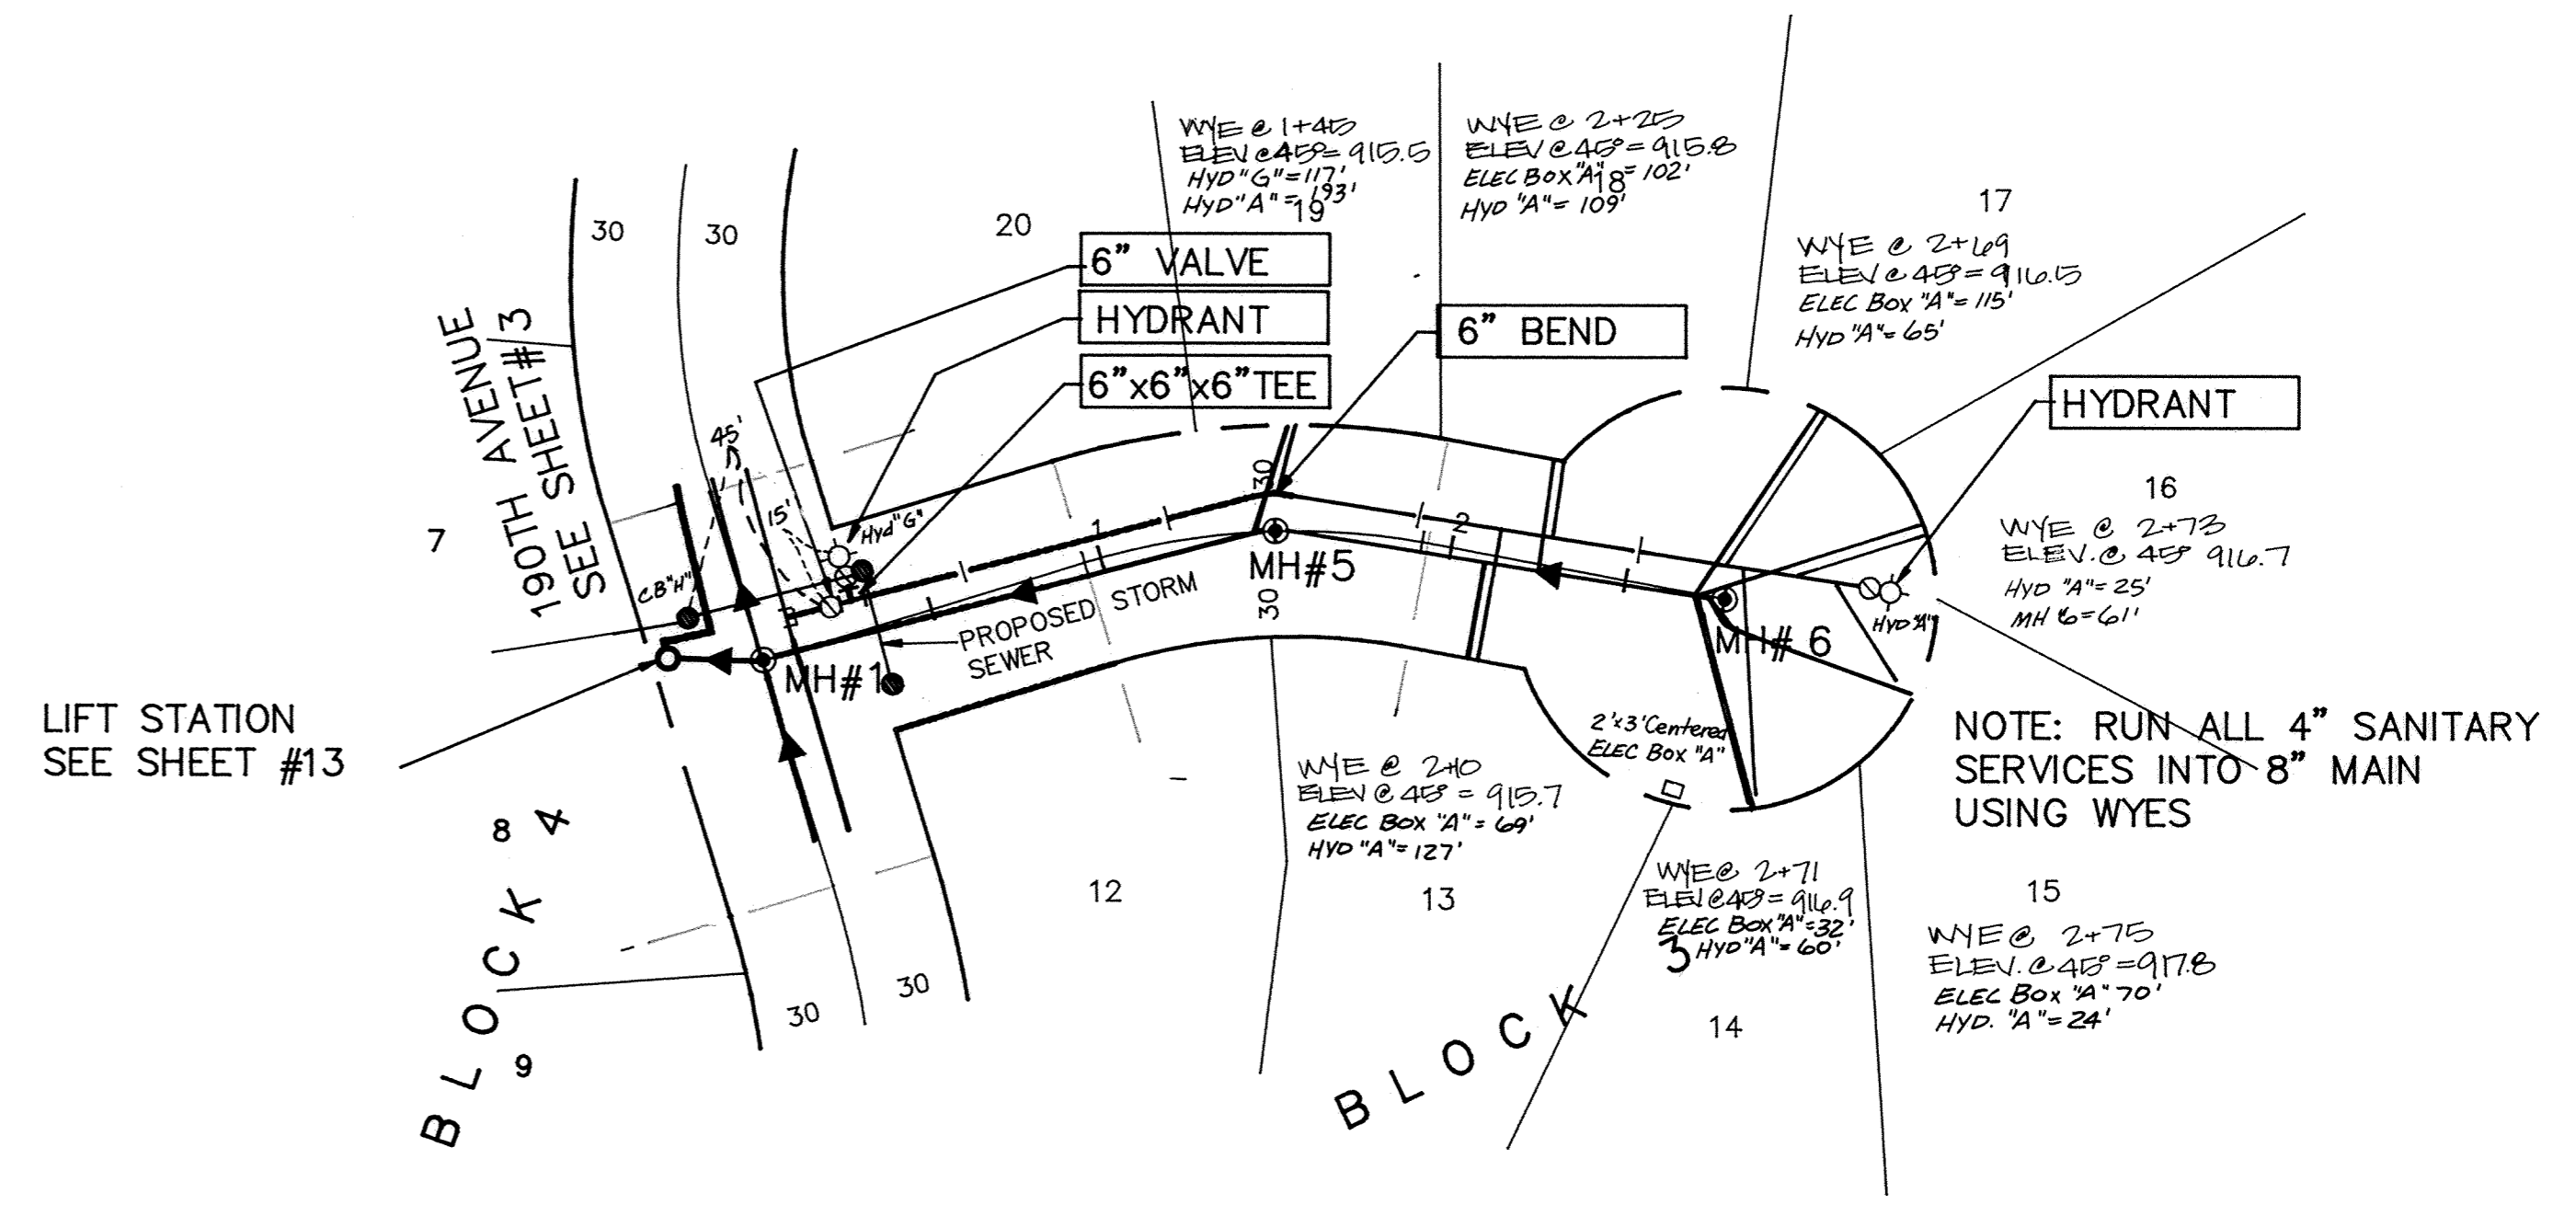


# YALE CIRCLE

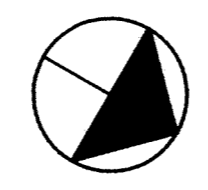

RECORD PLAN NOV. 1988

<p><b>Maier Stewart &amp; Associates Inc.</b> CONSULTING ENGINEERS</p> <p>1959 SLOAN PLACE (612)774-6021 ST. PAUL, MINNESOTA 55117</p>	DATE	DESCRIPTION	DESIGNED	CITY OF ELK RIVER	
	REVISIONS		CHECKED	SANITARY SEWER AND WATERMAIN	
			DRAWN	YALE CIRCLE	
			GRAPHIC SCALE	DATE	SHEET 4 OF 17 SHEETS
			HORIZ. 50'	MAR. 1988	PROJECT NO. 230-034
			VERT. 5'		