




# ZANE STREET

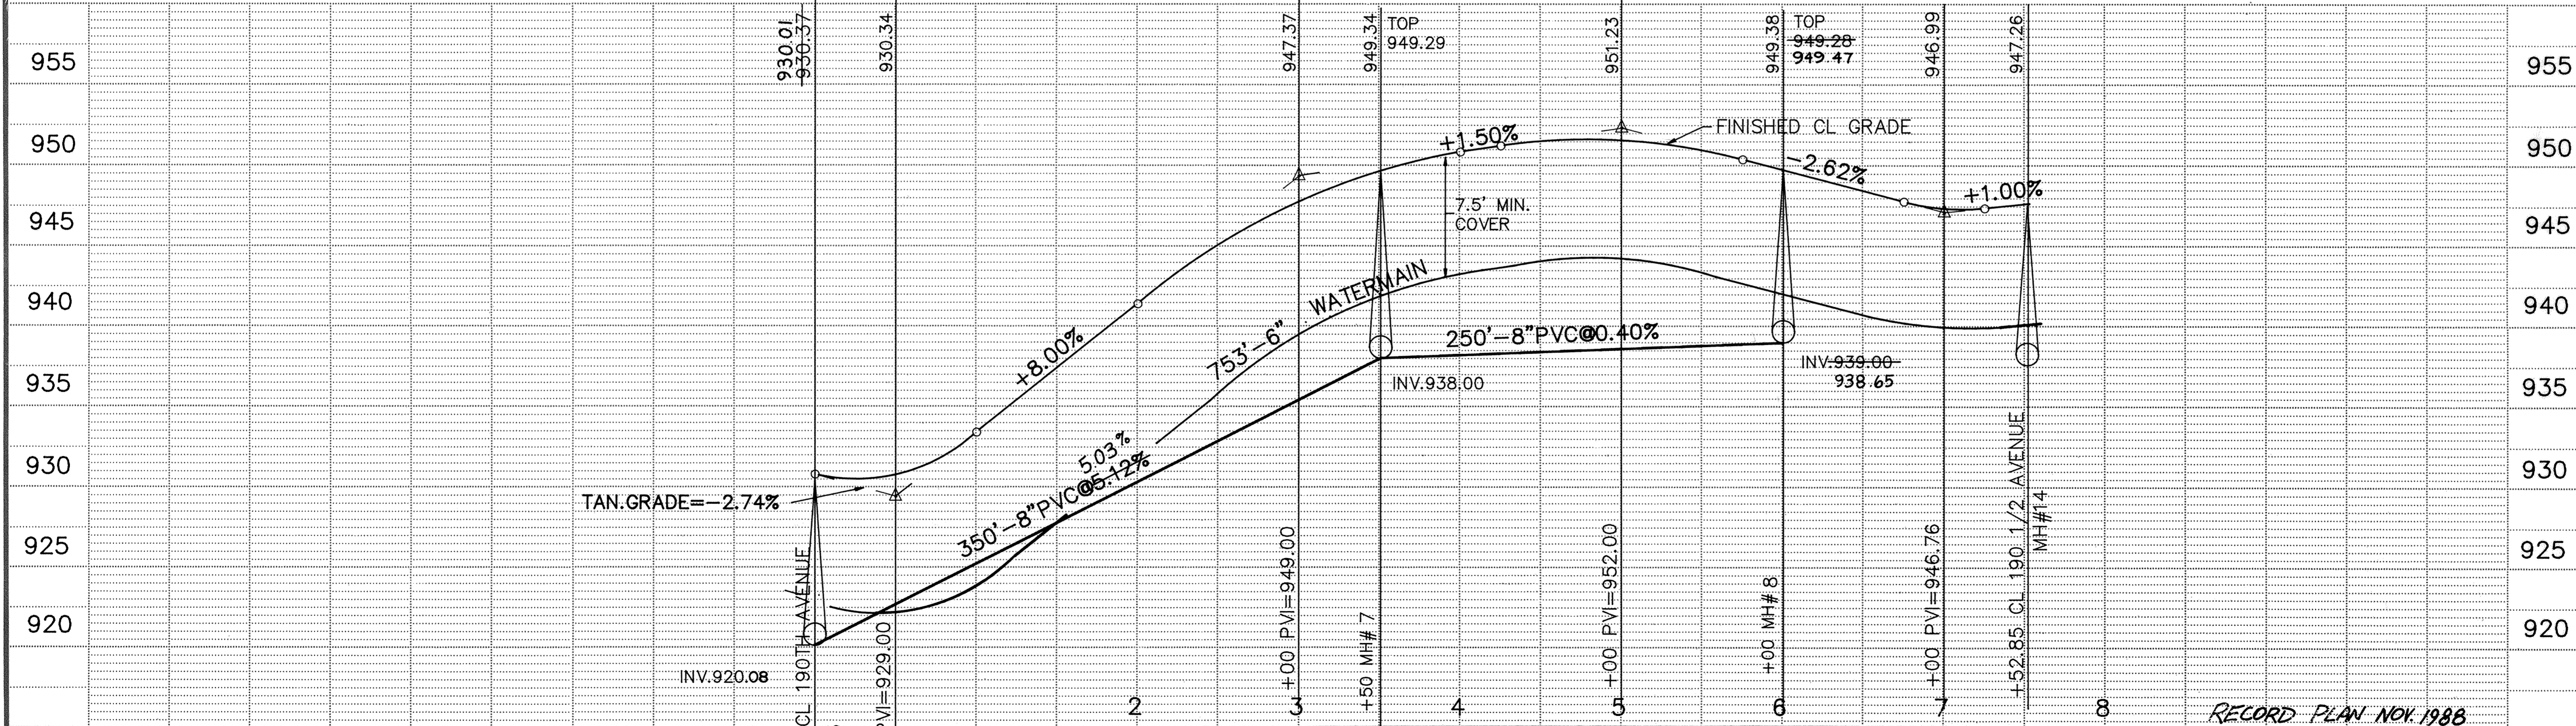

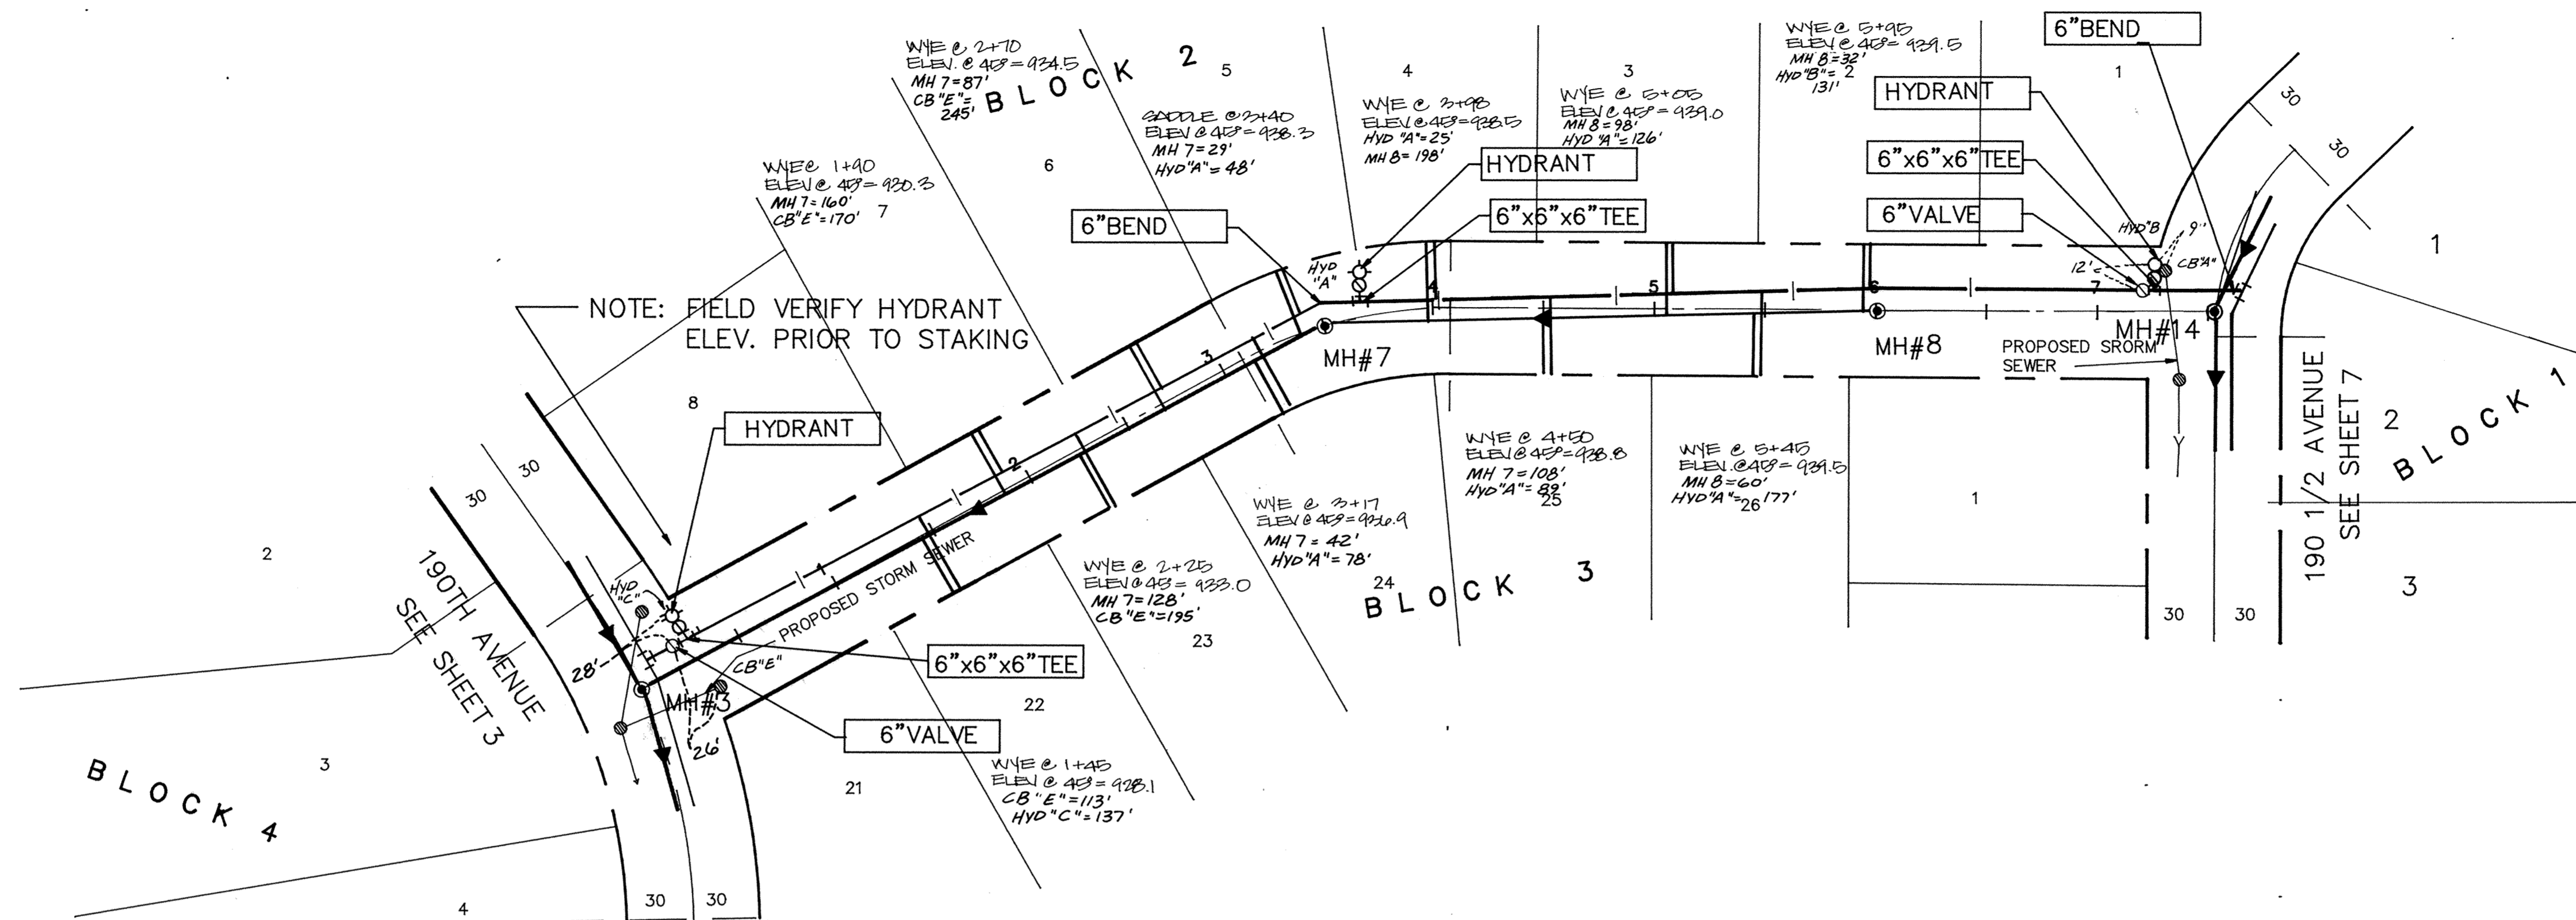

**CONSULTING ENGINEERS**  
**Maier Stewart & Associates Inc.**

1959 SLOAN PLACE (612) 774-6021 ST. PAUL, MINNESOTA 55117

DATE	DESCRIPTION	DESIGNED	CHECKED

**CITY OF ELK RIVER**  
**SANITARY SEWER AND WATERMAIN**  
**ZANE STREET**

DATE MAR.1988 SHEET 5 OF 17 SHEETS PROJECT NO. 230-034

RECORD PLAN NOV. 1988

DRAWING NUMBER  
 ROYAL 88  
 5  
 SDCO PRODUCTS • NEW HOPK, MINNESOTA  
 RESEARCH BY PART NUMBER 0532  
 PREPARED UNDER THE SUPERVISION OF THE ENGINEER