
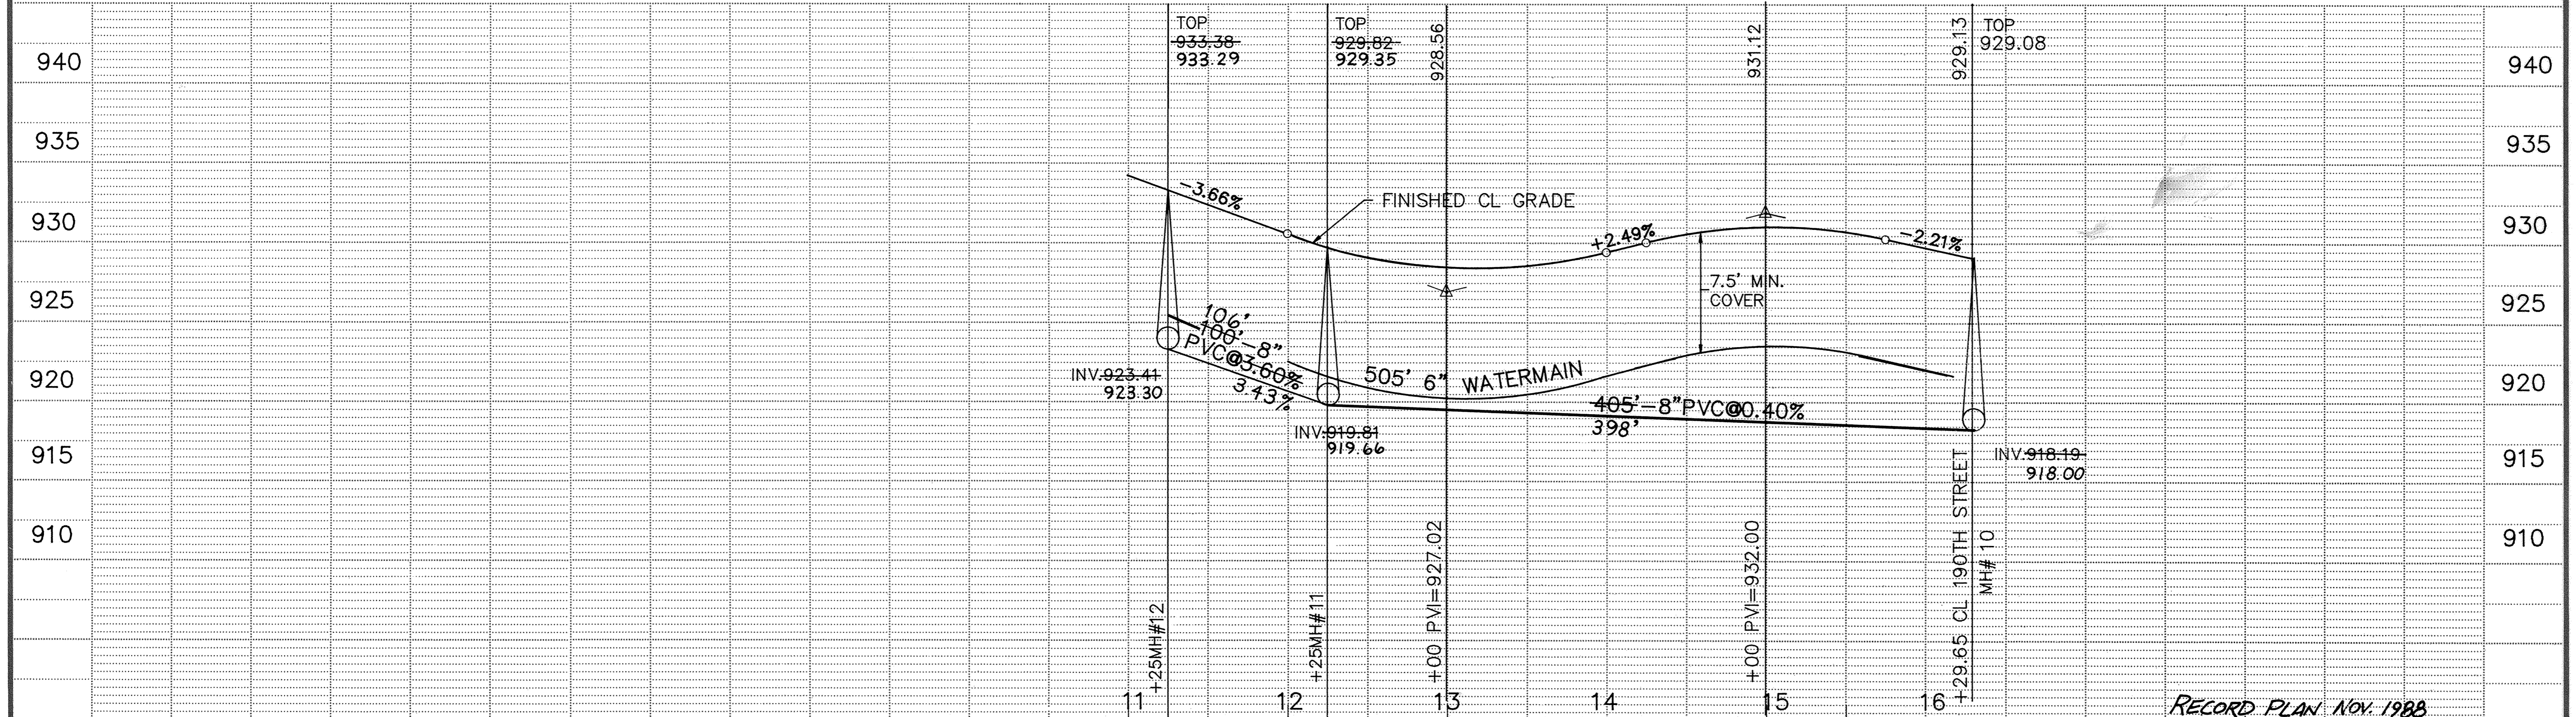
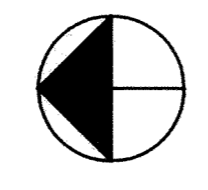


SACO PRODUCTS • NEW UPE, MINNESOTA
 REPRODUCED BY PART NUMBER 6032
 PERMITTED USE OF PART NUMBER 6032
 SACO PRODUCTS • NEW UPE, MINNESOTA
 REPRODUCED BY PART NUMBER 6032
 PERMITTED USE OF PART NUMBER 6032
 SACO PRODUCTS • NEW UPE, MINNESOTA
 REPRODUCED BY PART NUMBER 6032
 PERMITTED USE OF PART NUMBER 6032

XAVIER STREET

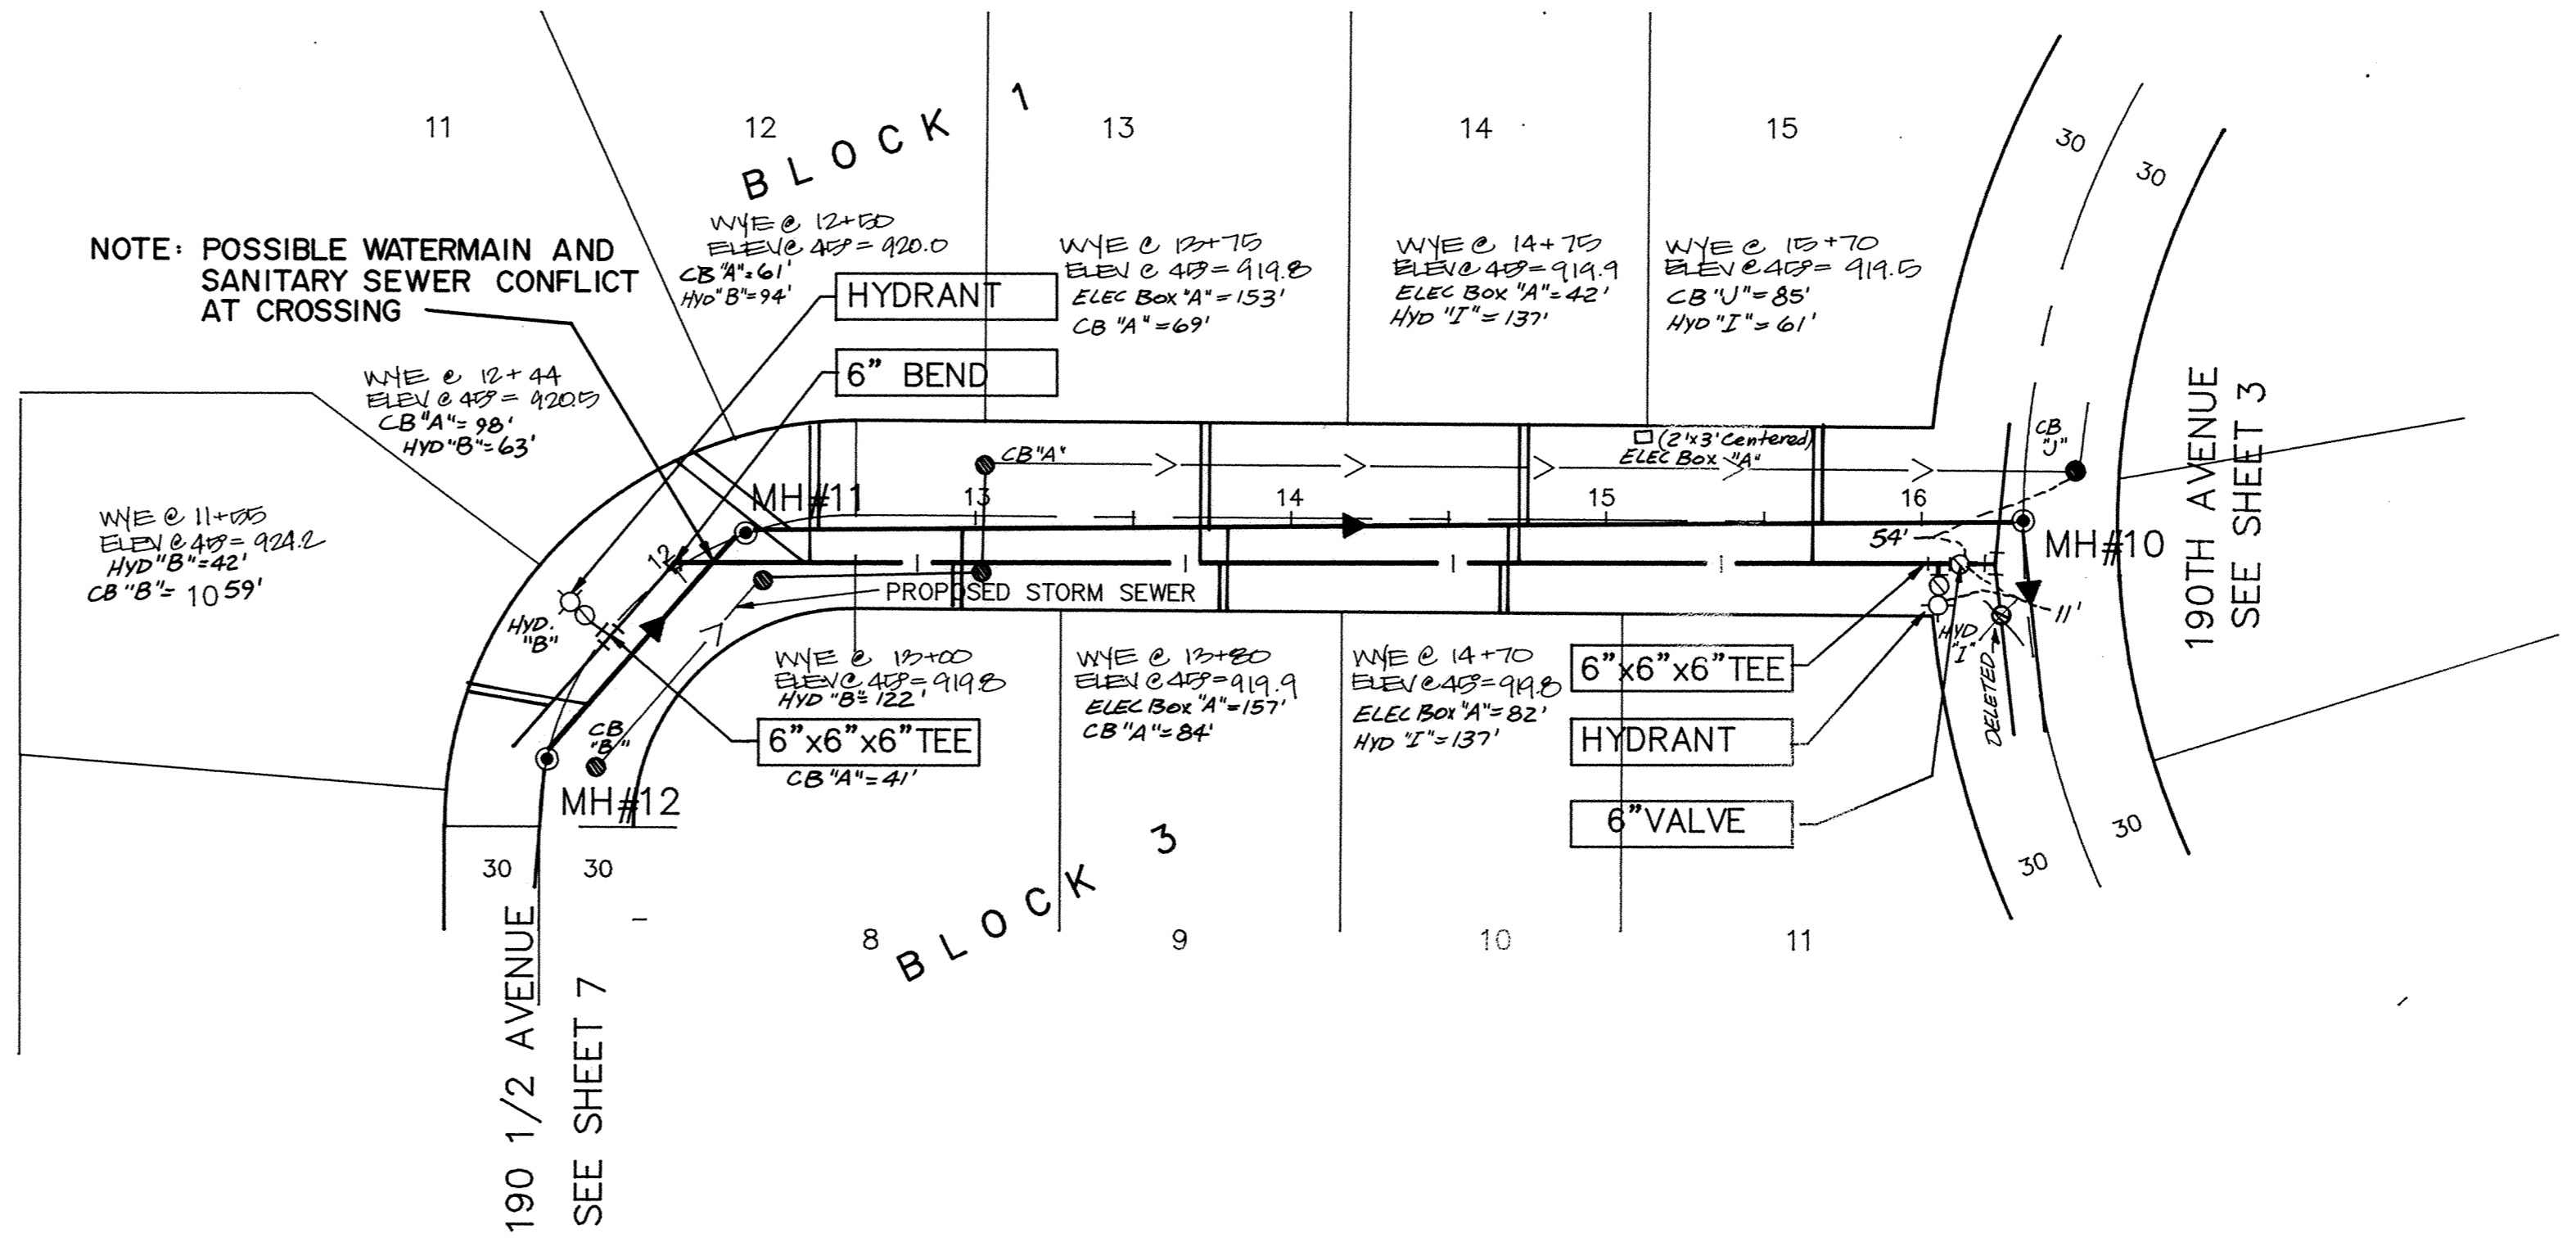

RECORD PLAN NOV. 1988

<p>CONSULTING ENGINEERS Maier Stewart & Associates Inc. 1959 SLOAN PLACE (612)774-6021 ST. PAUL, MINNESOTA 55117</p>	DATE	DESCRIPTION	DESIGNED	<p>CITY OF ELK RIVER SANITARY SEWER AND WATERMAIN XAVIER STREET</p> <p>DATE MAR.1988 SHEET 6 OF 17 SHEETS PROJECT NO. 230.034</p> <p style="text-align: right; font-weight: bold;">286</p>		
	REVISIONS		CHECKED			
			DRAWN MRJ			
			GRAPHIC SCALE			
			0' HORIZ. 50'			
			0' VERT. 5'			