
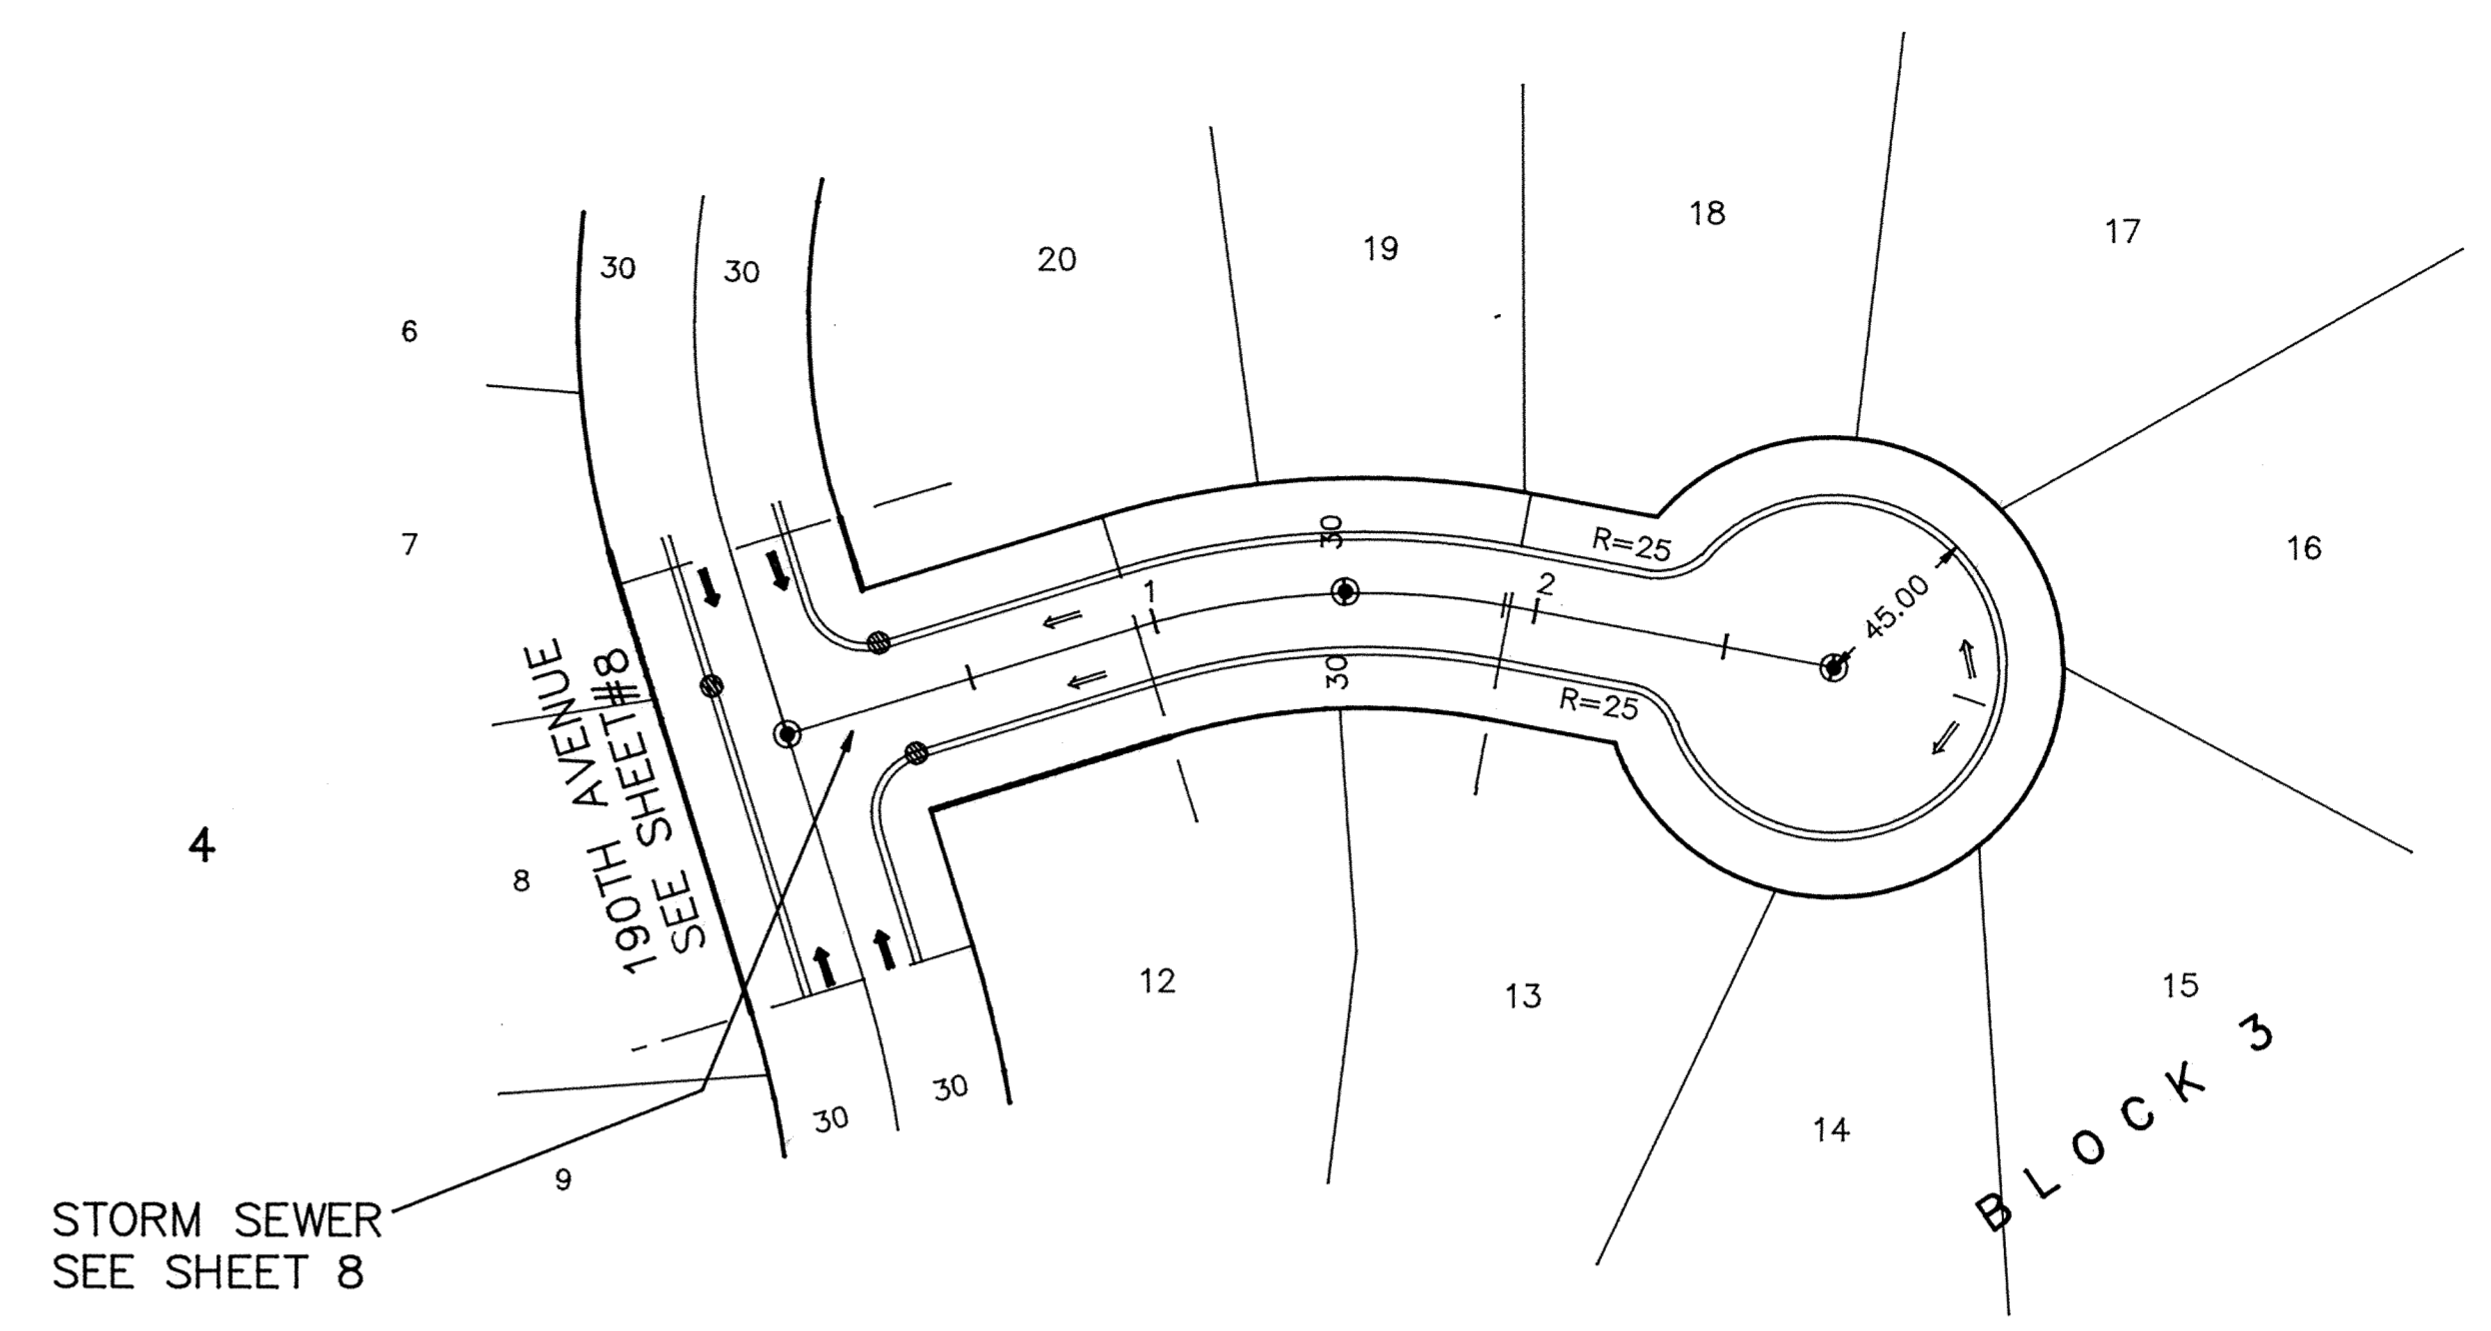


YALE CIRCLE

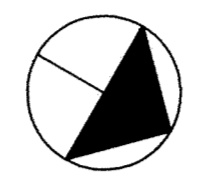

RECORD PLAN NOV. 1988

Maier Stewart & Associates Inc. CONSULTING ENGINEERS 1959 SLOAN PLACE (612)774-6021 ST. PAUL, MINNESOTA 55117	DATE	DESCRIPTION	DESIGNED	CITY OF ELK RIVER STREET AND STORM SEWER YALE CIRCLE	DATE	SHEET	OF	SHEETS	PROJECT NO.
	REVISIONS		CHECKED		MAR.1988	9	17		230-034
			DRAWN		MRJ				
				GRAPHIC SCALE					
				HORIZ. 50					
				VERT. 5					