



INDEPENDENT SCHOOL DISTRICT NO. 278

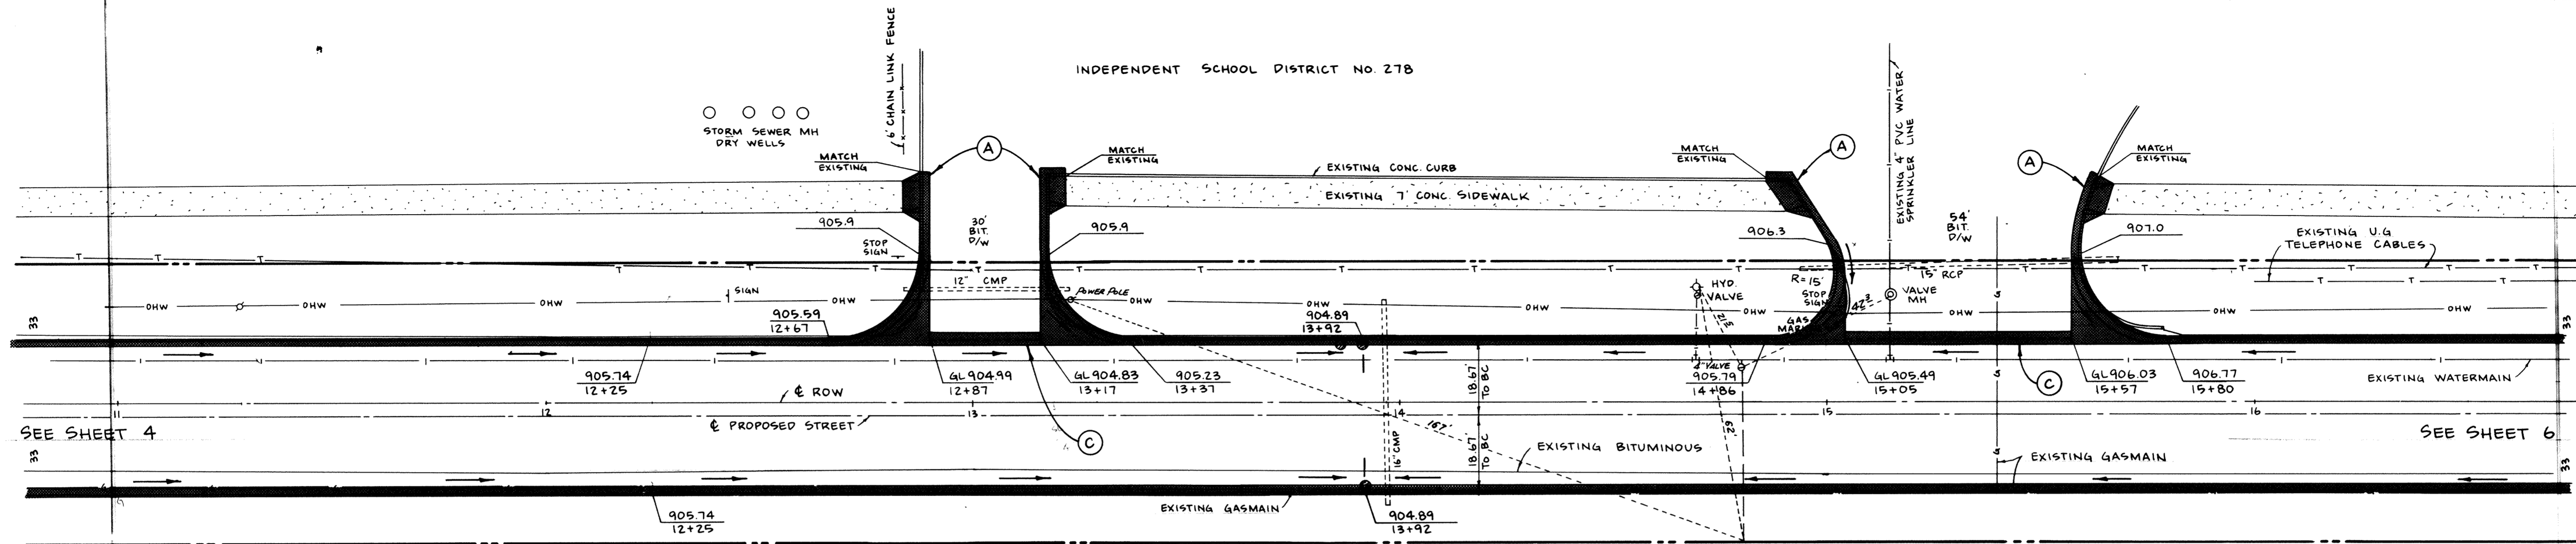

NOTES:
 1) SEE GENERAL STREET CONSTRUCTION NOTES ON SHEET 2.
 2) SEE STREET CONSTRUCTION LEGEND ON SHEET 2.

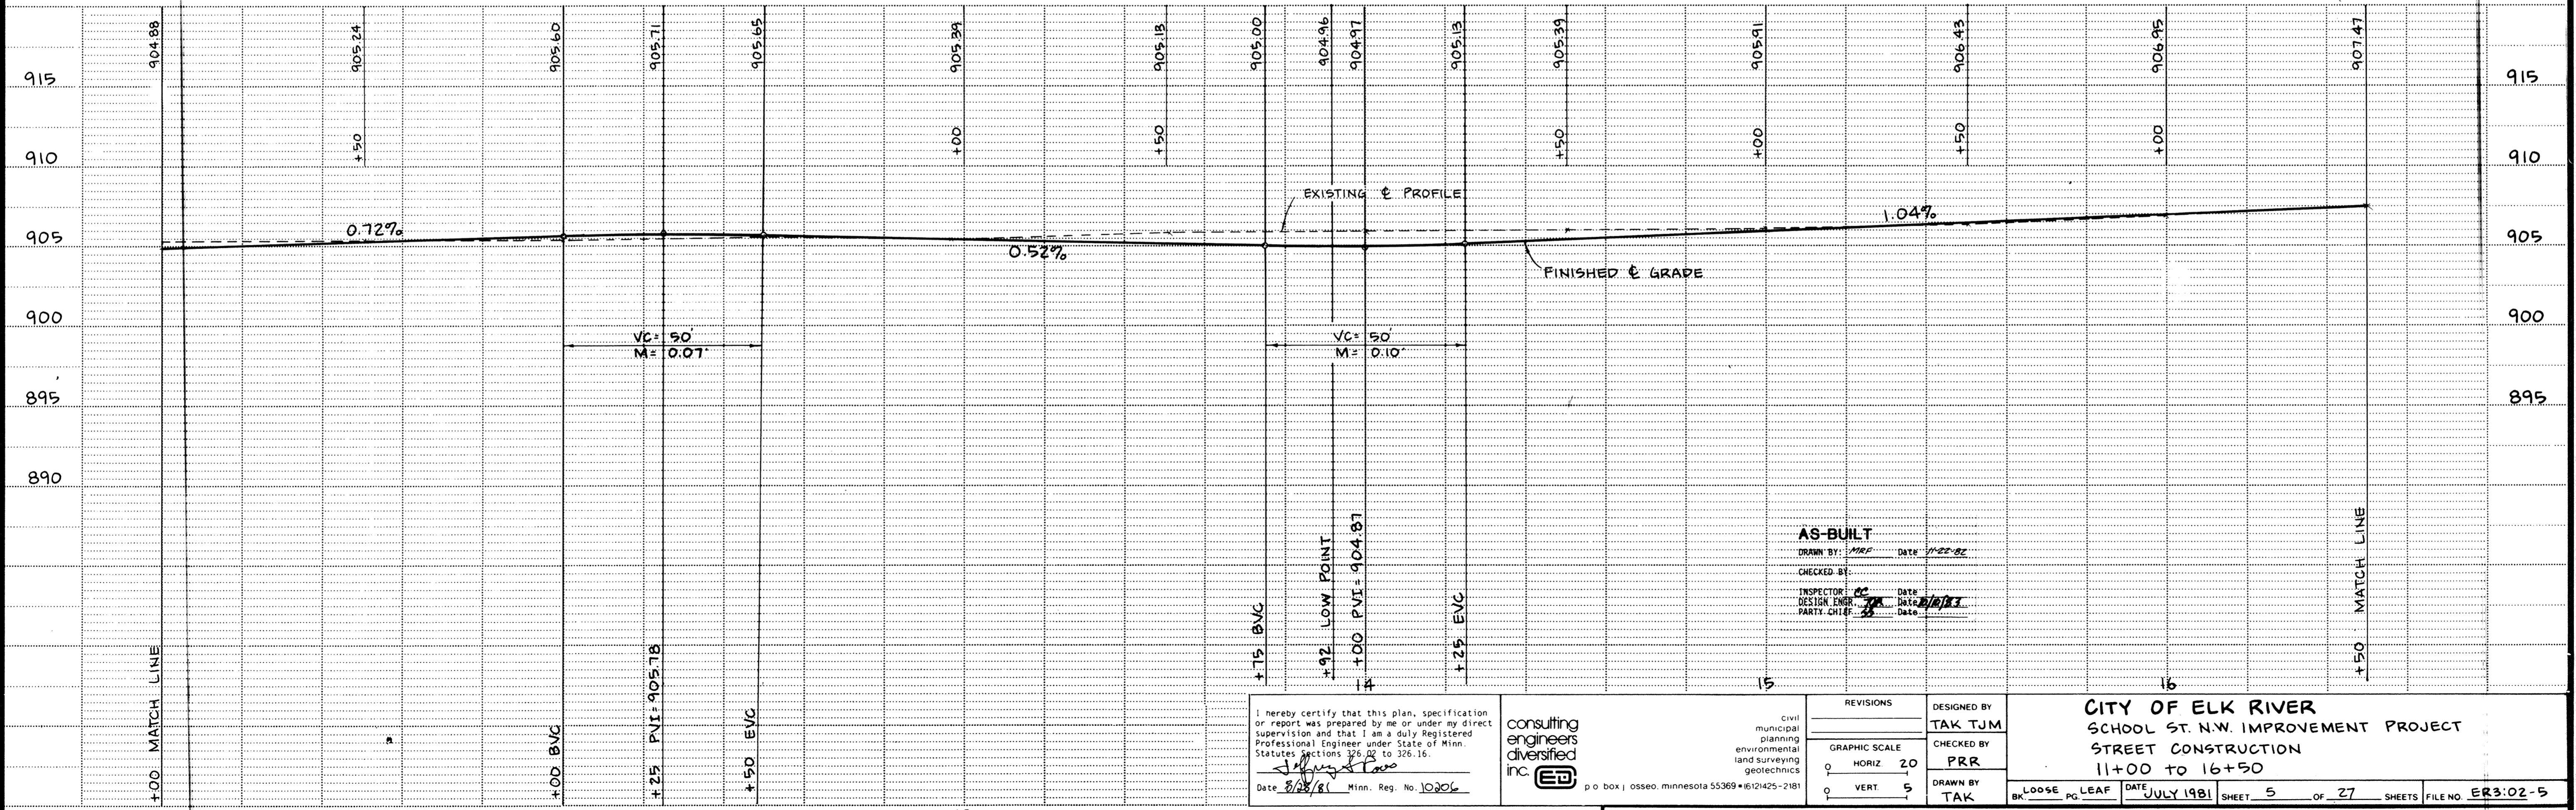

AS-BUILT
 DRAWN BY: MRP DATE: 11-22-82
 CHECKED BY: PRR
 INSPECTOR: DC DATE: 11/21/82
 DESIGN ENGINEER: JAK DATE: 11/21/82
 PARTY CHIEF: JAK

I hereby certify that this plan, specification or report was prepared by me or under my direct supervision and that I am a duly Registered Professional Engineer under State of Minn. Statutes sections 326.02 to 326.16.
 Date: 8/25/81 Minn. Reg. No. 10206

consulting engineers diversified inc.
 civil municipal planning environmental land surveying geotechnics
 p o box 1 osseo, minnesota 55369 +612/425-2181

DESIGNED BY	TAK TJM
CHECKED BY	PRR
DRAWN BY	TAK
REVISIONS	
GRAPHIC SCALE	0 HORIZ 20 0 VERT 5

CITY OF ELK RIVER
 SCHOOL ST. N.W. IMPROVEMENT PROJECT
 STREET CONSTRUCTION
 11+00 TO 16+50
 DATE: JULY 1981
 SHEET 5 OF 27 SHEETS
 FILE NO. ER3:02-5

DRAWING NUMBER

DRAWING NUMBER

DRAWING NUMBER

DRAWING NUMBER
SCHOOL 81