



INDEPENDENT SCHOOL DISTRICT NO. 78

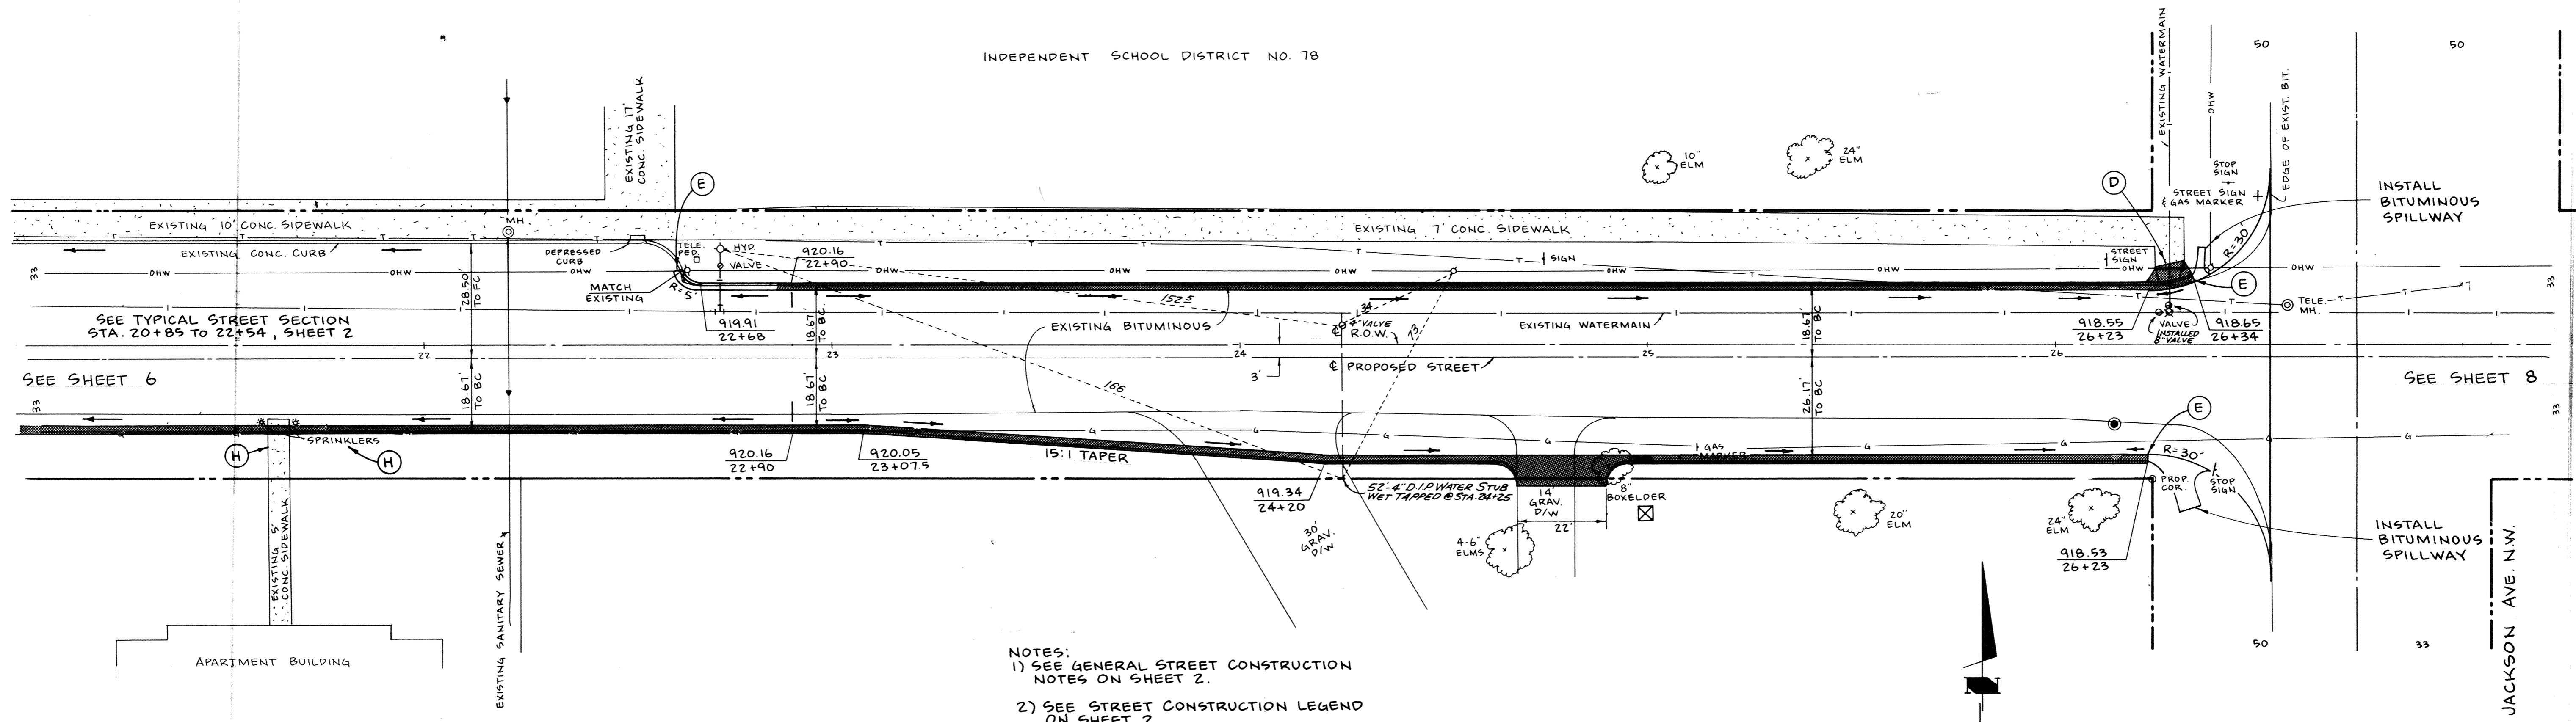

NOTES:
 1) SEE GENERAL STREET CONSTRUCTION NOTES ON SHEET 2.
 2) SEE STREET CONSTRUCTION LEGEND ON SHEET 2.

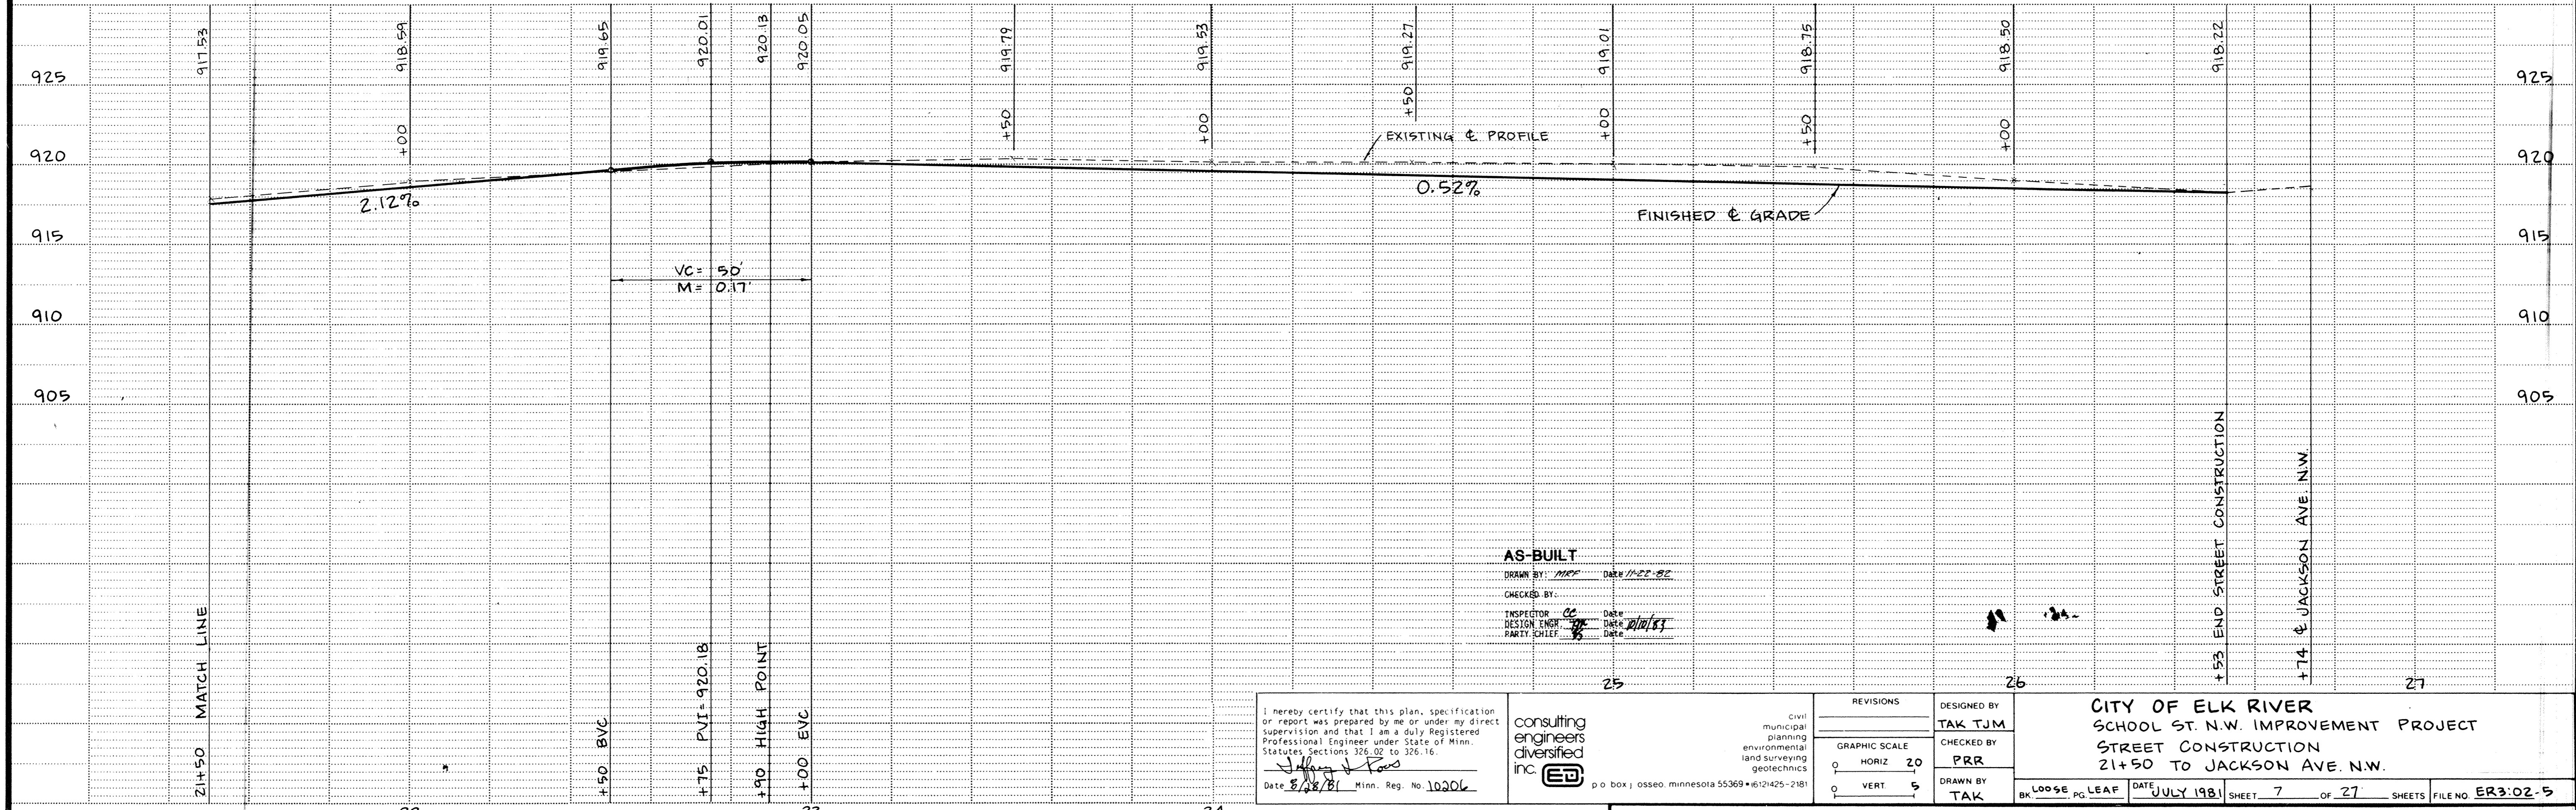

AS-BUILT
 DRAWN BY: [Signature] DATE: 11/22/82
 CHECKED BY: [Signature]
 INSPECTOR: [Signature] DATE: 12/1/82
 DESIGN ENGR: [Signature] DATE: 12/1/82
 PARTY CHIEF: [Signature] DATE: 12/1/82

I hereby certify that this plan, specification or report was prepared by me or under my direct supervision and that I am a duly Registered Professional Engineer under State of Minn. Statutes Sections 326.02 to 326.16.
 [Signature]
 Date: 8/28/81 Minn. Reg. No. 102206

consulting engineers diversified inc. [Logo]

DESIGNED BY	TAK TJM
CHECKED BY	PRR
DRAWN BY	TAK
DATE	JULY 1981

CITY OF ELK RIVER
 SCHOOL ST. N.W. IMPROVEMENT PROJECT
 STREET CONSTRUCTION
 21+50 TO JACKSON AVE. N.W.
 BK LOOSE PG. LEAF DATE: JULY 1981 SHEET 7 OF 27 SHEETS FILE NO. ER3-02-5

DRAWING NUMBER
 SCH00 81
 7
 61