



INDEPENDENT SCHOOL DISTRICT No. 218

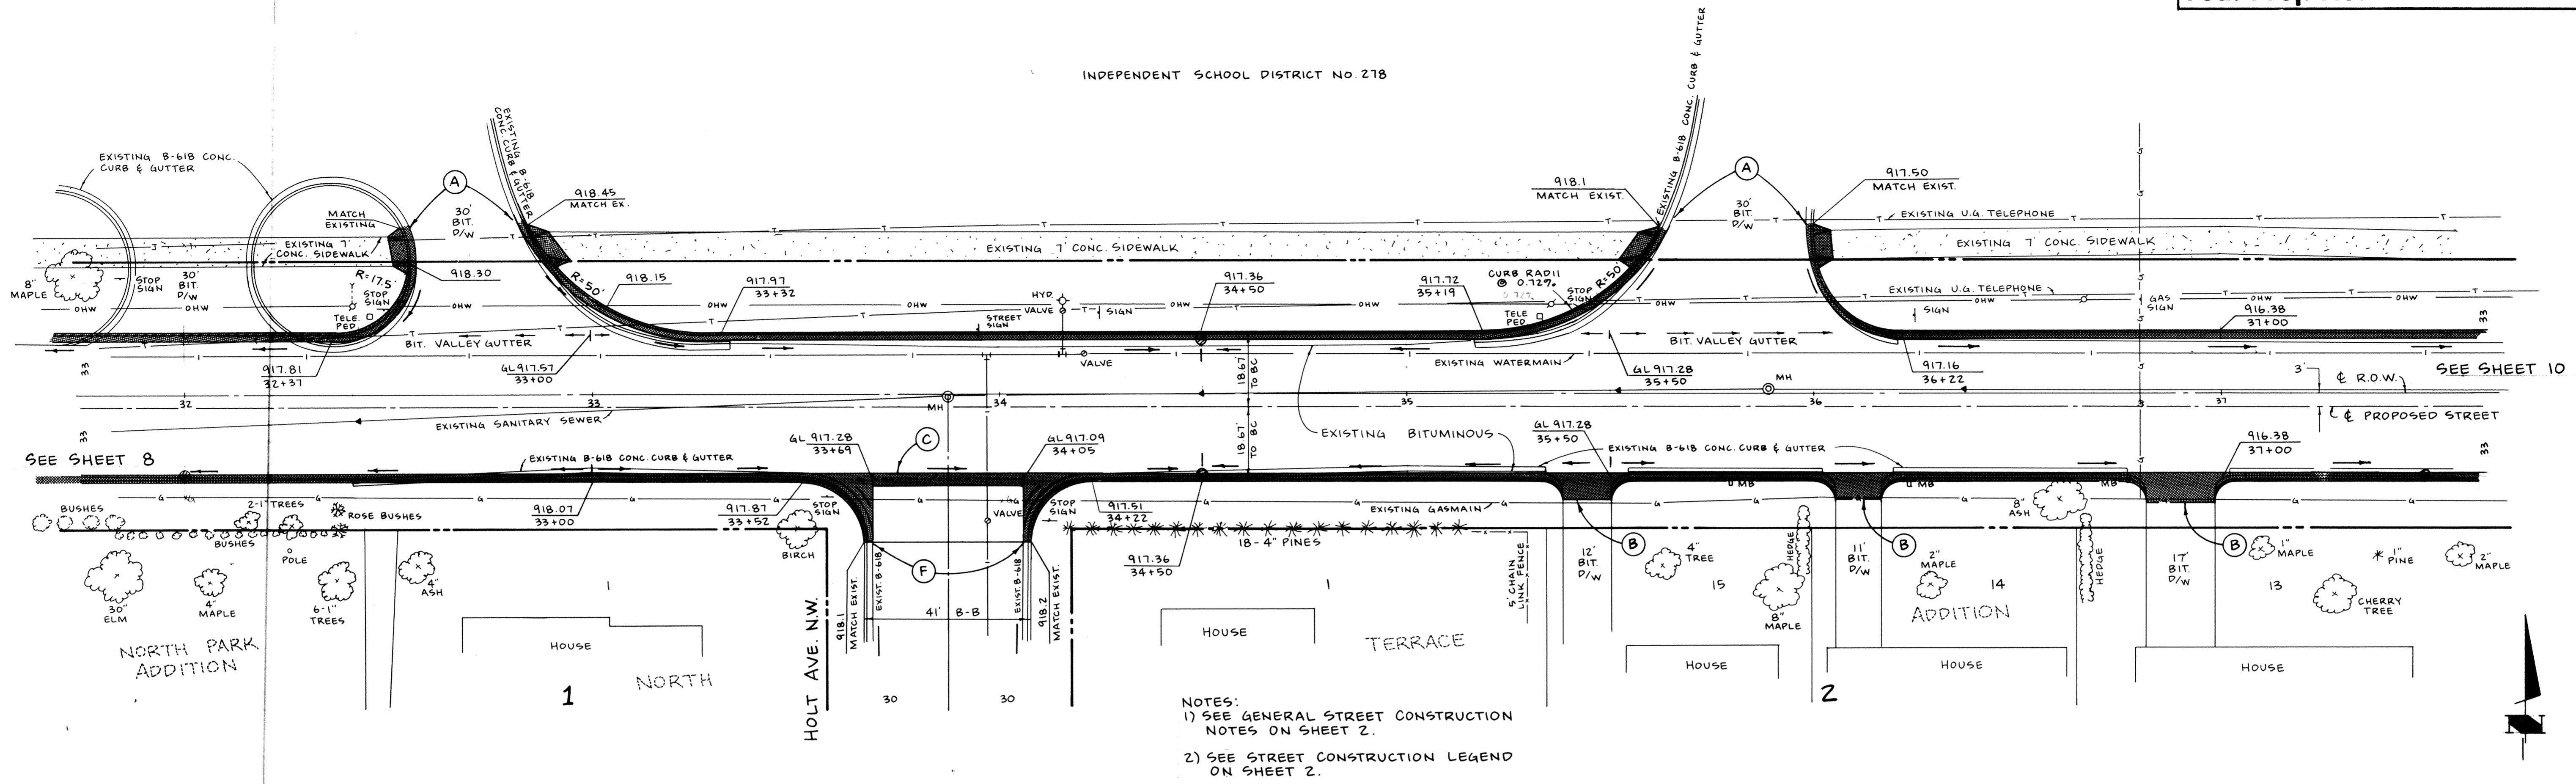

NOTES:
 1) SEE GENERAL STREET CONSTRUCTION NOTES ON SHEET 2.
 2) SEE STREET CONSTRUCTION LEGEND ON SHEET 2.

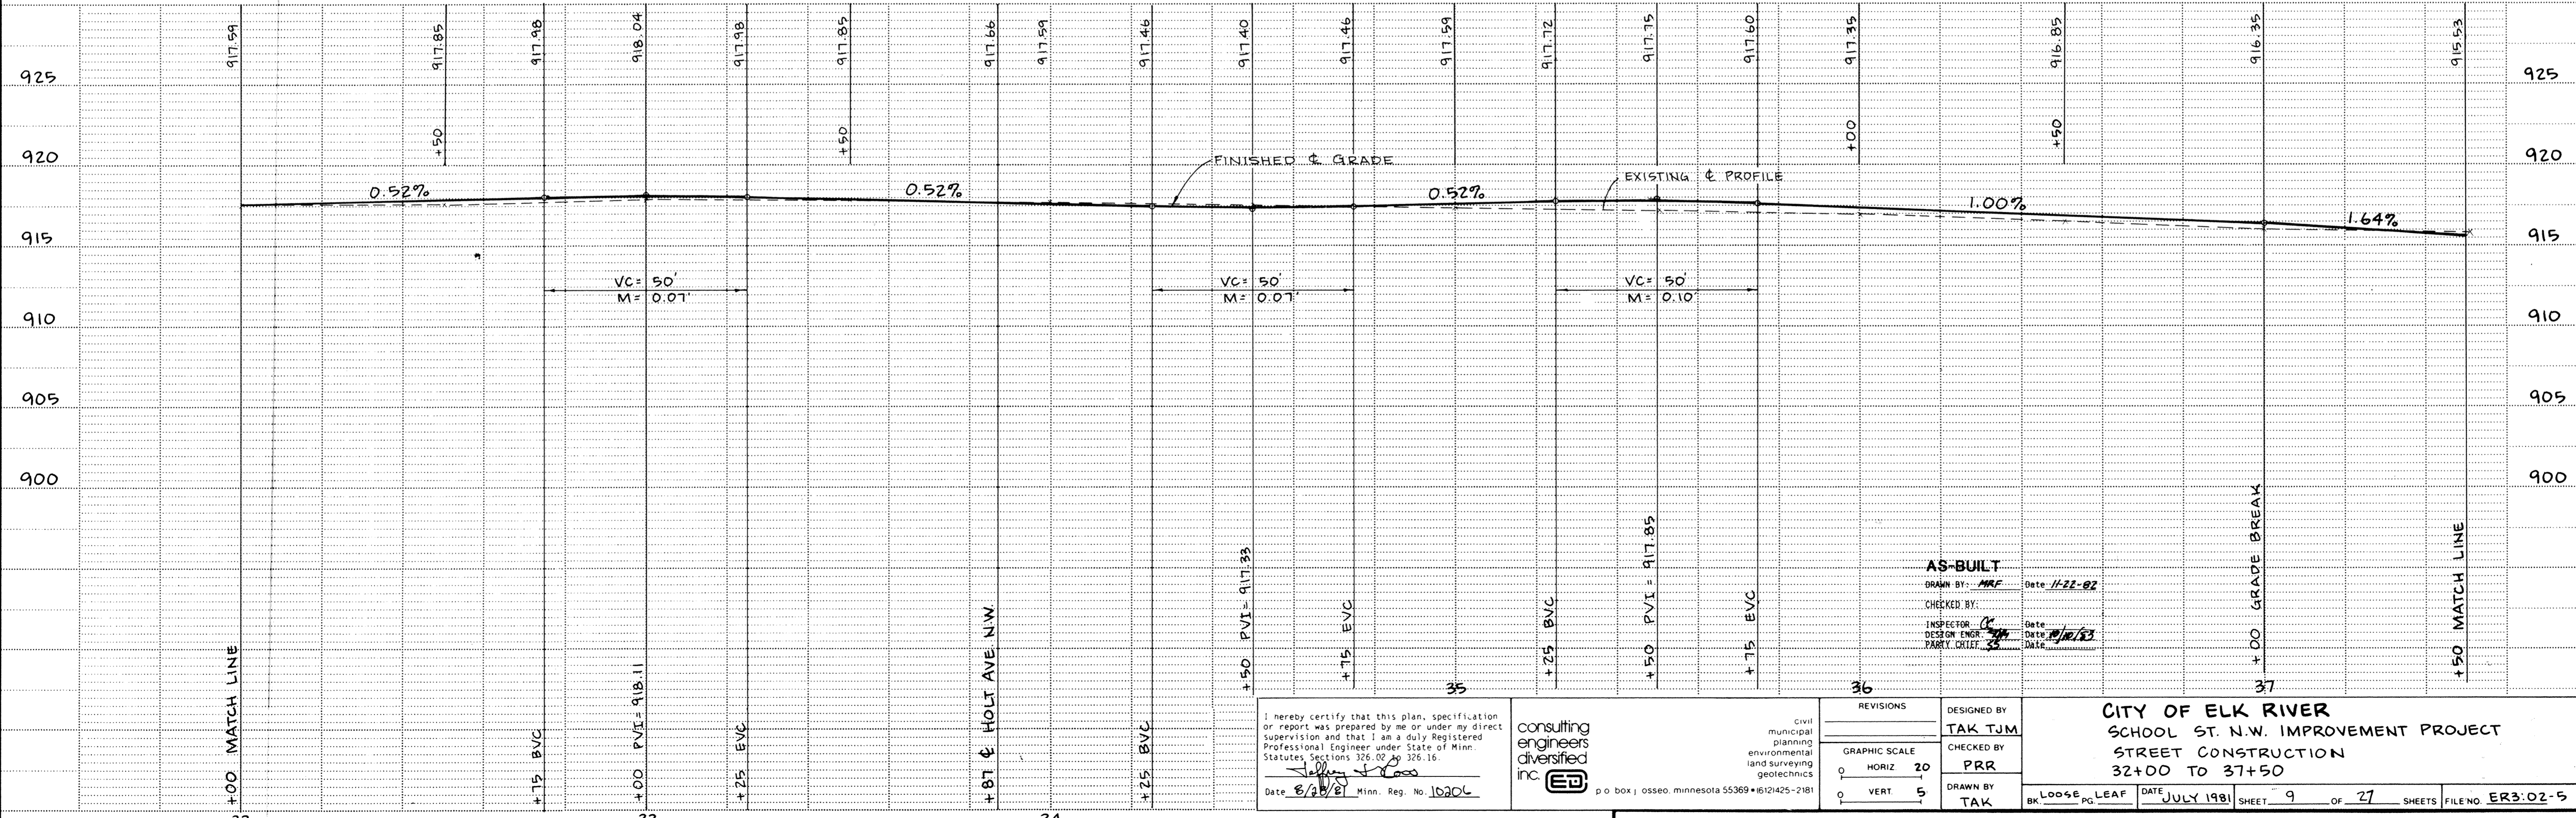

AS-BUILT
 DRAWN BY: *MRP* Date: 11-22-82
 CHECKED BY: *PRR*
 INSPECTOR: *PK* Date: 11/10/83
 DESIGN ENGR: *PK*
 PARTY CHIEF: *PK*

I hereby certify that this plan, specification or report was prepared by me or under my direct supervision and that I am a duly Registered Professional Engineer under State of Minnesota Statutes Sections 326.02 to 326.16.
Jeffrey J. Ross
 Date: 8/28/87 Min. Reg. No. 10206

consulting engineers diversified inc.
 civil municipal planning environmental and surveying geotechnics
 po box 1050 osseo, minnesota 55369 • 612/425-2181

DESIGNED BY	TAK TJM
CHECKED BY	PRR
DRAWN BY	TAK

CITY OF ELK RIVER
 SCHOOL ST. N.W. IMPROVEMENT PROJECT
 STREET CONSTRUCTION
 32+00 TO 37+50

DATE: JULY 1981 SHEET 9 OF 27 SHEETS FILE NO. ER3-02-5

DRAWING NUMBER: SCHOOL 81