


NOTES:
 1) SEE GENERAL STREET CONSTRUCTION NOTES ON SHEET 2.
 2) SEE STREET CONSTRUCTION LEGEND ON SHEET 2.

NOTE: APPROXIMATE LOCATION OF PROPOSED STREET AS PER PRELIMINARY PLAT. VERIFY LOCATION IN FIELD.

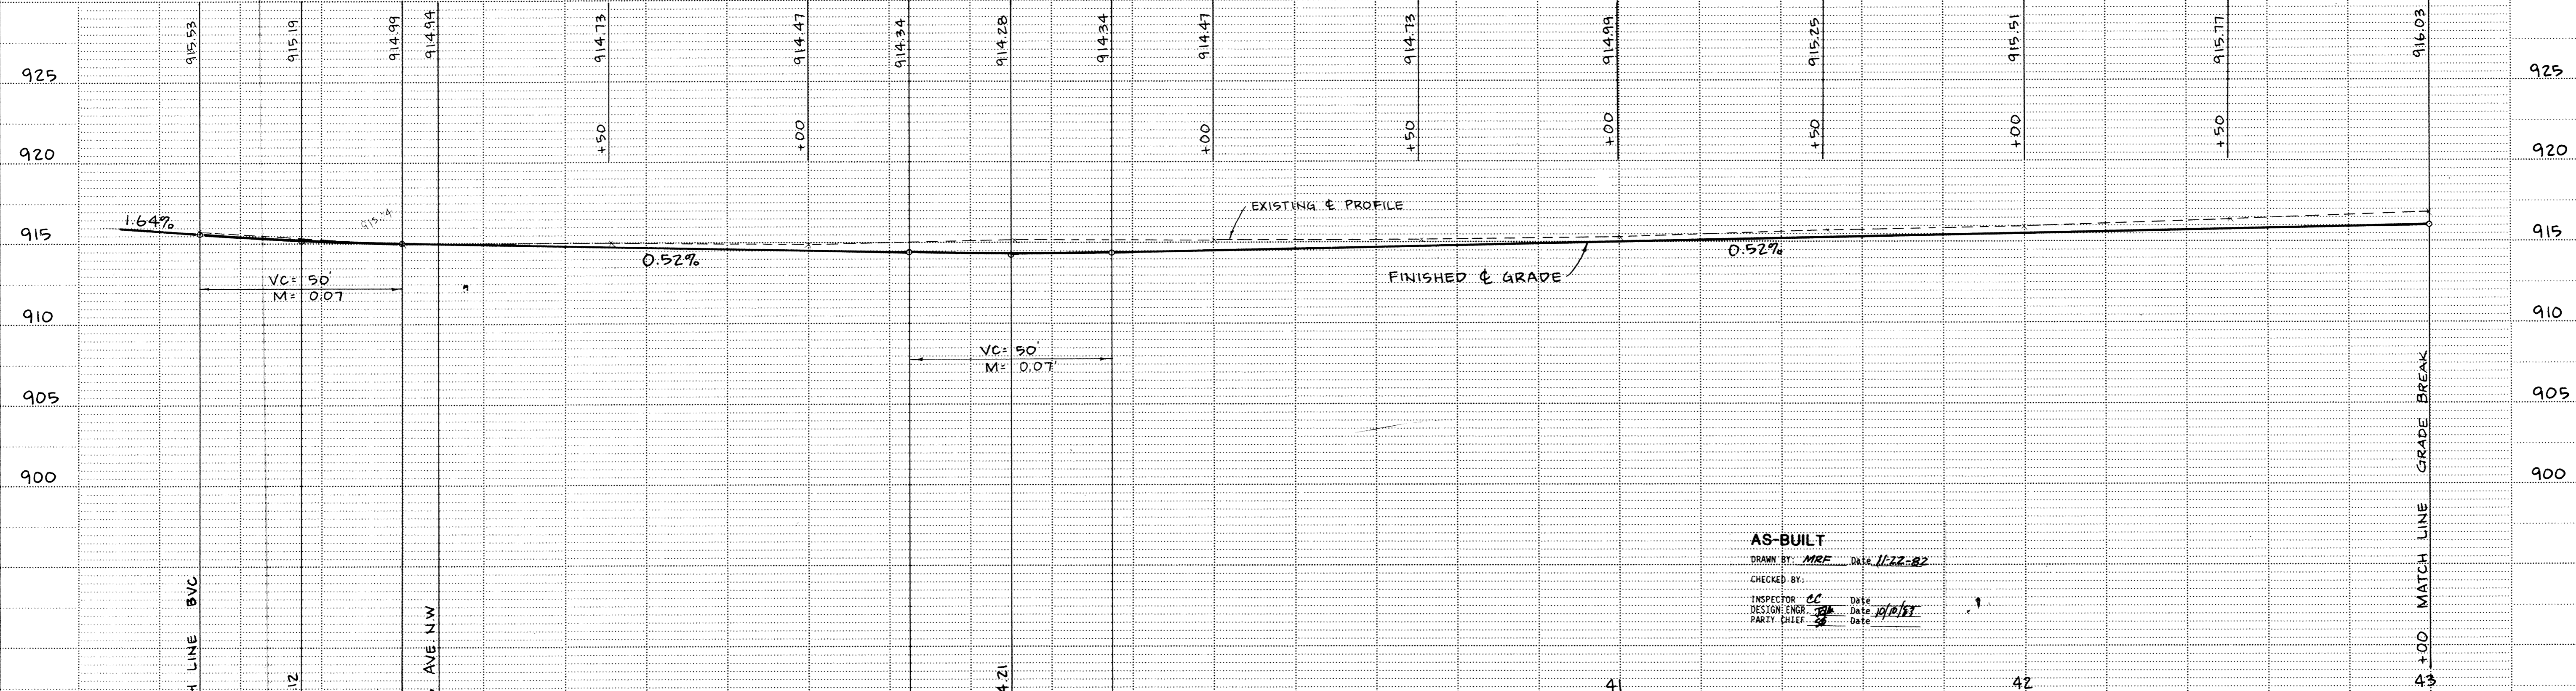

AS-BUILT
 DRAWN BY: MRE Date: 11/22/82
 CHECKED BY:
 INSPECTOR: CC Date: 11/18/82
 DESIGN ENGR: [Signature] Date: 11/18/82
 PARTY CHIEF: [Signature] Date:

I hereby certify that this plan, specification or report was prepared by me or under my direct supervision and that I am a duly Registered Professional Engineer under State of Minn. Statutes Sections 326.02 to 326.16.
 Date: 8/26/81 Minn. Reg. No. 10266

consulting engineers diversified inc. [Logo]
 p o box j osseo, minnesota 55369 • (612) 425-2181

REVISIONS	

DESIGNED BY: TAK TJM
 CHECKED BY: PRR
 DRAWN BY: TAK
 CITY OF ELK RIVER
 SCHOOL ST. N.W. IMPROVEMENT PROJECT
 STREET CONSTRUCTION
 37+50 TO 43+00
 DATE: JULY 1981 SHEET 10 OF 27 SHEETS FILE NO. ER3.02-5

DRAWING NUMBER
 DRAWING NUMBER
