


NOTE:
SEE NOTES ON SHEET 12.

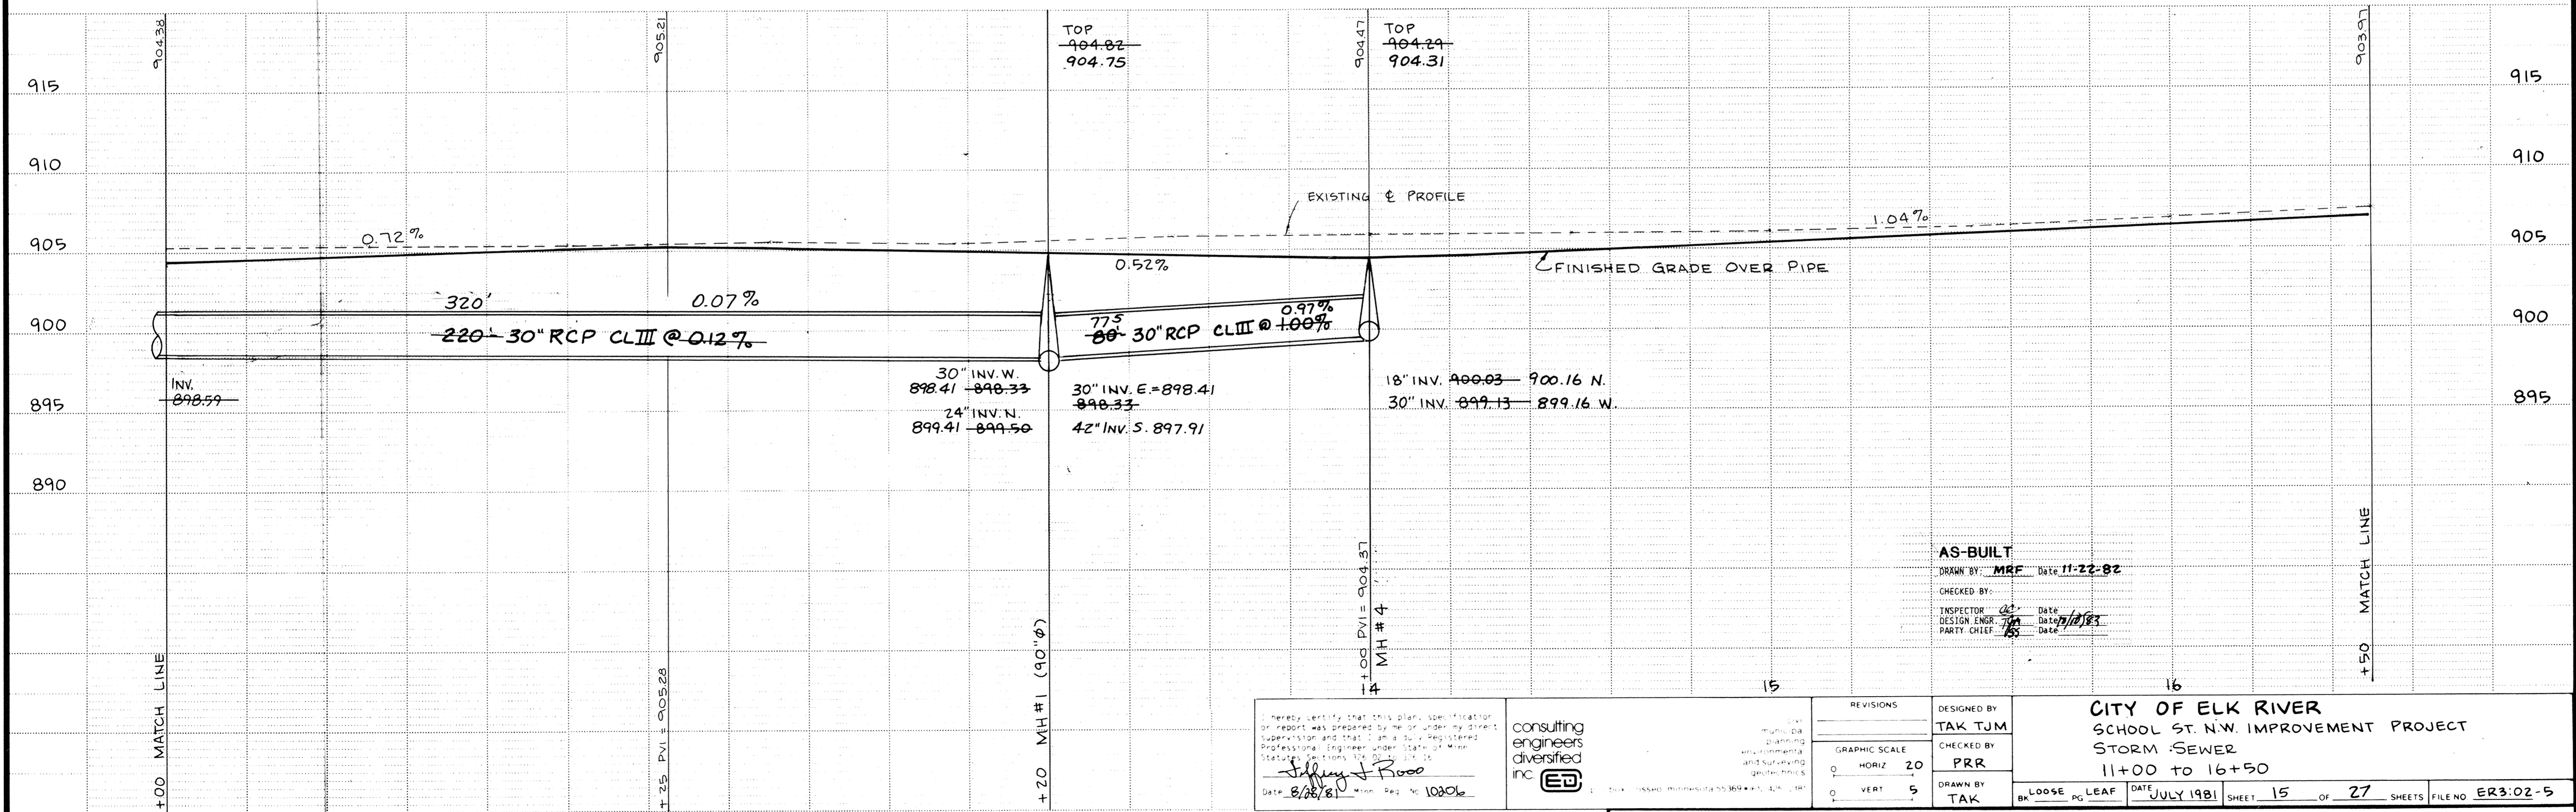

AS-BUILT
 DRAWN BY: MRF Date 11-22-82
 CHECKED BY:
 INSPECTOR: [Signature] Date 7/1/83
 DESIGN ENGR: [Signature] Date 7/1/83
 PARTY CHIEF: [Signature] Date

I hereby certify that this plan, specification or report was prepared by me or under my direct supervision and that I am a duly Registered Professional Engineer under State of Minnesota Statutes, Sections 319.01 to 319.35.
 Jeffrey J. Boos
 Date 8/28/81 Minn. Reg. No. 10206

consulting engineers diversified inc.

REVISIONS	

DESIGNED BY: TAK TJM
 CHECKED BY: PRR
 DRAWN BY: TAK

CITY OF ELK RIVER
 SCHOOL ST. N.W. IMPROVEMENT PROJECT
 STORM SEWER
 11+00 TO 16+50

DATE: JULY 1981 SHEET 15 OF 27 SHEETS FILE NO. ER3-02-5