

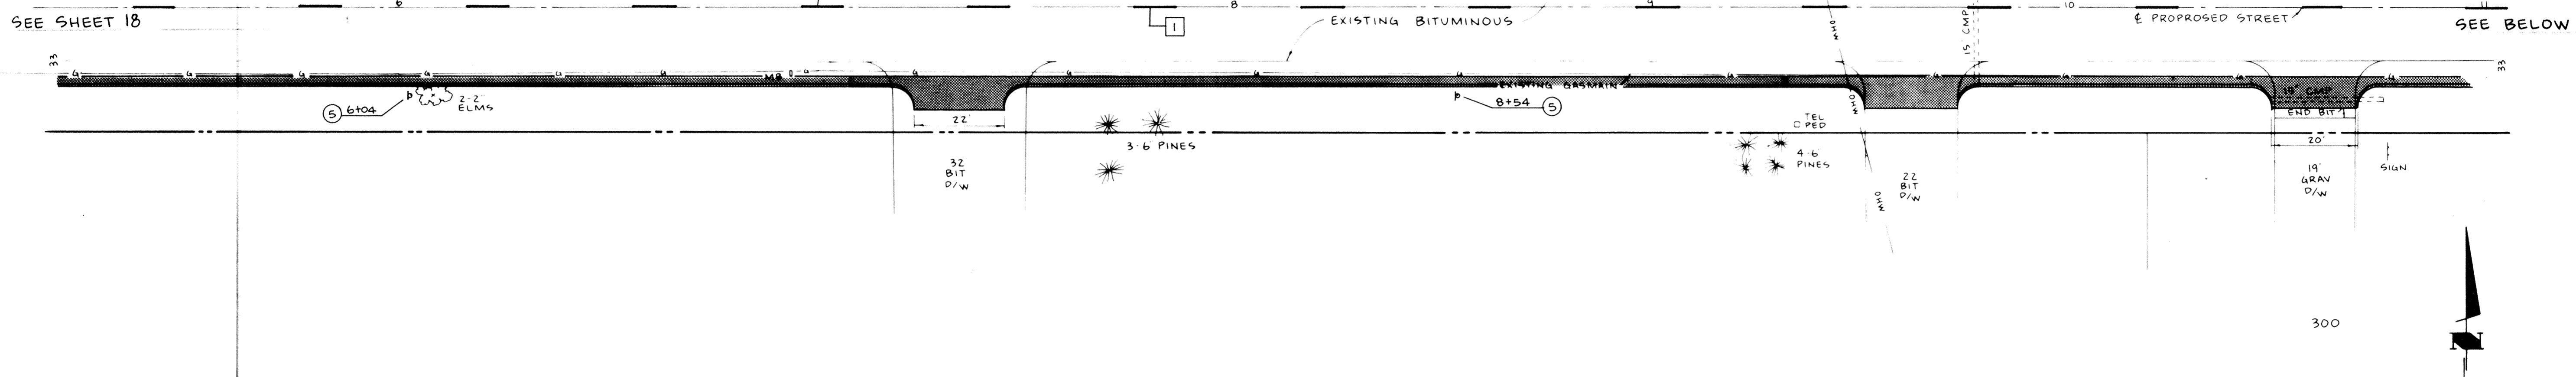


INDEPENDENT SCHOOL DISTRICT NO 278

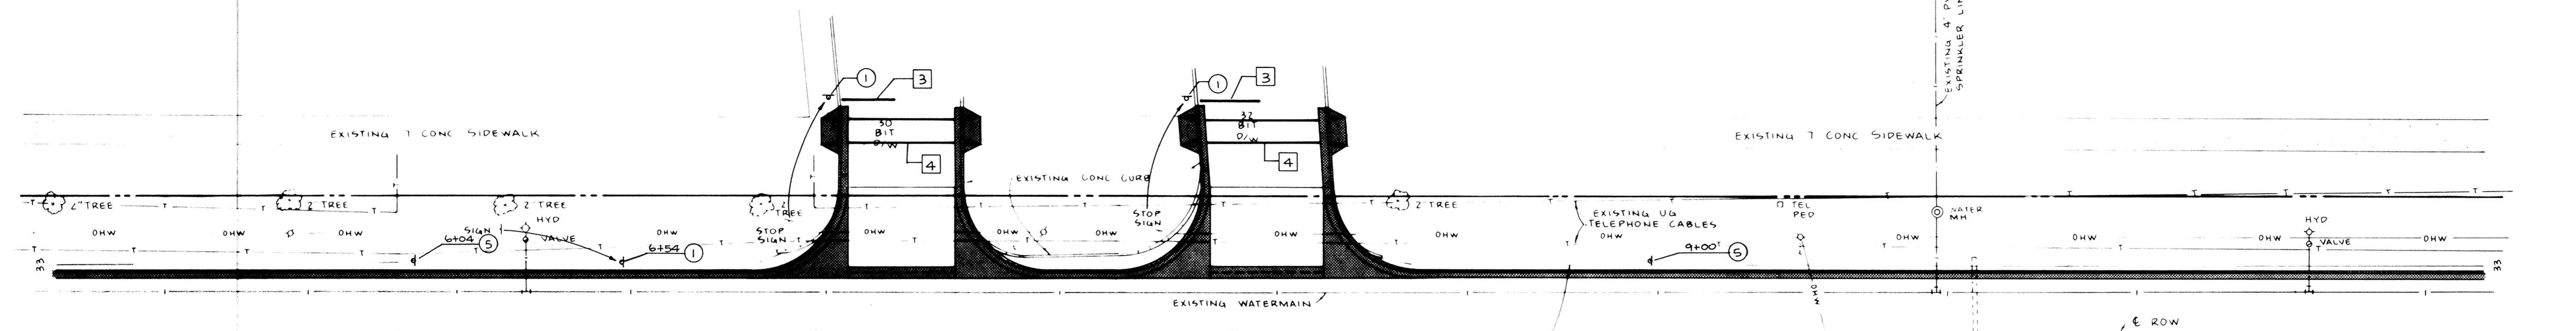

INDEPENDENT SCHOOL DISTRICT NO 278

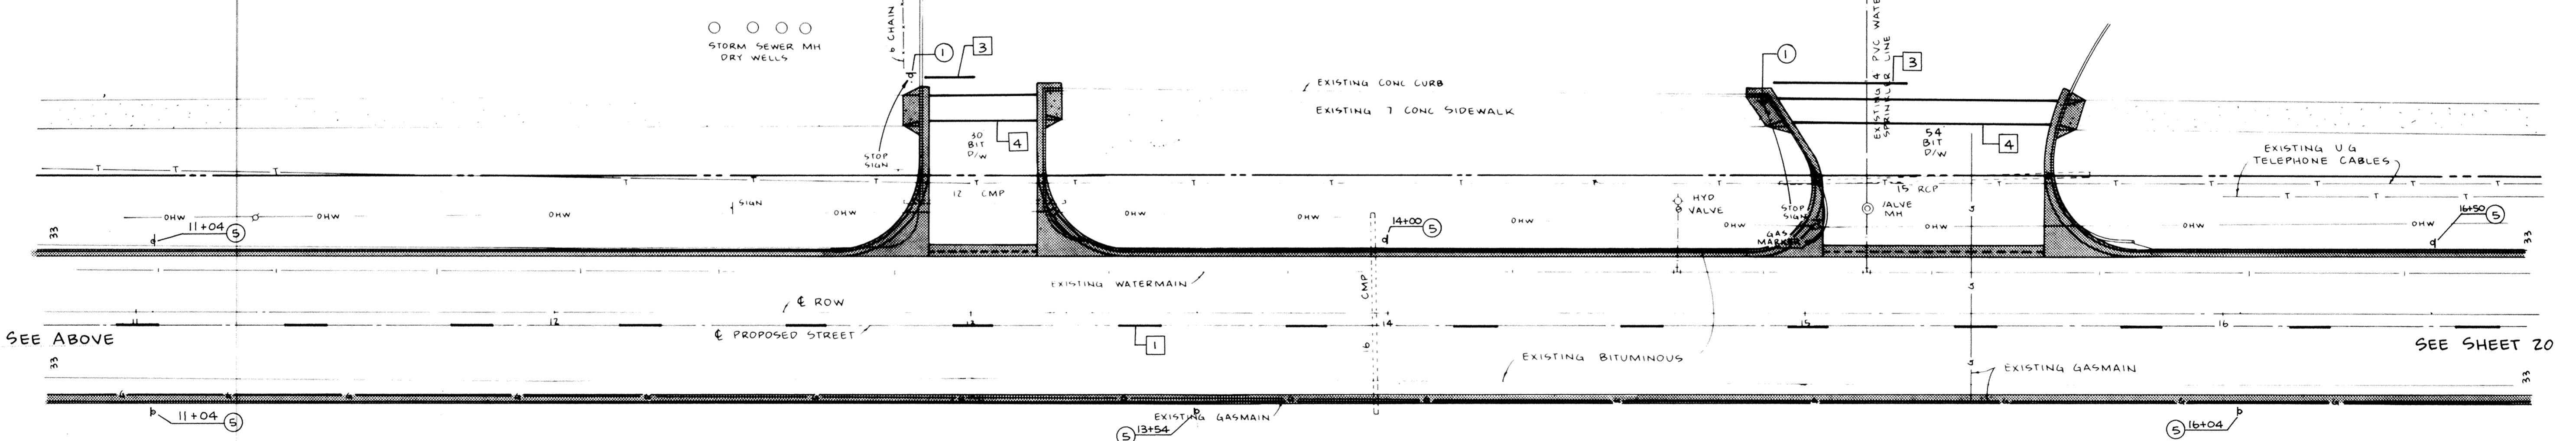

AS-BUILT
 DRAWN BY: MRF Date 11-22-82
 CHECKED BY:
 INSPECTOR: CC Date 11/24/82
 DESIGN ENG: JRM Date 11/24/82
 PARTY CHIEF: JRM Date 11/24/82

S.A.P.# 204-107-01

I hereby certify that this plan, specification or report was prepared by me or under my direct supervision and that I am a duly Registered Professional Engineer under State of Minn. Statutes Sections 326.02 to 326.10.
 Date 8/26/81 Minn. Reg. No. 10206

consulting engineers diversified inc. ED
 p.o. box 10800, osseo, minnesota 55369 • F1214, 4-1-1981

DESIGNED BY TJM	REVISIONS
CHECKED BY PRR	
DRAWN BY MRF	
GRAPHIC SCALE HORIZ 0 20 VERT 0 20	

CITY OF ELK RIVER SCHOOL ST. NW IMPROVEMENT PROJECT SIGNING & PAVEMENT MARKING 5+50 TO 16+50	
DATE Aug 1981	SHEET 20 OF 27 SHEETS
BK _____ PG _____	FILE NO ER3-02-5