


DATE: PROJECTS - NEW WORK - MANAGERIAL
REVISIONS BY PART NUMBER (R/S)

DATE: PROJECTS - NEW WORK - MANAGERIAL
REVISIONS BY PART NUMBER (R/S)

DATE: PROJECTS - NEW WORK - MANAGERIAL
REVISIONS BY PART NUMBER (R/S)

DATE: PROJECTS - NEW WORK - MANAGERIAL
REVISIONS BY PART NUMBER (R/S)

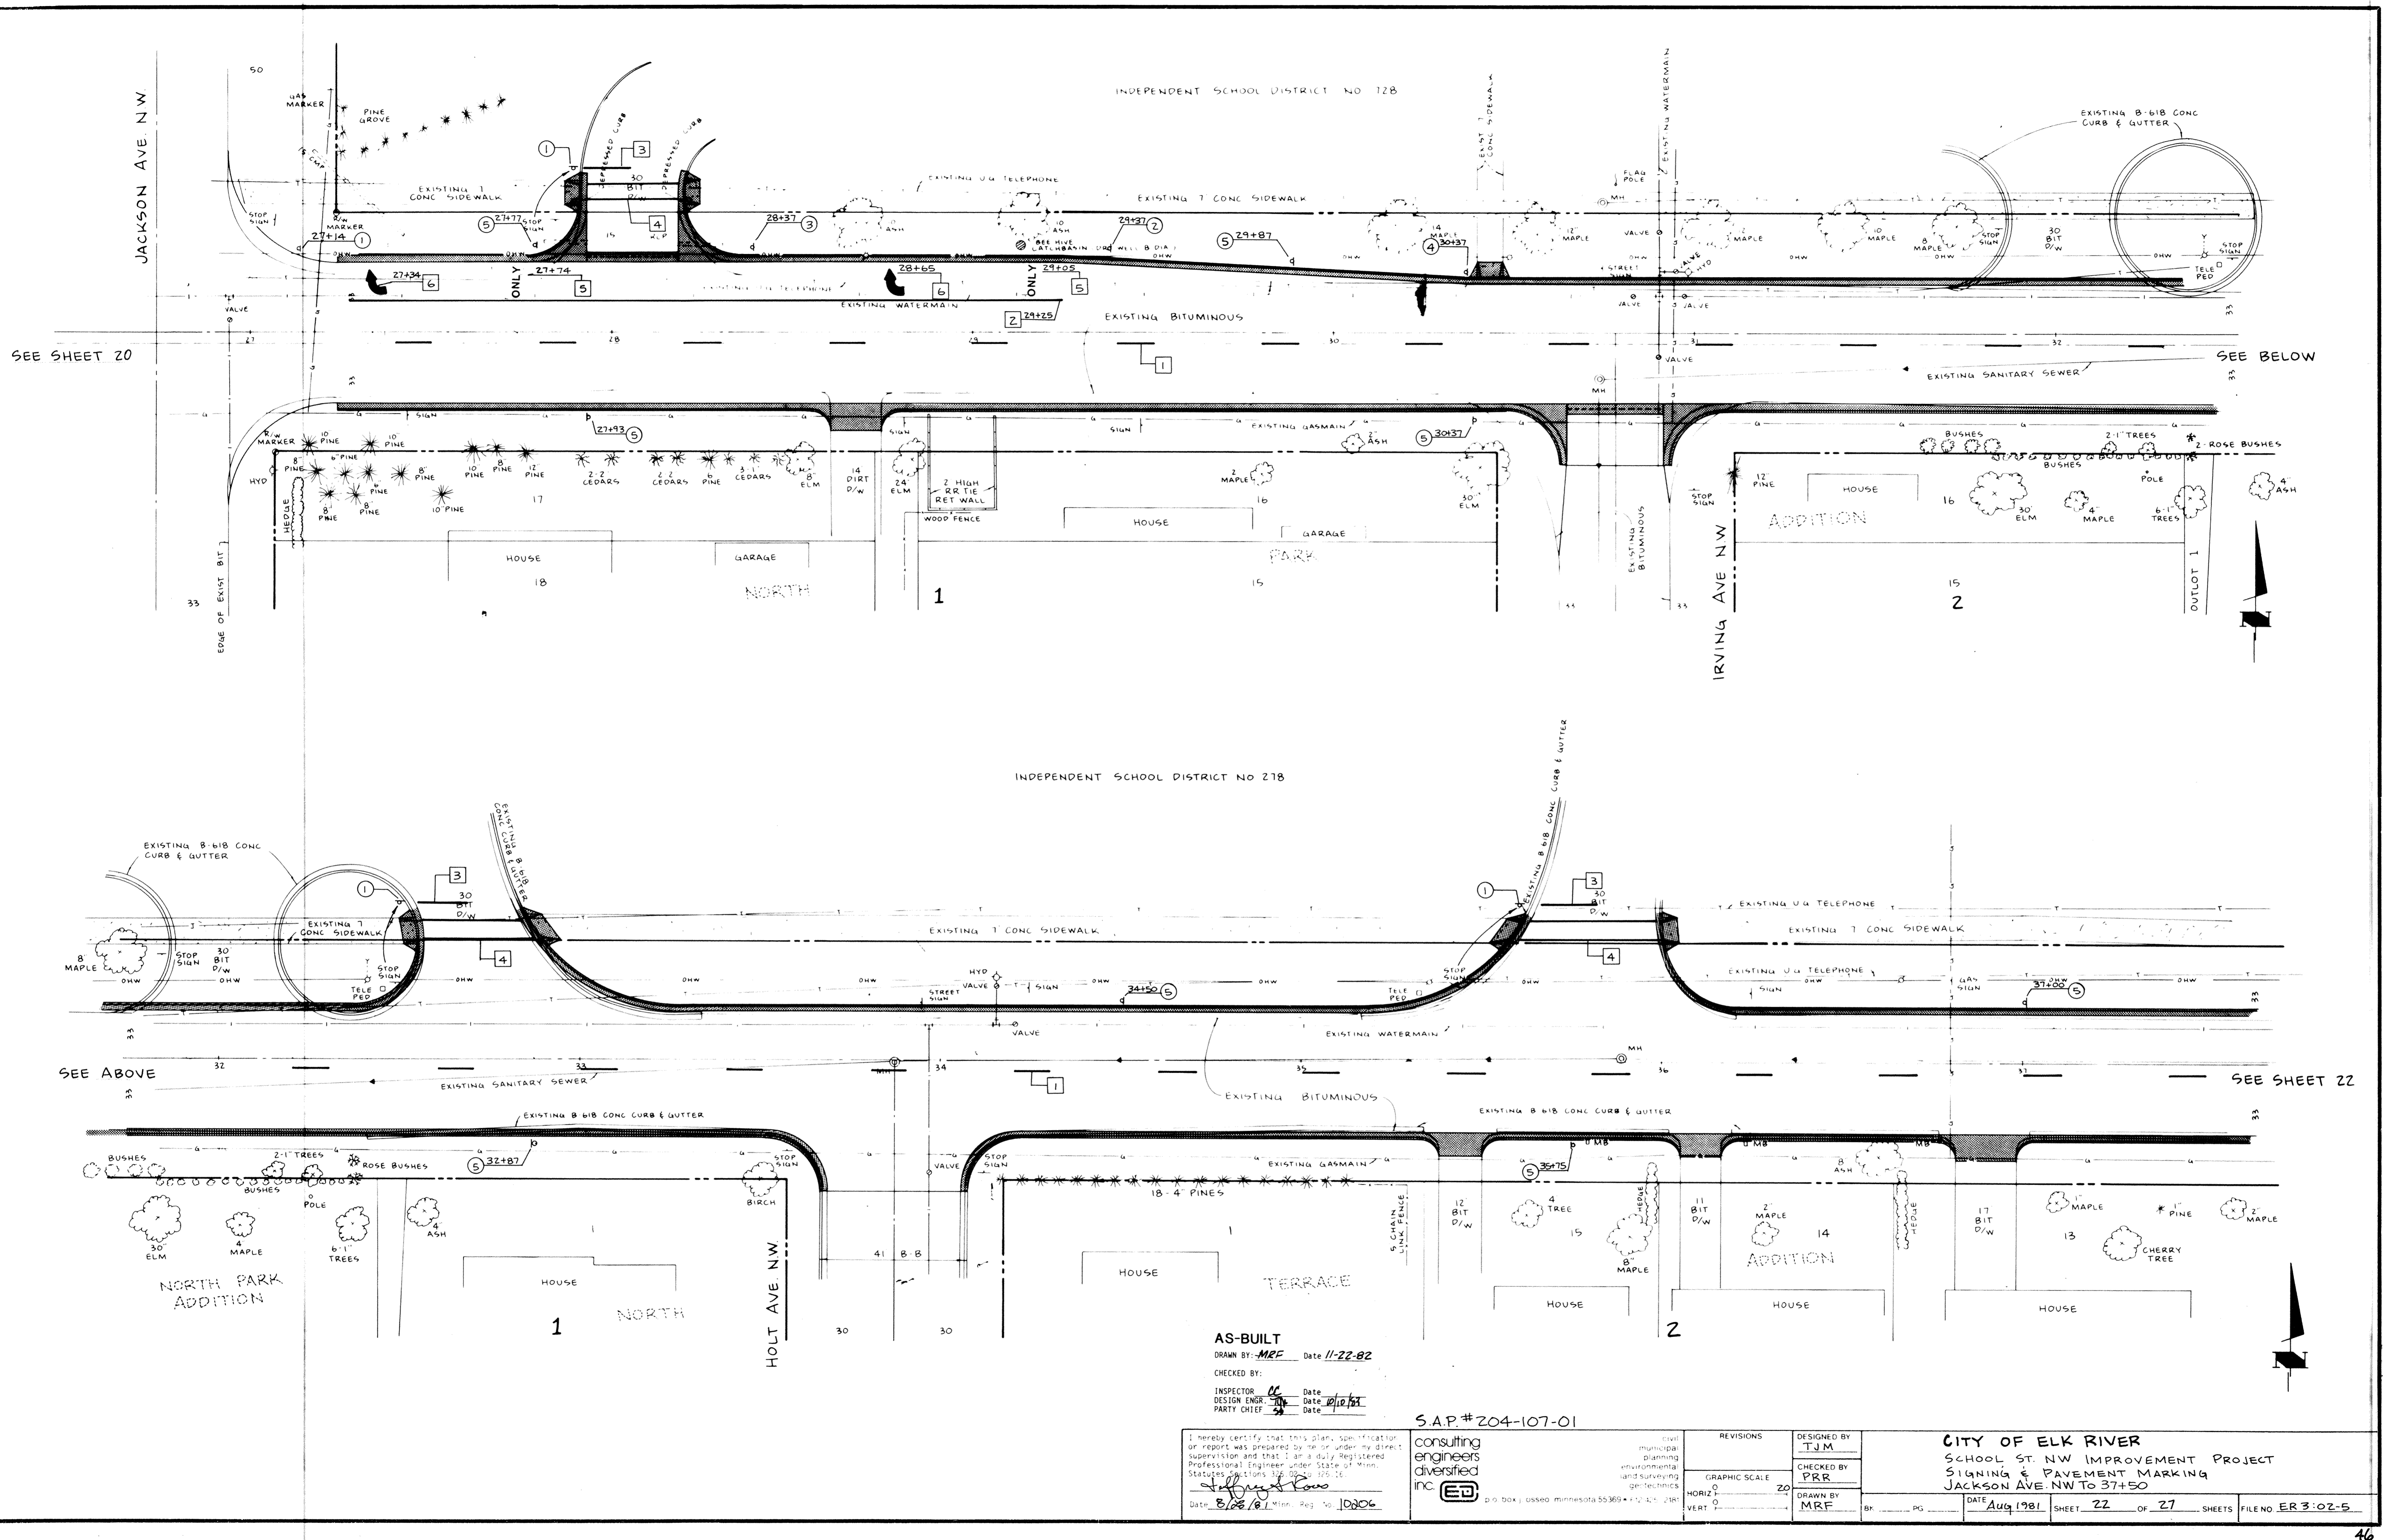

SEE SHEET 20

SEE BELOW


SEE ABOVE

SEE SHEET 22

AS-BUILT
 DRAWN BY: MRF Date 11-22-82
 CHECKED BY:
 INSPECTOR: CC Date 11/22/82
 DESIGN ENGR: JH Date 11/22/82
 PARTY CHIEF: SJ Date 11/22/82

S.A.P. # 204-107-01

I hereby certify that this plan, specification or report was prepared by me or under my direct supervision and that I am a duly Registered Professional Engineer under State of Minnesota Statutes Sections 129.00 to 129.16.
 Date 8/22/81 Minn. Reg. No. 10806

consulting engineers diversified inc. 
 civil municipal planning environmental and surveying geotechnical
 P.O. Box 1, Cassa Minnesota 55369 • (612) 421-2181

DESIGNED BY	TJM
CHECKED BY	PRR
DRAWN BY	MRF

REVISIONS	
GRAPHIC SCALE	20'
HORIZ	0
VERT	0

CITY OF ELK RIVER
 SCHOOL ST. NW IMPROVEMENT PROJECT
 SIGNING & PAVEMENT MARKING
 JACKSON AVE. NW TO 37+50
 DATE Aug 1981 SHEET 22 OF 27 SHEETS FILE NO. ER 3-02-5