



DRAWING NUMBER

DRAWING NUMBER

DRAWING NUMBER

DRAWING NUMBER
SCHOO 81
26

Fed. Proj. No.

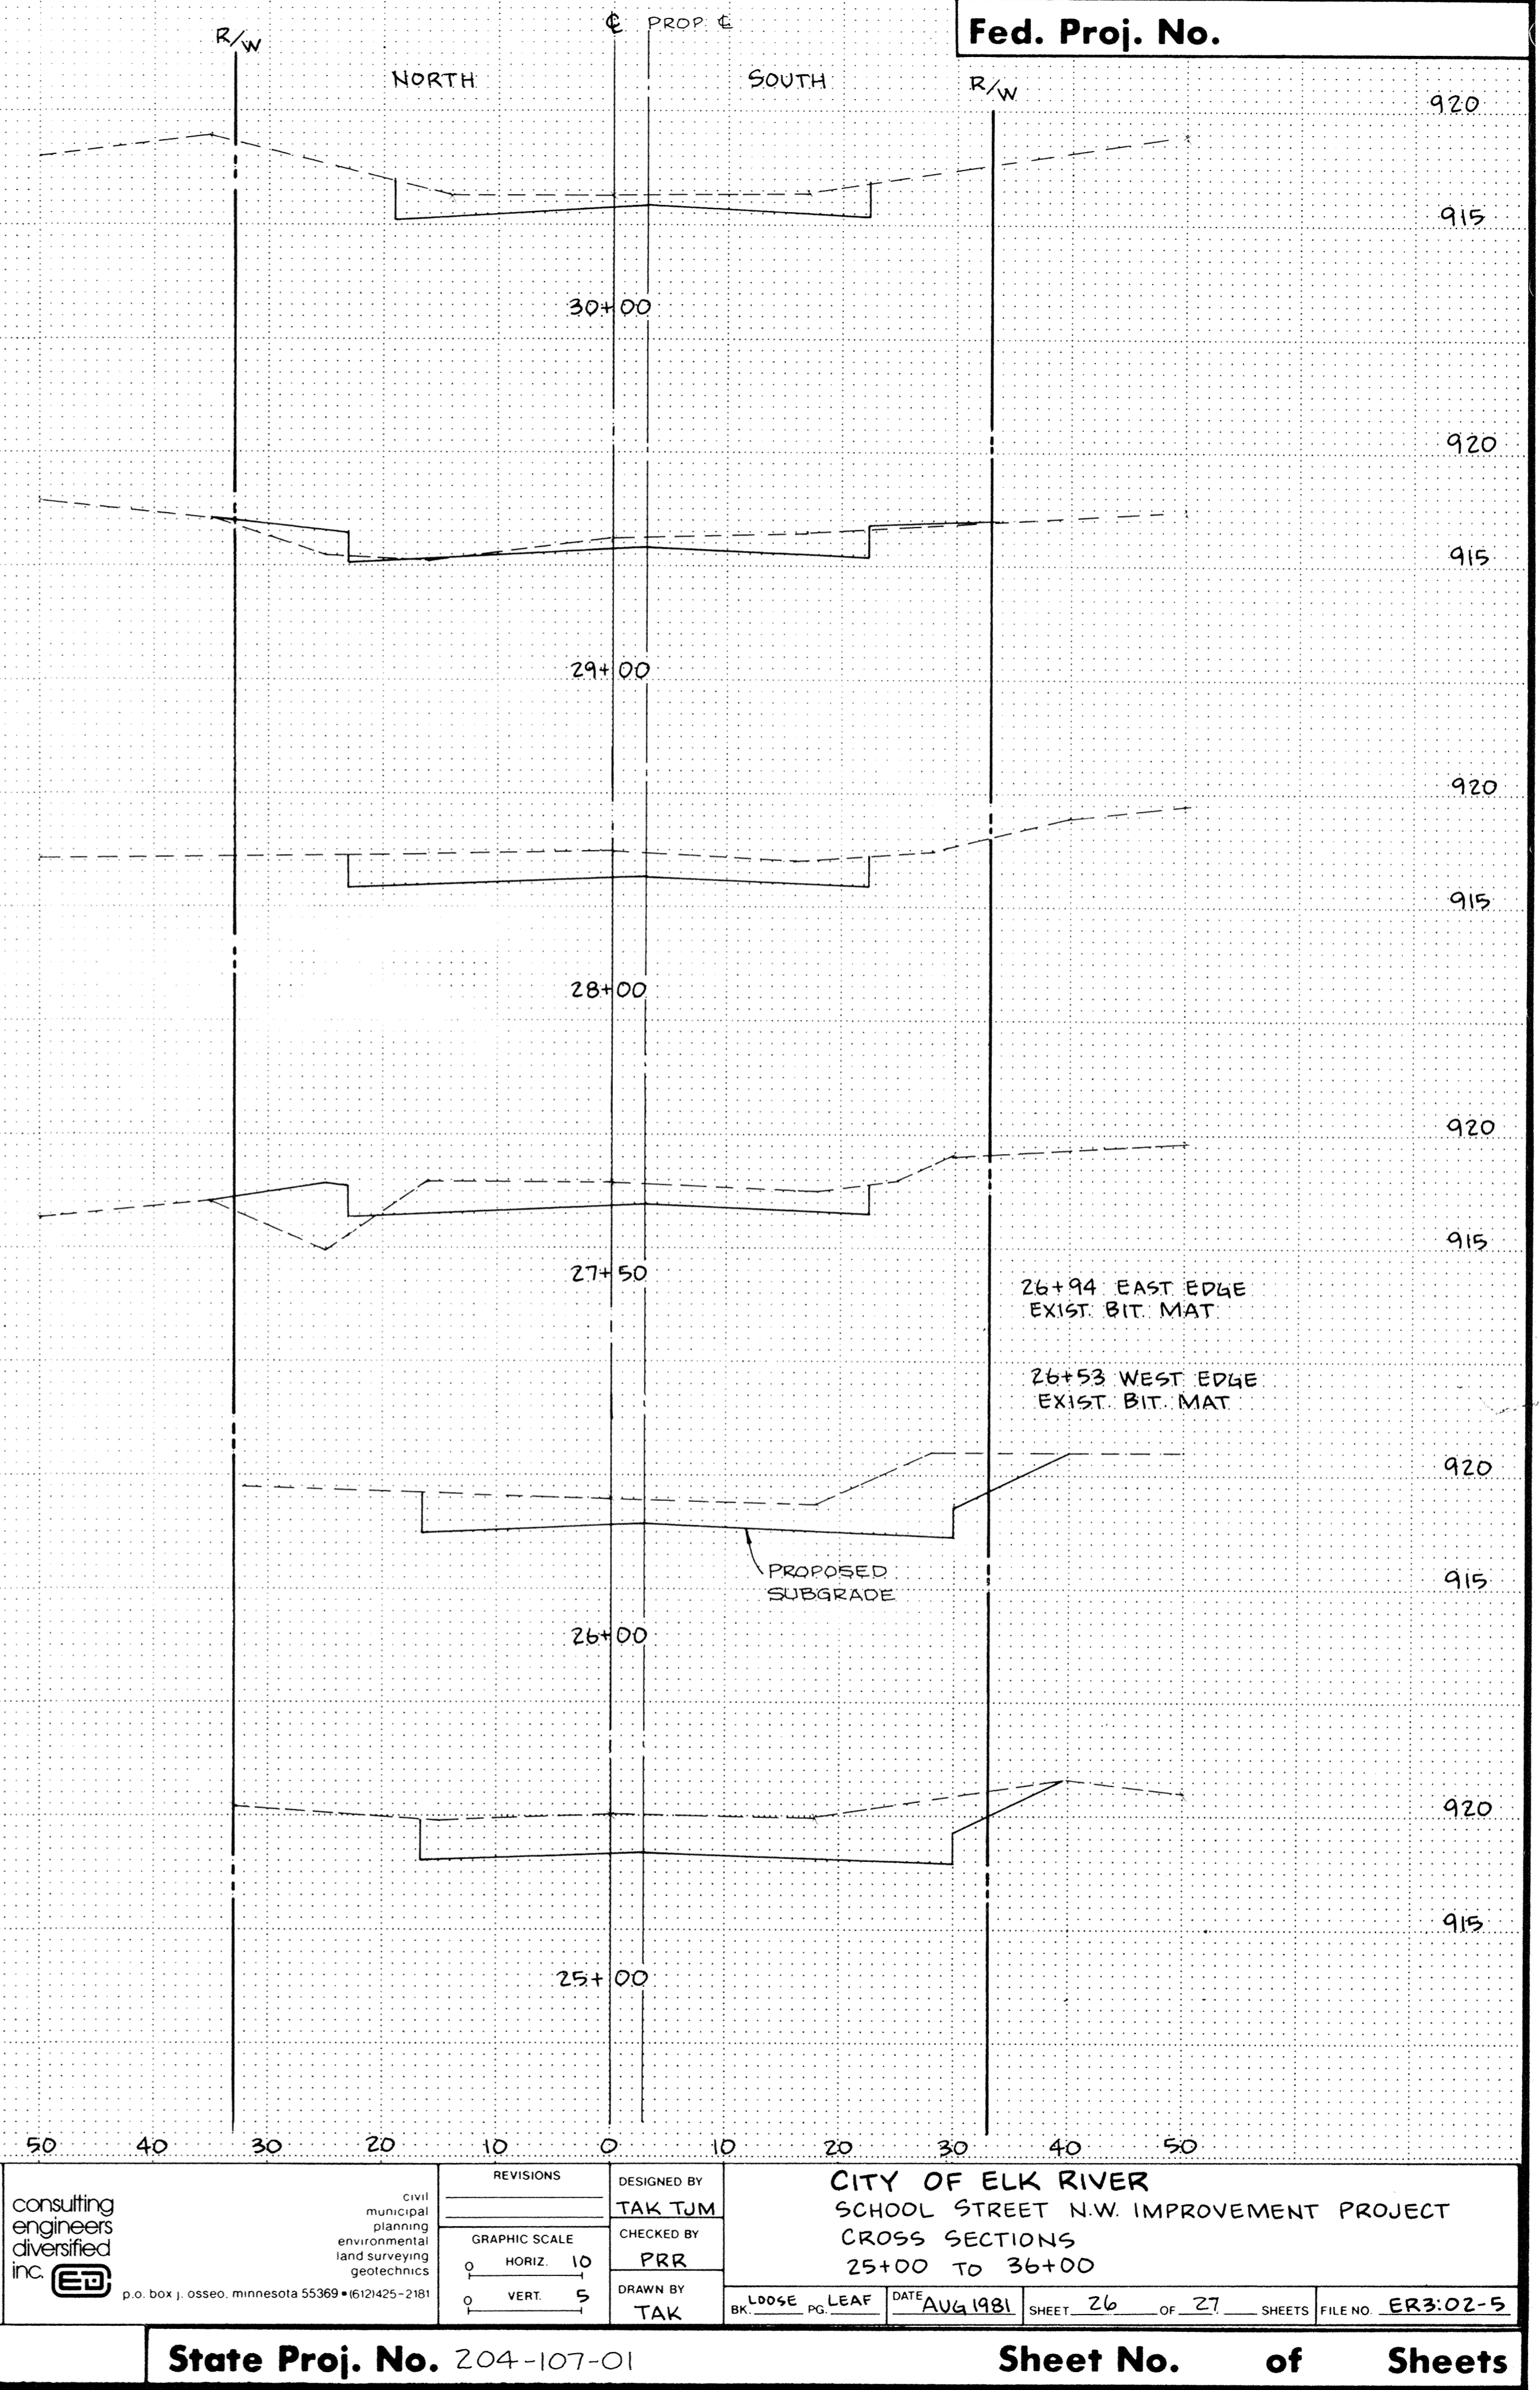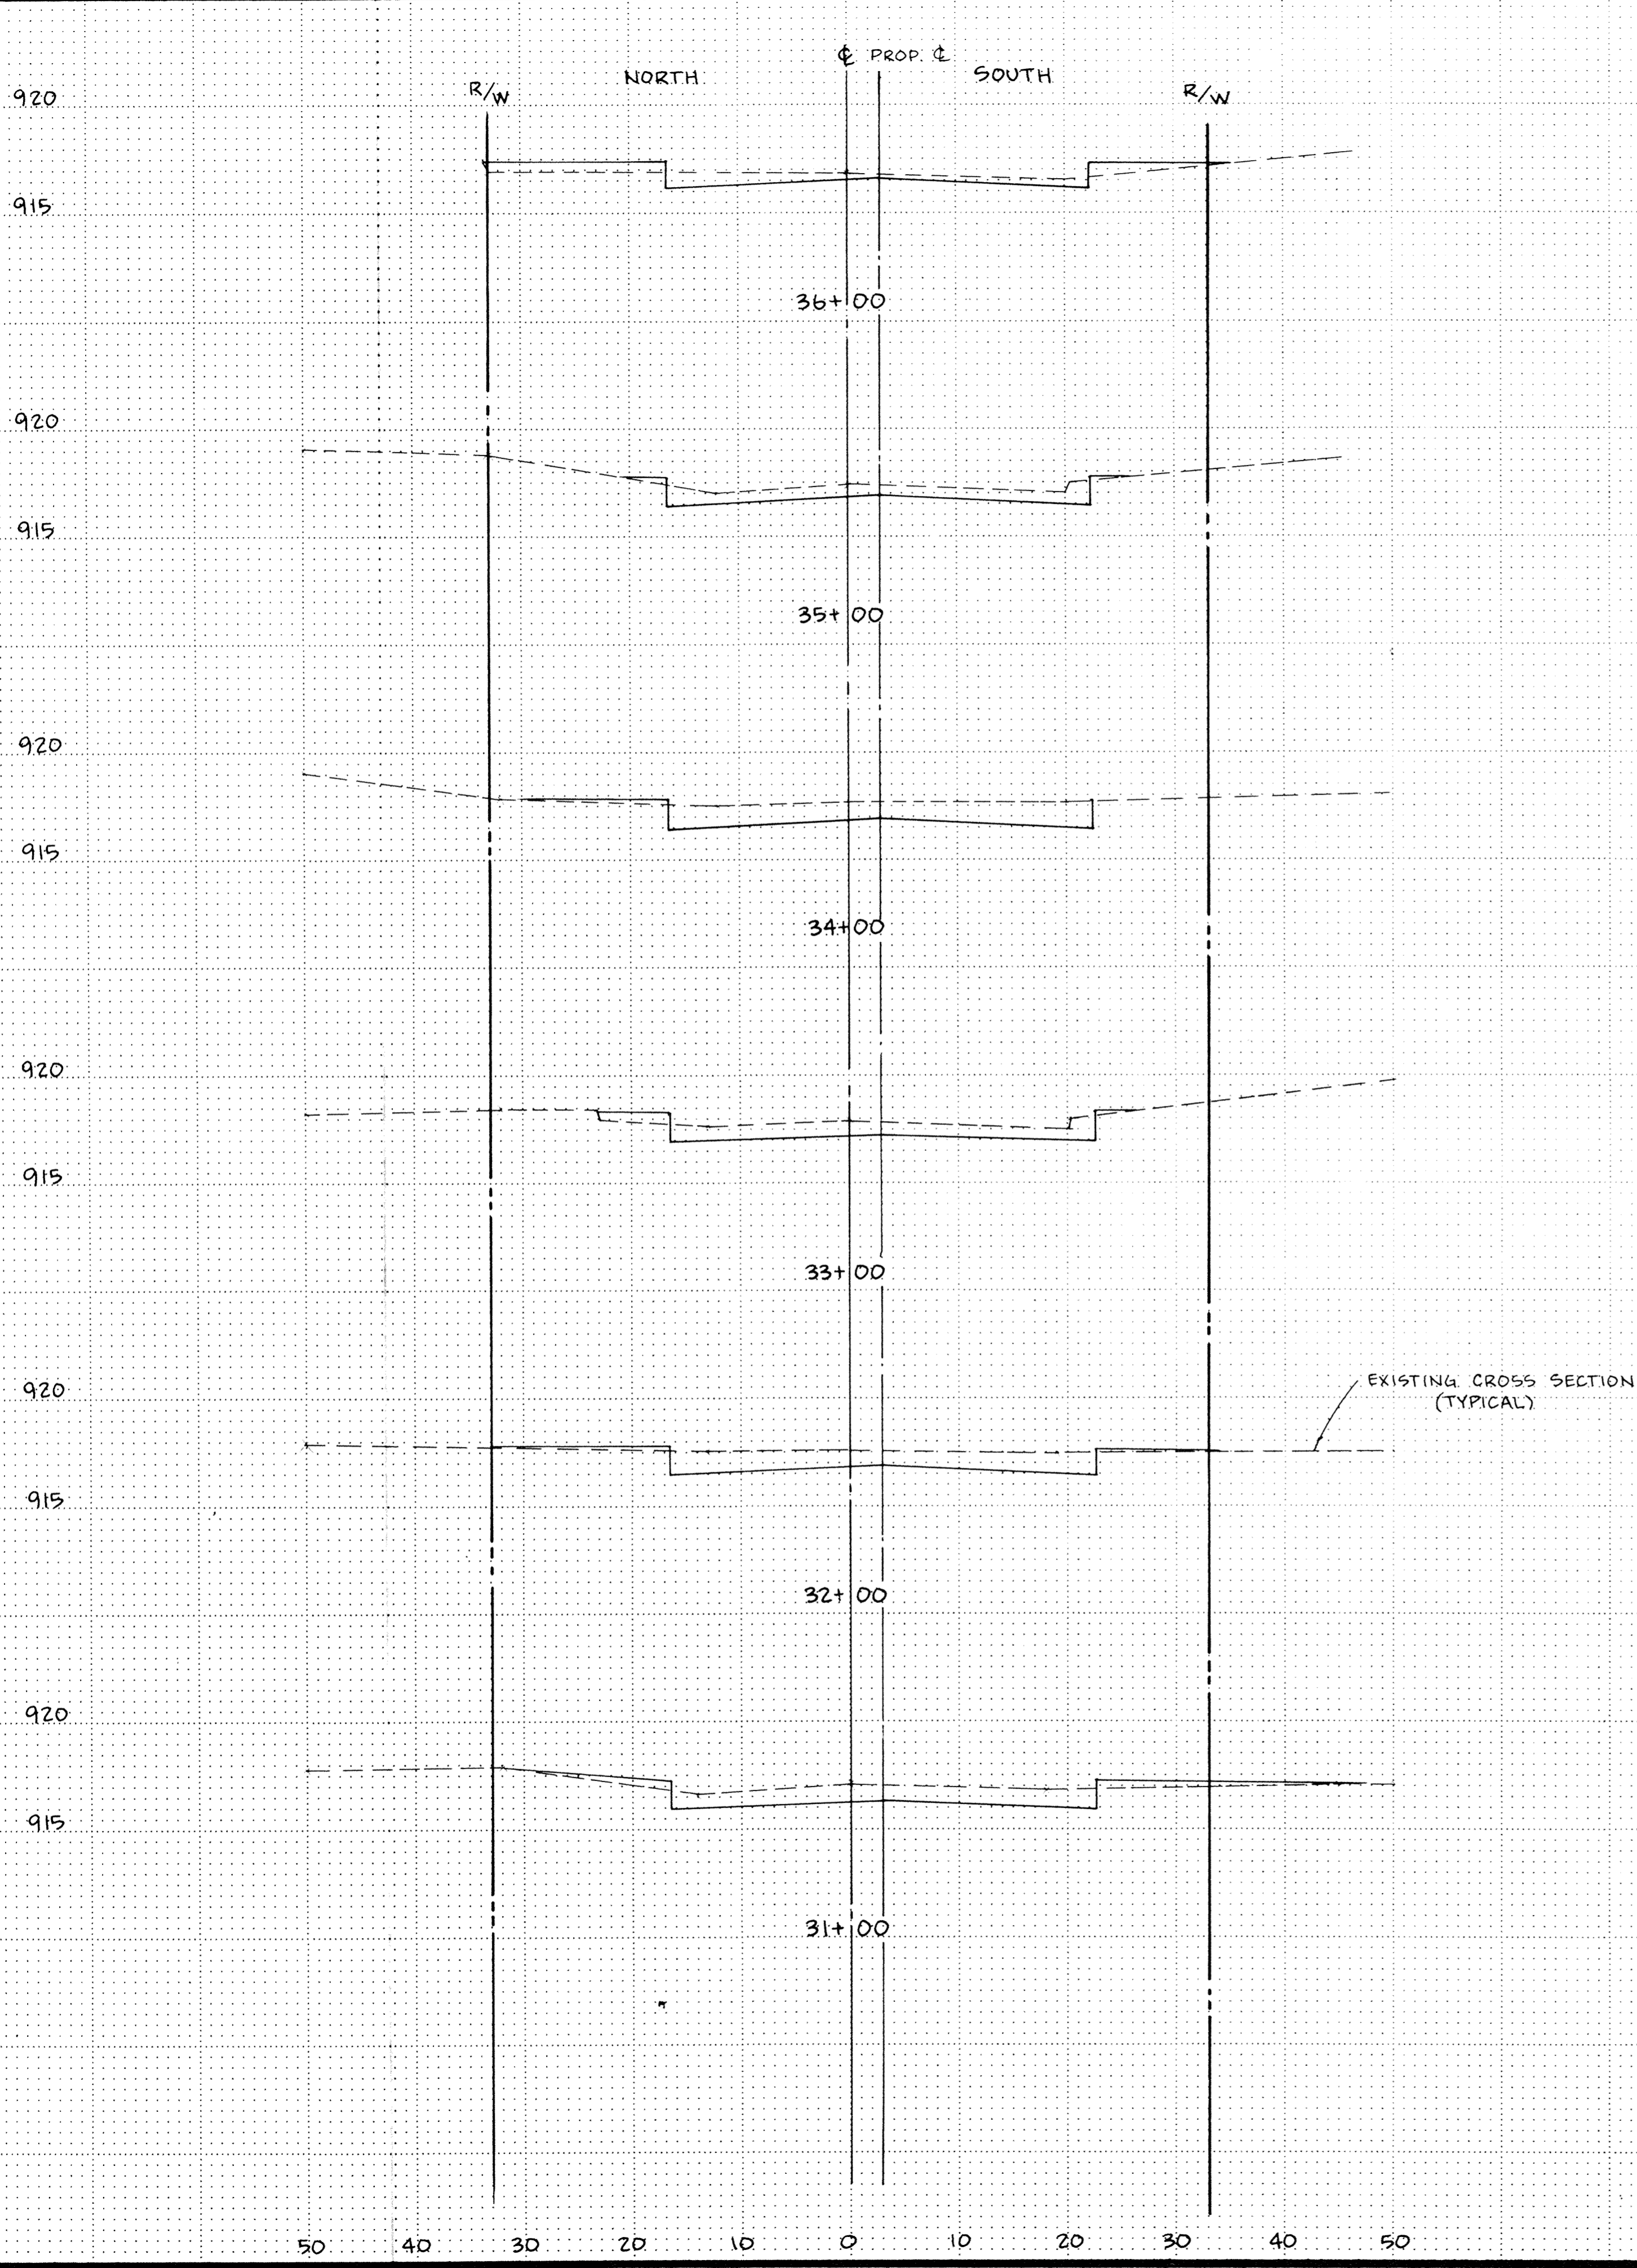

AS-BUILT
 DRAWN BY: MRF Date: 11-22-82
 CHECKED BY:
 INSPECTOR: OC Date: 10/1/83
 DESIGN ENGR: PRR Date:
 PARTY CHIEF: TAK Date:

I hereby certify that this plan, specification or report was prepared by me or under my direct supervision and that I am a duly Registered Professional Engineer under State of Minn. Statutes Sections 326.02 to 326.16.
[Signature]
 Date: 8/24/81 Minn. Reg. No. 10206

consulting engineers diversified inc.
 p.o. box j, osseo, minnesota 55369 • 612/425-2181

REVISIONS
 DESIGNED BY: TAK TJM
 CHECKED BY: PRR
 DRAWN BY: TAK

CITY OF ELK RIVER
 SCHOOL STREET N.W. IMPROVEMENT PROJECT
 CROSS SECTIONS
 25+00 TO 36+00
 DATE: AUG 1981 SHEET 26 OF 27 SHEETS
 FILE NO. ER3.02-5

State Proj. No. 204-107-01

Sheet No. of Sheets