



S&C&D PROJECTS • NEW UPRR, MINNESOTA  
PROPOSED BY PART NUMBER 6582  
S&C&D PROJECTS • NEW UPRR, MINNESOTA  
PROPOSED BY PART NUMBER 6582  
S&C&D PROJECTS • NEW UPRR, MINNESOTA  
PROPOSED BY PART NUMBER 6582

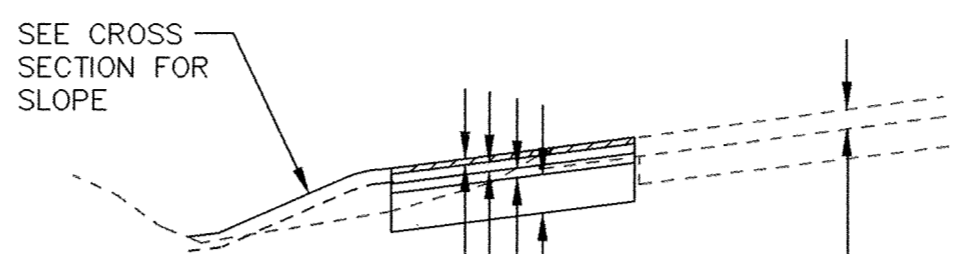

1" BITUMINOUS WEAR COURSE(2361)  
2" BITUMINOUS BINDER COURSE(2331)  
2" BITUMINOUS BASE COURSE(2331)  
10" CLASS 5 AGGREGATE BASE


EXISTING BITUMINOUS WEAR COURSE

TYPICAL STREET SECTION  
T.H. 169 LEFT TURN LANE  
T.H. 169 RIGHT TURN AND ACCELERATION LANE

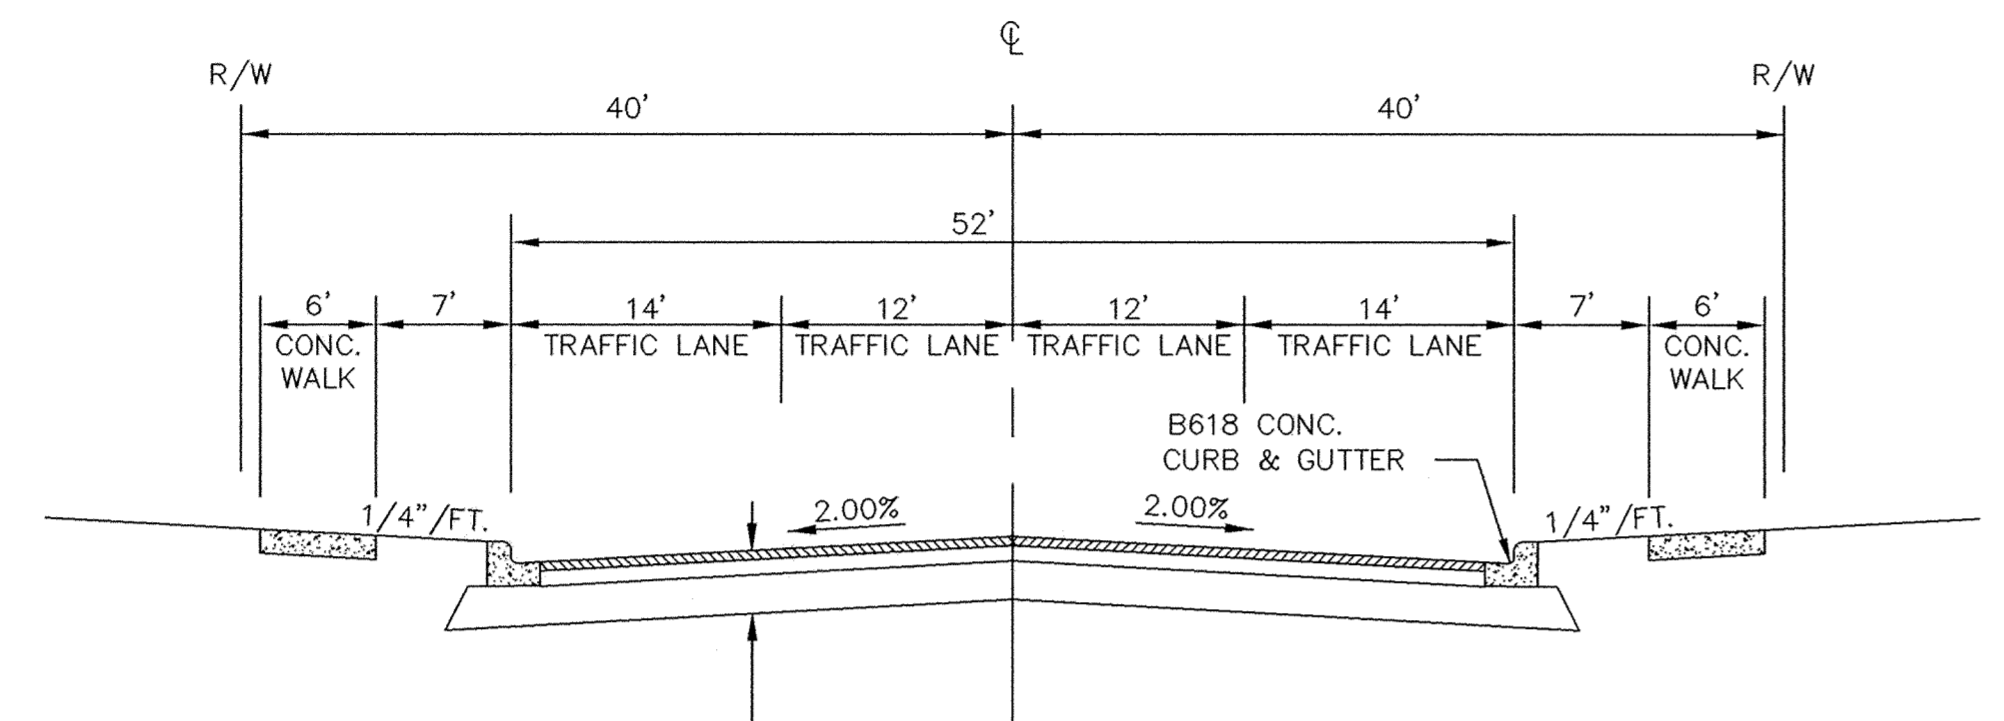

1 1/2" 2331 TYPE 41A BIT. WEAR COURSE  
2" 2331 TYPE 31B BIT. BASE COURSE  
9" CLASS 5 AGGREGATE BASE


TYPICAL STREET SECTION  
FREEPORT AVENUE  
191st AVENUE

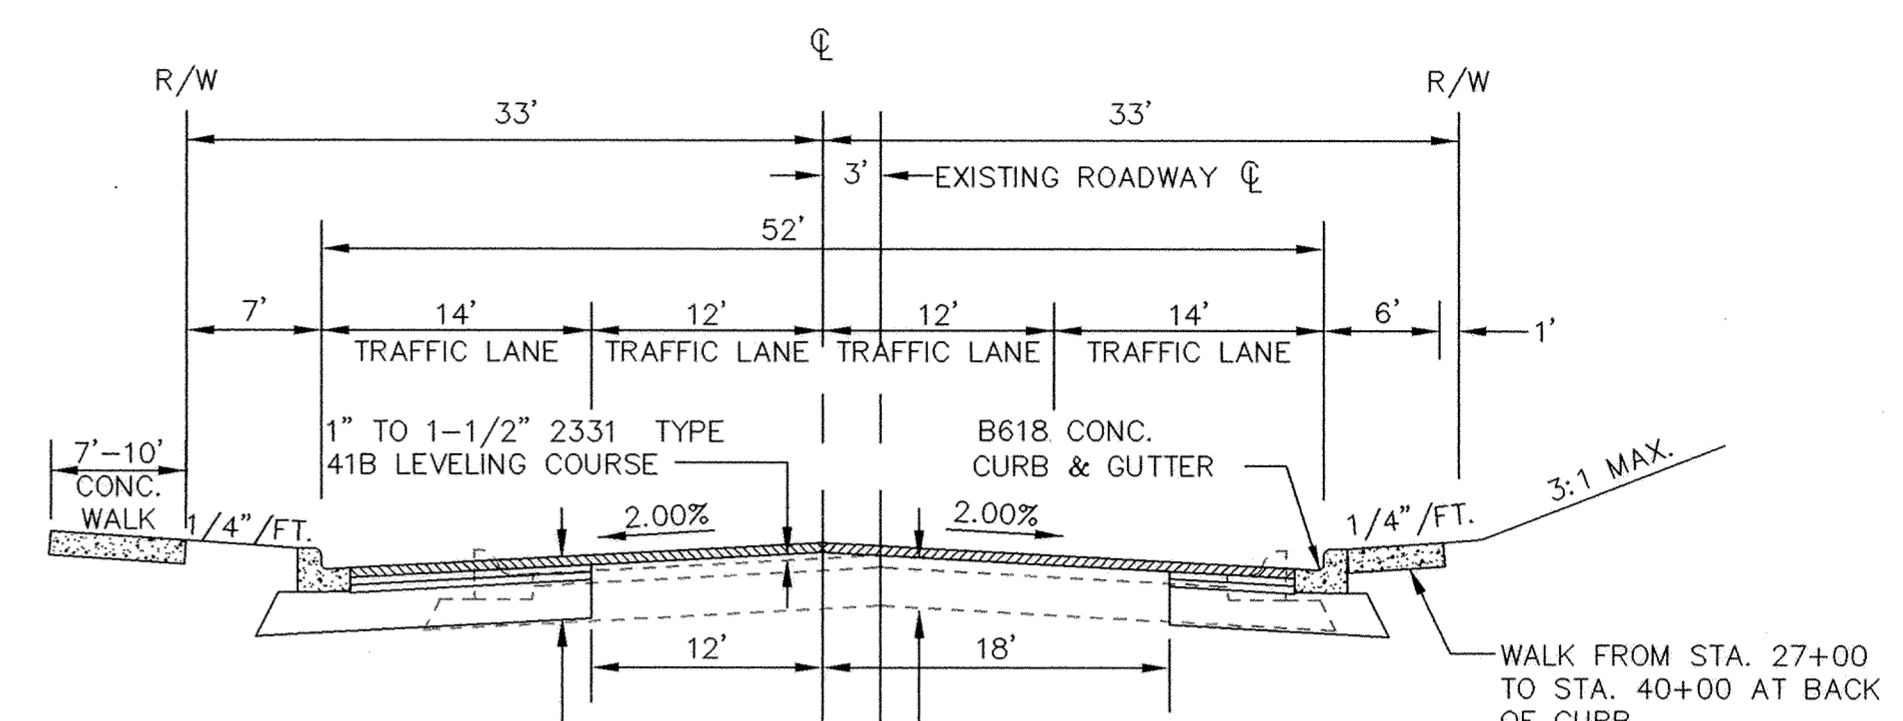

1 1/2" 2331 TYPE 61CS BIT. WEAR COURSE / OVERLAY  
1 1/2" 2331 TYPE 31B BIT. BINDER COURSE  
2" 2331 TYPE 31B BIT. BASE COURSE  
7" CLASS 5 AGGREGATE BASE

STREET SECTION TO BE SAVED  
EXISTING 2 1/4" 2361 BIT. WEAR COURSE  
EXISTING 2" 2331 BIT. BASE COURSE  
EXISTING 7" CLASS 5 AGGREGATE BASE


TYPICAL STREET SECTION  
SCHOOL STREET (STA. 17+00 TO STA. 38+00)  
GATES AVENUE

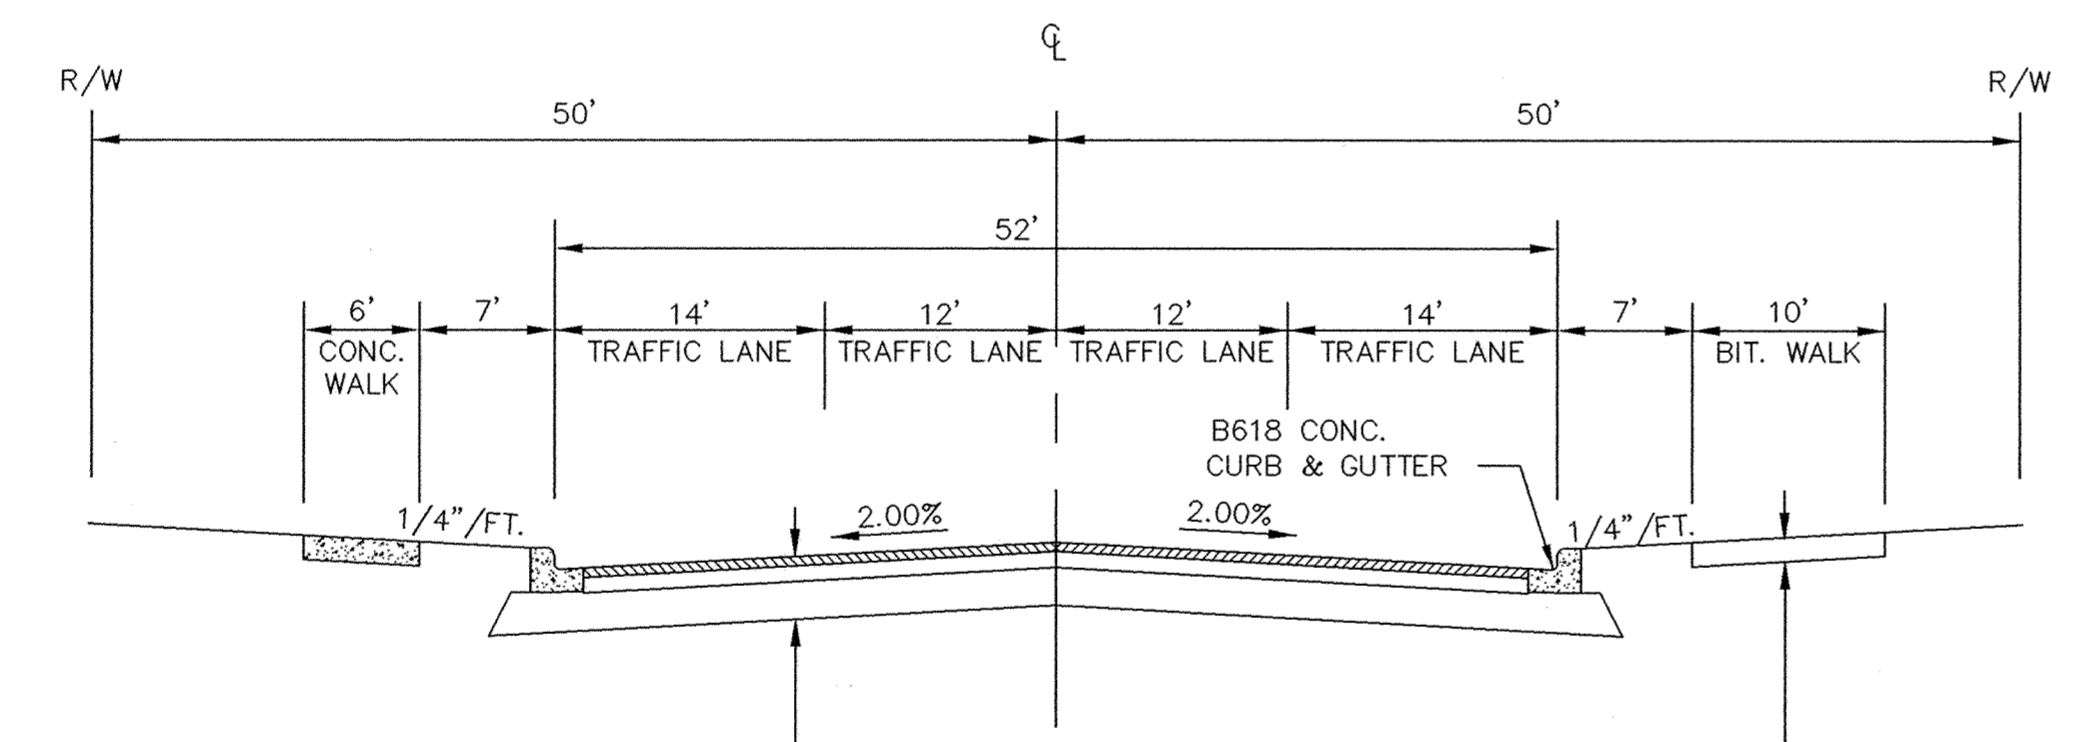

1 1/2" 2331 TYPE 41A BIT. WEAR COURSE  
2" 2331 TYPE 31B BIT. BASE COURSE  
9" CLASS 5 AGGREGATE BASE

2" 2331 TYPE 41A WEAR COURSE  
4" CLASS 5 AGGREGATE BASE

TYPICAL STREET SECTION  
JACKSON AVENUE

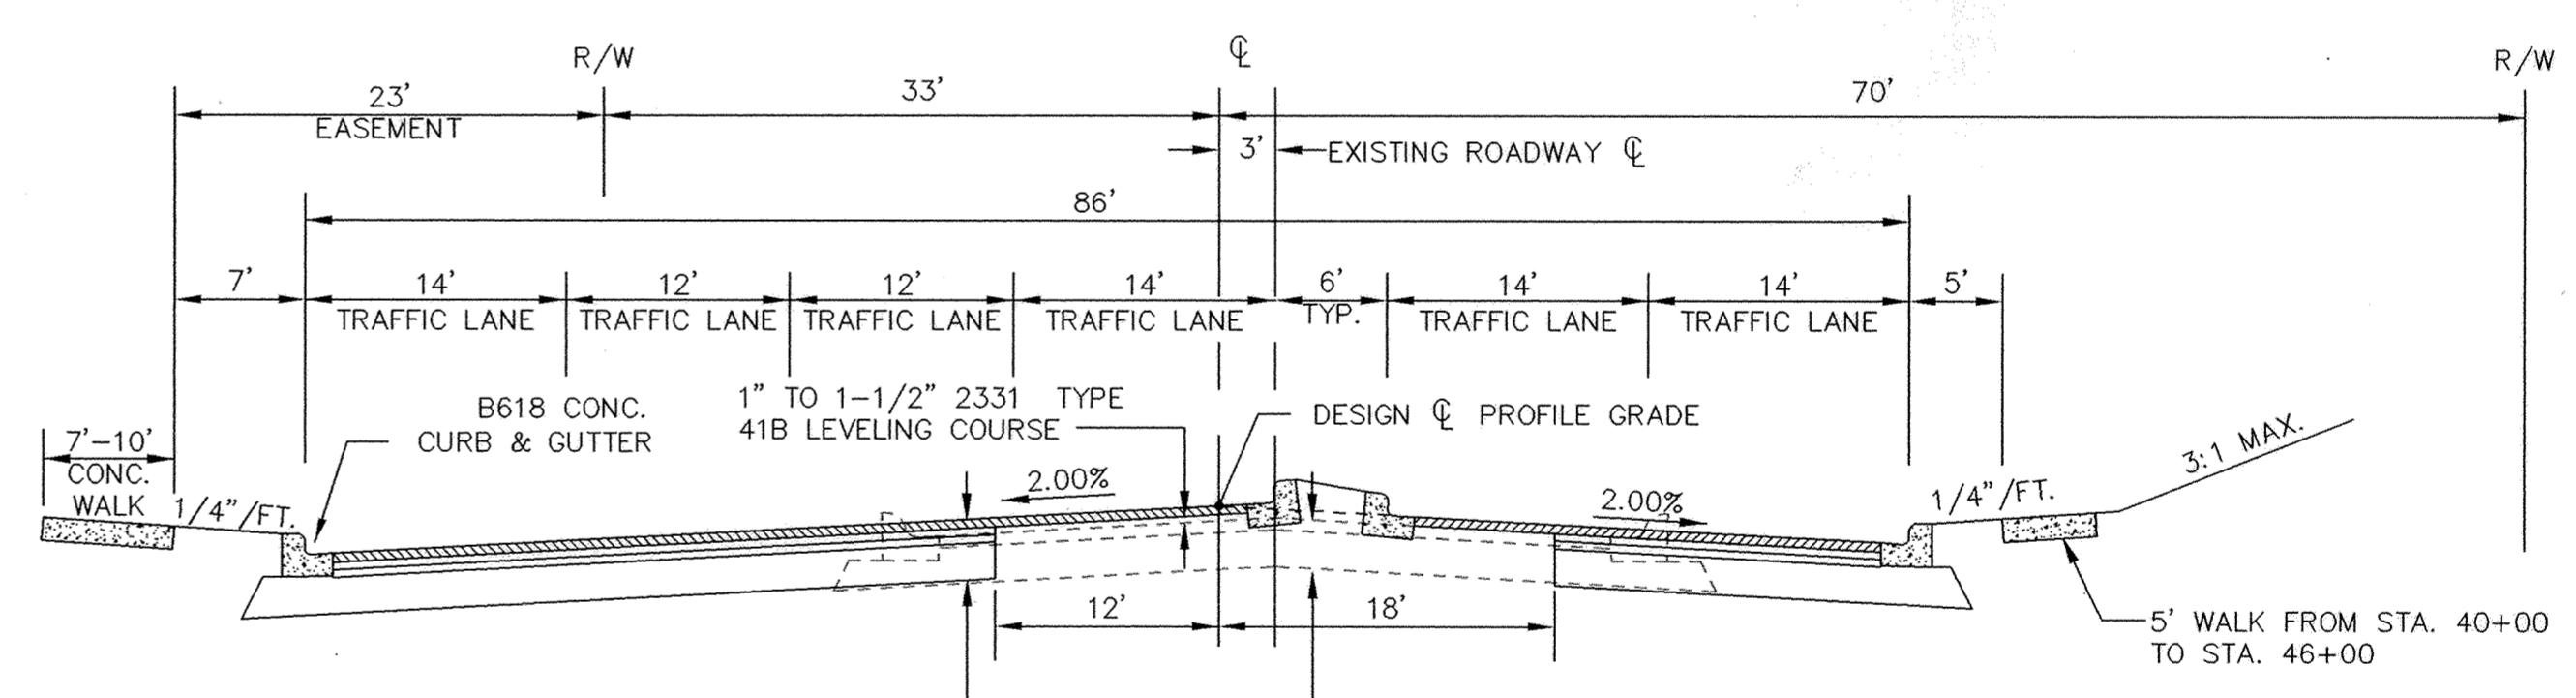

1 1/2" 2331 TYPE 61CS BIT. WEAR COURSE / OVERLAY  
1 1/2" 2331 TYPE 31B BIT. BINDER COURSE  
1 1/2" 2331 TYPE 31B BIT. BASE COURSE  
9 1/2" CLASS 5 AGGREGATE BASE


STREET SECTION TO BE SAVED  
EXISTING 2 1/4" 2361 BIT. WEAR COURSE  
EXISTING 2" 2331 BIT. BASE COURSE  
EXISTING 7" CLASS 5 AGGREGATE BASE

TYPICAL STREET SECTION  
SCHOOL STREET (STA. 38+00 TO STA. 48+38)  
GATES AVENUE TO T.H. 169

RECORD PLAN 1995

CITY OF ELK RIVER		DATE APRIL 1994	
DETAILS- STREET RECONSTRUCTION		SHEET 4 OF 74 SHEETS	
SCHOOL STREET, JACKSON AVENUE, TH 169 TURN LANE, TH 10 TURN LANE		PROJECT NO. 230-216	
S.A.P. 204-104-04 MTB & 204-107-04			

I HEREBY CERTIFY THAT THIS PLAN, SPECIFICATION, OR REPORT WAS PREPARED BY ME OR UNDER MY DIRECT SUPERVISION AND THAT I AM A DULY REGISTERED PROFESSIONAL ENGINEER UNDER THE LAWS OF THE STATE OF MINNESOTA.  
*Paul Baettch*  
DATE 6-2-94 REG. NO. 13929

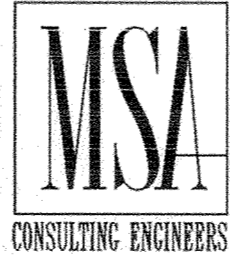

1326 ENERGY PARK DRIVE  
ST. PAUL, MINNESOTA 55108  
(612) 644-4389  
9800 SHELARD PARKWAY  
MINNEAPOLIS, MINNESOTA 55441  
(612) 546-0432

DATE	DESCRIPTION	DESIGNED	PEB
5/20/94	STATE AID COMMENTS	CHECKED	
6/1/94	PWNT SECTIONS FREEPORT AVENUE	DRAWN	JM
6/1/94	JACKSON AVENUE	GRAPHIC SCALE	
		0 HORIZ. NA	
		0 VERT. NA	