
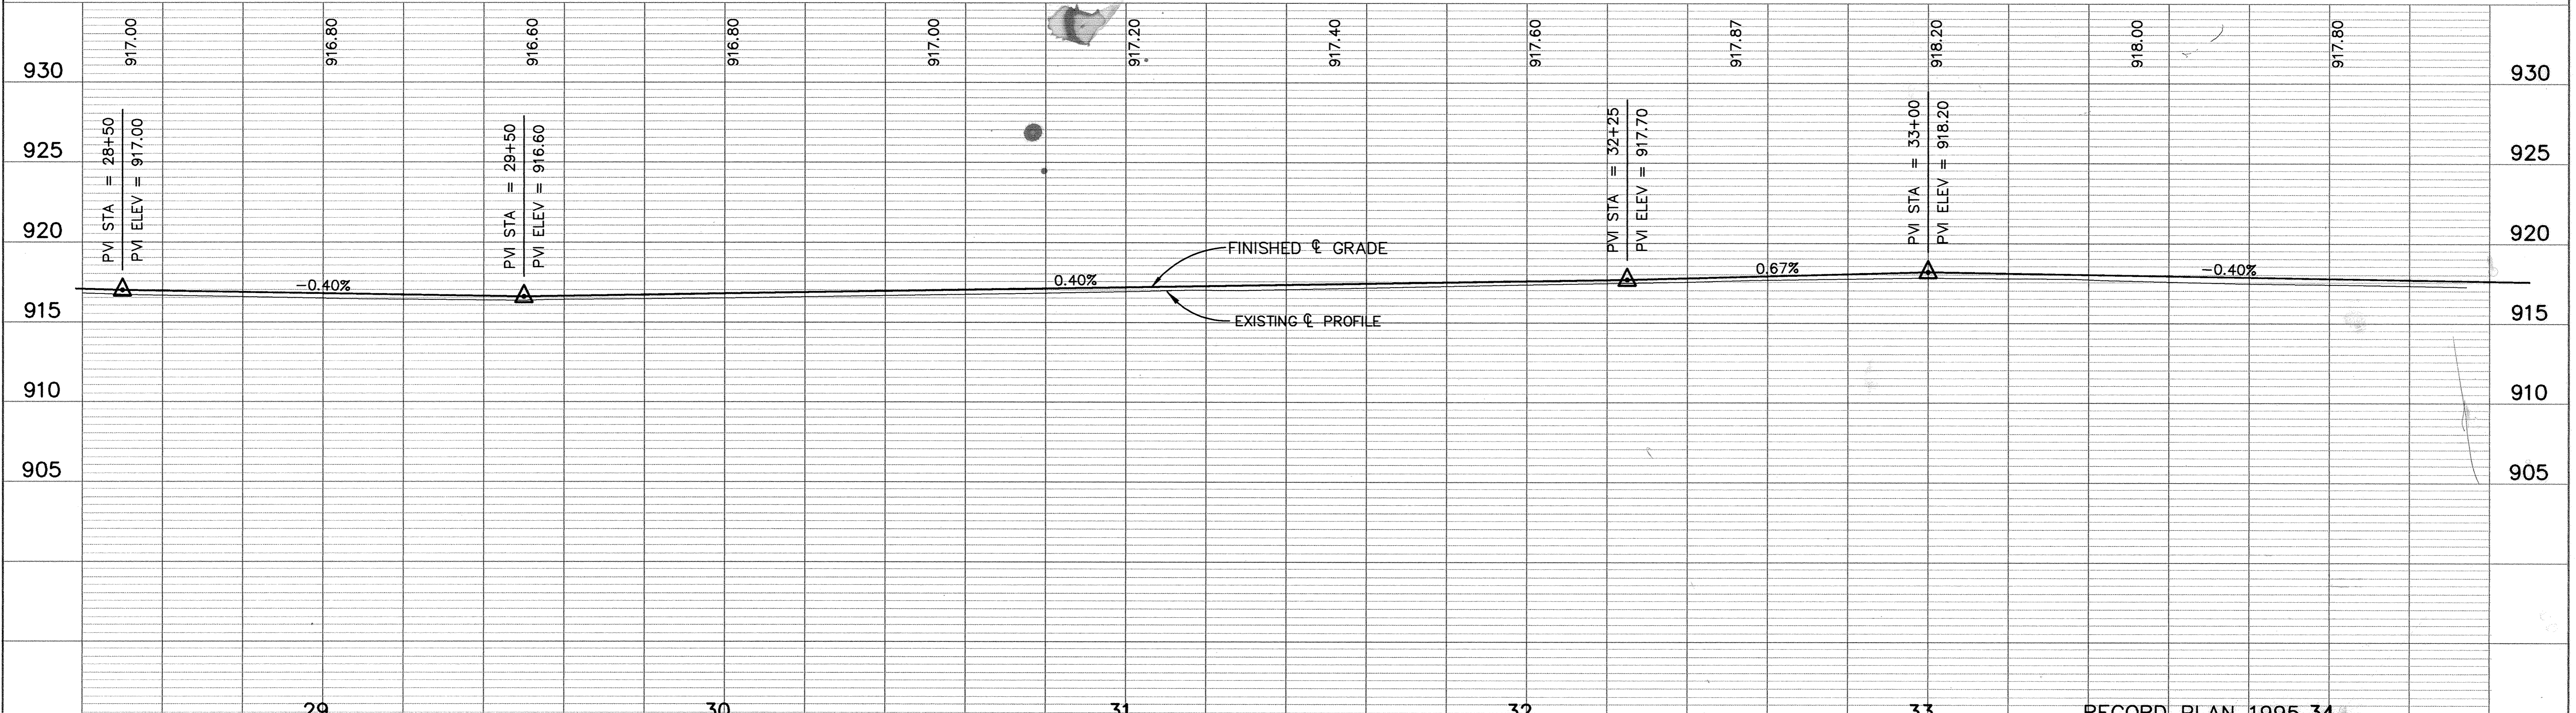


# SCHOOL STREET

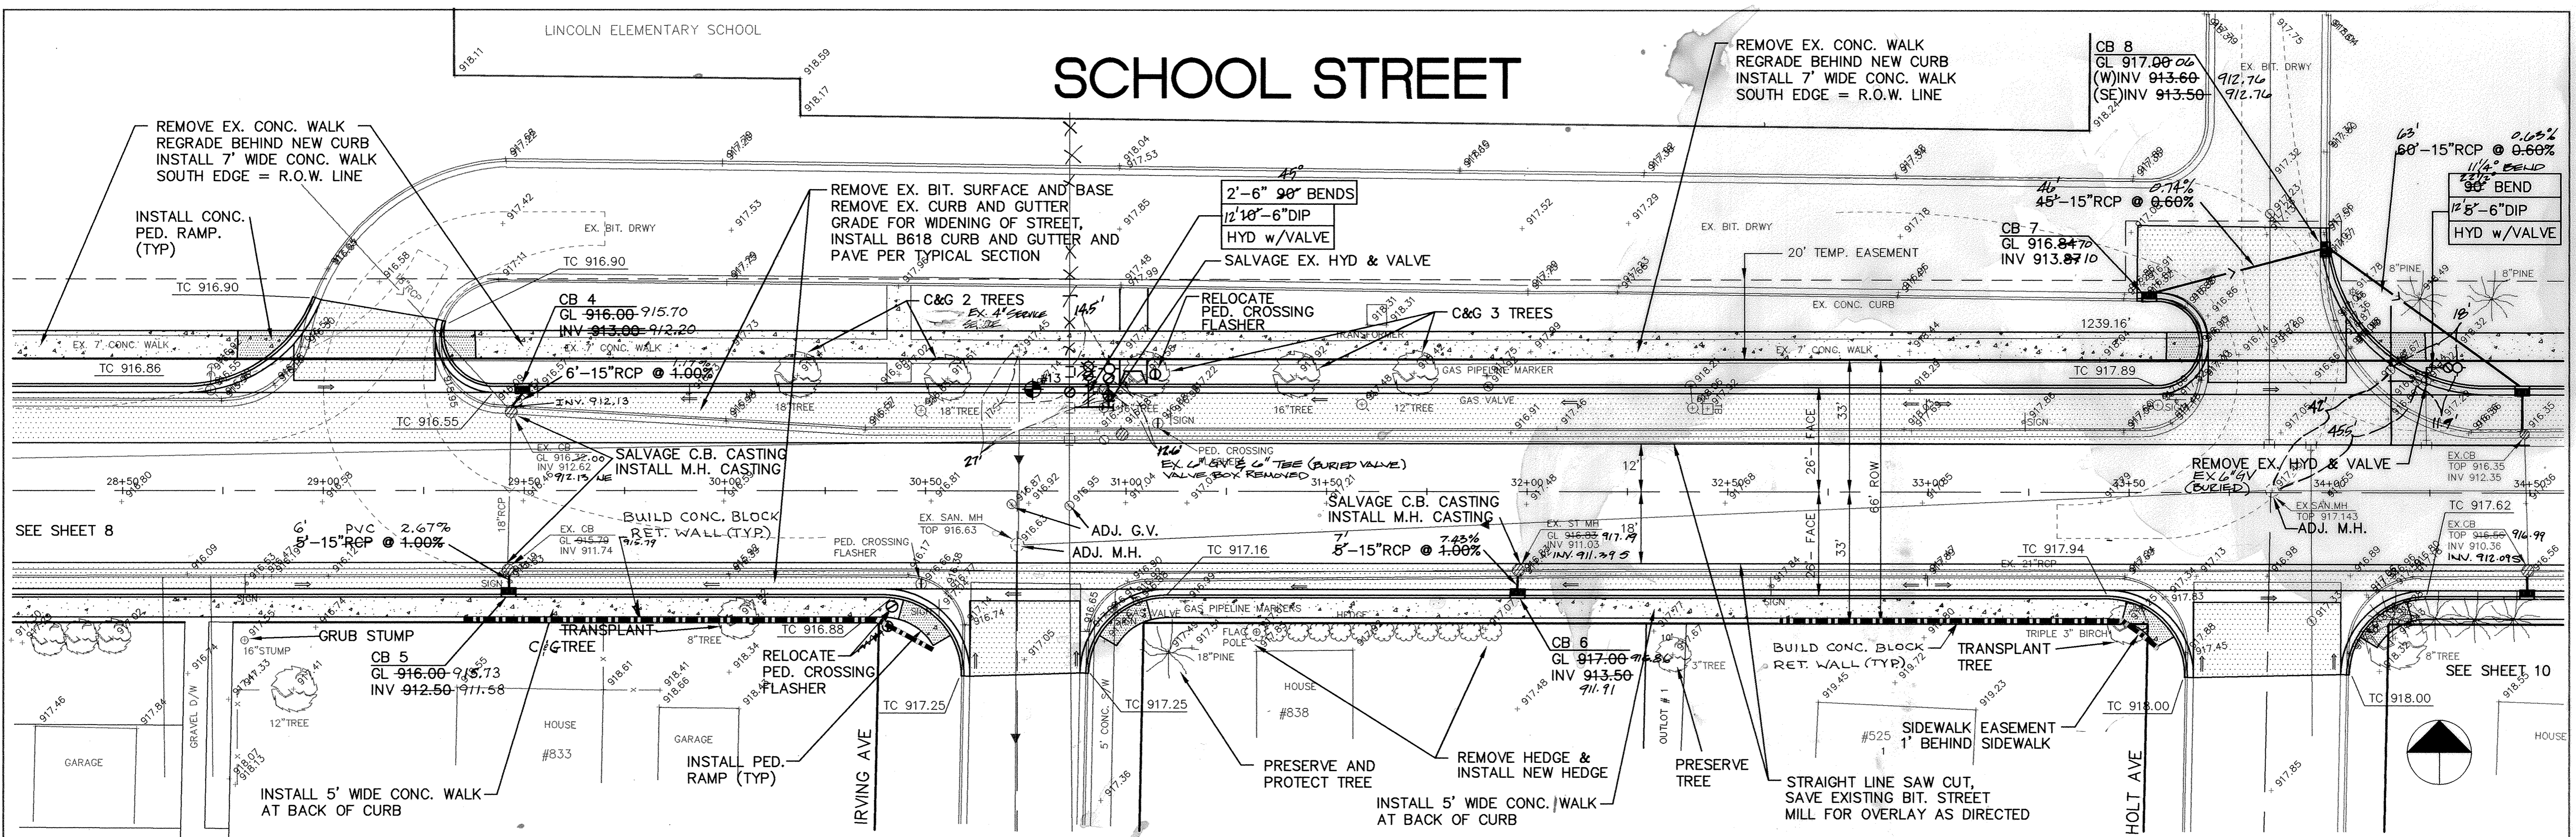

DATE	DESCRIPTION	DESIGNED	CHECKED	PER
APRIL 1994	RECORD PLAN 1995 34			

CITY OF ELK RIVER  
STREET RECONSTRUCTION  
SCHOOL STREET  
204-107-04

DATE APRIL 1994 SHEET 9 OF 74 SHEETS PROJECT NO. 230-216

I HEREBY CERTIFY THAT THIS PLAN, SPECIFICATION, OR REPORT WAS PREPARED BY ME OR UNDER MY DIRECT SUPERVISION AND THAT I AM A DULY REGISTERED PROFESSIONAL ENGINEER UNDER THE LAWS OF THE STATE OF MINNESOTA.

*Paul J. ...*  
DATE 4-29-94 REG. NO. 13929



1326 ENERGY PARK DRIVE  
ST. PAUL, MINNESOTA 55108  
(612) 644-4389

9800 SHELARD PARKWAY  
MINNEAPOLIS, MINNESOTA 55441  
(612) 546-0432

GRAPHIC SCALE	0
HORIZ.	20
VERT.	5