
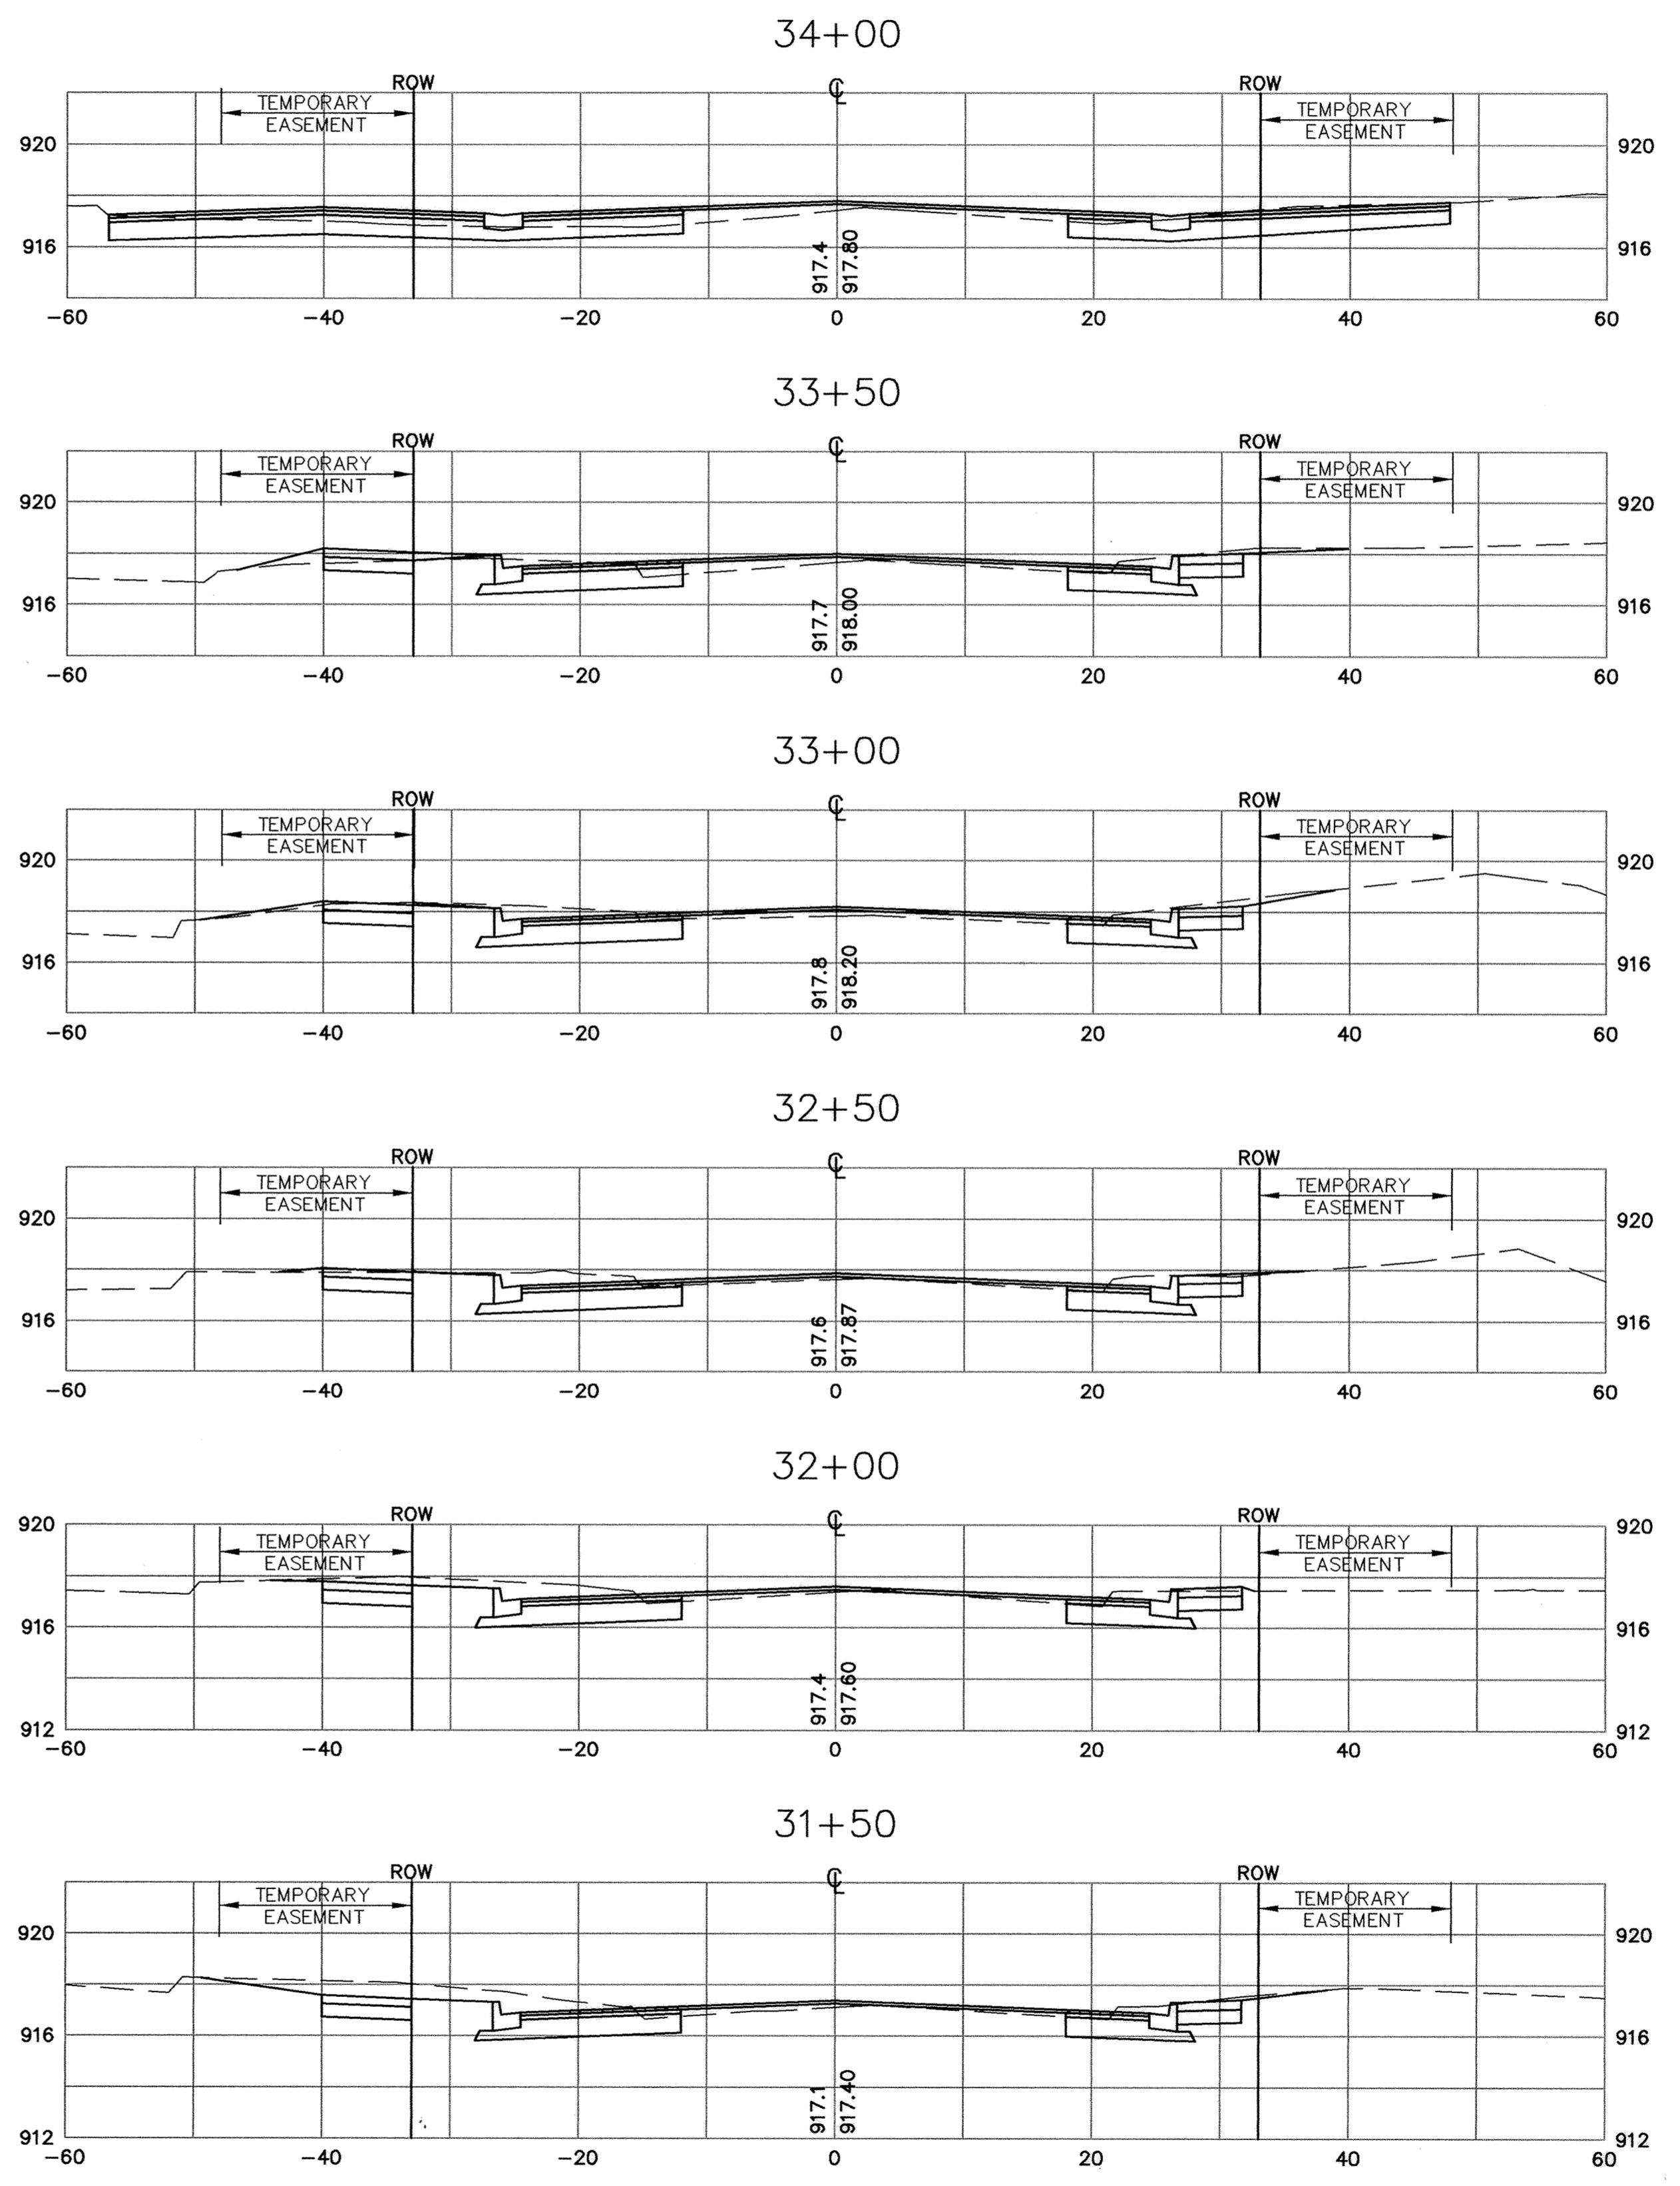


SDCO PRODUCTS • NEW HOPE, MINNESOTA
REVISION BY PART NUMBER 8029
CONSULTING ENGINEERS

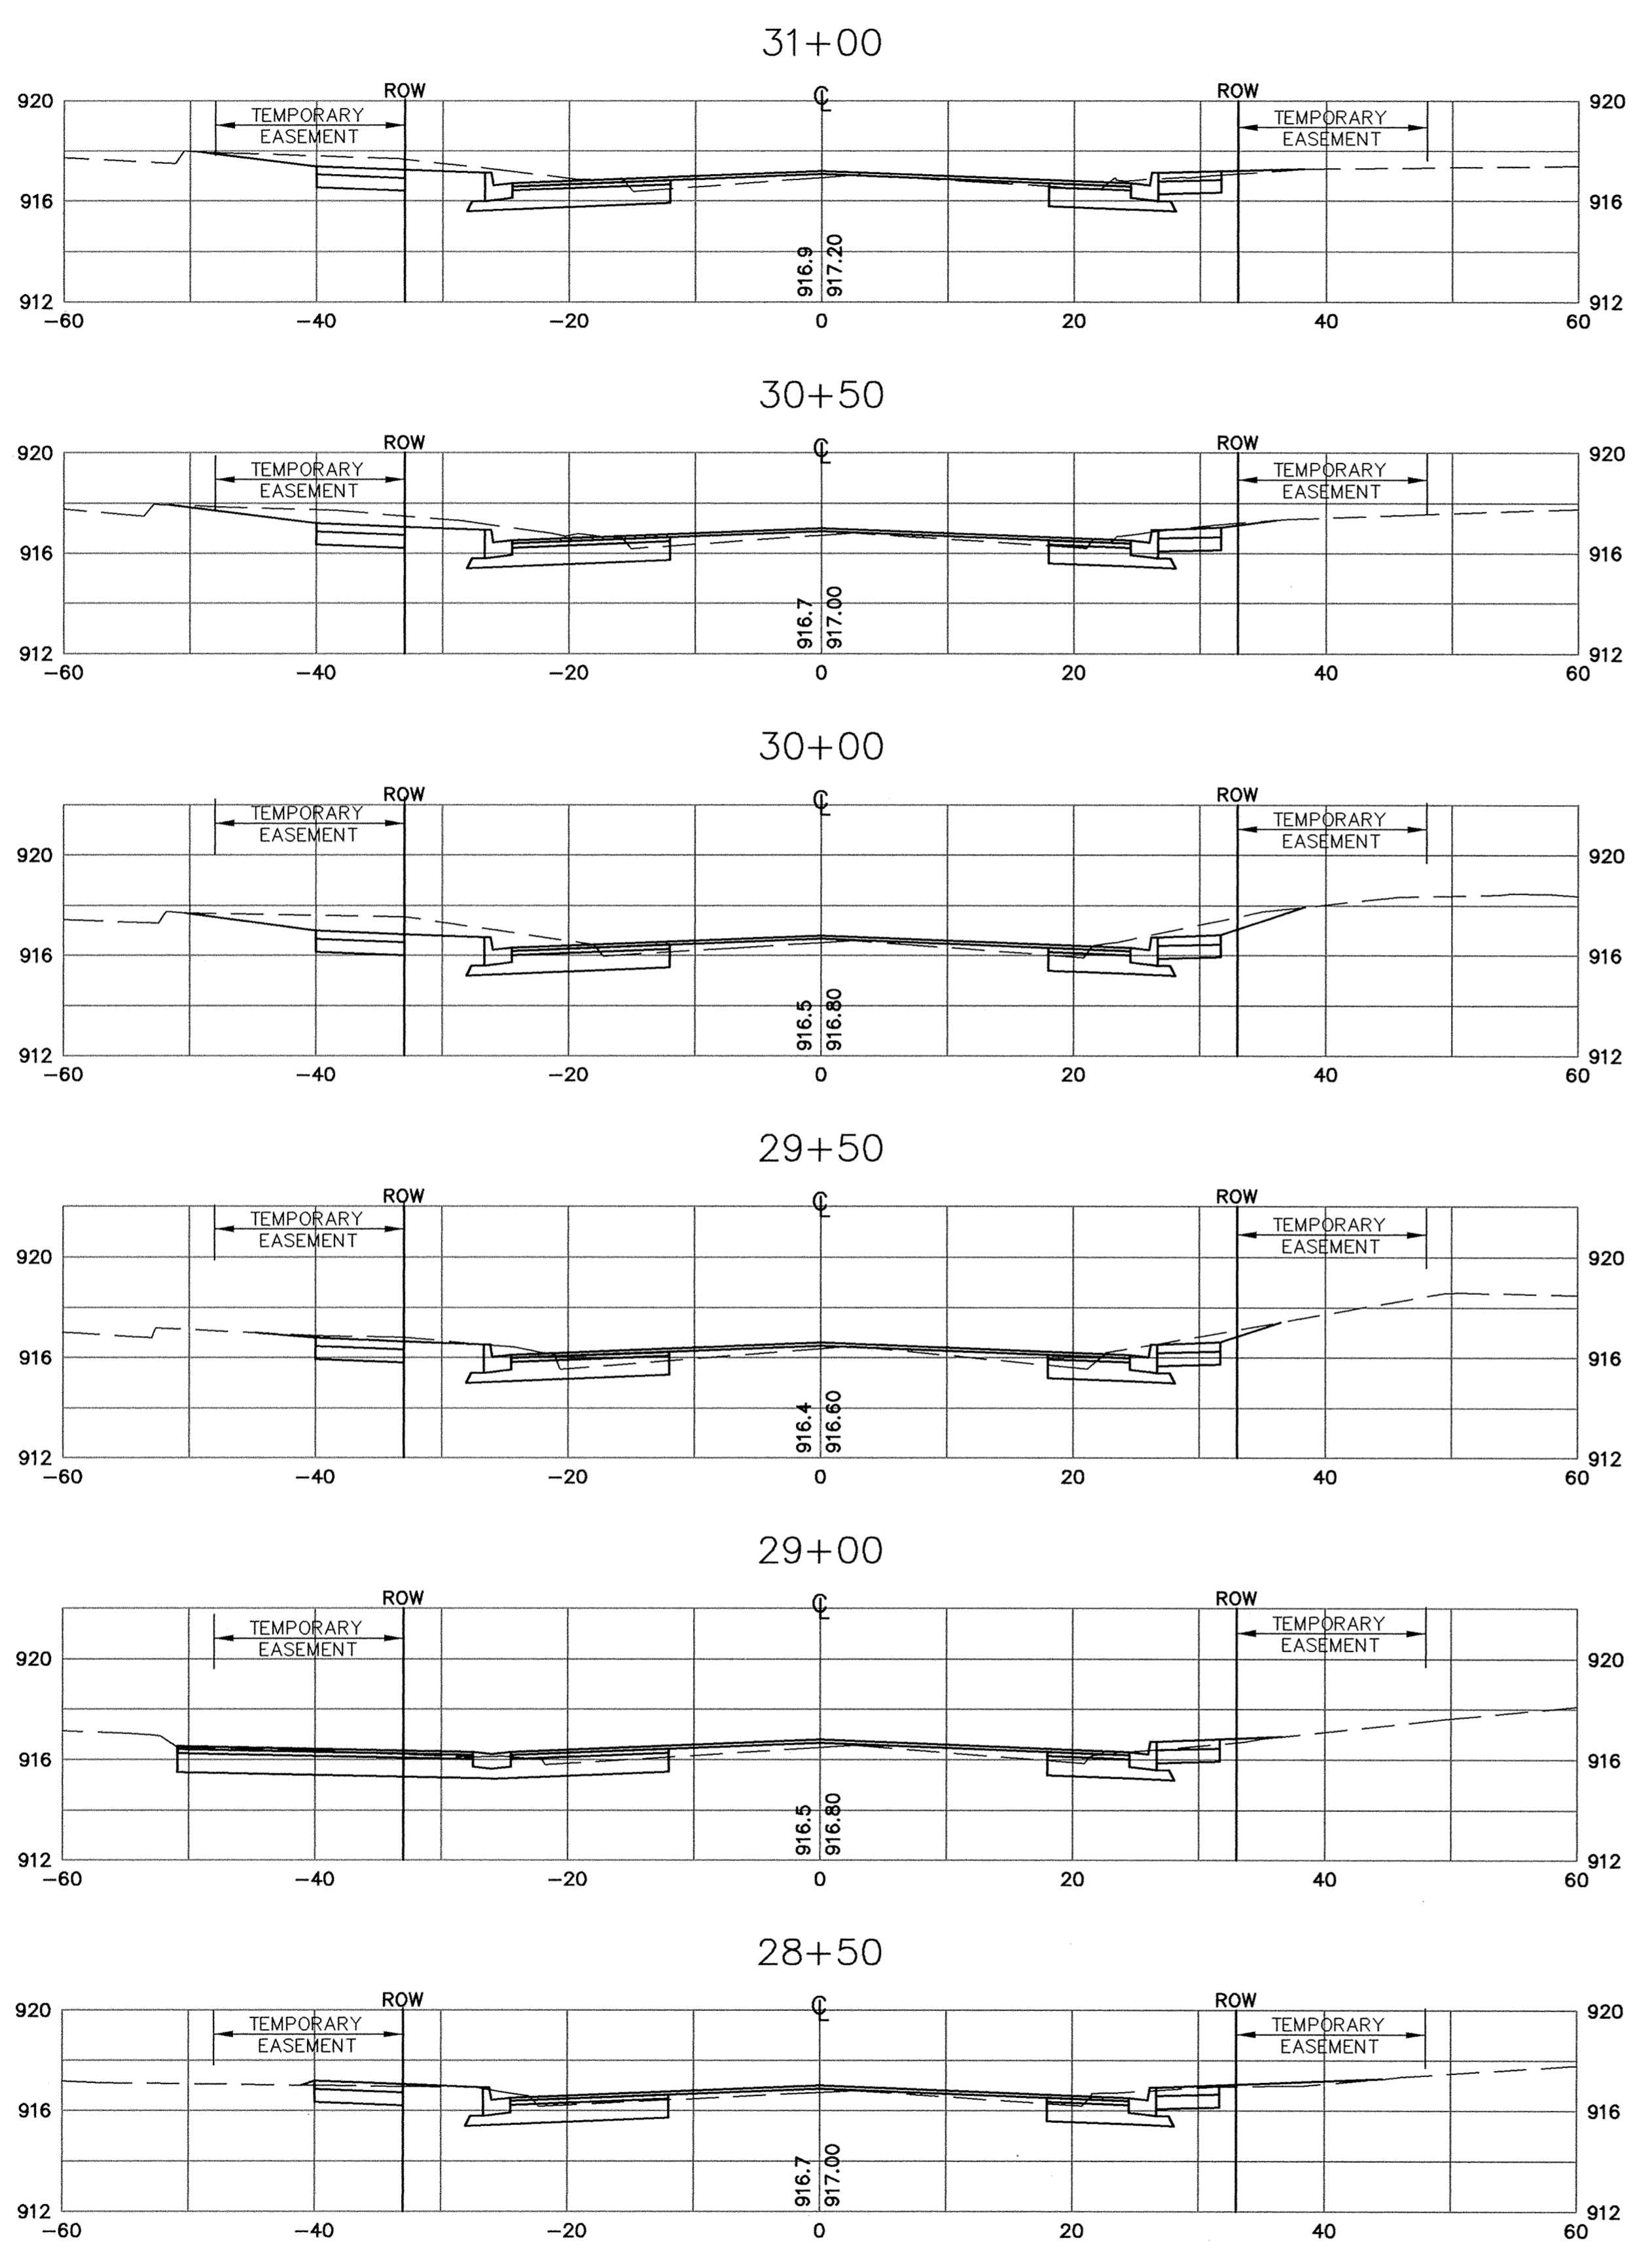


RECORD PLAN 1995

CITY OF ELK RIVER
SCHOOL STREET RECONSTRUCTION
1000' WEST OF JACKSON TO T.H. 169
S.A.P. 204-107-04 28+50 TO 34+00

DATE APRIL 1994 SHEET 16 OF 74 SHEETS PROJECT NO. 230-216

DATE	DESCRIPTION	DESIGNED	PEB

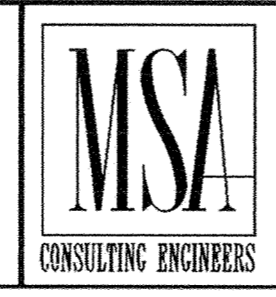

1326 ENERGY PARK DRIVE
ST. PAUL, MINNESOTA 55108
(612) 644-4389
9800 SHELARD PARKWAY
MINNEAPOLIS, MINNESOTA 55441
(612) 546-0432

I HEREBY CERTIFY THAT THIS PLAN, SPECIFICATION,
OR REPORT WAS PREPARED BY ME OR UNDER MY DIRECT
SUPERVISION AND THAT I AM A DULY REGISTERED
PROFESSIONAL ENGINEER UNDER THE LAWS OF THE
STATE OF MINNESOTA.
Paul Bittel
DATE 4-29-94 REG. NO. 13929