


SD PRODUCTS • NEW HOPE, MINNESOTA
 REVISIONS: (SEE REVISIONS LIST)
 REVISIONS: (SEE REVISIONS LIST)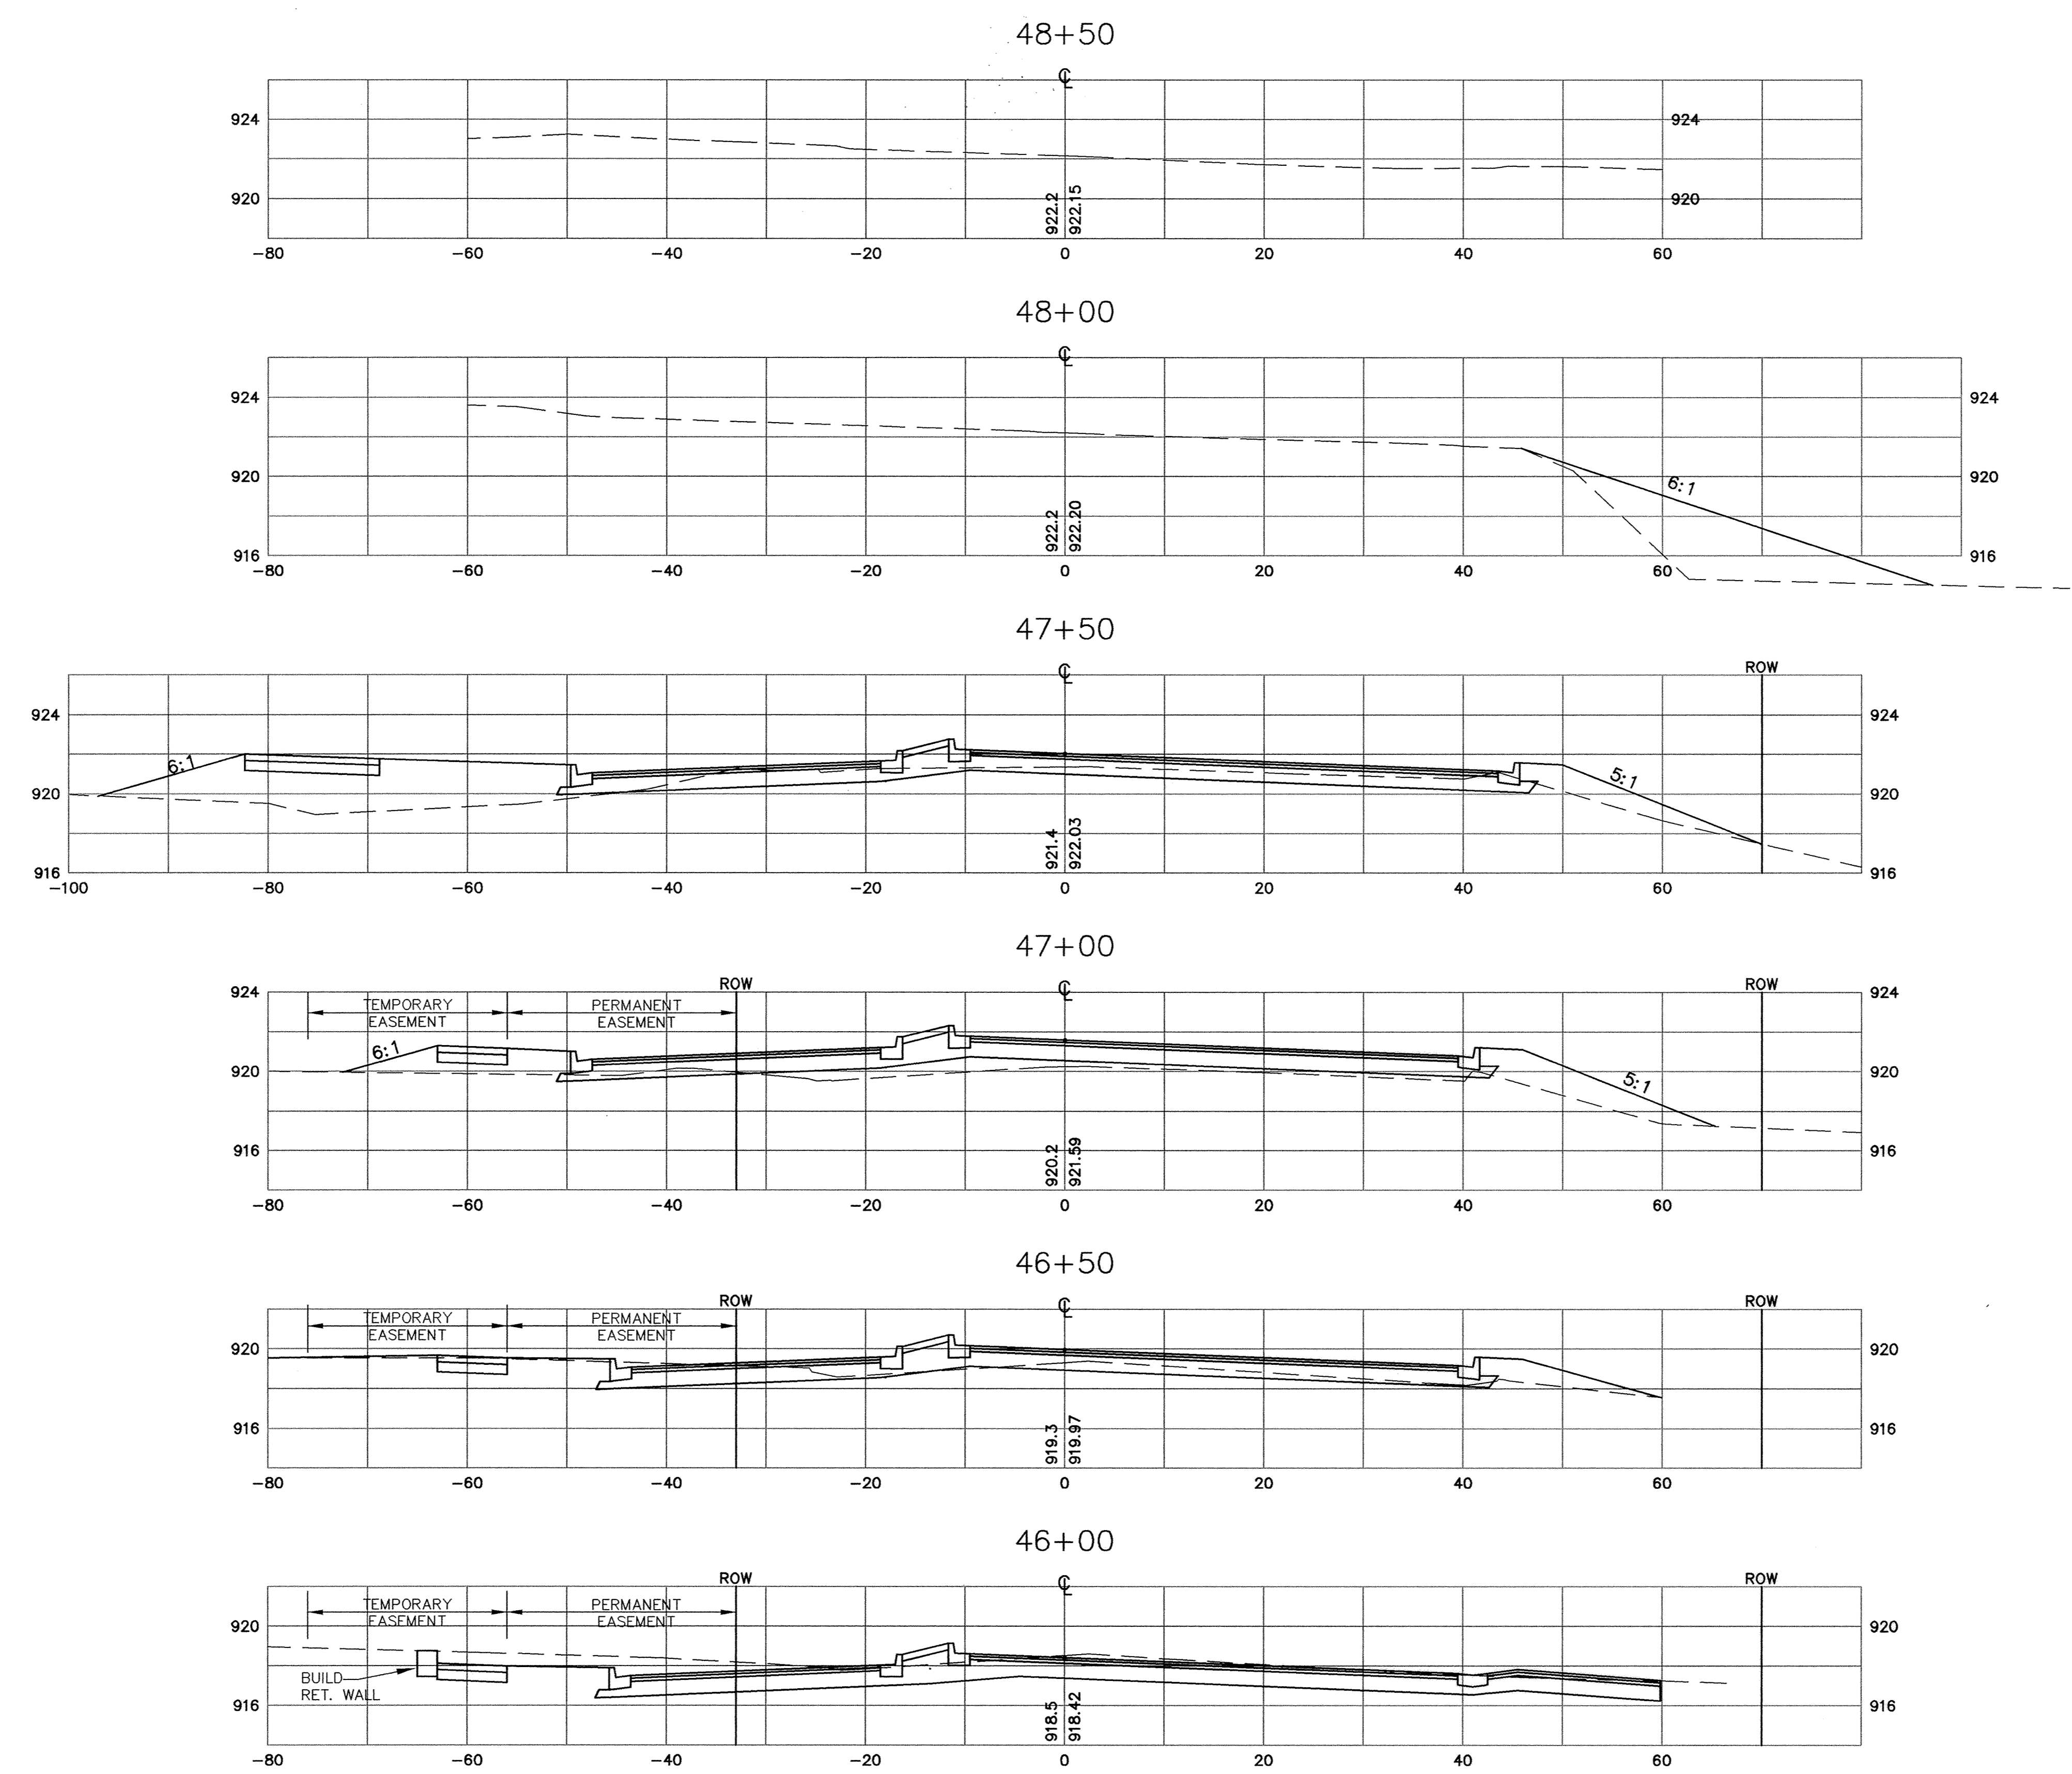
RECORD PLAN 1995

CITY OF ELK RIVER
SCHOOL STREET RECONSTRUCTION
1000' WEST OF JACKSON TO T.H. 169
S.A.P. 204-107-04 46+00 TO 48+50

DATE 6/2/94 TPC	DESCRIPTION MED. & CURB OFFSETS STA. 46+00 & 46+50	DESIGNED <u>PFB</u>	CHECKED _____
		DRAWN _____	GRAPHIC SCALE 0 HORIZ. 10 0 VERT. 5
REVISIONS _____ _____ _____		DATE APRIL 1994	SHEET <u>19</u> OF <u>74</u> SHEETS
		PROJECT NO. <u>230-216</u>	

I HEREBY CERTIFY THAT THIS PLAN, SPECIFICATION,
 OR REPORT WAS PREPARED BY ME OR UNDER MY DIRECT
 SUPERVISION AND THAT I AM A DULY REGISTERED
 PROFESSIONAL ENGINEER UNDER THE LAWS OF THE
 STATE OF MINNESOTA.
Paul Faith
 DATE 6-2-94 REG. NO. 13929



1326 ENERGY PARK DRIVE
 ST. PAUL, MINNESOTA 55108
 (612) 644-4389

 9800 SHELARD PARKWAY
 MINNEAPOLIS, MINNESOTA 55441
 (612) 546-0432