
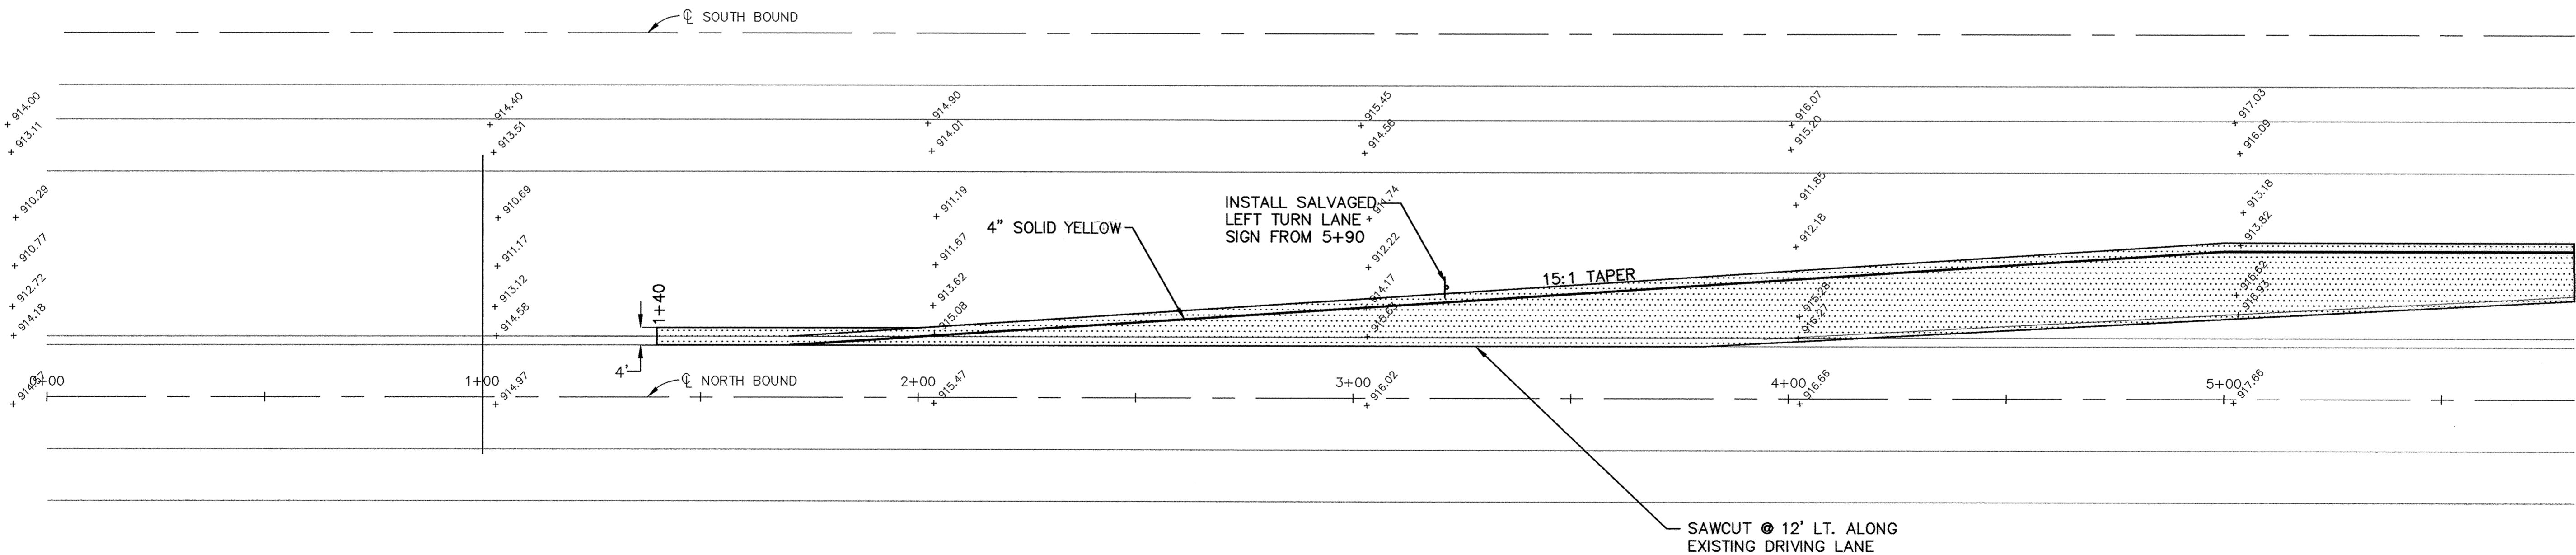
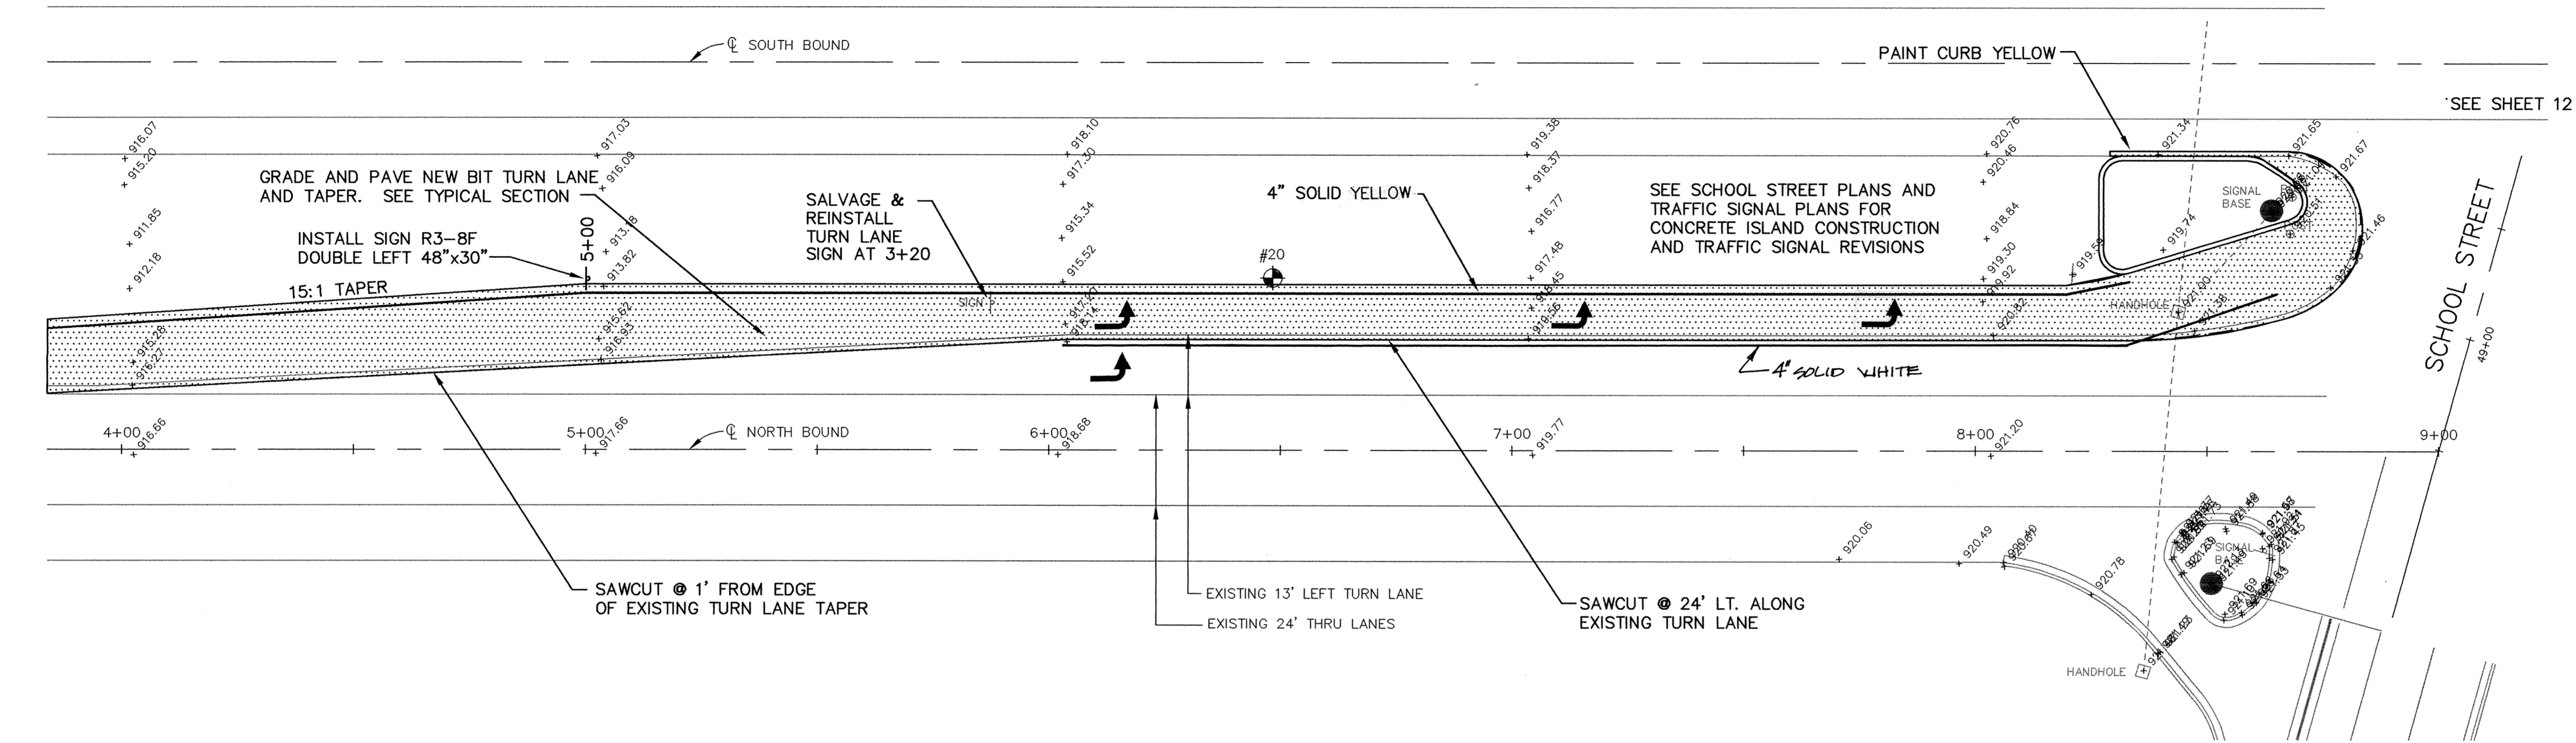


U.S. HIGHWAY NO. 169

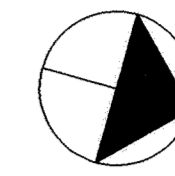

RECORD PLAN 1995

CITY OF ELK RIVER
 ADDITIONAL LEFT TURN LANE
 NORTH BOUND T.H. 169 AT SCHOOL STREET
 S.A.P. 204-010-02

DATE APRIL 1994 SHEET 20 OF 74 SHEETS PROJECT NO. 230-216

I HEREBY CERTIFY THAT THIS PLAN, SPECIFICATION, OR REPORT WAS PREPARED BY ME OR UNDER MY DIRECT SUPERVISION AND THAT I AM A DULY REGISTERED PROFESSIONAL ENGINEER UNDER THE LAWS OF THE STATE OF MINNESOTA.

Paul Koeth
 DATE 4-29-94 REG. NO. 13929

MSA
 CONSULTING ENGINEERS

1326 ENERGY PARK DRIVE
 ST. PAUL, MINNESOTA 55108
 (612) 644-4389

9800 SHELARD PARKWAY
 MINNEAPOLIS, MINNESOTA 55441
 (612) 546-0432

DATE	DESCRIPTION	DESIGNED	PER
5/20/94	STATE AID COMMENTS	CHECKED	PB
		DRAWN	

GRAPHIC SCALE
 0 HORIZ. 20
 0 VERT. 5

DRAWING NUMBER

DRAWING NUMBER

DRAWING NUMBER

DRAWING NUMBER
 SCHOOL 95
 20