
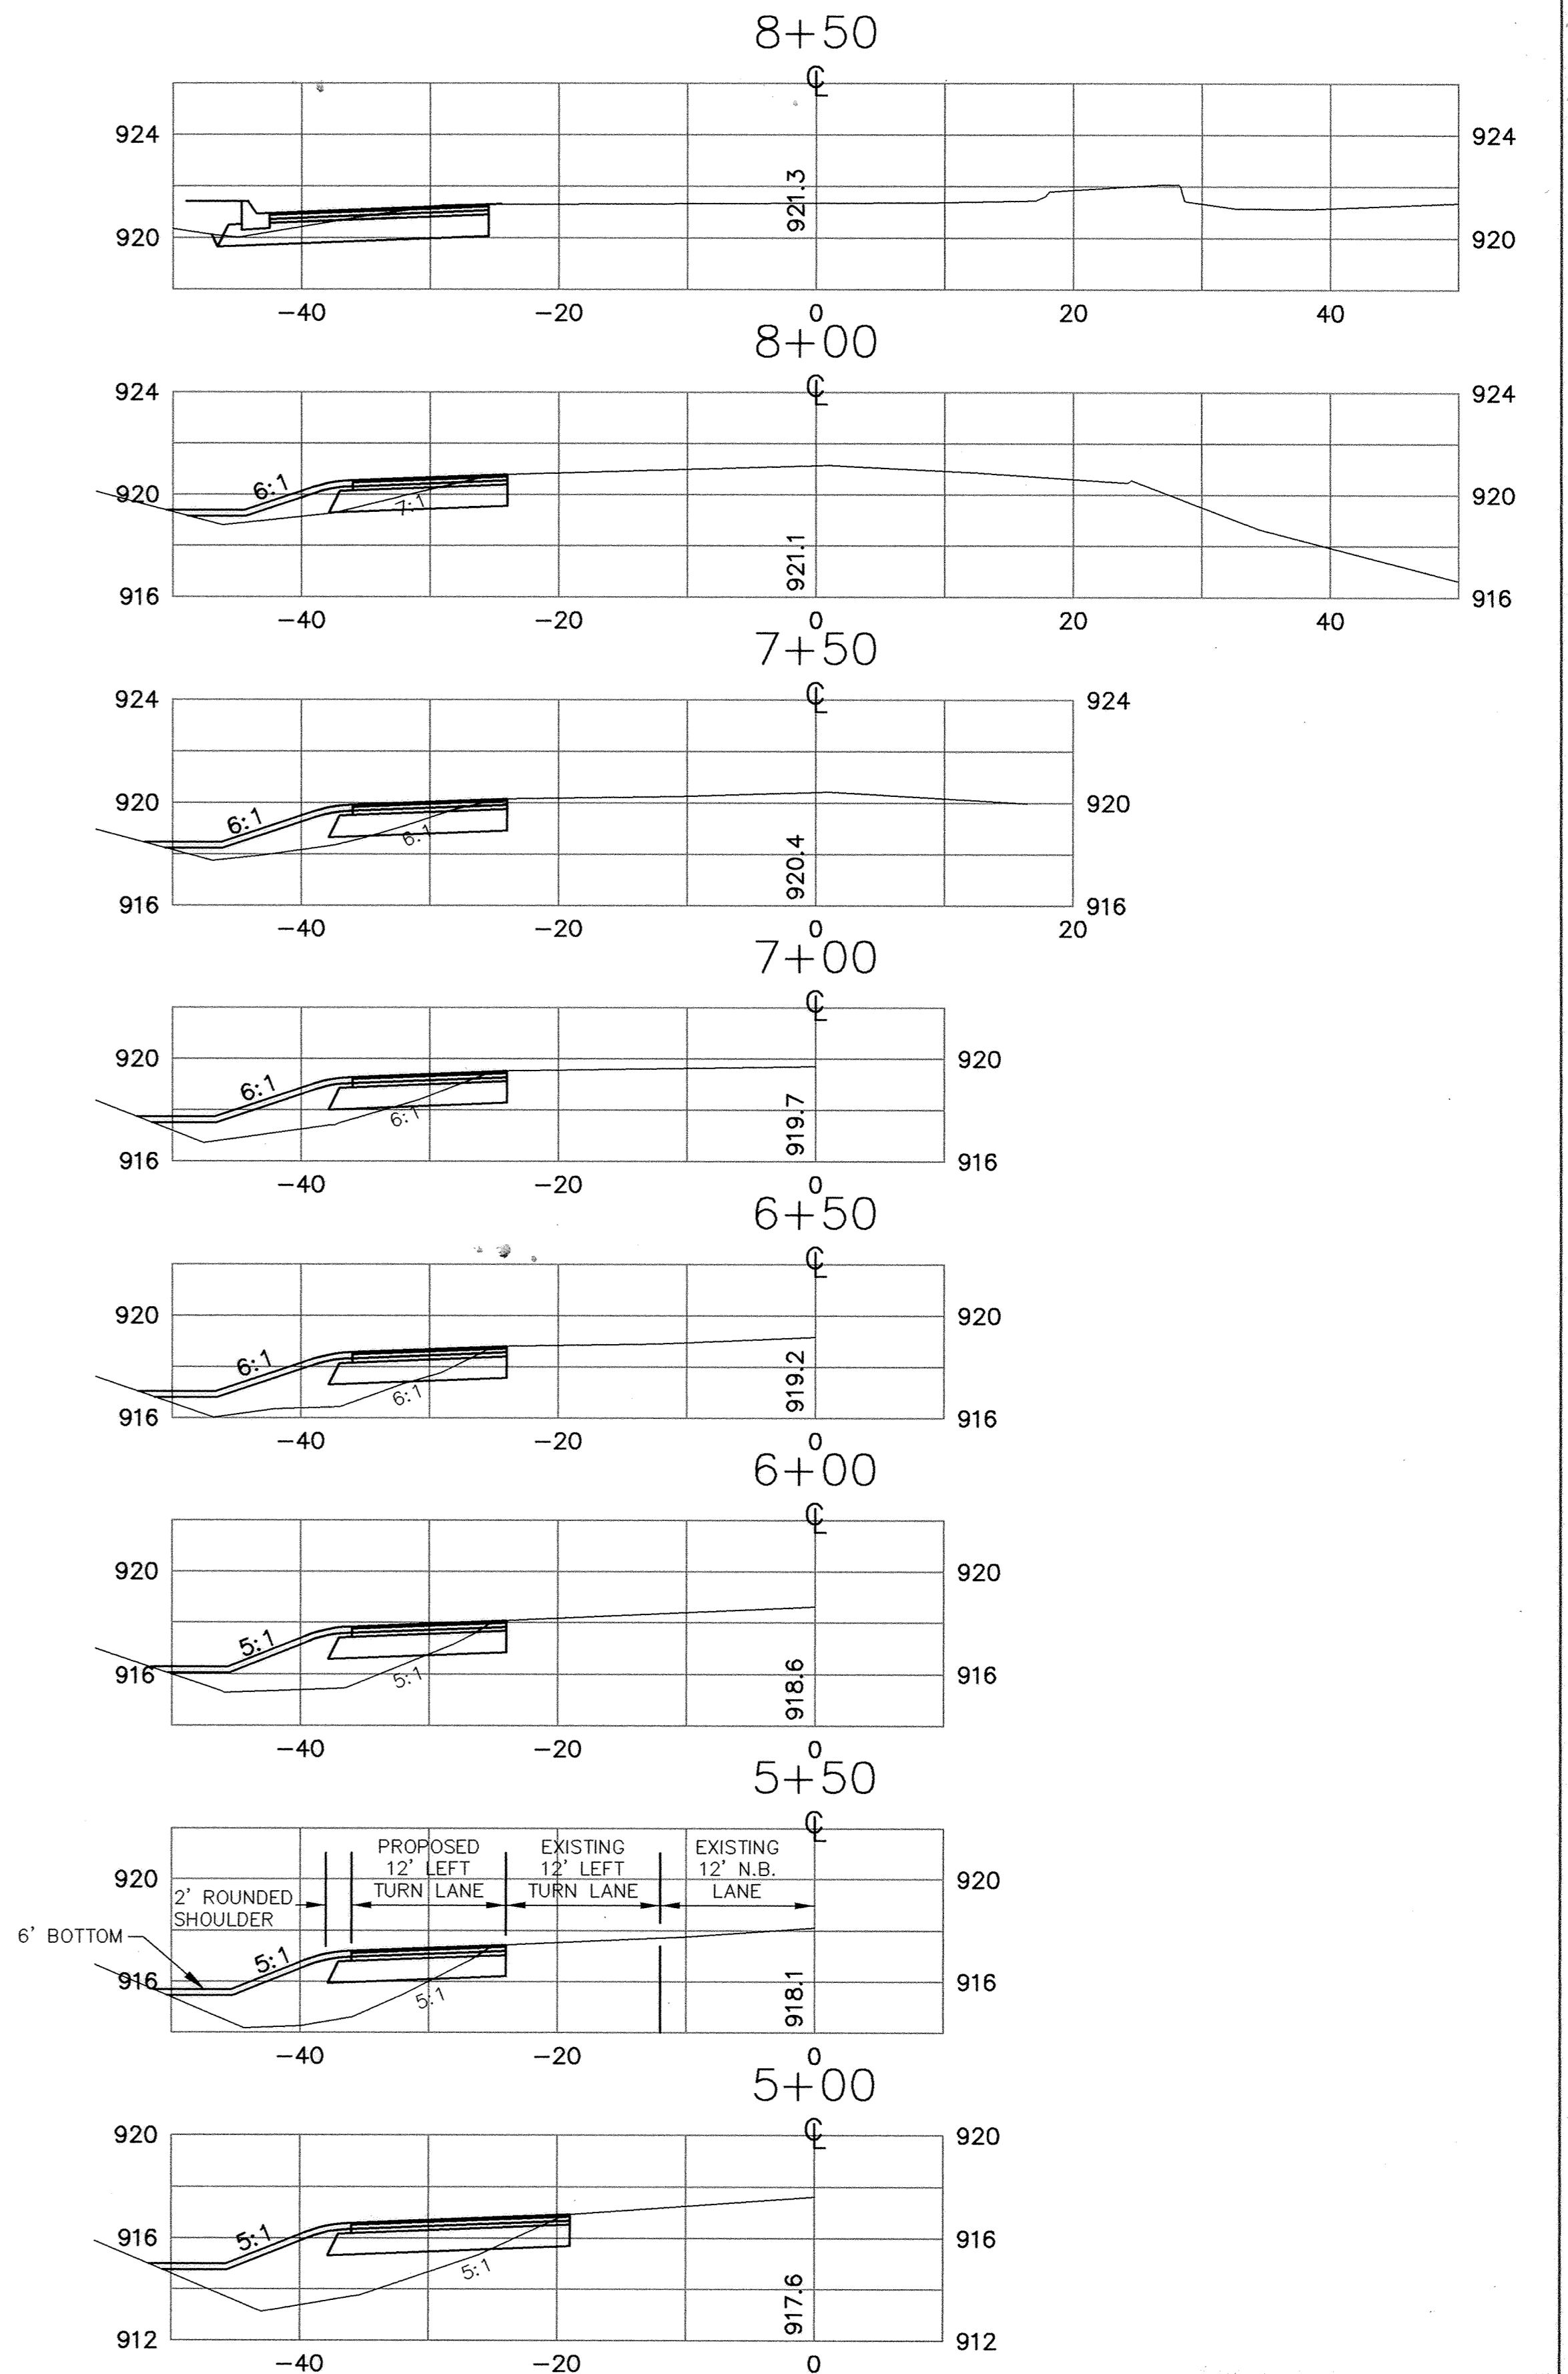
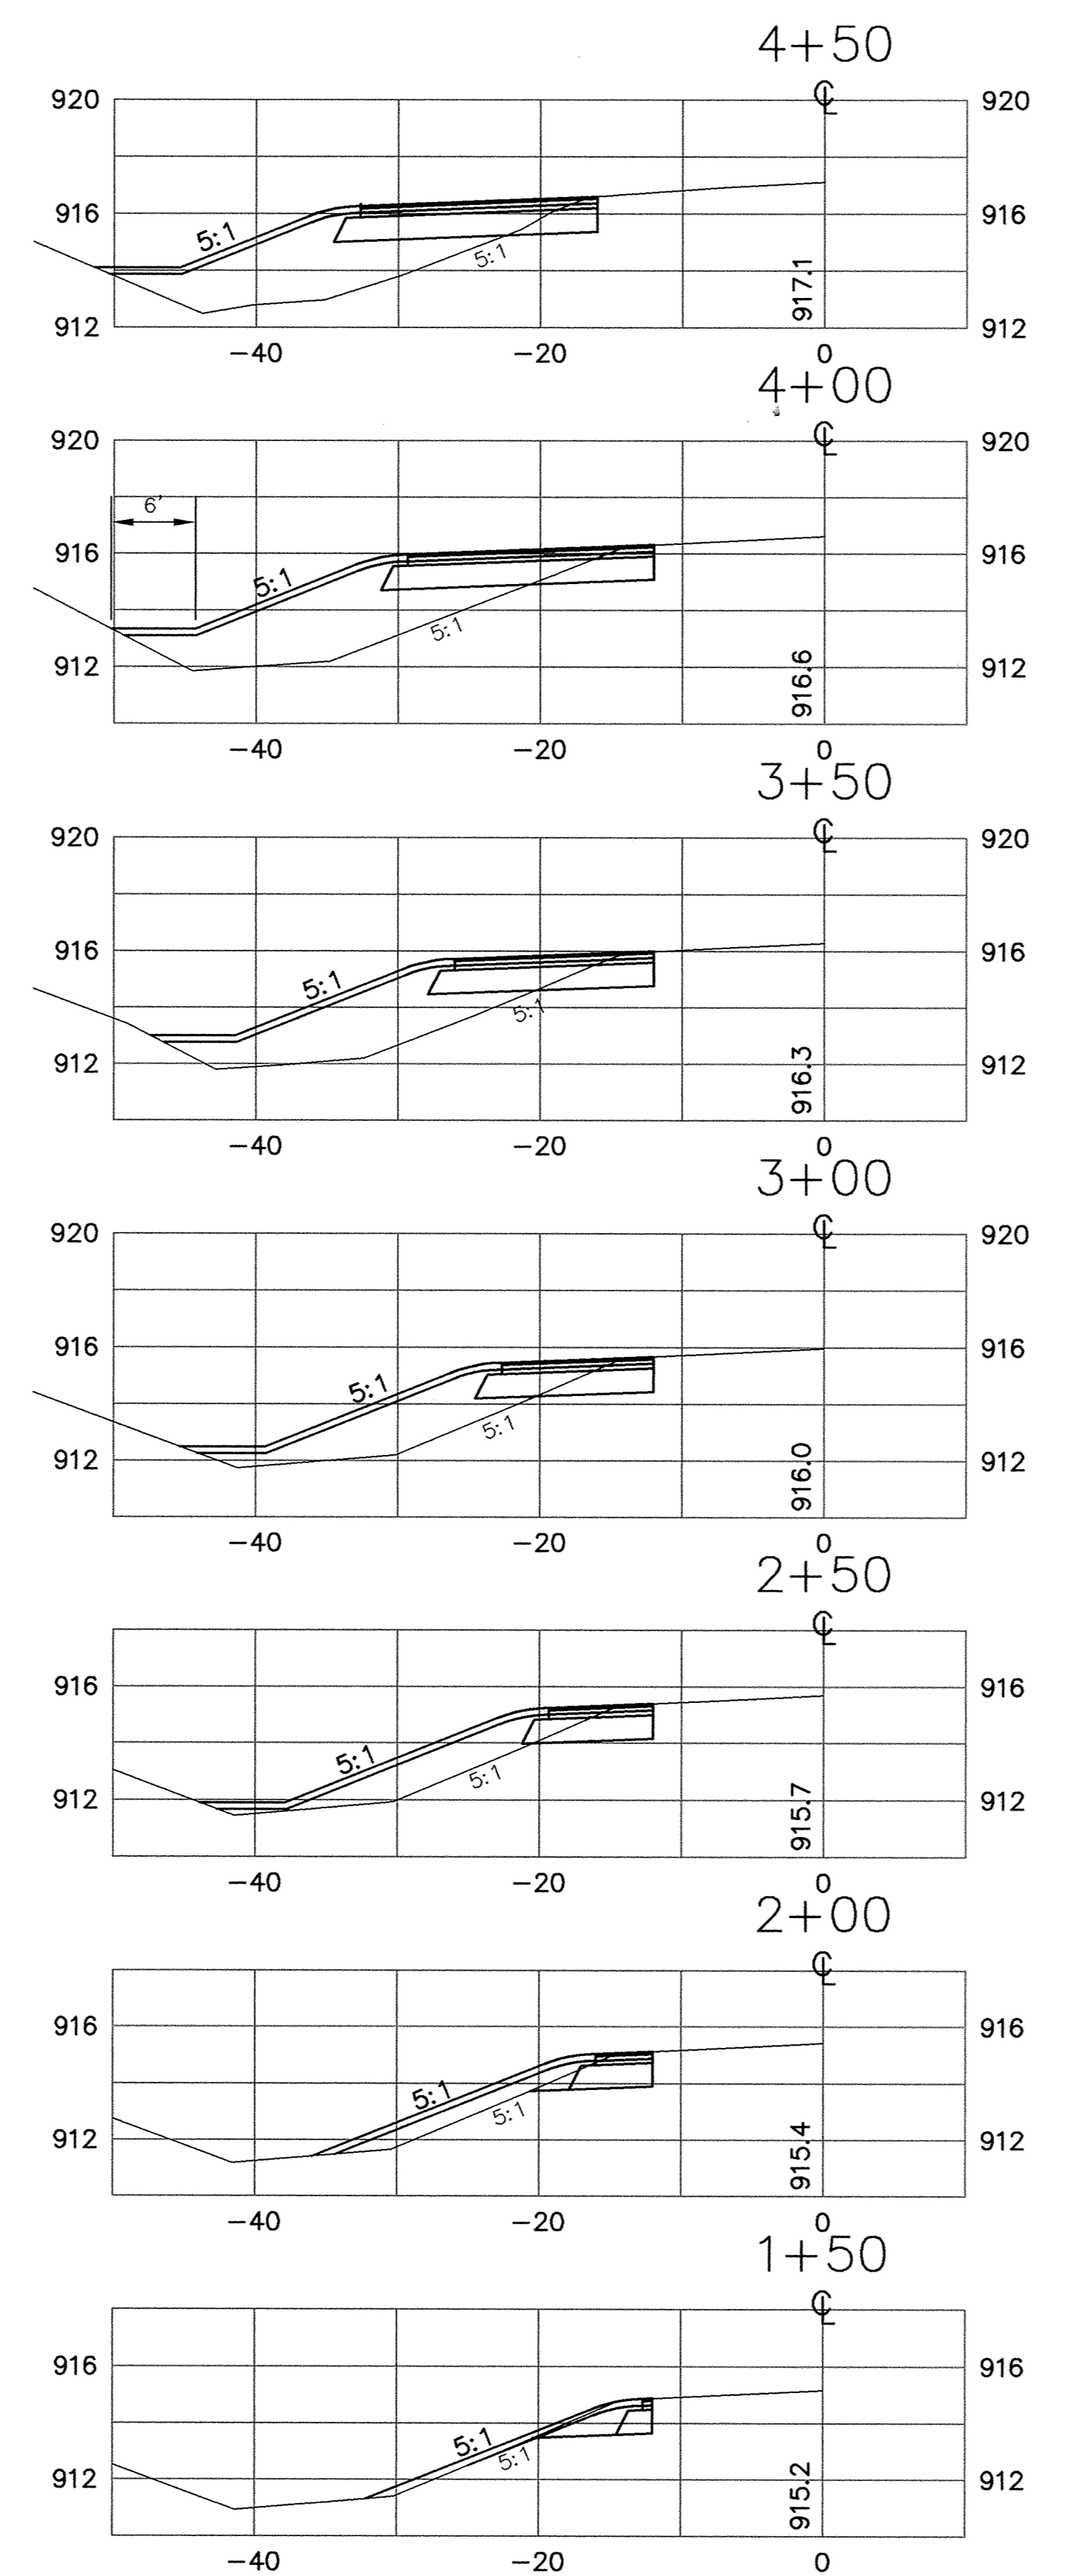


31 PROJECTS • NEW HOPE, MINNESOTA  
REPORT BY PART NUMBER 8528

31 PROJECTS • NEW HOPE, MINNESOTA  
REPORT BY PART NUMBER 8528

31 PROJECTS • NEW HOPE, MINNESOTA  
REPORT BY PART NUMBER 8528

31 PROJECTS • NEW HOPE, MINNESOTA  
REPORT BY PART NUMBER 8528

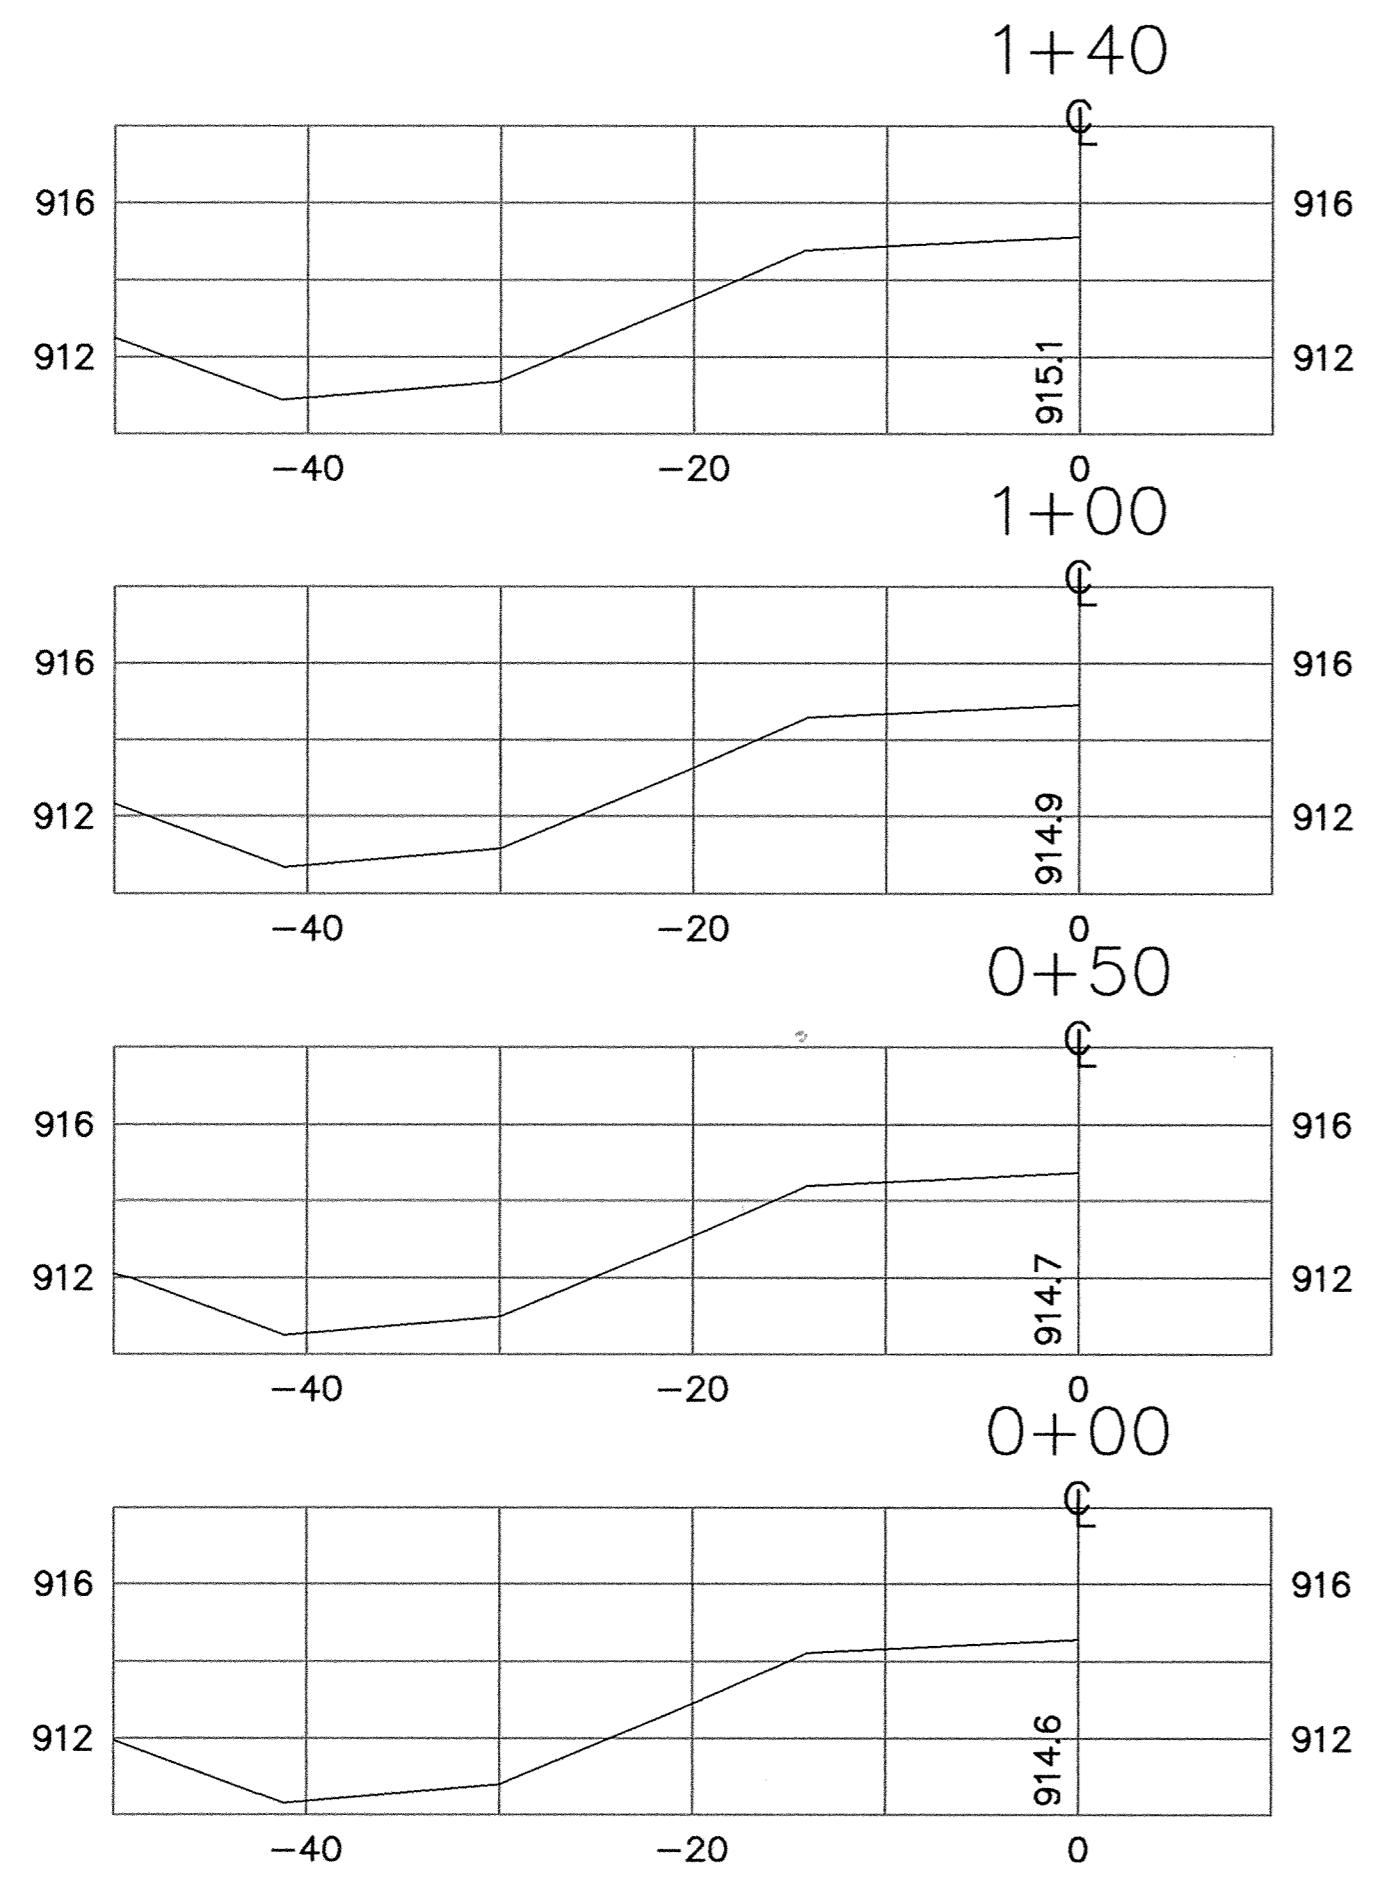

ER216TNX

I HEREBY CERTIFY THAT THIS PLAN, SPECIFICATION, OR REPORT WAS PREPARED BY ME OR UNDER MY DIRECT SUPERVISION AND THAT I AM A DULY REGISTERED PROFESSIONAL ENGINEER UNDER THE LAWS OF THE STATE OF MINNESOTA.

*Paul Boettke*  
DATE: 4-29-94 REG. NO. 13929



1326 ENERGY PARK DRIVE  
ST. PAUL, MINNESOTA 55108  
(612) 644-4389

9800 SHELARD PARKWAY  
MINNEAPOLIS, MINNESOTA 55441  
(612) 546-0432

DATE	DESCRIPTION	DESIGNED	PER
		CHECKED	PB
		DRAWN	
GRAPHIC SCALE		HORIZ. 10	
		VERT. 5	

RECORD PLAN 1995

CITY OF ELK RIVER  
ADDITIONAL LEFT TURN LANE  
NORTH BOUND T.H. 169 AT SCHOOL STREET  
S.A.P. 204-010-02

DATE APRIL 1994 SHEET 21 OF 74 SHEETS PROJECT NO. 230-216

824