


SURVEY CREW -
 FIELD VERIFY STORM SEWER
 OUTLET PIPE LOCATIONS
 WITH DEVELOPER'S PLAN
 AND CONSTRUCTION AS TO
 PIPE LOCATION, LENGTH
 AND SLOPE.

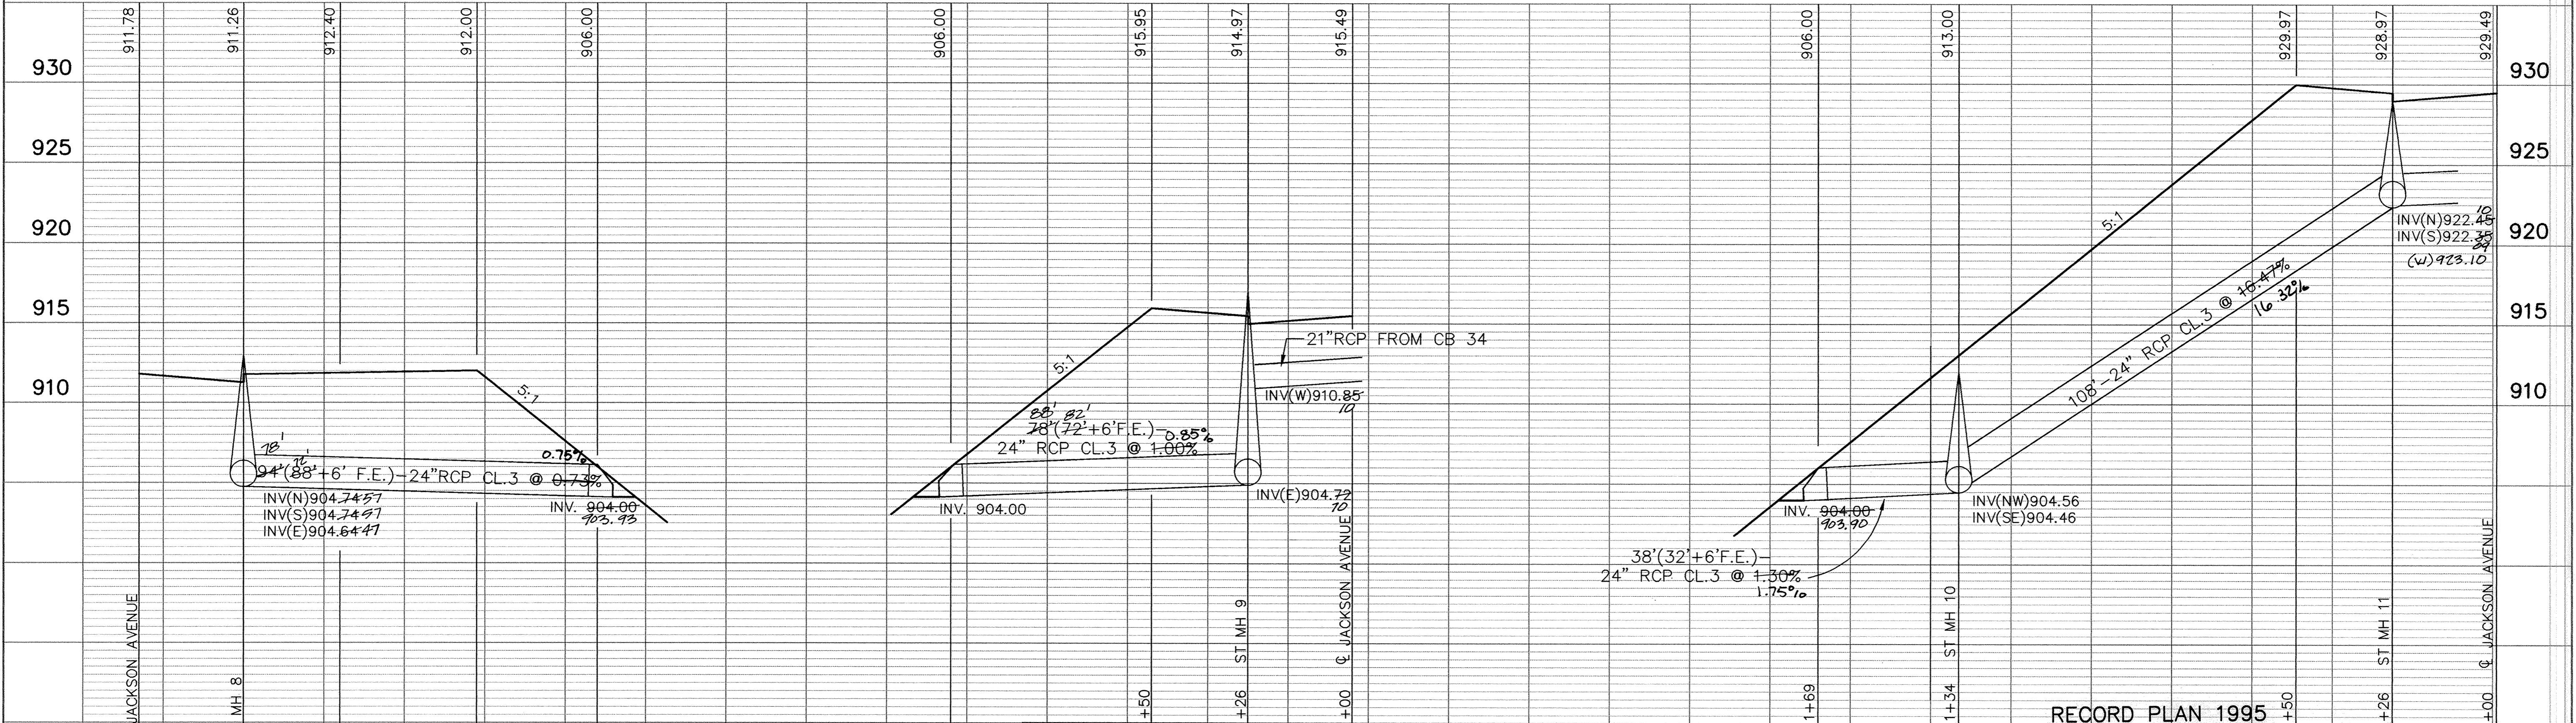

DATE	REVISIONS	DESCRIPTION	DESIGNED	CHECKED	DRAWN
APRIL 1994			PEB	PEB	PEB
DATE	CITY OF ELK RIVER JACKSON AVE. RECONSTRUCTION SCHOOL ST. TO T.H. 169 S.A.P. 204-104-04 MTB				
SHEET	26 OF 74 SHEETS				
PROJECT NO.	230-216				

I HEREBY CERTIFY THAT THIS PLAN, SPECIFICATION,
 OR REPORT WAS PREPARED BY ME OR UNDER MY DIRECT
 SUPERVISION AND THAT I AM A DULY REGISTERED
 PROFESSIONAL ENGINEER UNDER THE LAWS OF THE
 STATE OF MINNESOTA.
 Paul Boettch
 DATE 4-29-94 REG. NO. 1929

MSA
 CONSULTING ENGINEERS
 1326 ENERGY PARK DRIVE
 ST. PAUL, MINNESOTA 55108
 (612) 644-4389
 9800 SHELDARD PARKWAY
 MINNEAPOLIS, MINNESOTA 55441
 (612) 546-0432

RECORD PLAN 1995

S:\CADD\PROJECTS\230\230-216\230-216.DWG
 DRAWING NUMBER
 SCHOOL 95
 26
 DRAWING NUMBER
 819