

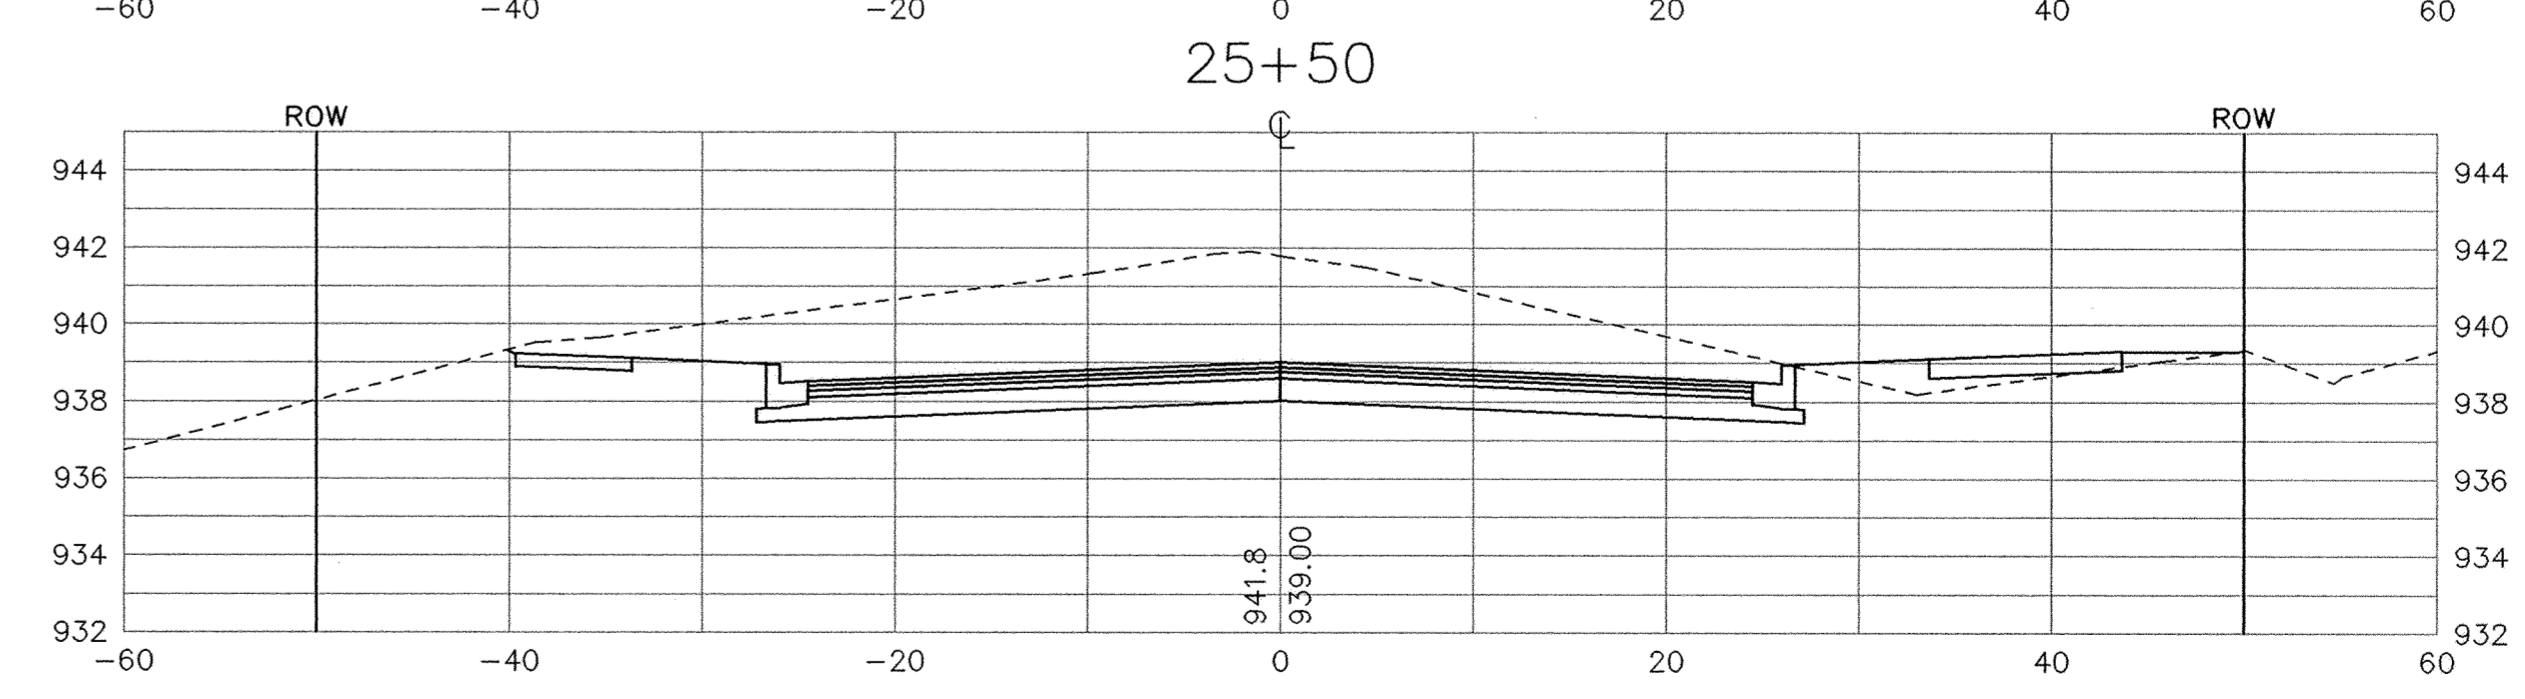
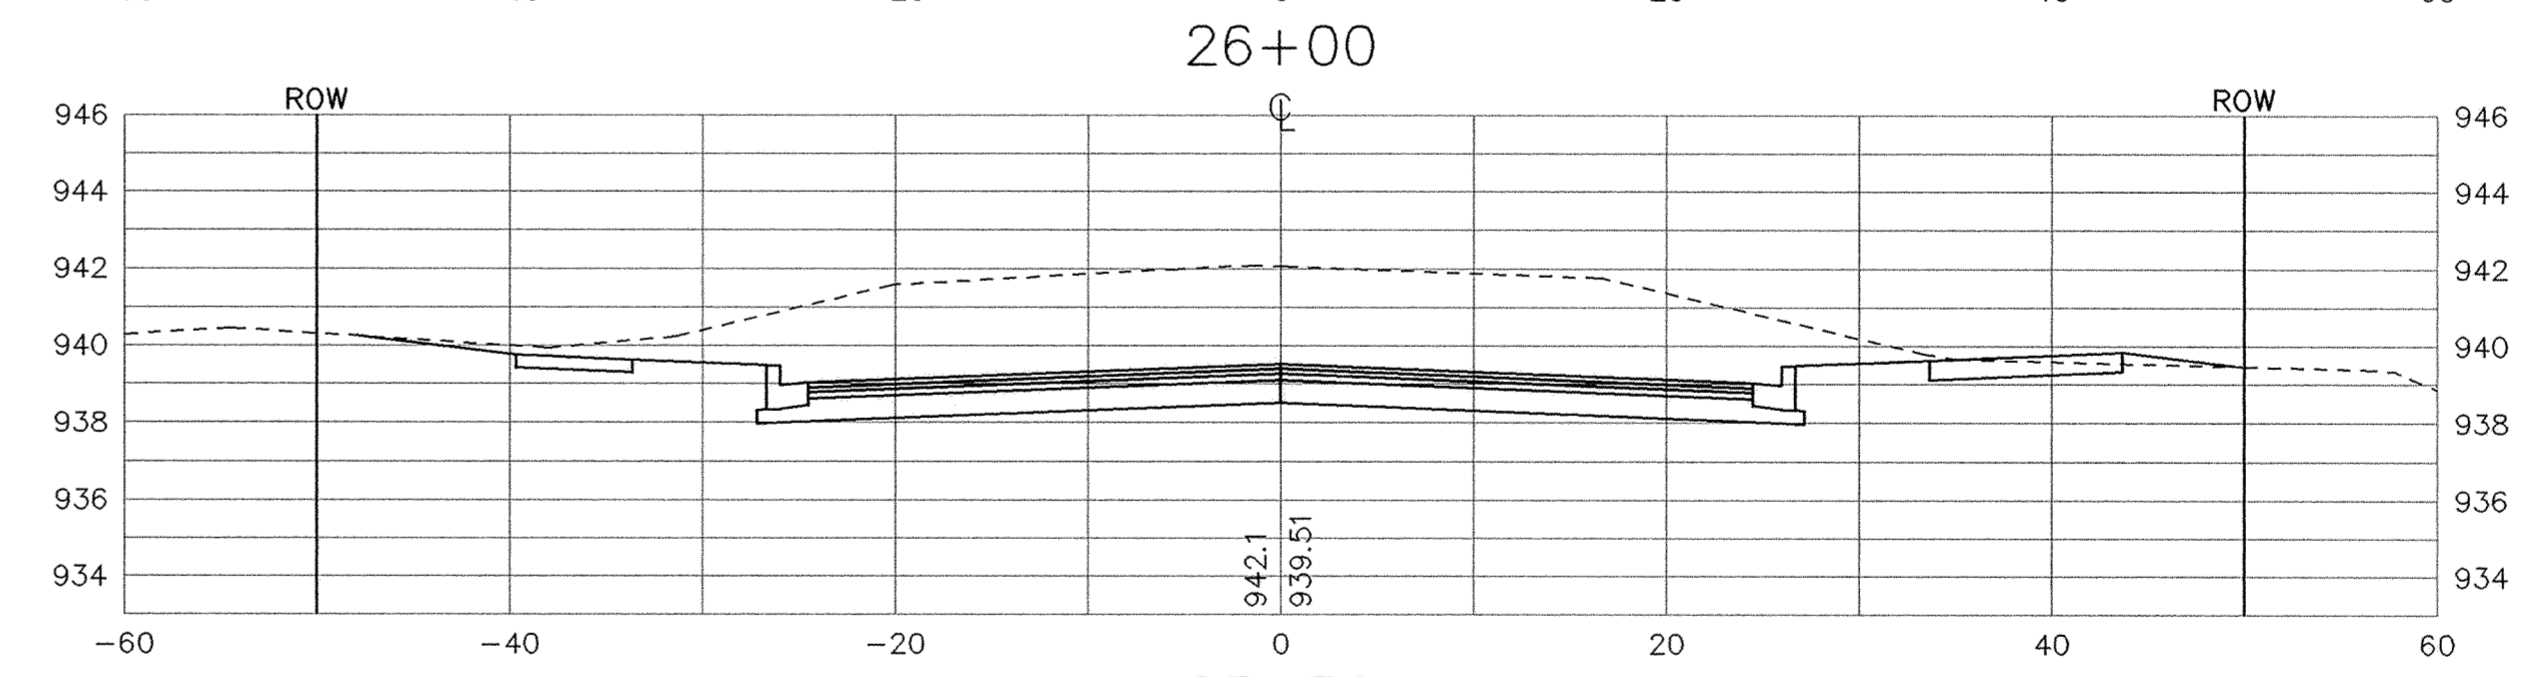
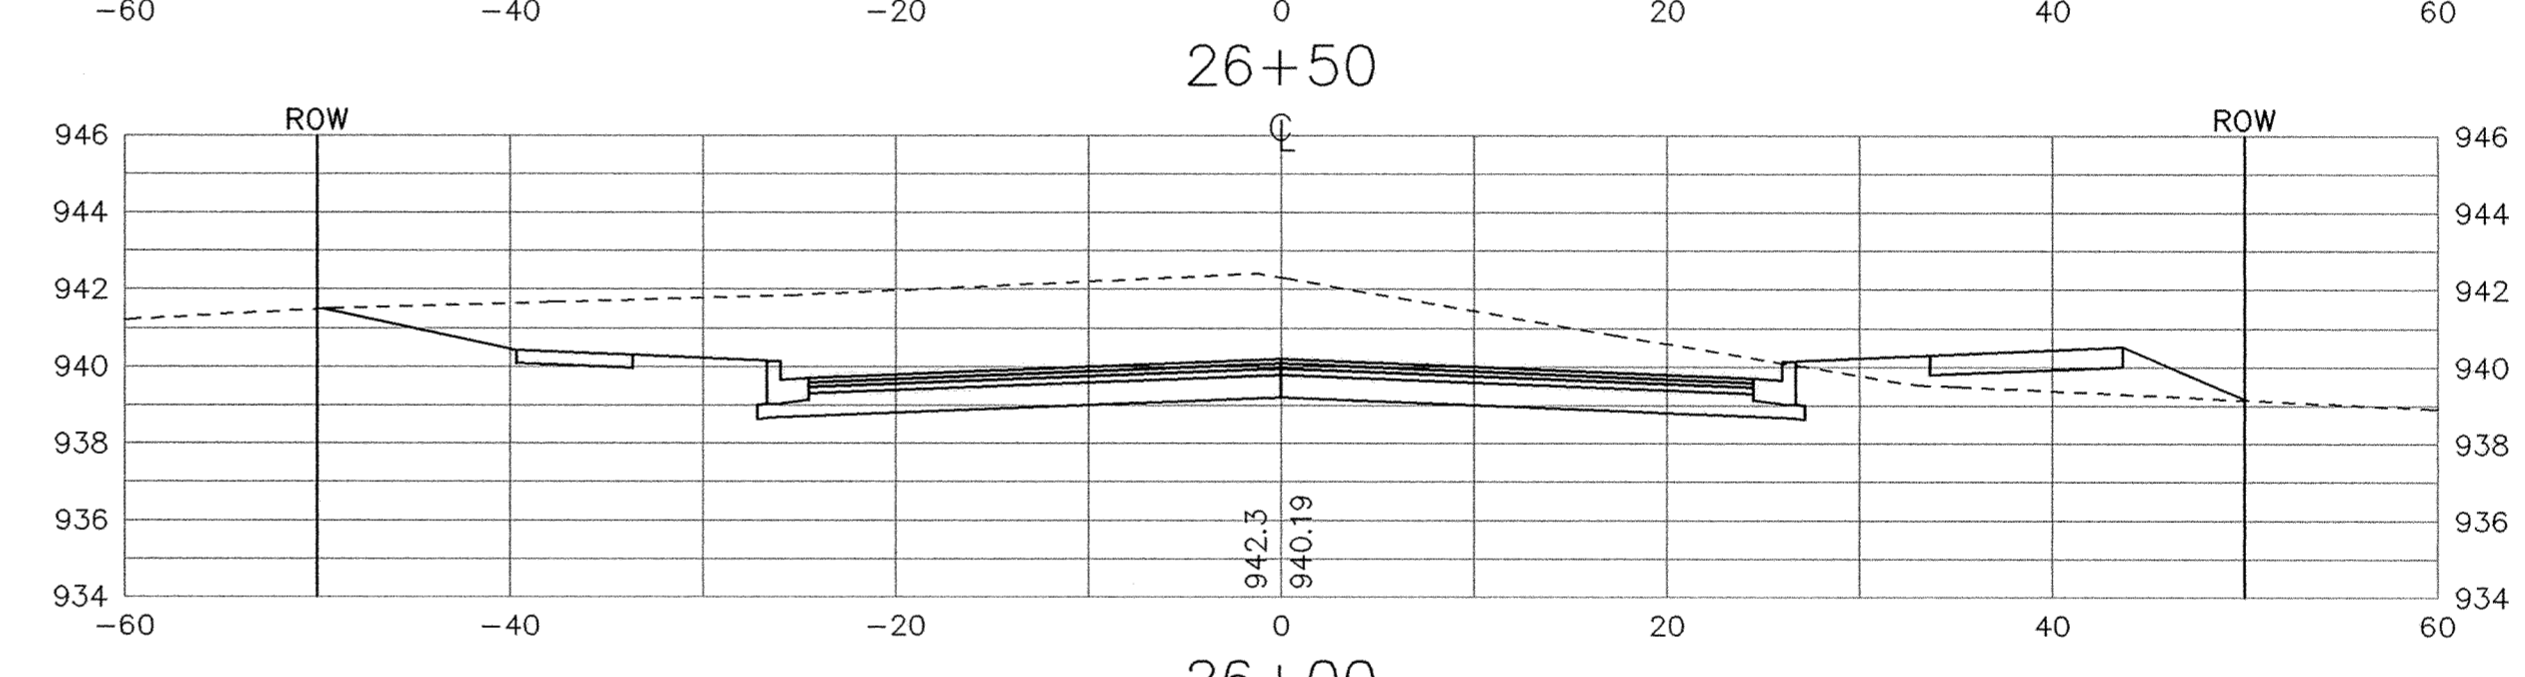
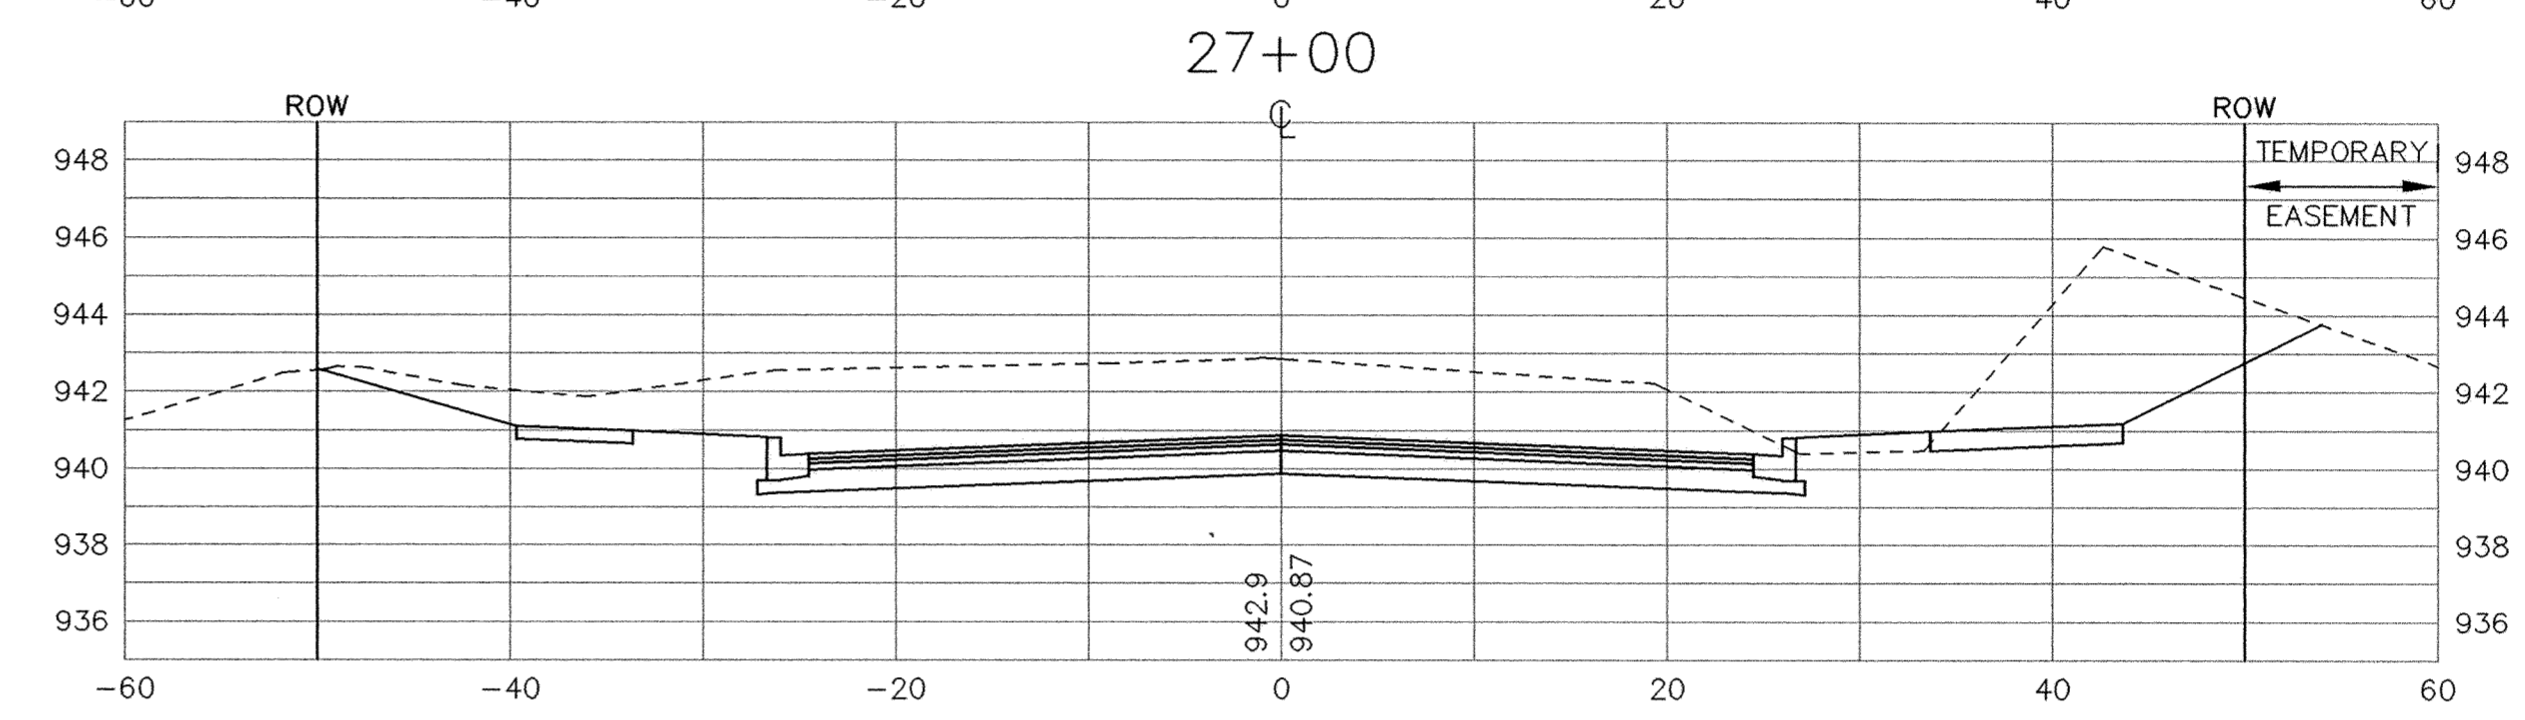
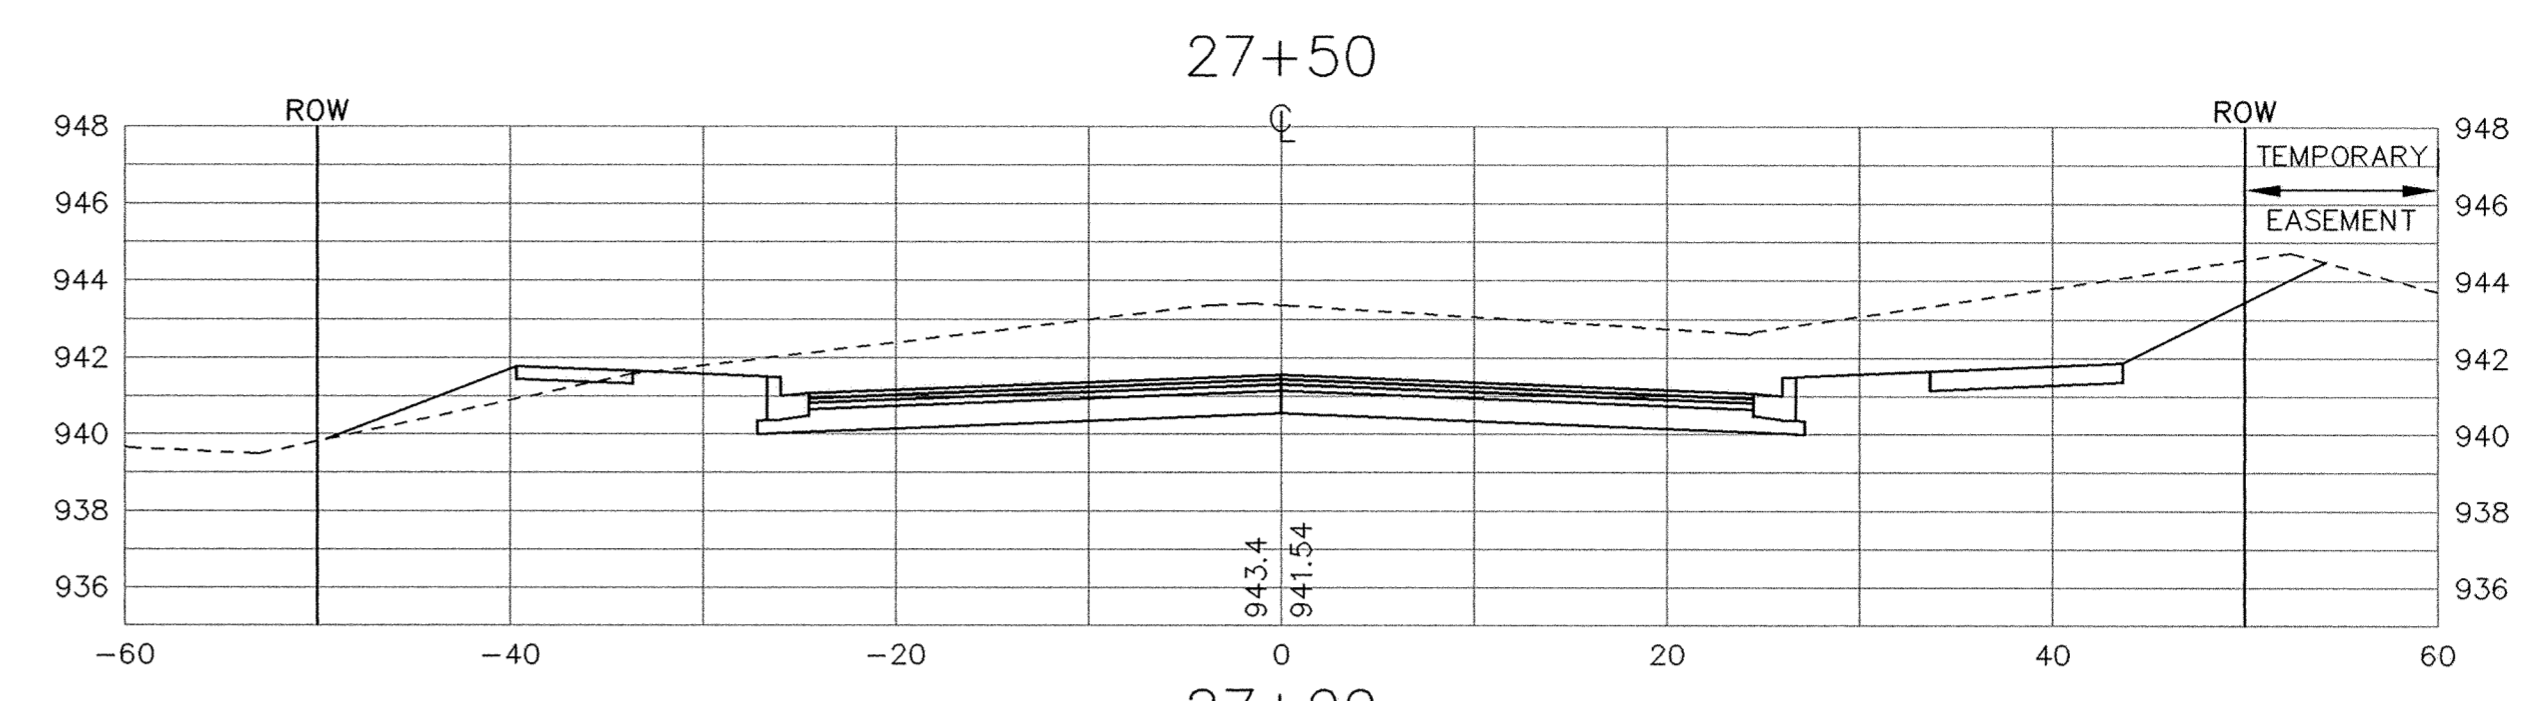
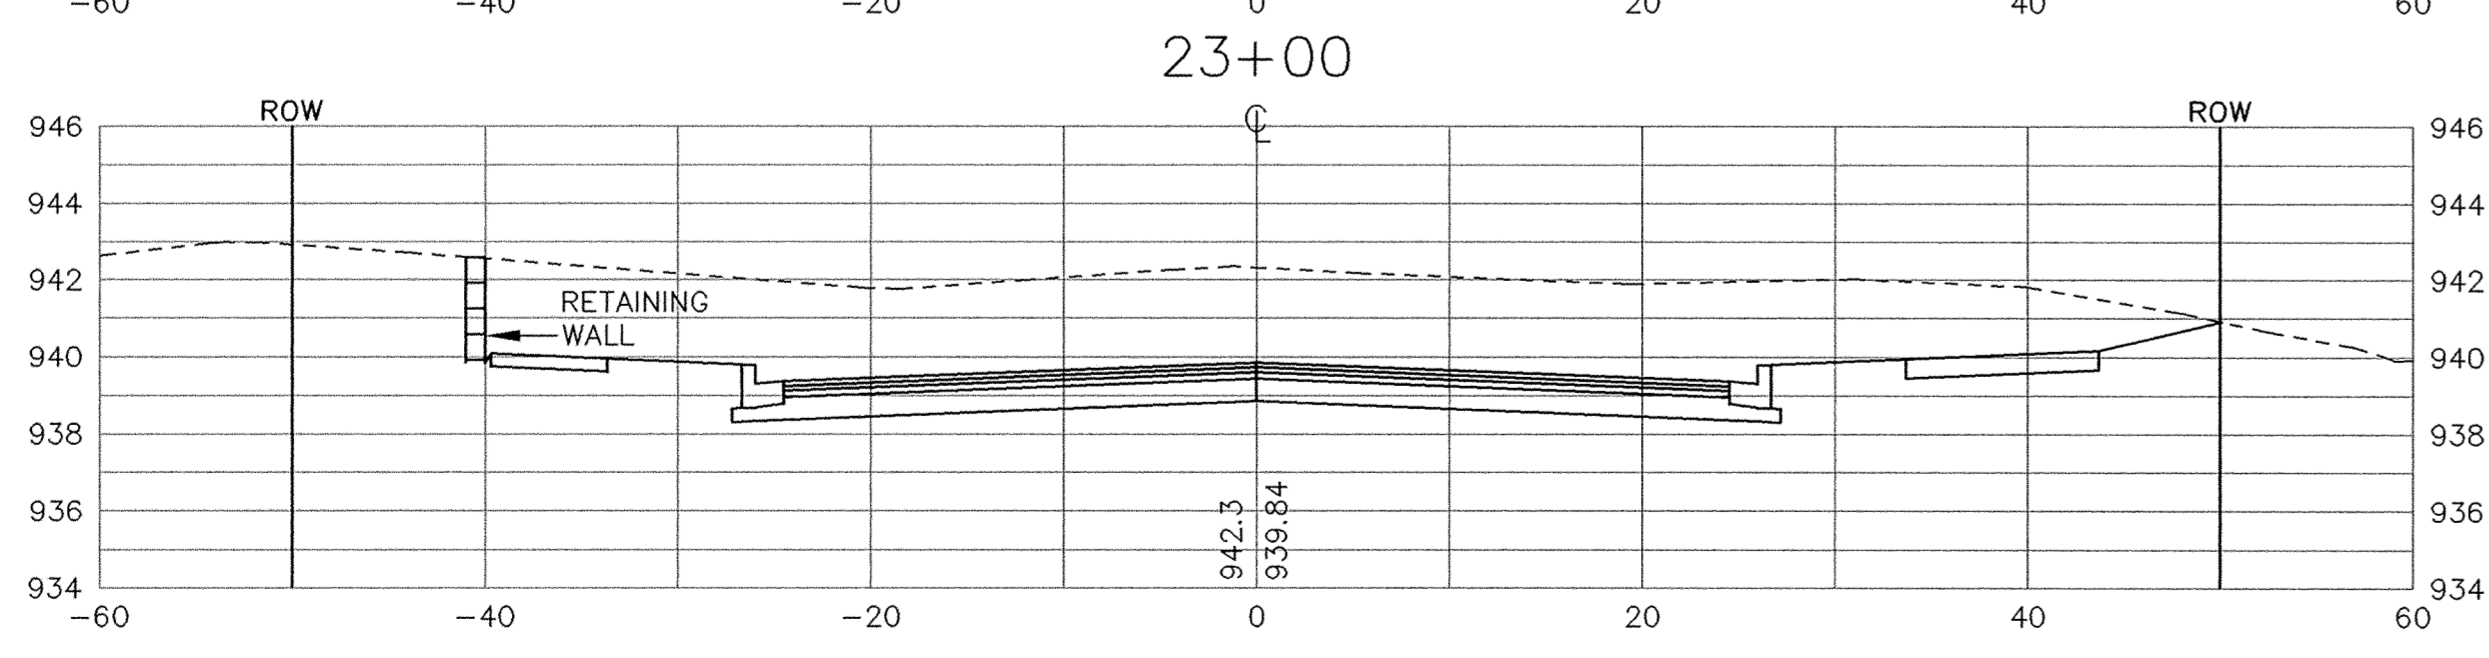
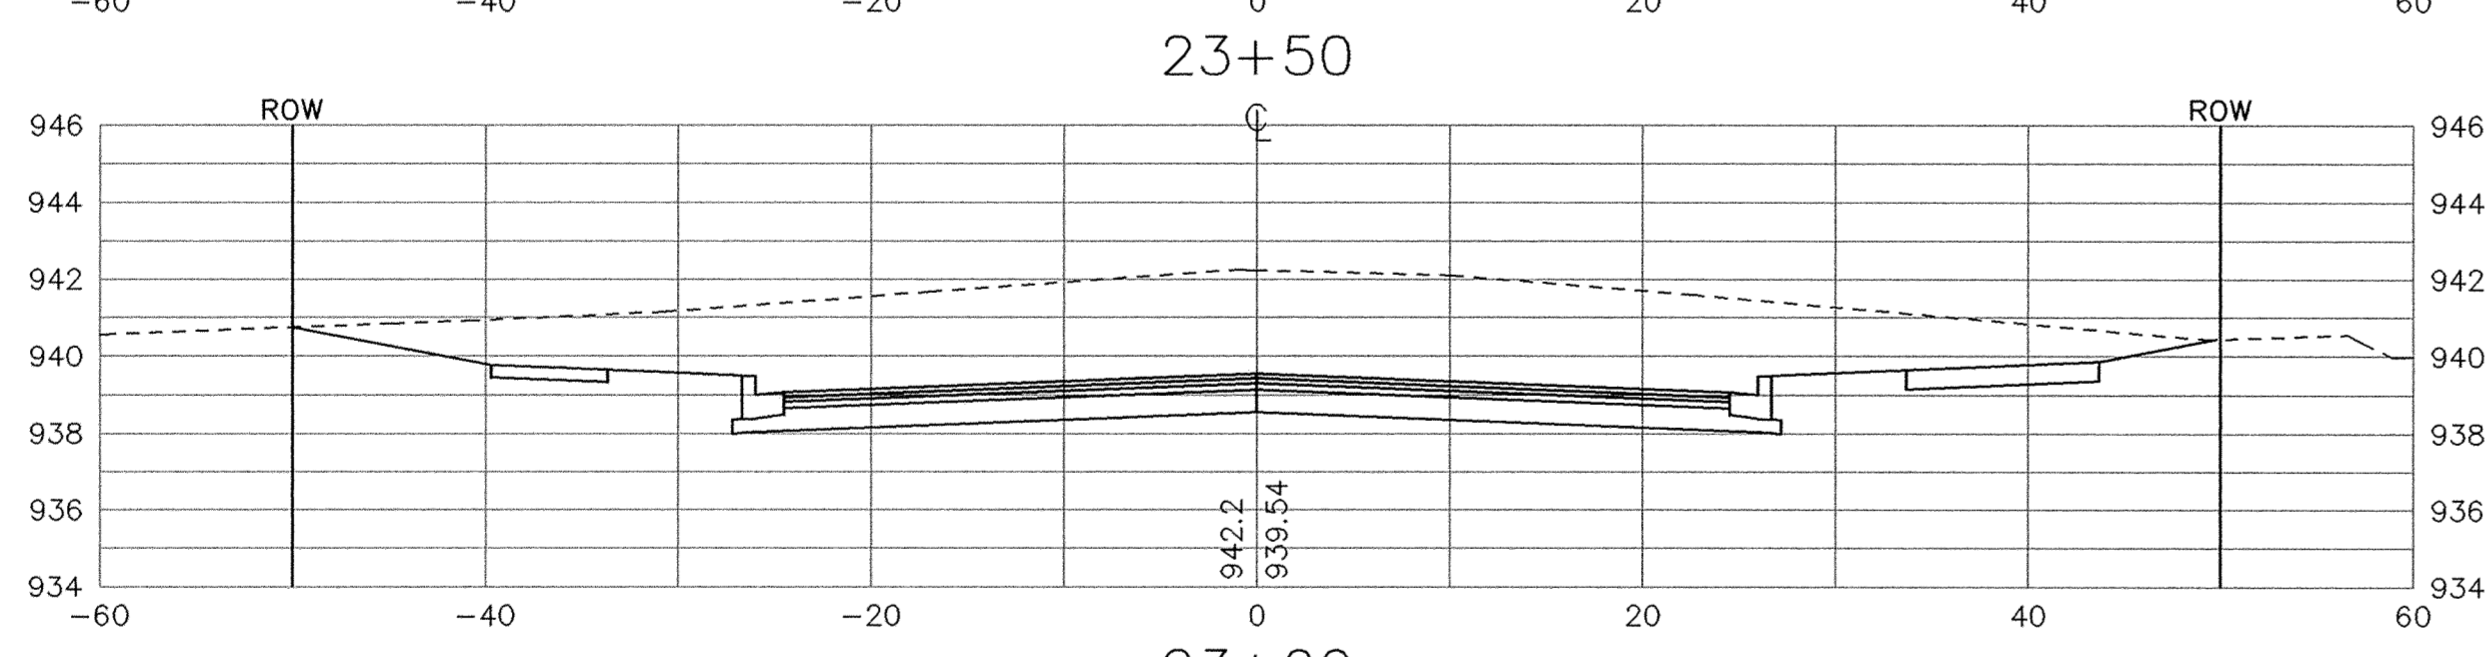
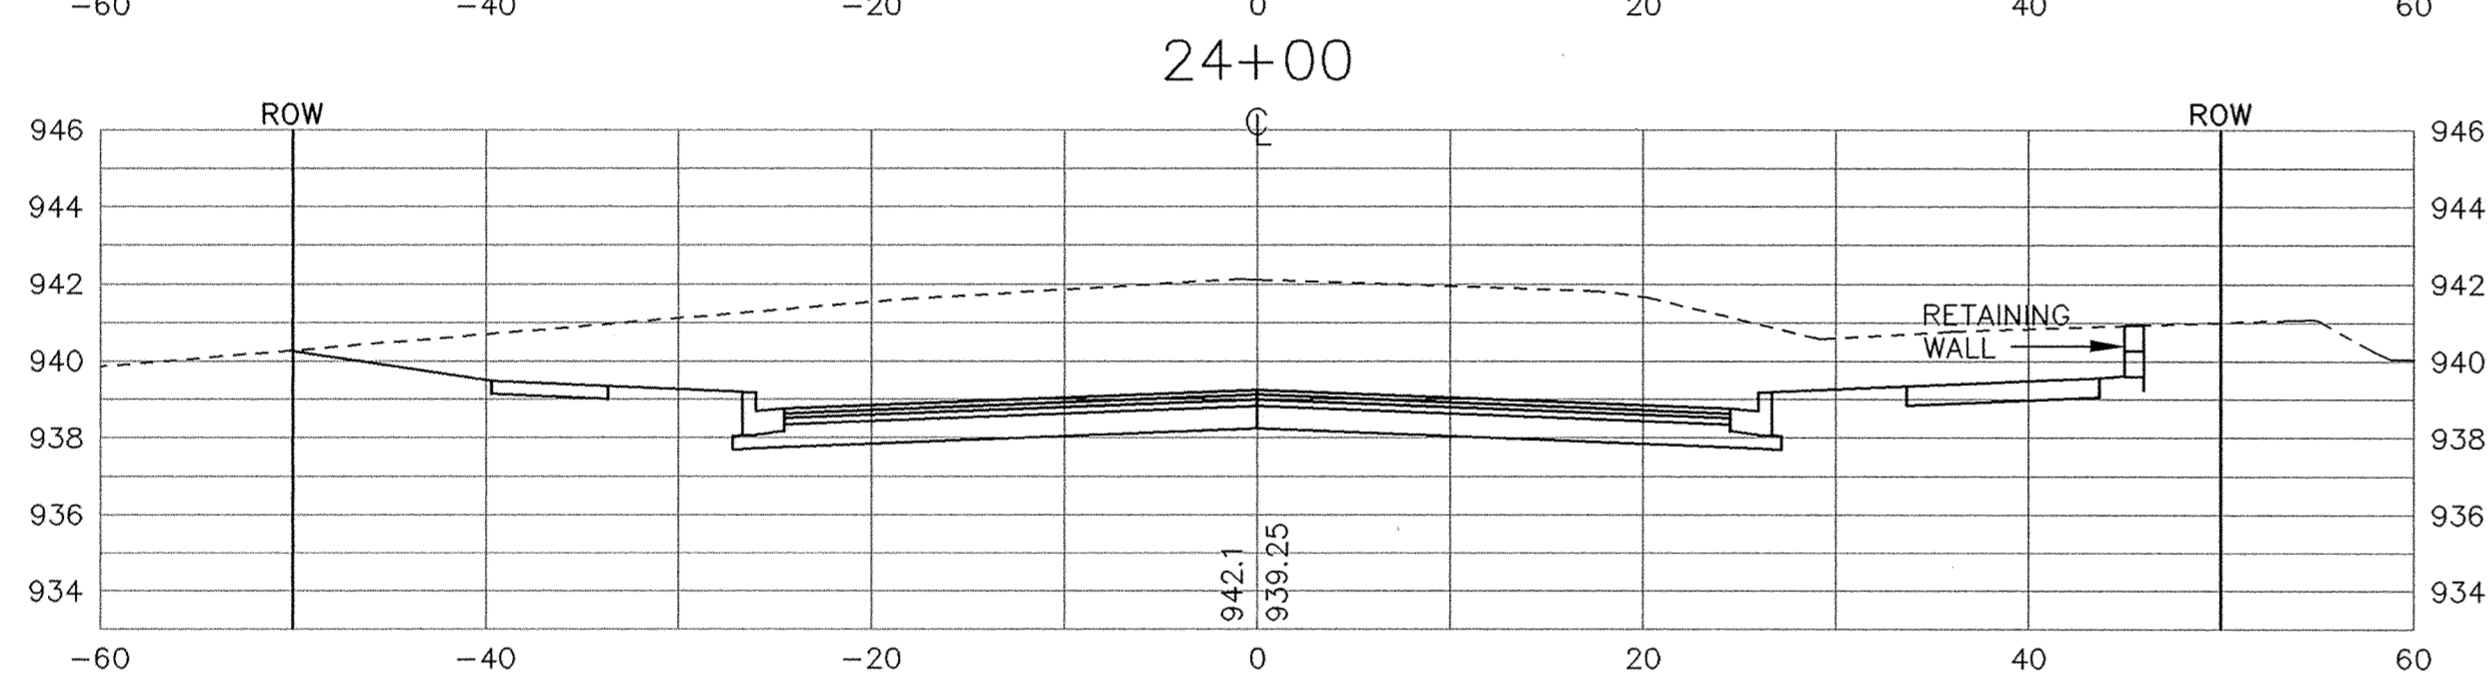


SAECO PRODUCTS • NEW HIRE, MINNESOTA
REPORT BY PART NUMBER 6532

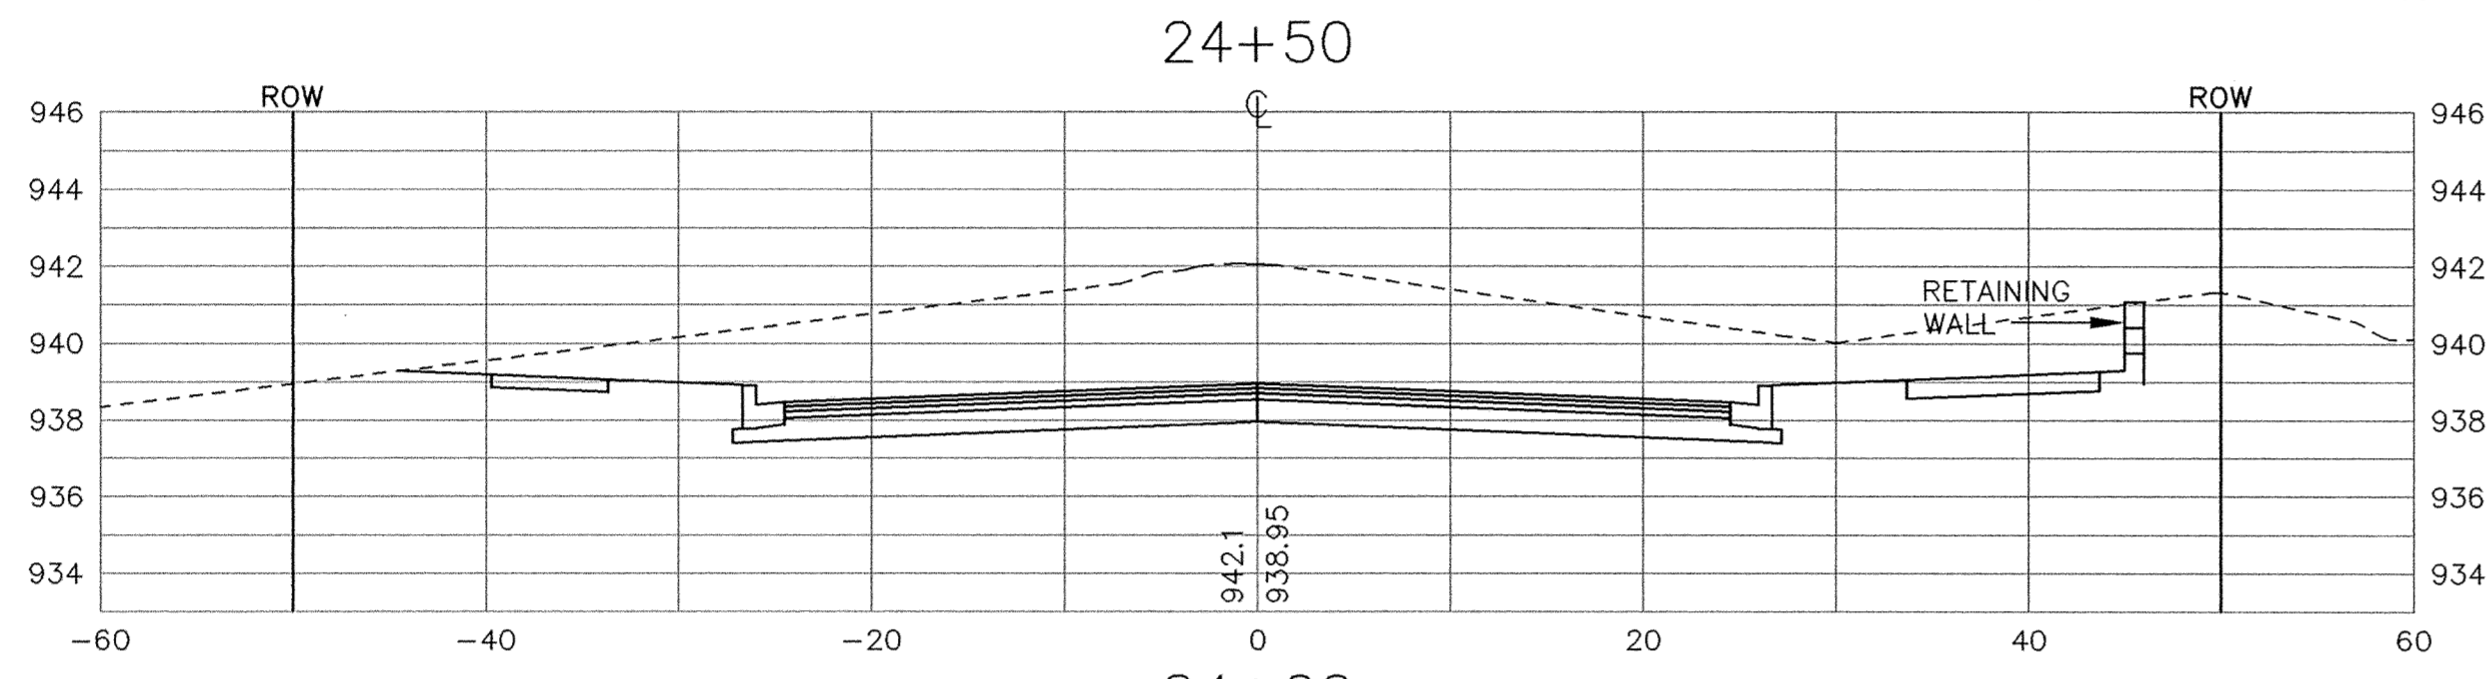

RECORD PLAN 1995

I HEREBY CERTIFY THAT THIS PLAN, SPECIFICATION, OR REPORT WAS PREPARED BY ME OR UNDER MY DIRECT SUPERVISION AND THAT I AM A DULY REGISTERED PROFESSIONAL ENGINEER UNDER THE LAWS OF THE STATE OF MINNESOTA.
Paul Baetzler
 DATE 4-29-94 REG. NO. 13929

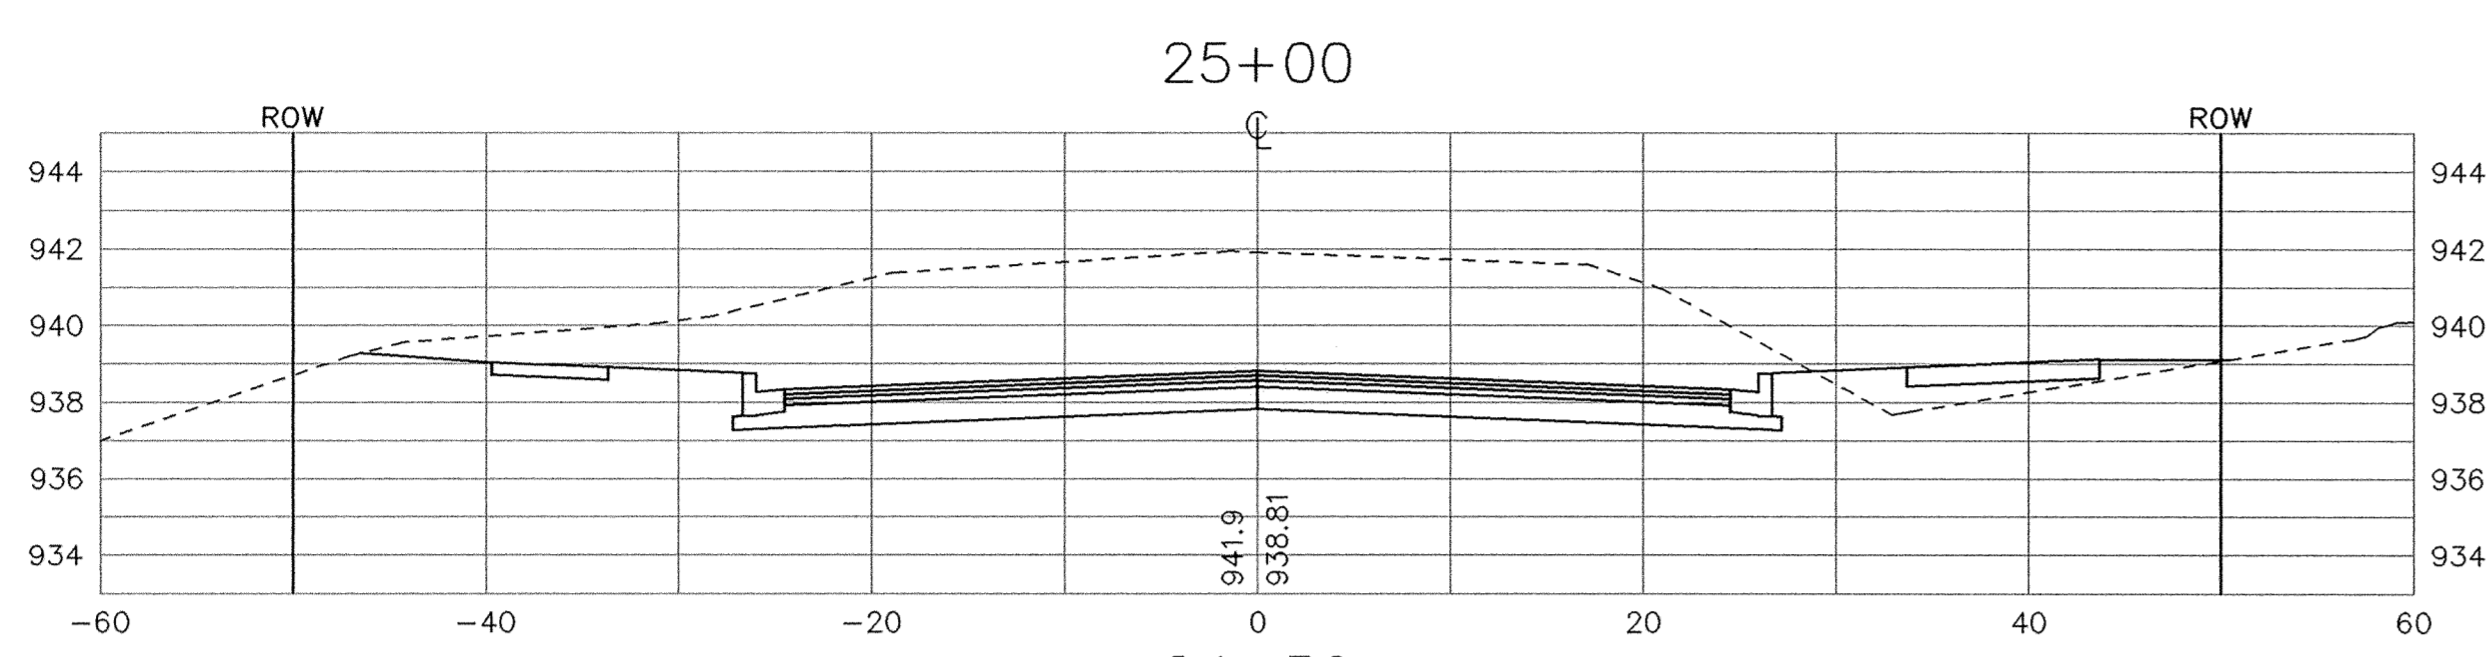

1326 ENERGY PARK DRIVE
 ST. PAUL, MINNESOTA 55108
 (612) 644-4389
 9800 SHELARD PARKWAY
 MINNEAPOLIS, MINNESOTA 55441
 (612) 546-0432

REVISIONS	DATE	DESCRIPTION	DESIGNED	PER
			PPB	
			CHECKED	
			DRAWN	

GRAPHIC SCALE
 0' HORIZ. 1" = 10'
 0' VERT. 1" = 5'

CITY OF ELK RIVER
 JACKSON AVENUE RECONSTRUCTION
 SCHOOL ST. TO T.H. 169
 S.A.P. 204-104-04 MTB 23+00 - 27+50
 DATE APRIL 1994 SHEET 38 OF 74 SHEETS PROJECT NO. 230-216