
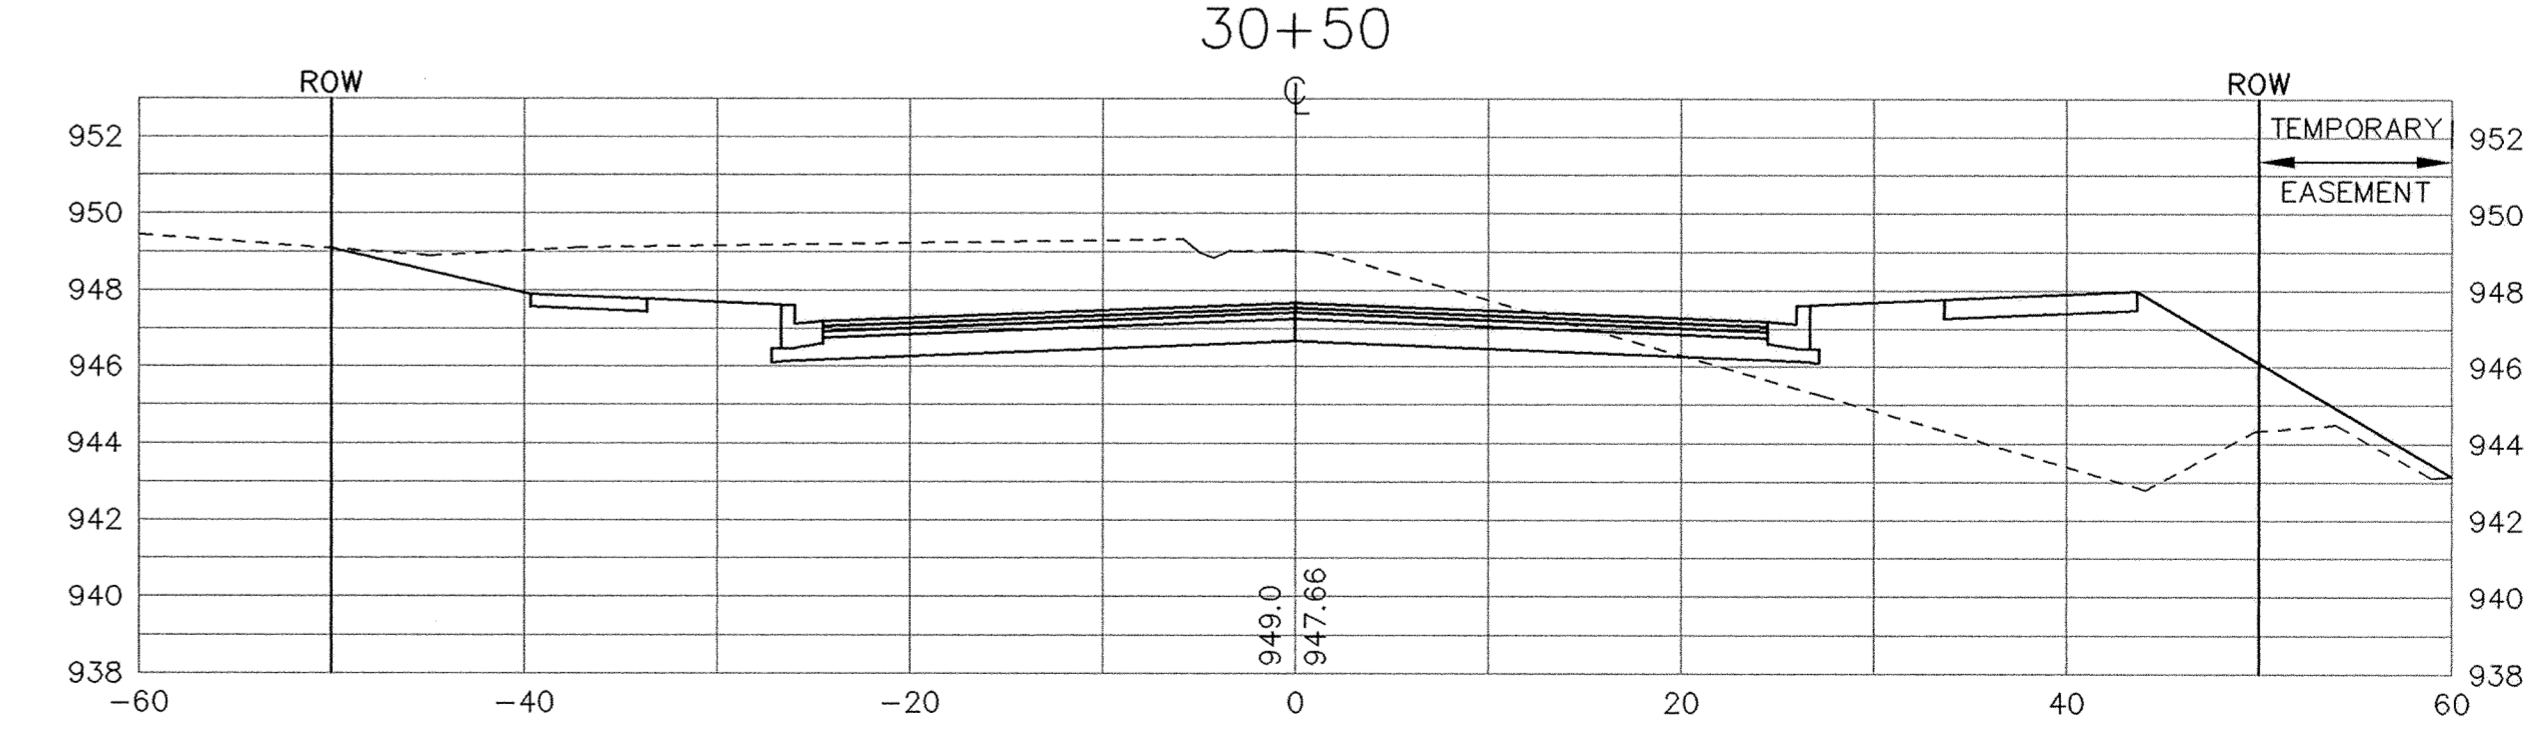
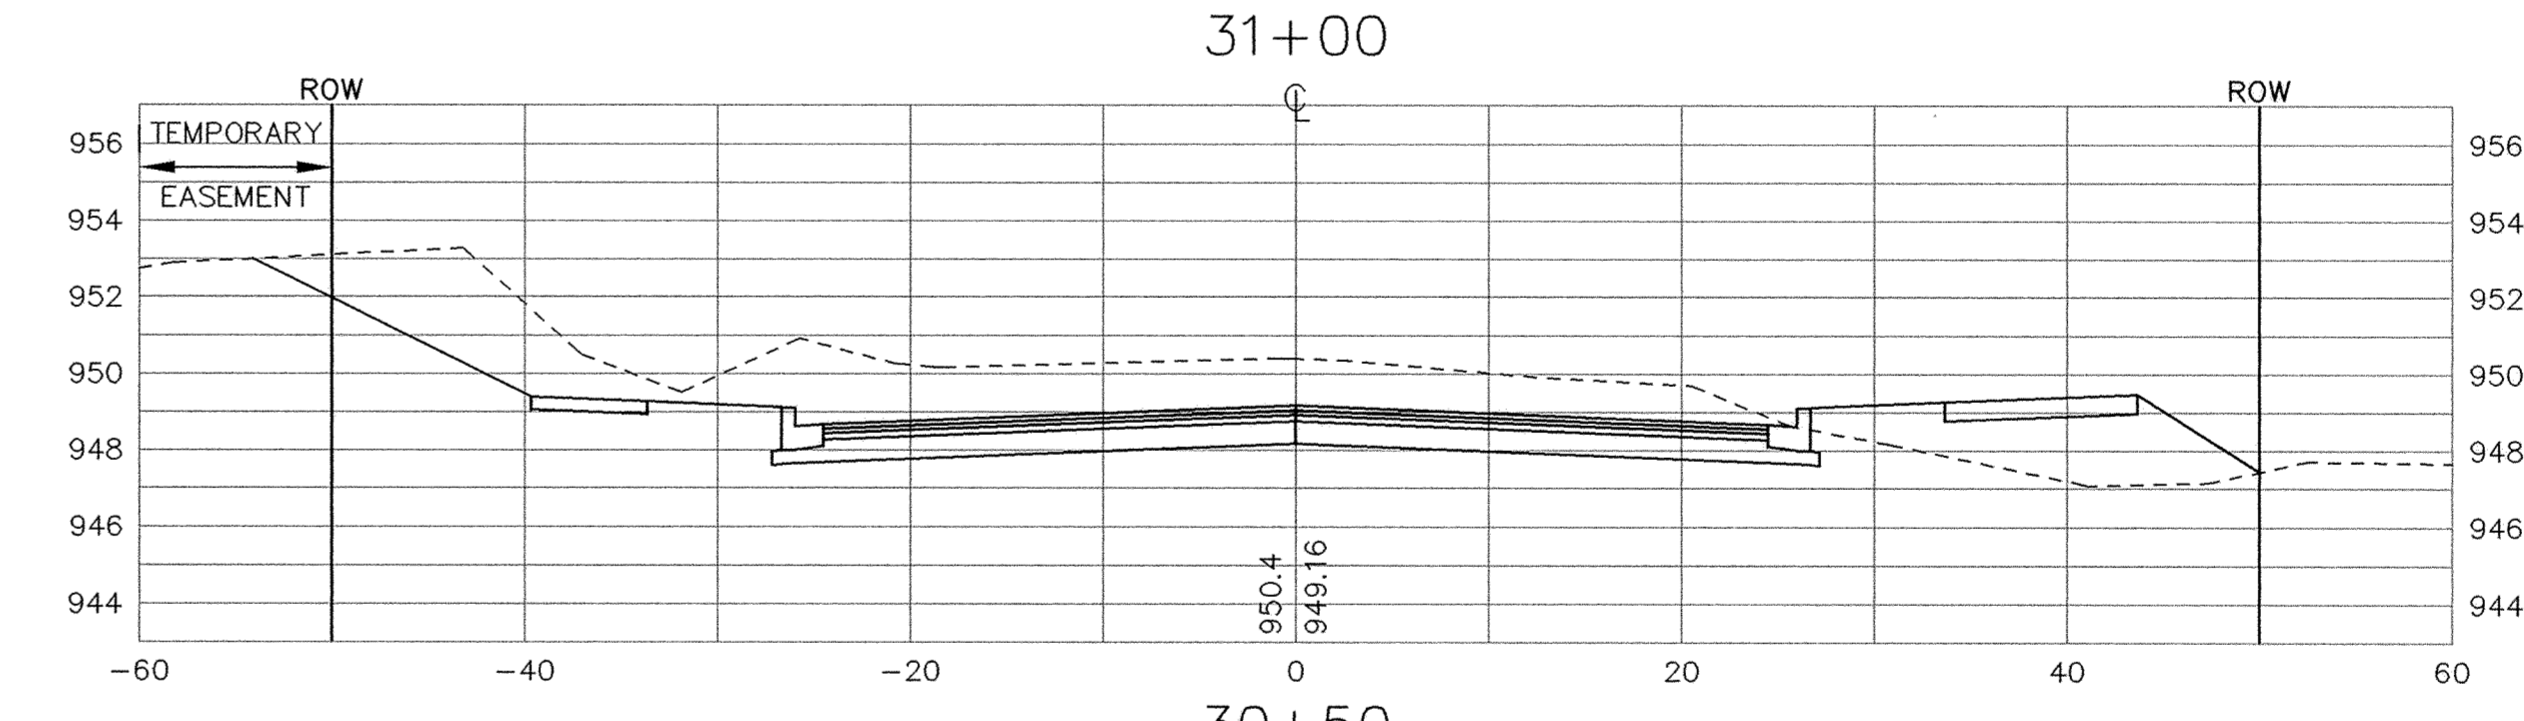
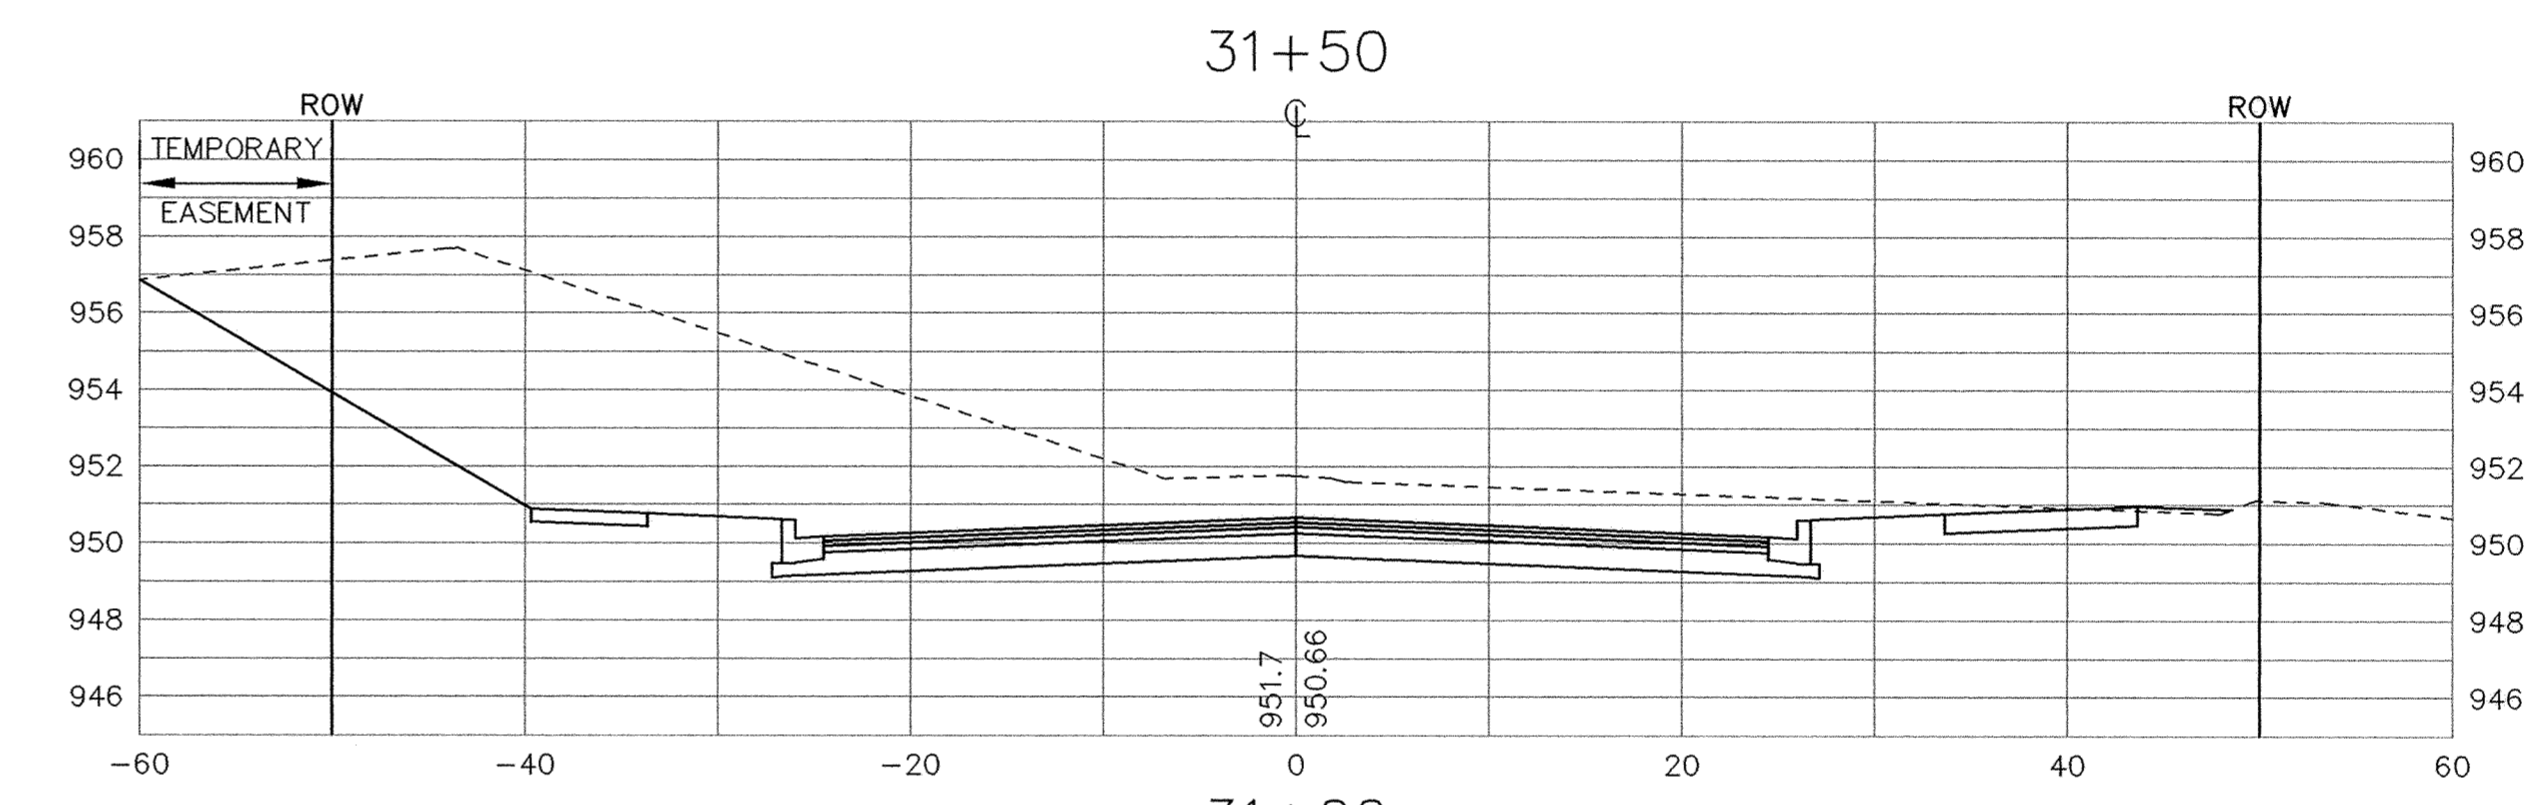
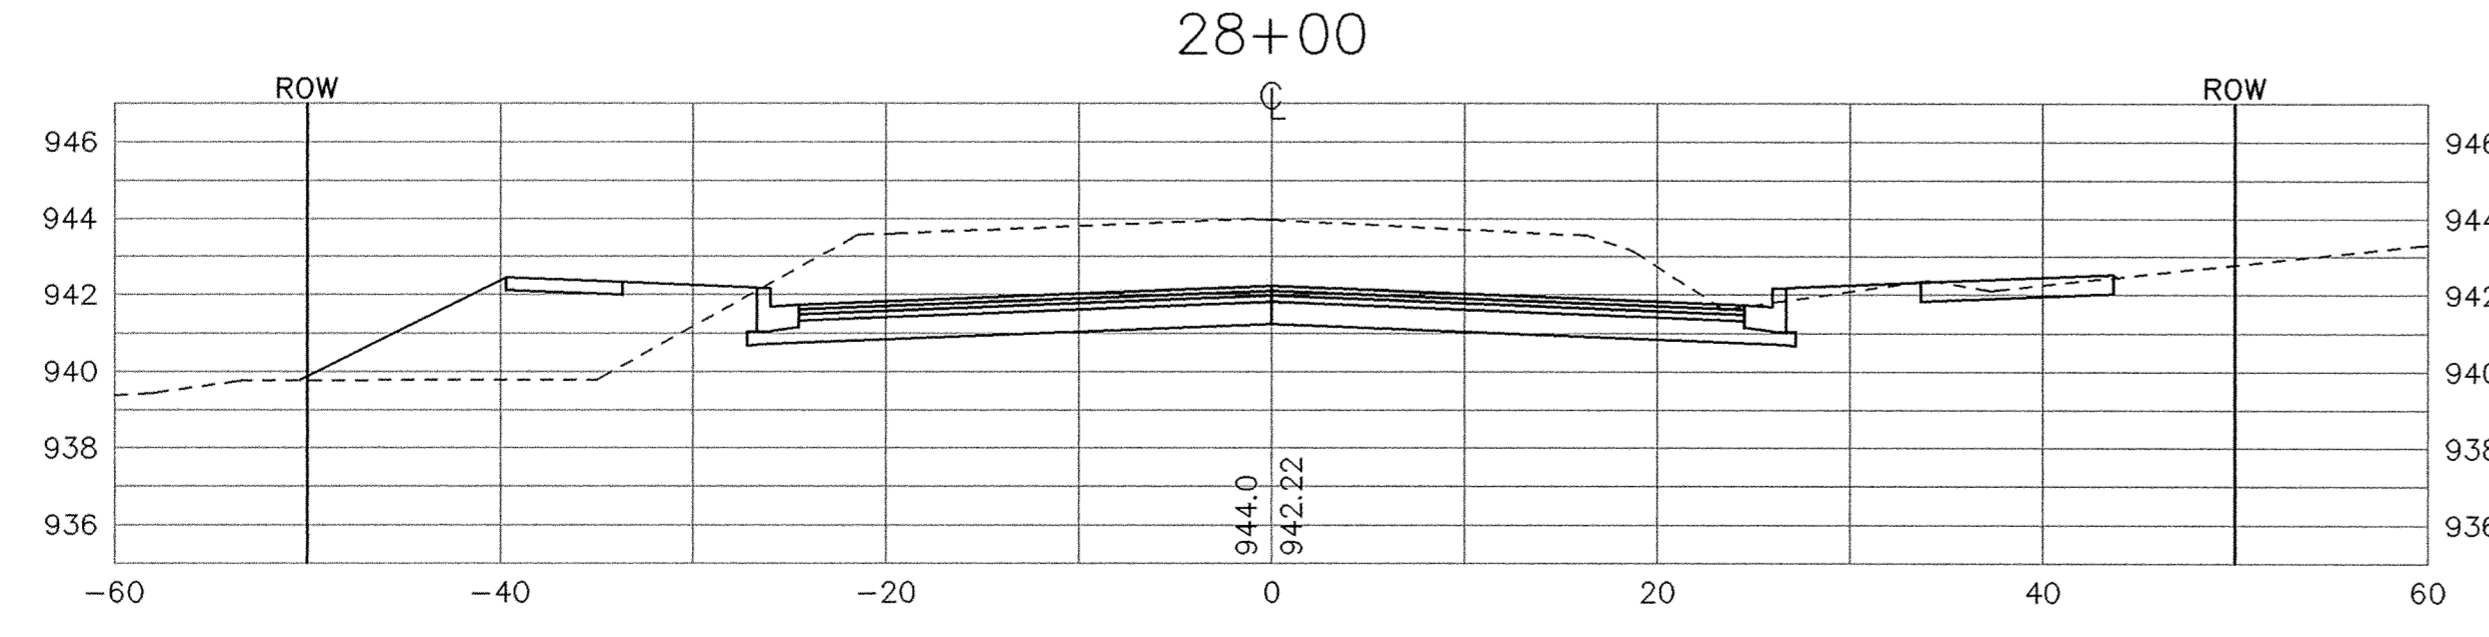
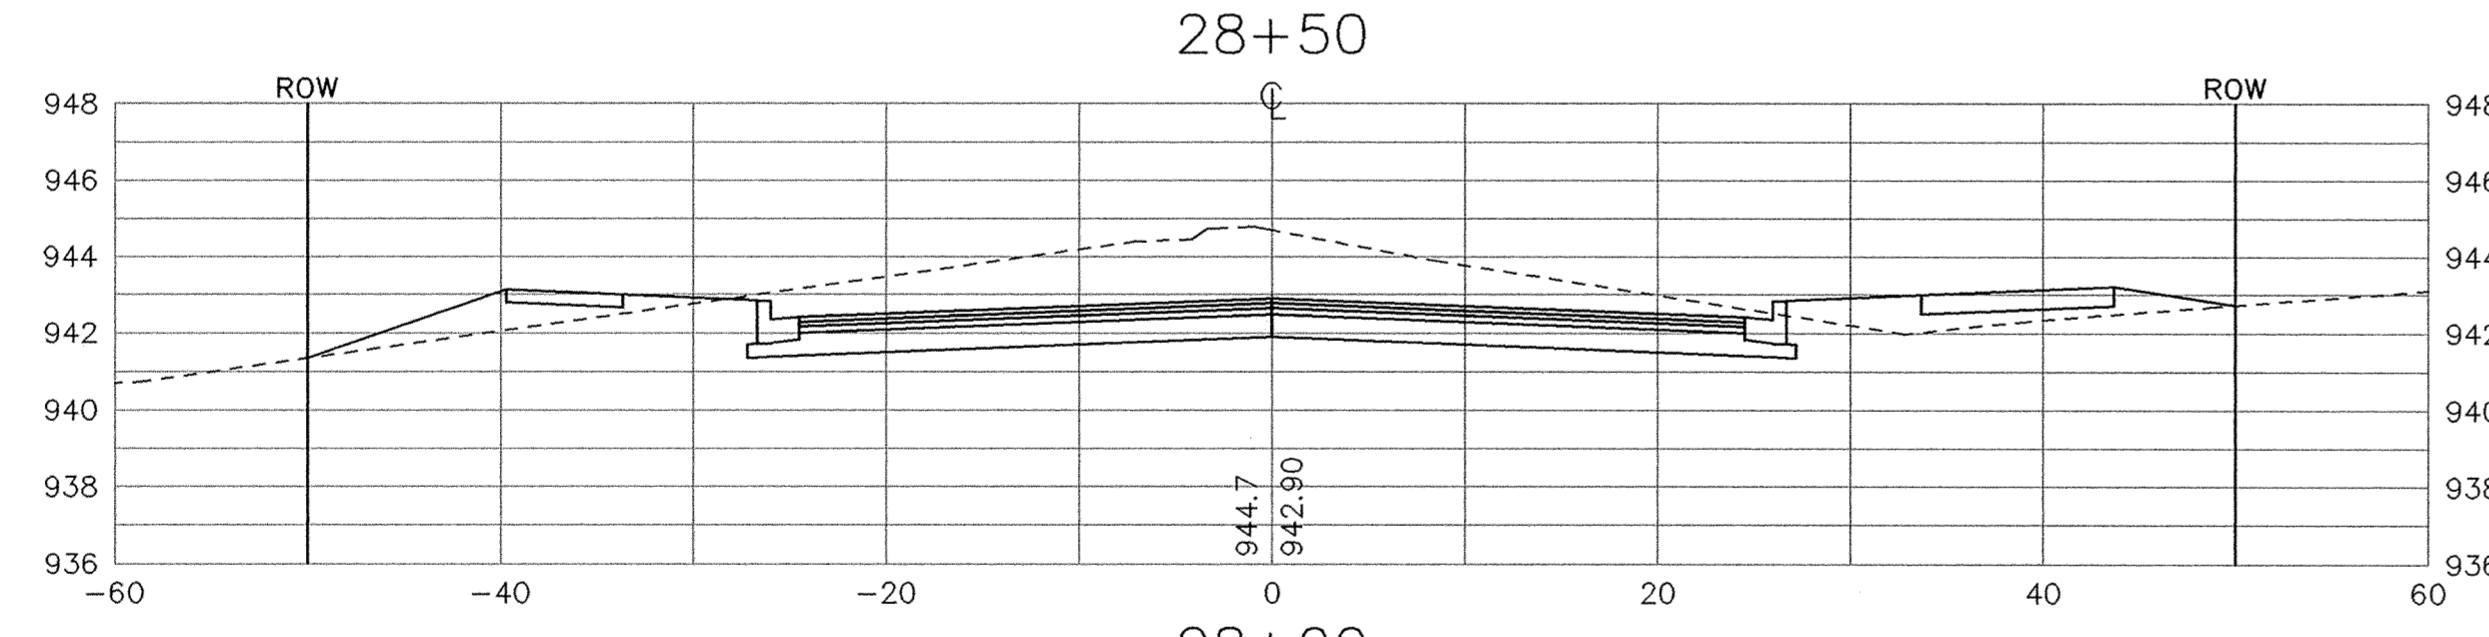
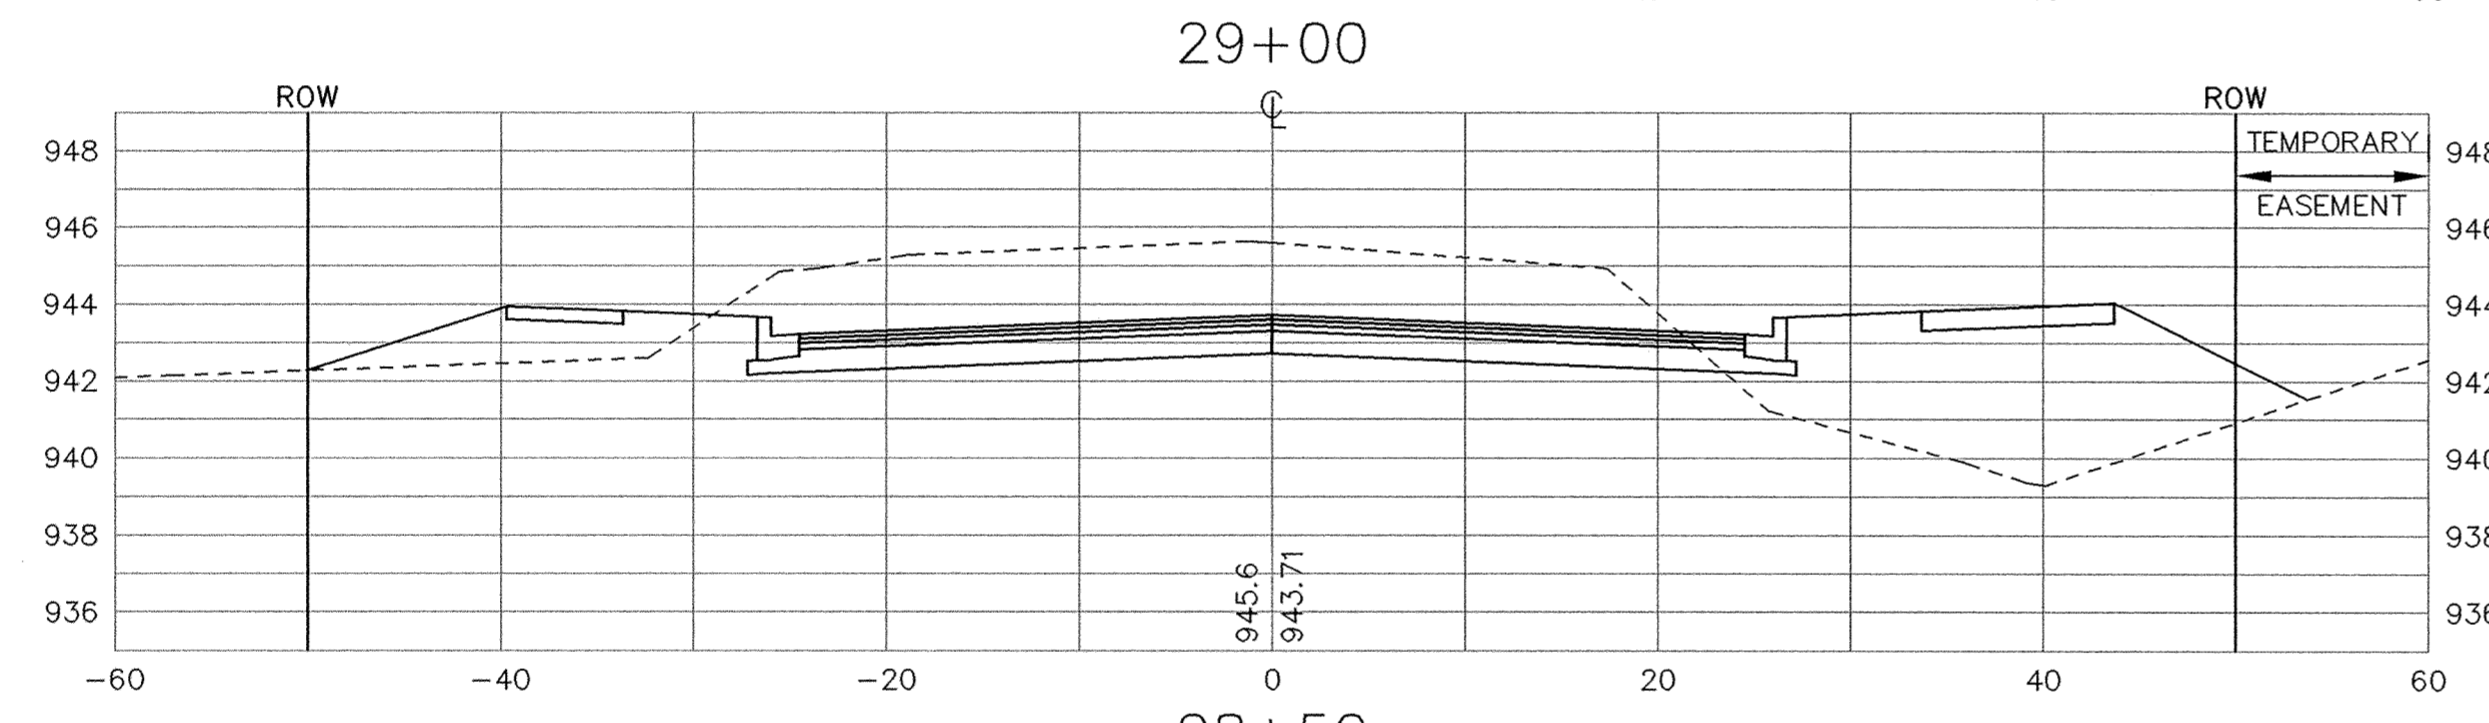
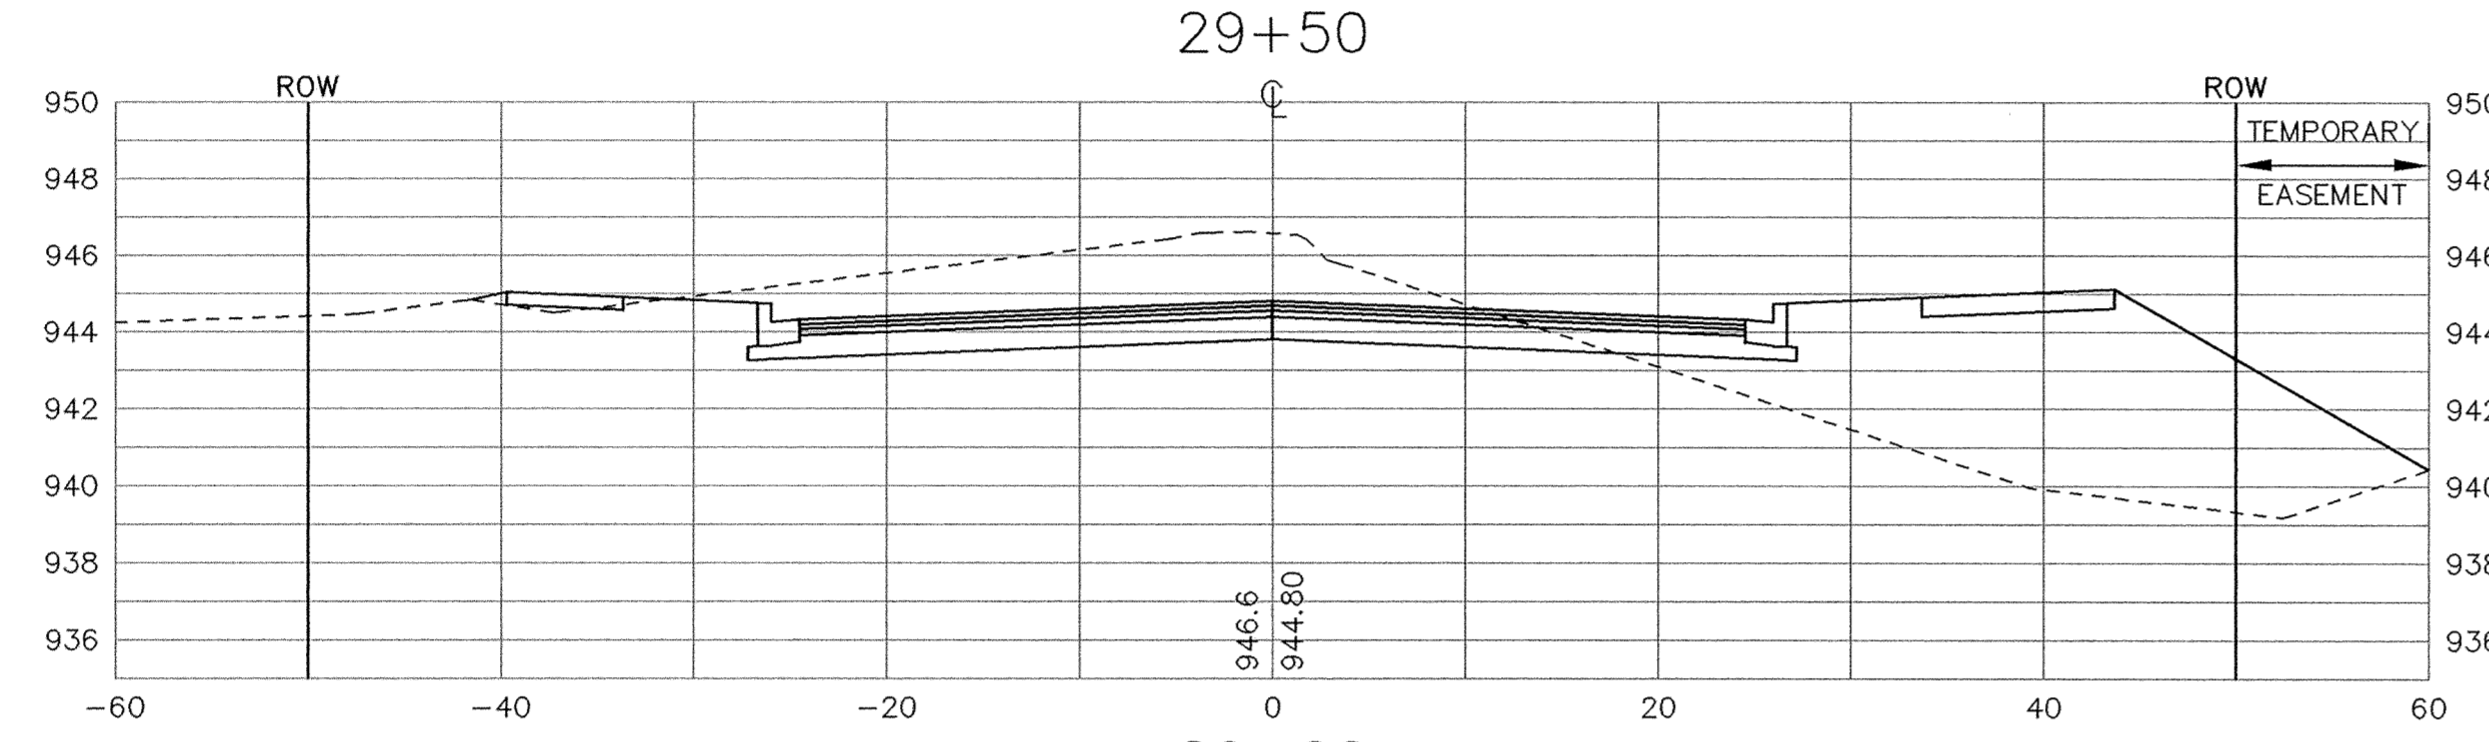


SAICO PRODUCTS • NEW HORIZON, MINNESOTA
RECORDED BY PART NUMBER 8582
SAICO PRODUCTS • NEW HORIZON, MINNESOTA
RECORDED BY PART NUMBER 8582
SAICO PRODUCTS • NEW HORIZON, MINNESOTA
RECORDED BY PART NUMBER 8582
SAICO PRODUCTS • NEW HORIZON, MINNESOTA
RECORDED BY PART NUMBER 8582

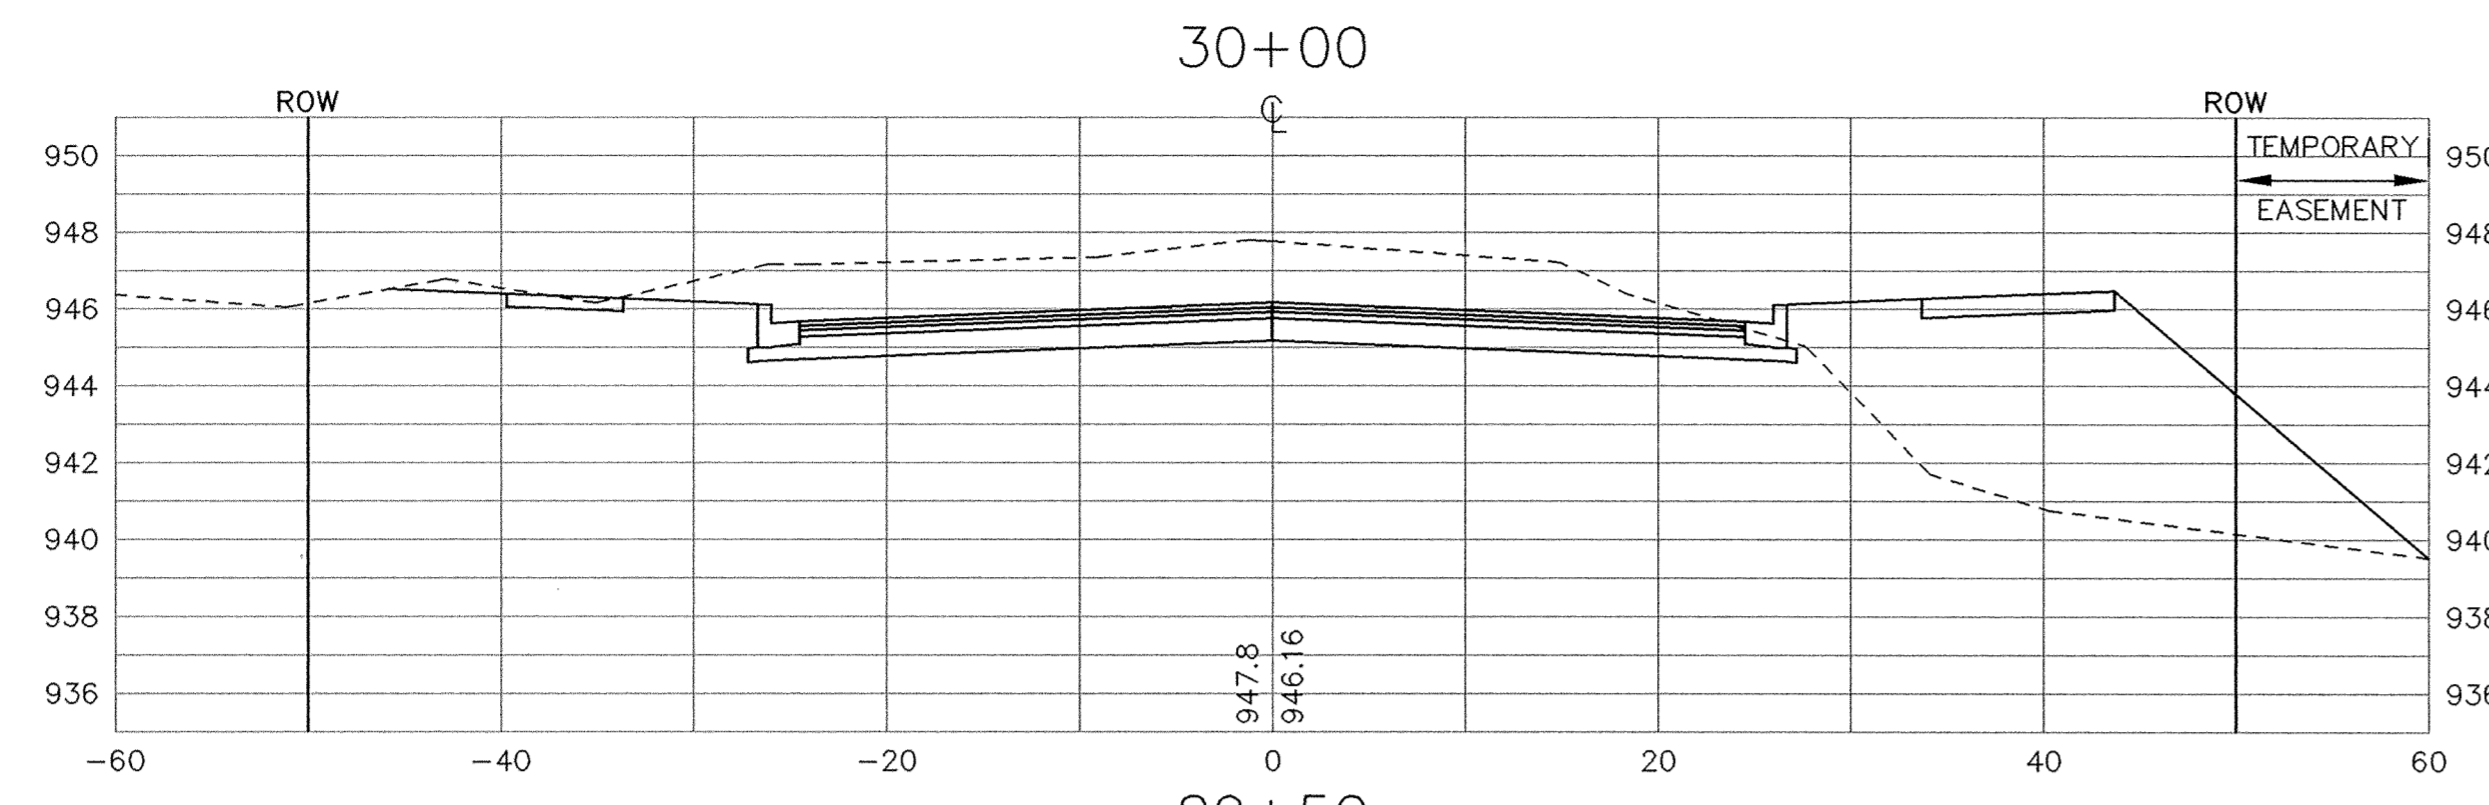

RECORD PLAN 1995

CITY OF ELK RIVER
JACKSON AVENUE RECONSTRUCTION
SCHOOL ST. TO T.H. 169
S.A.P. 204-104-04 MTB 28+00 - 31+50

DATE APRIL 1994 SHEET 39 OF 74 SHEETS PROJECT NO. 230-216

DATE	DESCRIPTION	DESIGNED	PER
		CHECKED	72
		DRAWN	

GRAPHIC SCALE	
HORIZ.	10
VERT.	5

1326 ENERGY PARK DRIVE
ST. PAUL, MINNESOTA 55108
(612) 644-4389

9800 SHELARD PARKWAY
MINNEAPOLIS, MINNESOTA 55441
(612) 546-0432



I HEREBY CERTIFY THAT THIS PLAN, SPECIFICATION, OR REPORT WAS PREPARED BY ME OR UNDER MY DIRECT SUPERVISION AND THAT I AM A DULY REGISTERED PROFESSIONAL ENGINEER UNDER THE LAWS OF THE STATE OF MINNESOTA.

Paul Paul
DATE 4-29-94 REG. NO. 13929