



STATION	AREAS Square Feet		VOLUMES Cubic Yards		CUMULATIVE VOLUMES Cubic Yards	
	CUT	FILL	CUT	FILL	CUT	FILL
0+00	51.20	25.79	126.15	72.27	126.15	72.27
0+50	85.04	52.26	175.83	92.58	301.99	164.85
1+00	104.86	47.72	245.74	50.96	547.72	215.81
1+50	160.54	7.32	307.61	26.36	855.33	242.17
2+00	171.68	21.15	331.52	21.61	1186.85	263.78
2+50	186.36	2.19	388.60	2.02	1575.45	265.81
3+00	233.32	0.00	345.00	5.61	1920.46	271.42
3+50	139.01	6.06	279.65	13.54	2200.11	284.96
4+00	162.75	8.63	323.83	8.12	2523.94	293.08
4+50	186.51	0.12	303.97	3.62	2827.91	296.70
5+00	141.41	3.78	268.73	5.89	3096.64	302.59
5+50	149.20	2.52	240.25	15.43	3336.89	318.02
6+00	110.76	13.83	185.85	18.57	3522.75	336.59
6+50	89.88	6.25	150.95	21.48	3673.69	358.07
7+00	72.97	16.98	113.54	60.47	3787.23	418.54
7+50	49.56	48.15	96.61	116.13	3883.85	534.67
8+00	54.93	77.49	106.94	122.28	3990.78	656.95
8+50	60.93	54.64	126.24	131.07	4117.03	788.02
9+00	75.47	86.96	149.32	87.96	4266.34	875.98
9+50	85.63	8.16	139.72	94.55	4406.07	970.53
10+00	65.23	93.83	87.95	153.46	4494.02	1123.99
10+50	29.93	71.25	80.80	144.69	4574.83	1268.68
11+00	57.50	84.90	126.40	137.76	4701.22	1406.45
11+50	79.01	63.88	171.59	101.34	4872.82	1507.78
12+00	106.31	45.56	216.46	70.20	5089.28	1577.99
12+50	127.47	30.26	252.33	37.05	5341.61	1615.04
13+00	145.04	9.76	330.37	9.04	5671.98	1624.07
13+50	211.76	0.00	415.89	0.02	6087.86	1624.09
14+00	237.39	0.02	483.73	0.02	6571.59	1624.11
14+50	285.03	0.00	467.93	0.00	7039.53	1624.11
15+00	220.33	0.00	447.39	0.00	7486.92	1624.11
15+50	262.85	0.00	447.92	0.00	7934.84	1624.11
16+00	220.91	0.00	391.47	0.00	8326.31	1624.11
16+50	201.88	0.00	303.77	1.69	8630.08	1625.79
17+00	126.20	1.82	232.83	1.69	8862.91	1627.48
17+50	125.26	0.00	192.59	1.97	9055.50	1629.45
18+00	82.74	2.13	136.78	17.63	9192.29	1647.08
18+50	64.98	16.90	118.95	33.81	9311.24	1680.89
19+00	63.48	19.61	132.34	26.74	9443.58	1707.63
19+50	79.45	9.28	144.59	22.50	9588.17	1730.13
20+00	76.71	15.02	170.35	13.94	9758.52	1744.07
20+50	107.27	0.04	220.06	0.75	9978.58	1744.81
21+00	130.40	0.77	331.84	0.72	10310.42	1745.53
21+50	227.99	0.00	408.67	0.00	10719.09	1745.53
22+00	213.37	0.00	448.09	0.00	11167.17	1745.53
22+50	270.56	0.00	491.33	0.00	11658.50	1745.53
23+00	260.07	0.00	471.27	0.00	12129.78	1745.53
23+50	248.90	0.00	472.88	0.00	12602.65	1745.53
24+00	261.80	0.00	458.04	0.00	13060.69	1745.53
24+50	232.88	0.00	424.59	8.36	13485.28	1753.89
25+00	225.68	9.03	369.74	14.06	13855.02	1767.95
25+50	173.64	6.16	347.51	6.42	14202.53	1774.37
26+00	201.48	0.83	346.45	11.76	14548.98	1786.13
26+50	172.37	11.97	370.21	13.92	14919.20	1800.06
27+00	227.34	3.17	385.00	7.76	15304.20	1807.82
27+50	189.24	5.20	299.99	38.98	15604.19	1846.80
28+00	135.21	36.59	229.45	52.59	15833.64	1899.39
28+50	112.57	19.98	227.53	110.07	16061.17	2009.46
29+00	133.04	98.99	198.75	219.88	16465.43	2435.73
29+50	88.72	125.18	233.37	186.60	16698.81	2622.33
30+00	125.74	113.94	263.31	109.02	16962.11	2731.34
30+50	125.82	88.89	422.38	27.71	17384.50	2759.05
31+00	157.86	29.65	399.07	7.26	17783.57	2766.31
31+50	296.64	0.50	212.16	74.28	17995.73	2840.59
32+00	133.25	7.34	129.03	165.69	18124.76	3006.28
32+50	95.88	72.88	77.05	173.04	18201.81	3179.32
33+00	43.47	106.06	99.19	97.79	18301.00	3277.12
33+50	39.75	80.83	120.59	42.08	18421.59	3319.19
34+00	67.37	24.79	0.00	0.00	18421.59	3319.19

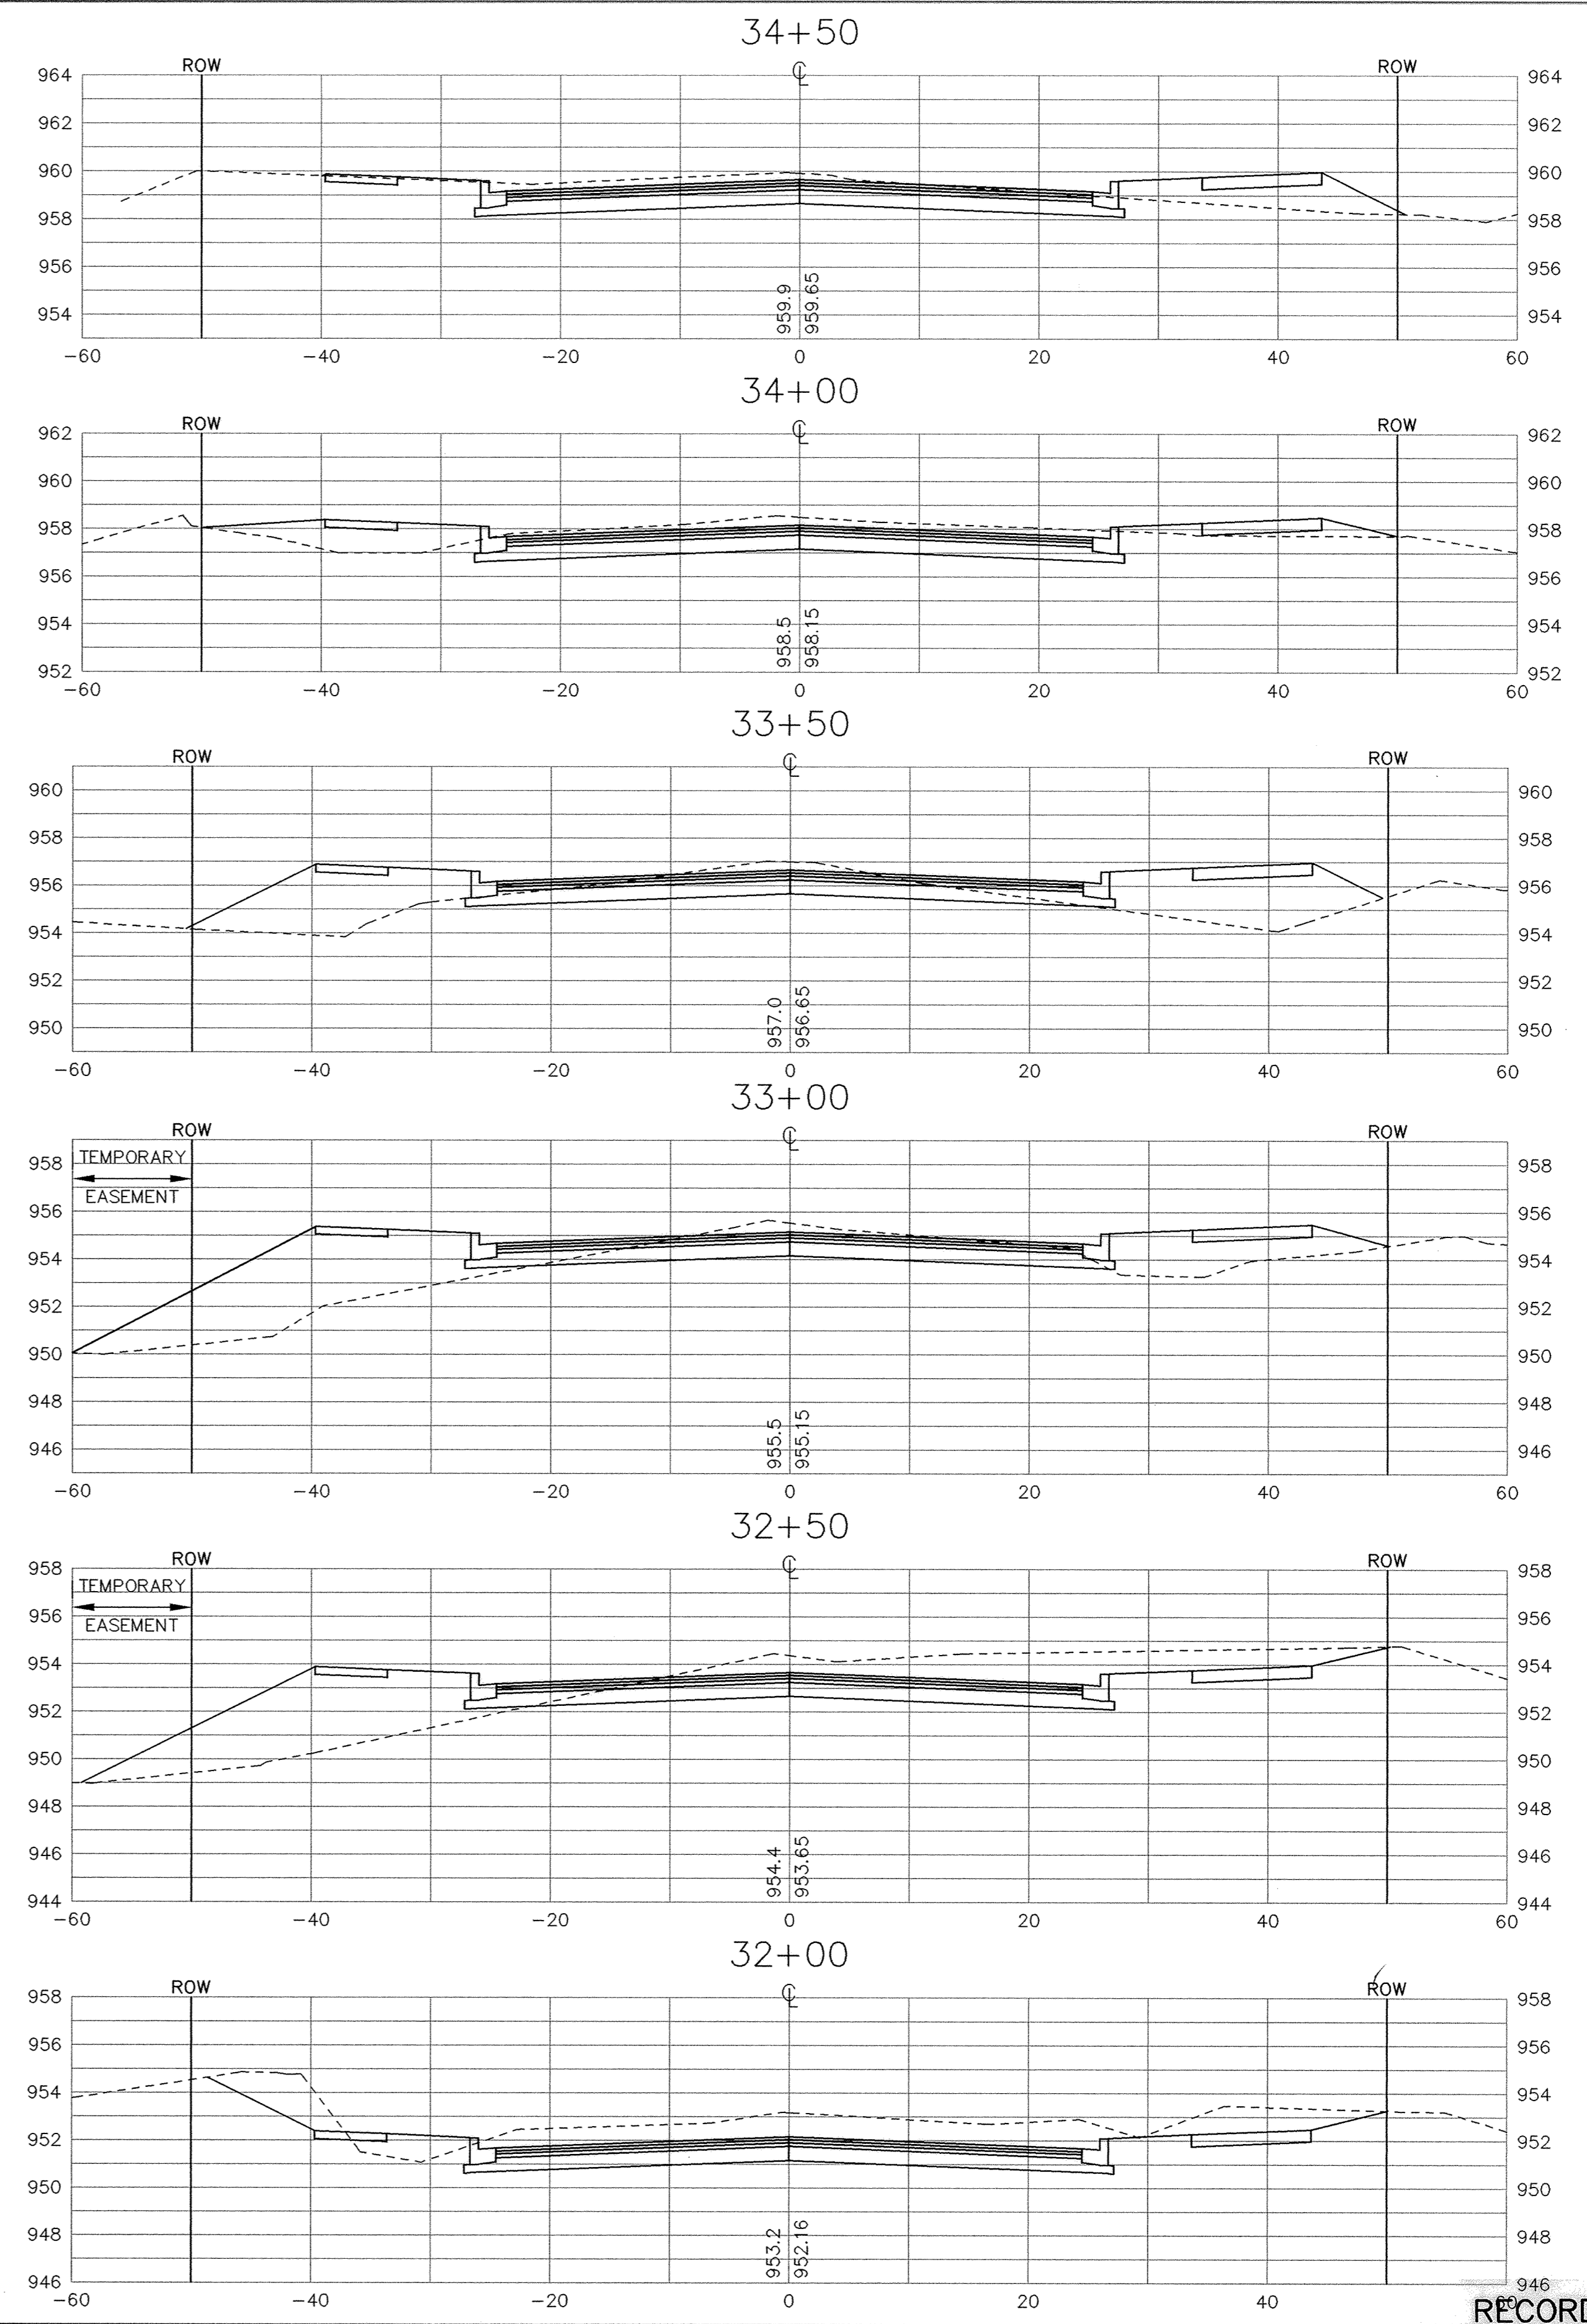

RECORD PLAN 1995

I HEREBY CERTIFY THAT THIS PLAN, SPECIFICATION, OR REPORT WAS PREPARED BY ME OR UNDER MY DIRECT SUPERVISION AND THAT I AM A DULY REGISTERED PROFESSIONAL ENGINEER UNDER THE LAWS OF THE STATE OF MINNESOTA.

Paul Foch
DATE: 4-29-94 REG. NO. 13929

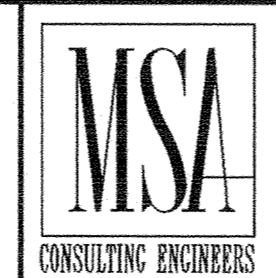

1326 ENERGY PARK DRIVE
ST. PAUL, MINNESOTA 55108
(612) 644-4389

9800 SHELARD PARKWAY
MINNEAPOLIS, MINNESOTA 55441
(612) 546-0432

DATE	DESCRIPTION	DESIGNED	PER
		CHECKED	PP
		DRAWN	

GRAPHIC SCALE
0 10
L HORIZ. 10
0 5
L VERT. 5

CITY OF ELK RIVER
JACKSON AVENUE RECONSTRUCTION
SCHOOL ST. TO T.H. 169
S.A.P. 204-104-04 MTB 32+00 - 34+50

DATE: APRIL 1994 SHEET: 40 OF 74 SHEETS PROJECT NO.: 230-216