



FREEPORT AVENUE

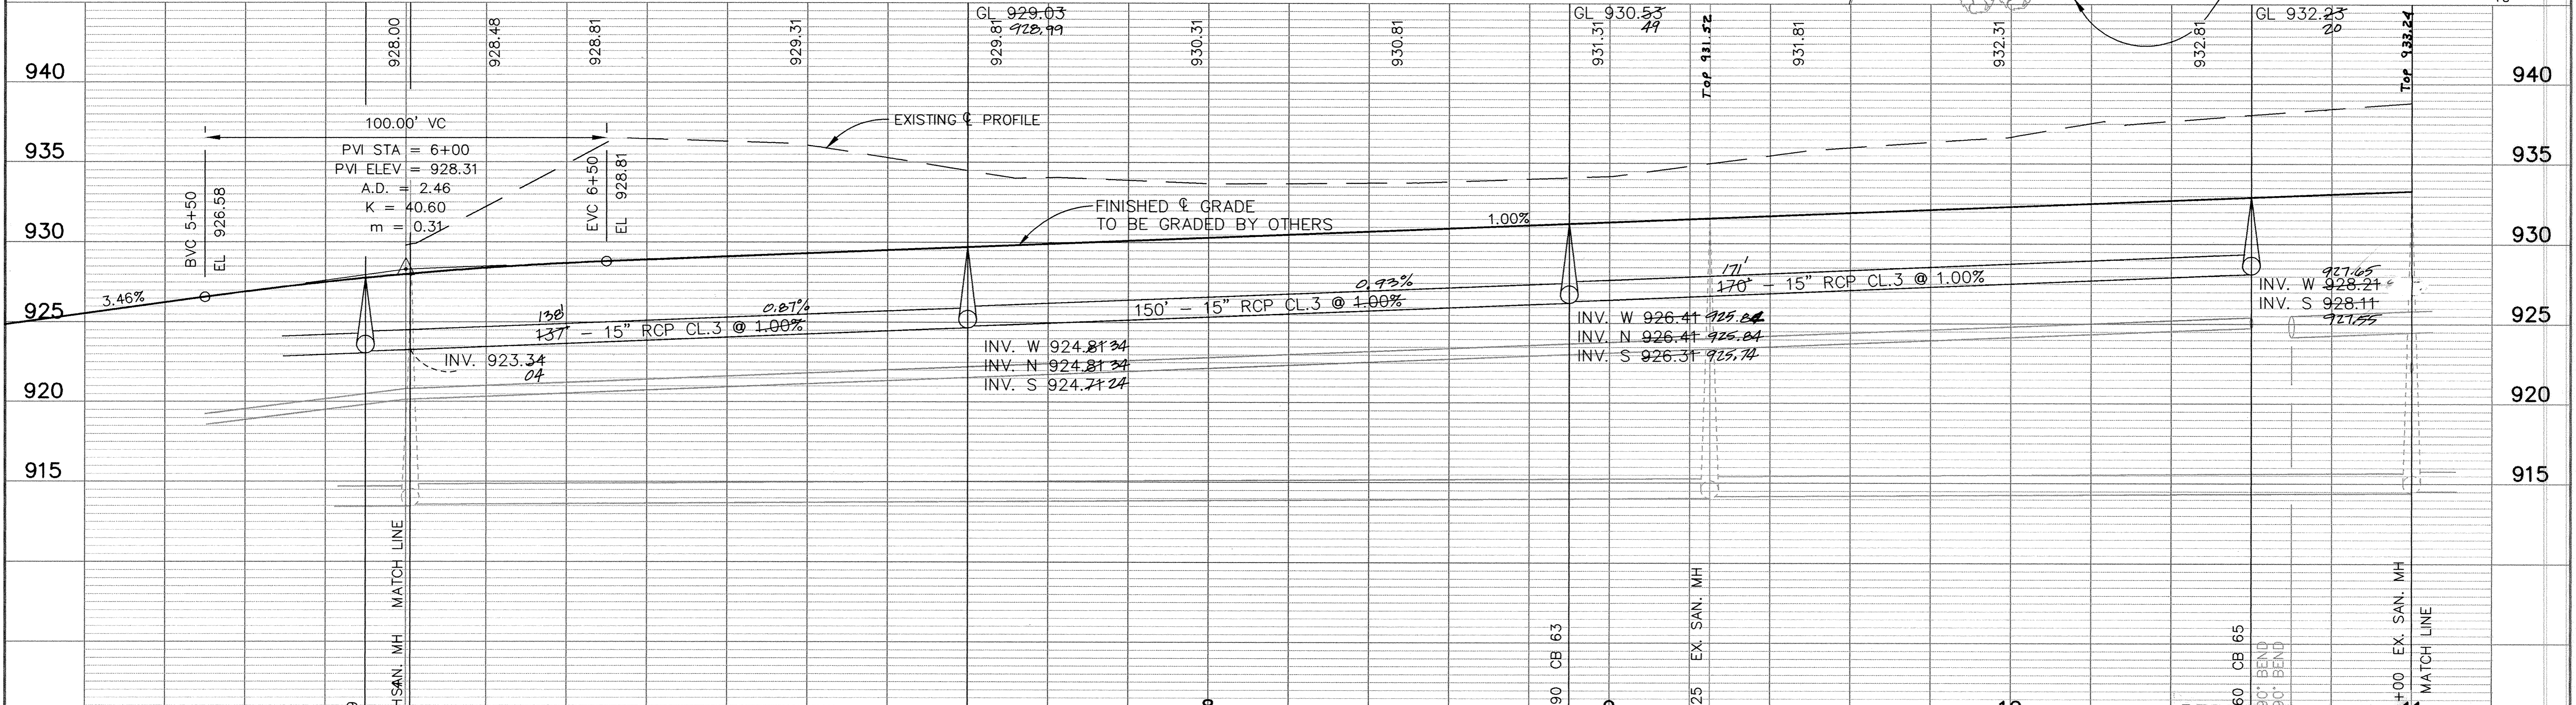

I HEREBY CERTIFY THAT THIS PLAN, SPECIFICATION, OR REPORT WAS PREPARED BY ME OR UNDER MY DIRECT SUPERVISION AND THAT I AM A DULY REGISTERED PROFESSIONAL ENGINEER UNDER THE LAWS OF THE STATE OF MINNESOTA.

Paul Fackler
 DATE 4-29-94 REG. NO. 13929

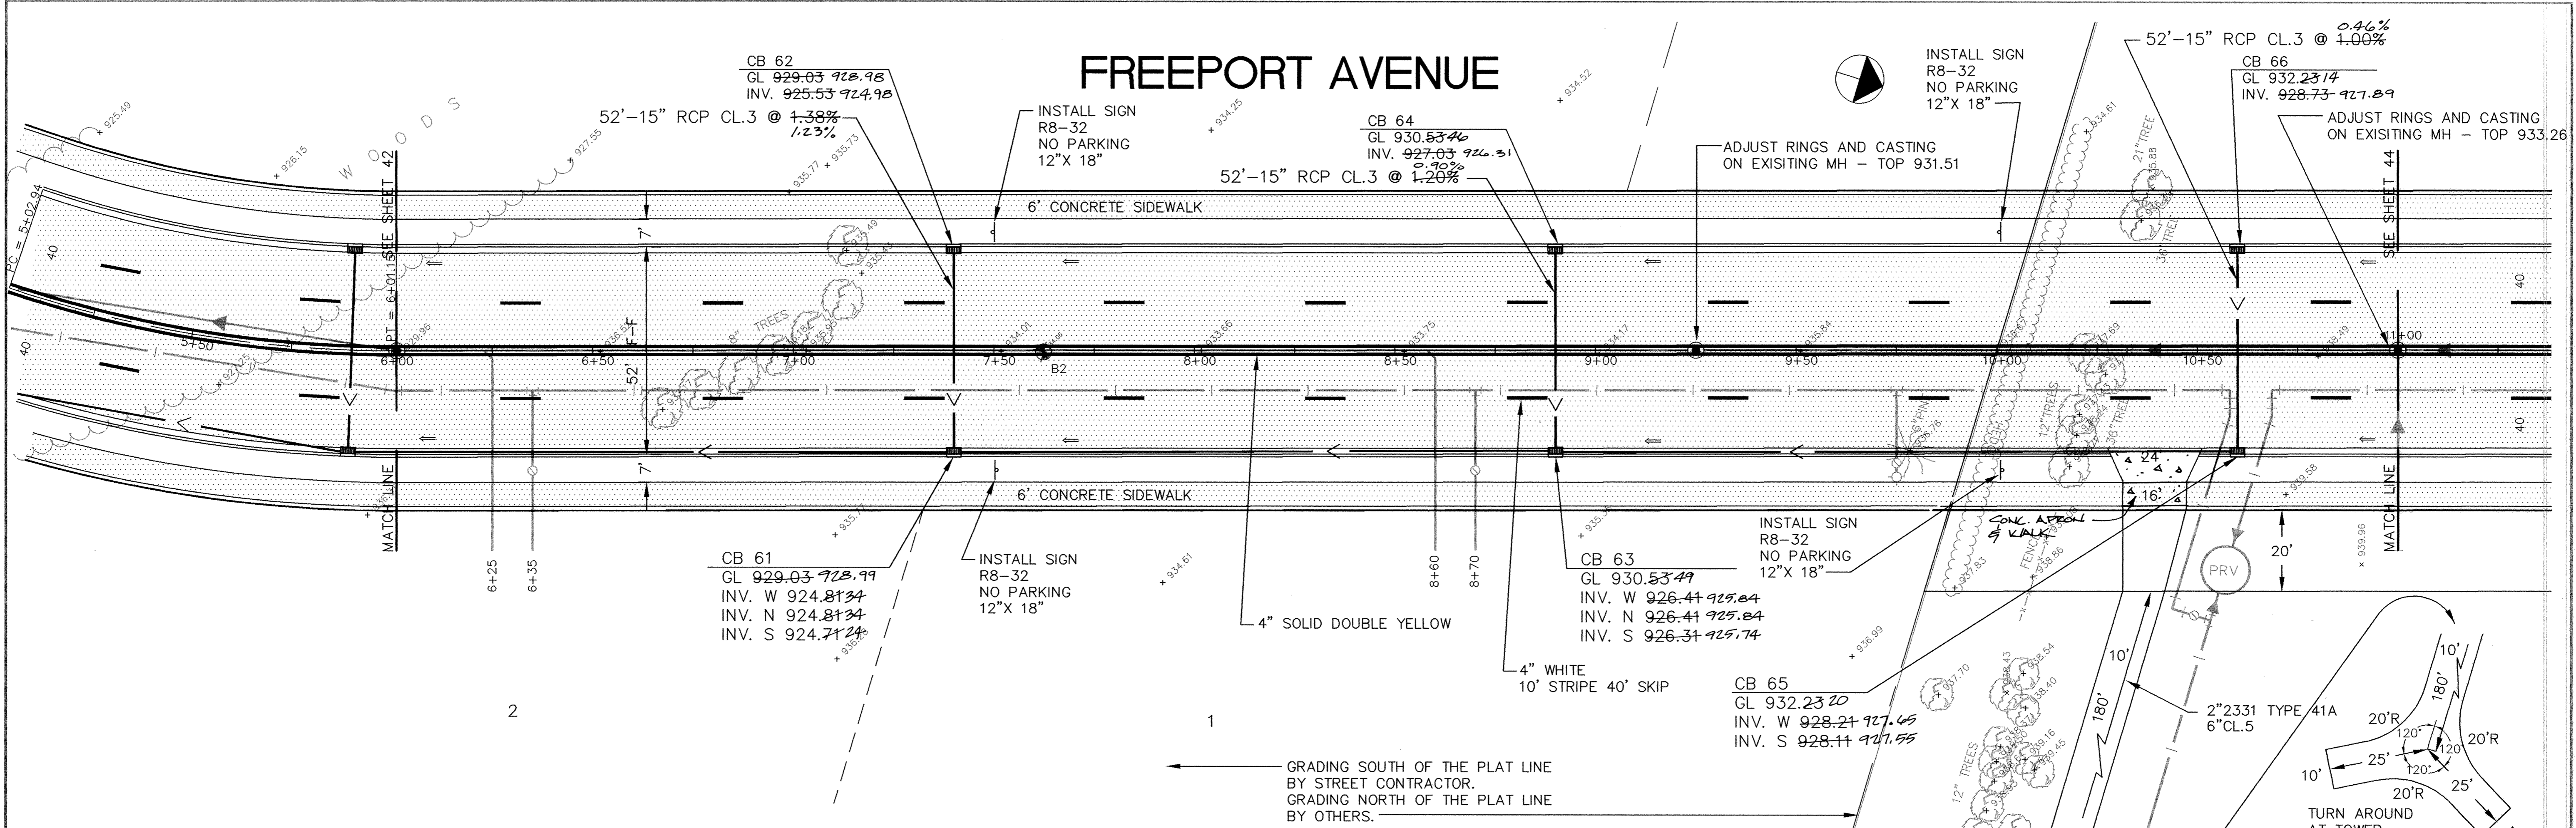

1326 ENERGY PARK DRIVE
 ST. PAUL, MINNESOTA 55108
 (612) 644-4389

9800 SHELARD PARKWAY
 MINNEAPOLIS, MINNESOTA 55441
 (612) 546-0432

DATE	DESCRIPTION	DESIGNED	PER
		CLS	CLS

GRAPHIC SCALE
 0 HORIZ. 20
 0 VERT. 5

RECORD PLAN 1995 11

CITY OF ELK RIVER
 STREET AND STORM SEWER
 FREEPORT AVENUE

STA. 6+01.15 TO 11+00

DATE APRIL 1994 SHEET 43 OF 74 SHEETS PROJECT NO. 230-217

SDCO PRODUCTS • NEW HOPE, MINNESOTA
 REORDER BY PART NUMBER 8022
 SDCO PRODUCTS • NEW HOPE, MINNESOTA
 REORDER BY PART NUMBER 8022
 SDCO PRODUCTS • NEW HOPE, MINNESOTA
 REORDER BY PART NUMBER 8022
 SDCO PRODUCTS • NEW HOPE, MINNESOTA
 REORDER BY PART NUMBER 8022