
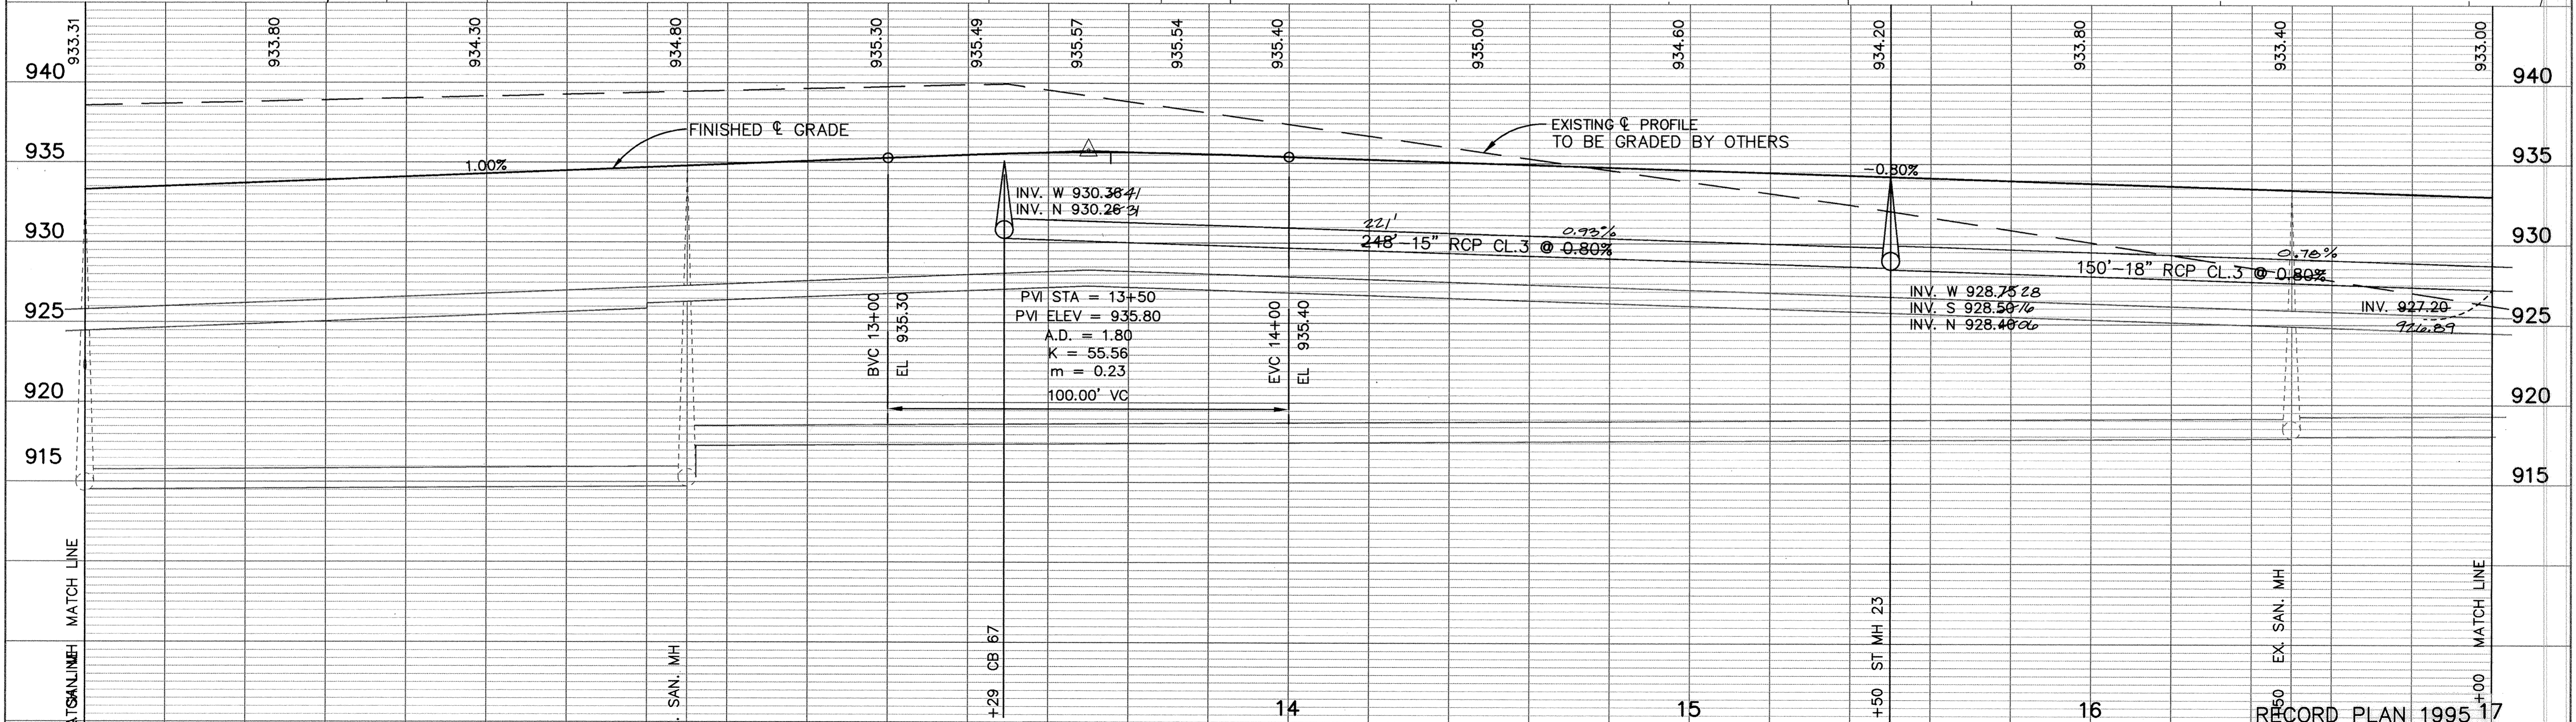
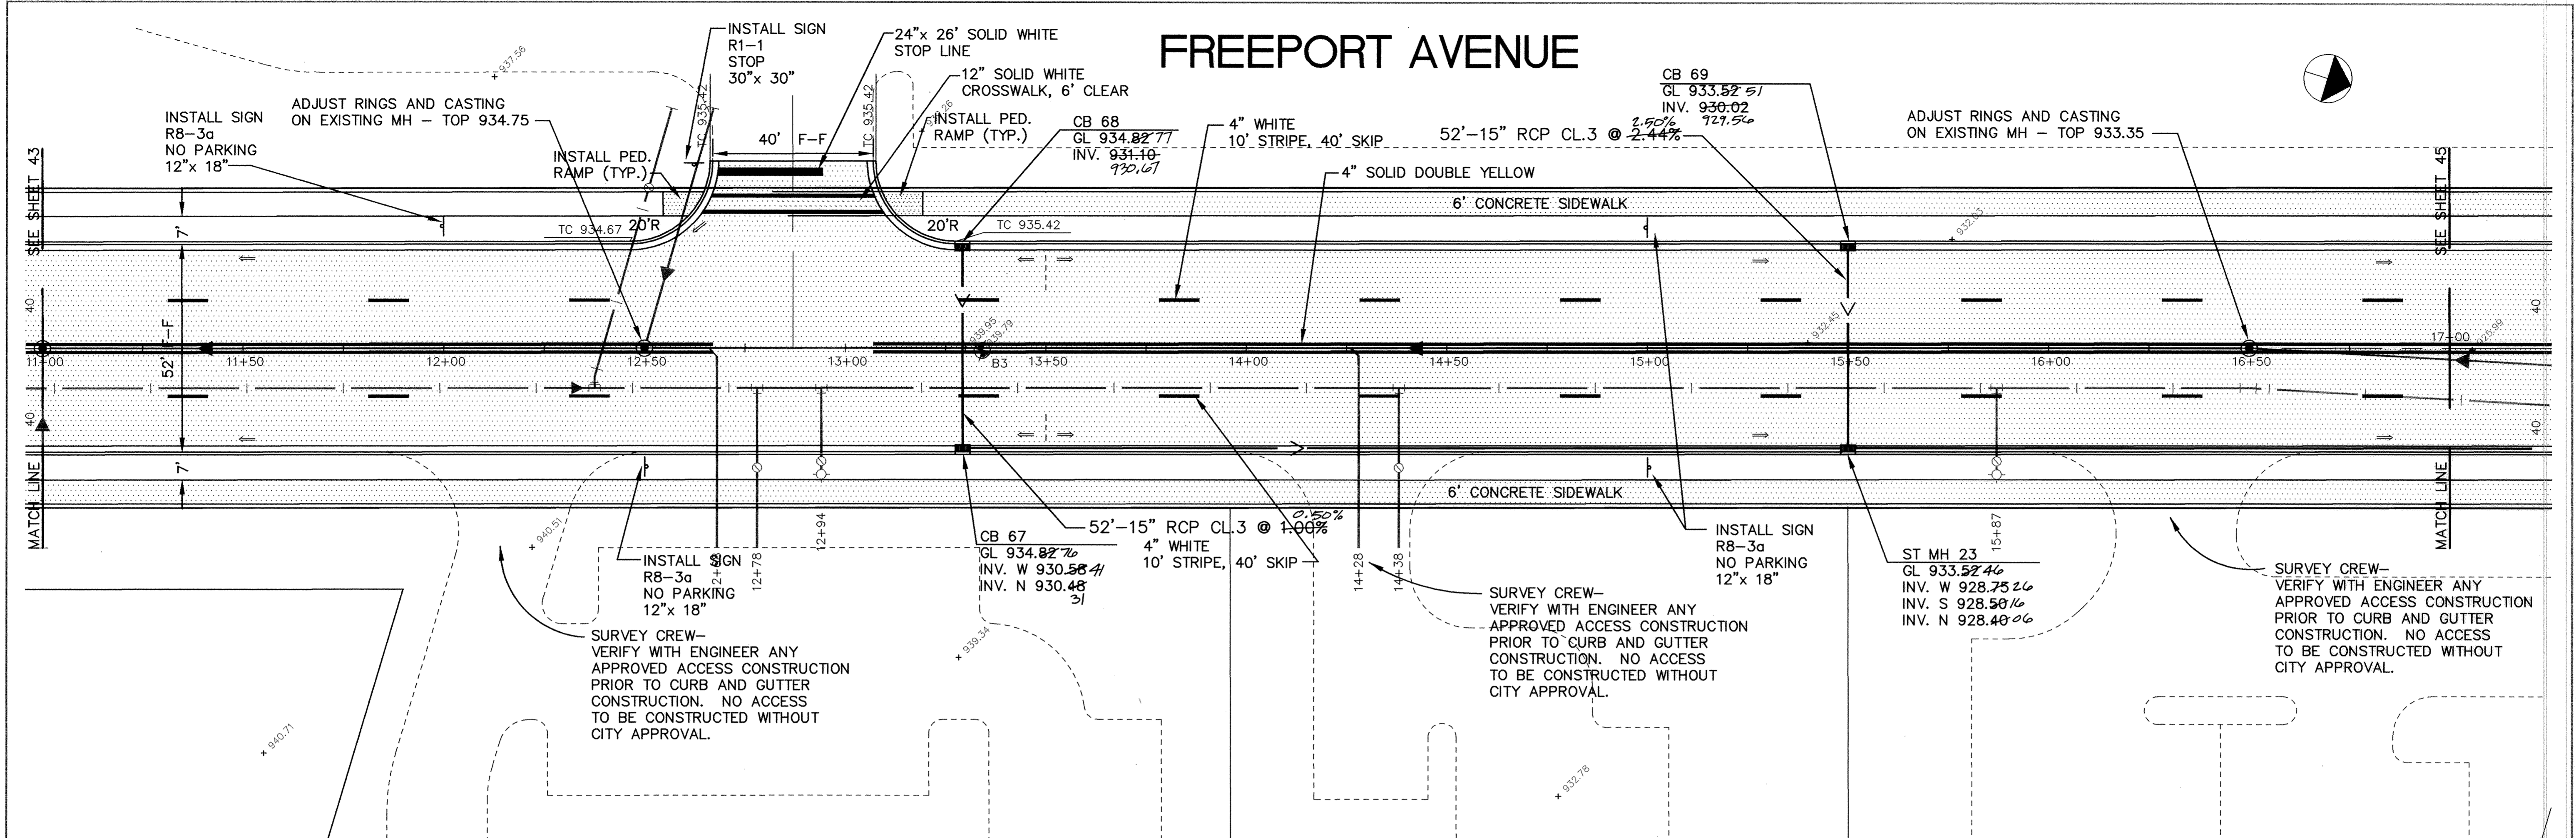


FREEPORT AVENUE

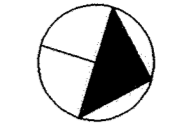

| | | | | | | | | |
|--|----|----|----|----|---|-----------------|---|---|
| ER217F-411 | 12 | 13 | 14 | 15 | 16 | 17 | 17 | |
| I HEREBY CERTIFY THAT THIS PLAN, SPECIFICATION, OR REPORT WAS PREPARED BY ME OR UNDER MY DIRECT SUPERVISION AND THAT I AM A DULY REGISTERED PROFESSIONAL ENGINEER UNDER THE LAWS OF THE STATE OF MINNESOTA. <i>Paul Baeth</i> DATE 6-2-94 REG. NO. 13929 | | | | | 1326 ENERGY PARK DRIVE ST. PAUL, MINNESOTA 55108 (612) 644-4389 9800 SHELARD PARKWAY MINNEAPOLIS, MINNESOTA 55441 (612) 546-0432 | | DATE 6-2-94 DESCRIPTION MOVE ENT. @ 12+87 DESIGNED PEB CHECKED _____ DRAWN CLS GRAPHIC SCALE 0 HORIZ. 20 0 VERT. 5 | CITY OF ELK RIVER STREET AND STORM SEWER FREEPORT AVENUE STA. 11+00 TO 17+00 |
| REVISIONS: | | | | | | DATE APRIL 1994 | SHEET 44 OF 74 SHEETS | PROJECT NO. 230-217 |

DRAWING NUMBER

DRAWING NUMBER

DRAWING NUMBER

DRAWING NUMBER
SCHOO 95
44

301