
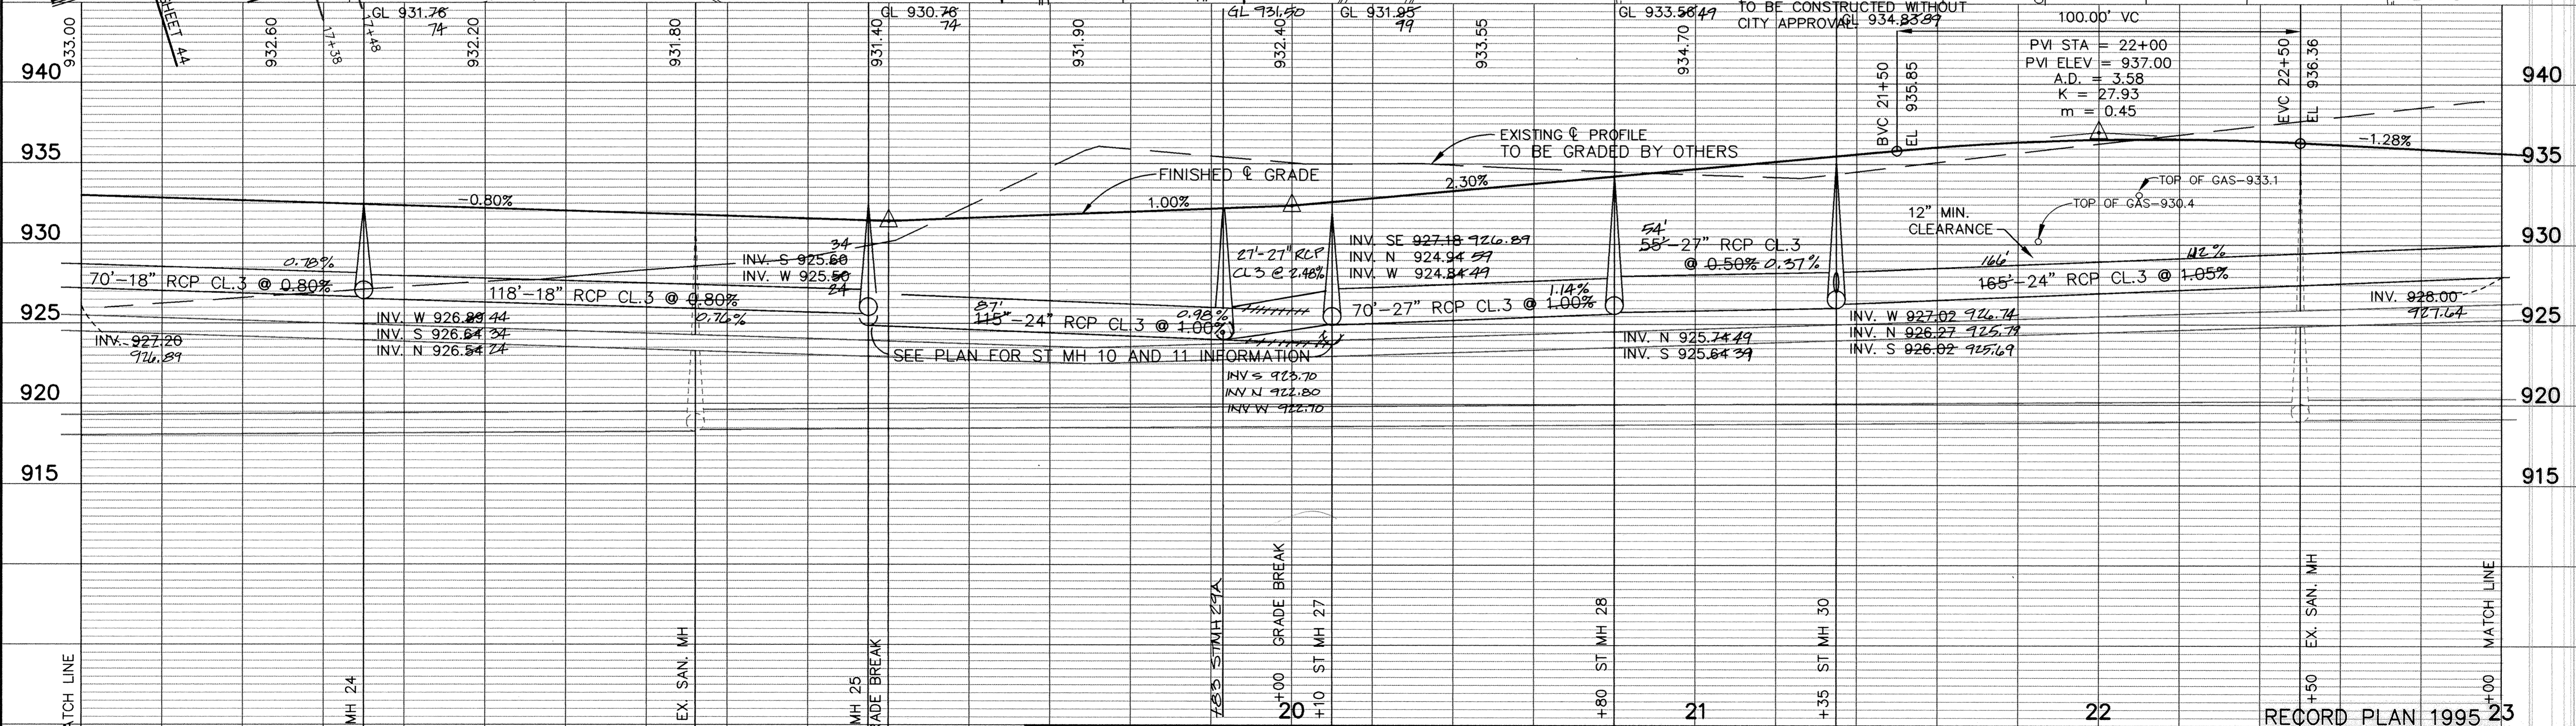


FREEPORT AVENUE

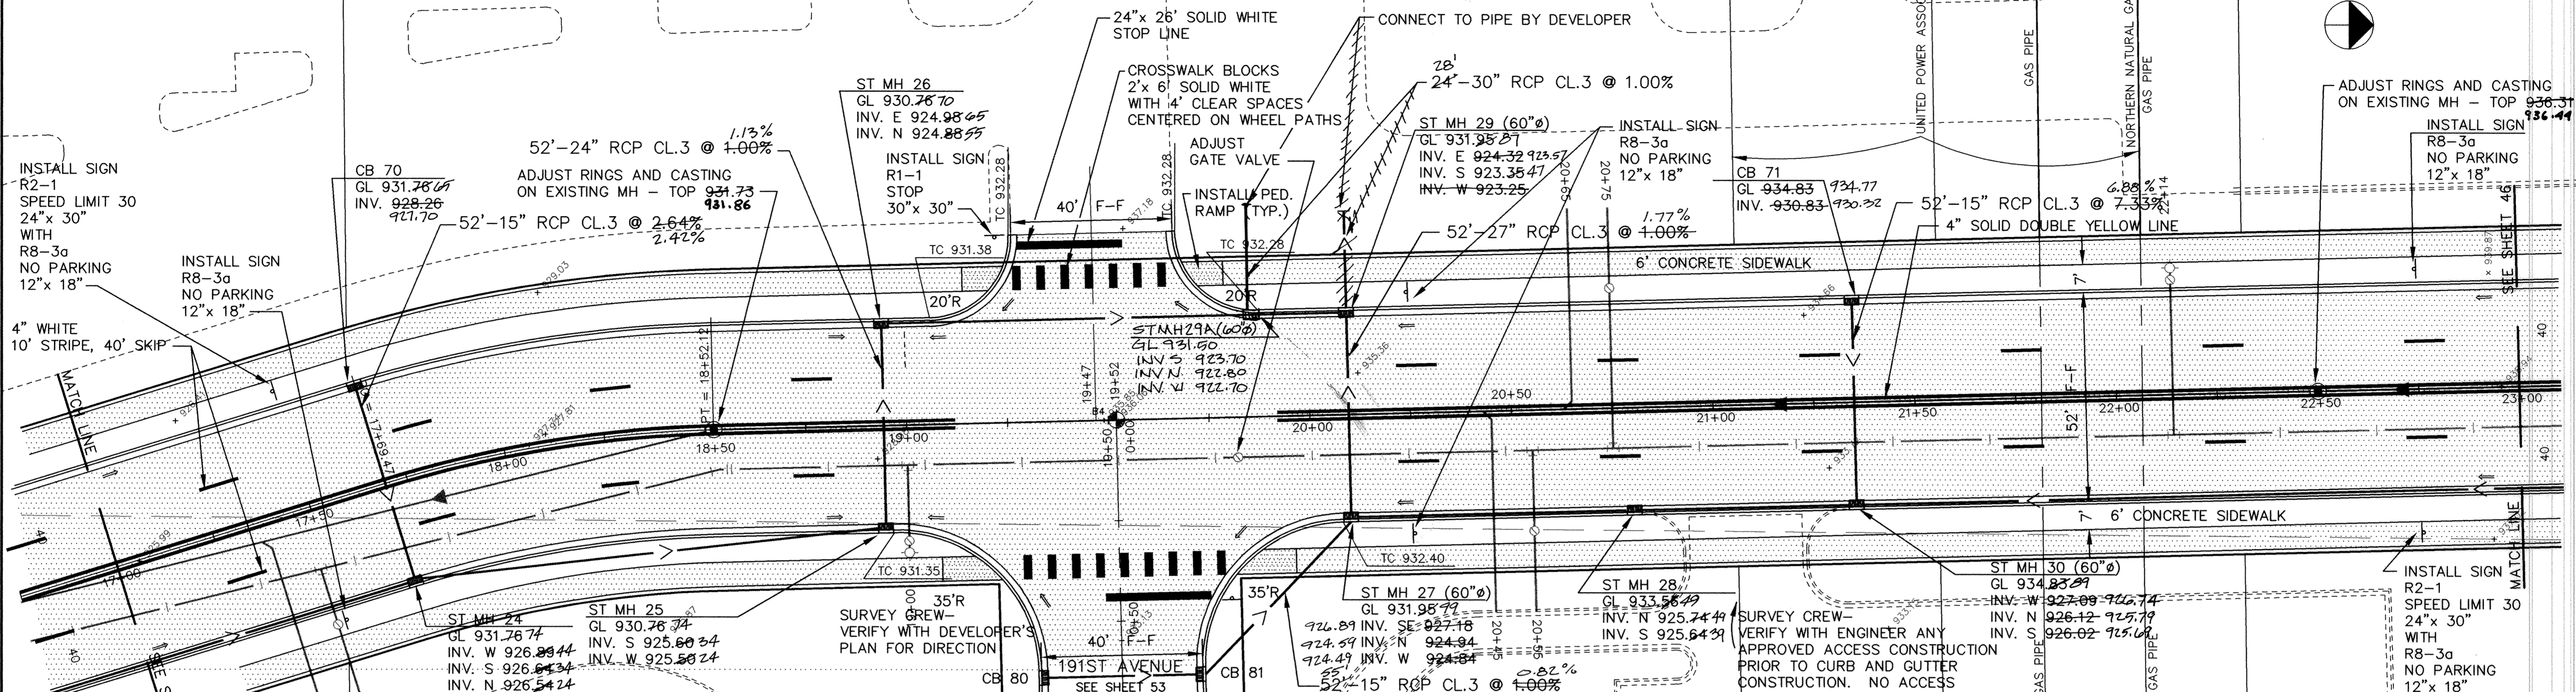

<p>I HEREBY CERTIFY THAT THIS PLAN, SPECIFICATION, OR REPORT WAS PREPARED BY ME OR UNDER MY DIRECT SUPERVISION AND THAT I AM A DULY REGISTERED PROFESSIONAL ENGINEER UNDER THE LAWS OF THE STATE OF MINNESOTA.</p> <p style="text-align: center;"><i>Jeff M. Moore</i> DATE 6/22/94 REG. NO. 15310</p>		<p>1326 ENERGY PARK DRIVE ST. PAUL, MINNESOTA 55108 (612) 644-4389</p> <p>9800 SHELARD PARKWAY MINNEAPOLIS, MINNESOTA 55441 (612) 546-0432</p>	<table border="1" style="width: 100%; border-collapse: collapse;"> <tr><th>DATE</th><th>DESCRIPTION</th></tr> <tr><td>5/31/94</td><td>REVISED STORM SEWER FROM MH 27 TO 12</td></tr> <tr><td>5/31/94</td><td>REVISED STREET PROFILE FROM STA. 20+00 TO 23+50</td></tr> <tr><td>6/22/94</td><td>REVISED CATCH BASINS AT STA. 21+50 AND STA. 22+50</td></tr> </table>	DATE	DESCRIPTION	5/31/94	REVISED STORM SEWER FROM MH 27 TO 12	5/31/94	REVISED STREET PROFILE FROM STA. 20+00 TO 23+50	6/22/94	REVISED CATCH BASINS AT STA. 21+50 AND STA. 22+50	<table border="1" style="width: 100%; border-collapse: collapse;"> <tr><th>DESIGNED</th><th>P.E.B.</th></tr> <tr><td>CHECKED</td><td></td></tr> <tr><td>DRAWN</td><td>CLS</td></tr> </table> <p>GRAPHIC SCALE 0 HORIZ. 20 0 VERT. 5</p>	DESIGNED	P.E.B.	CHECKED		DRAWN	CLS	<p>CITY OF ELK RIVER STREET AND STORM SEWER FREEPORT AVENUE</p> <p style="text-align: right;">STA. 17+00 TO 23+00</p>
DATE	DESCRIPTION																		
5/31/94	REVISED STORM SEWER FROM MH 27 TO 12																		
5/31/94	REVISED STREET PROFILE FROM STA. 20+00 TO 23+50																		
6/22/94	REVISED CATCH BASINS AT STA. 21+50 AND STA. 22+50																		
DESIGNED	P.E.B.																		
CHECKED																			
DRAWN	CLS																		
<p>RECORD PLAN 1995 23</p>			<p>DATE APRIL 1994 SHEET 45 OF 74 SHEETS PROJECT NO. 230-217</p>																