
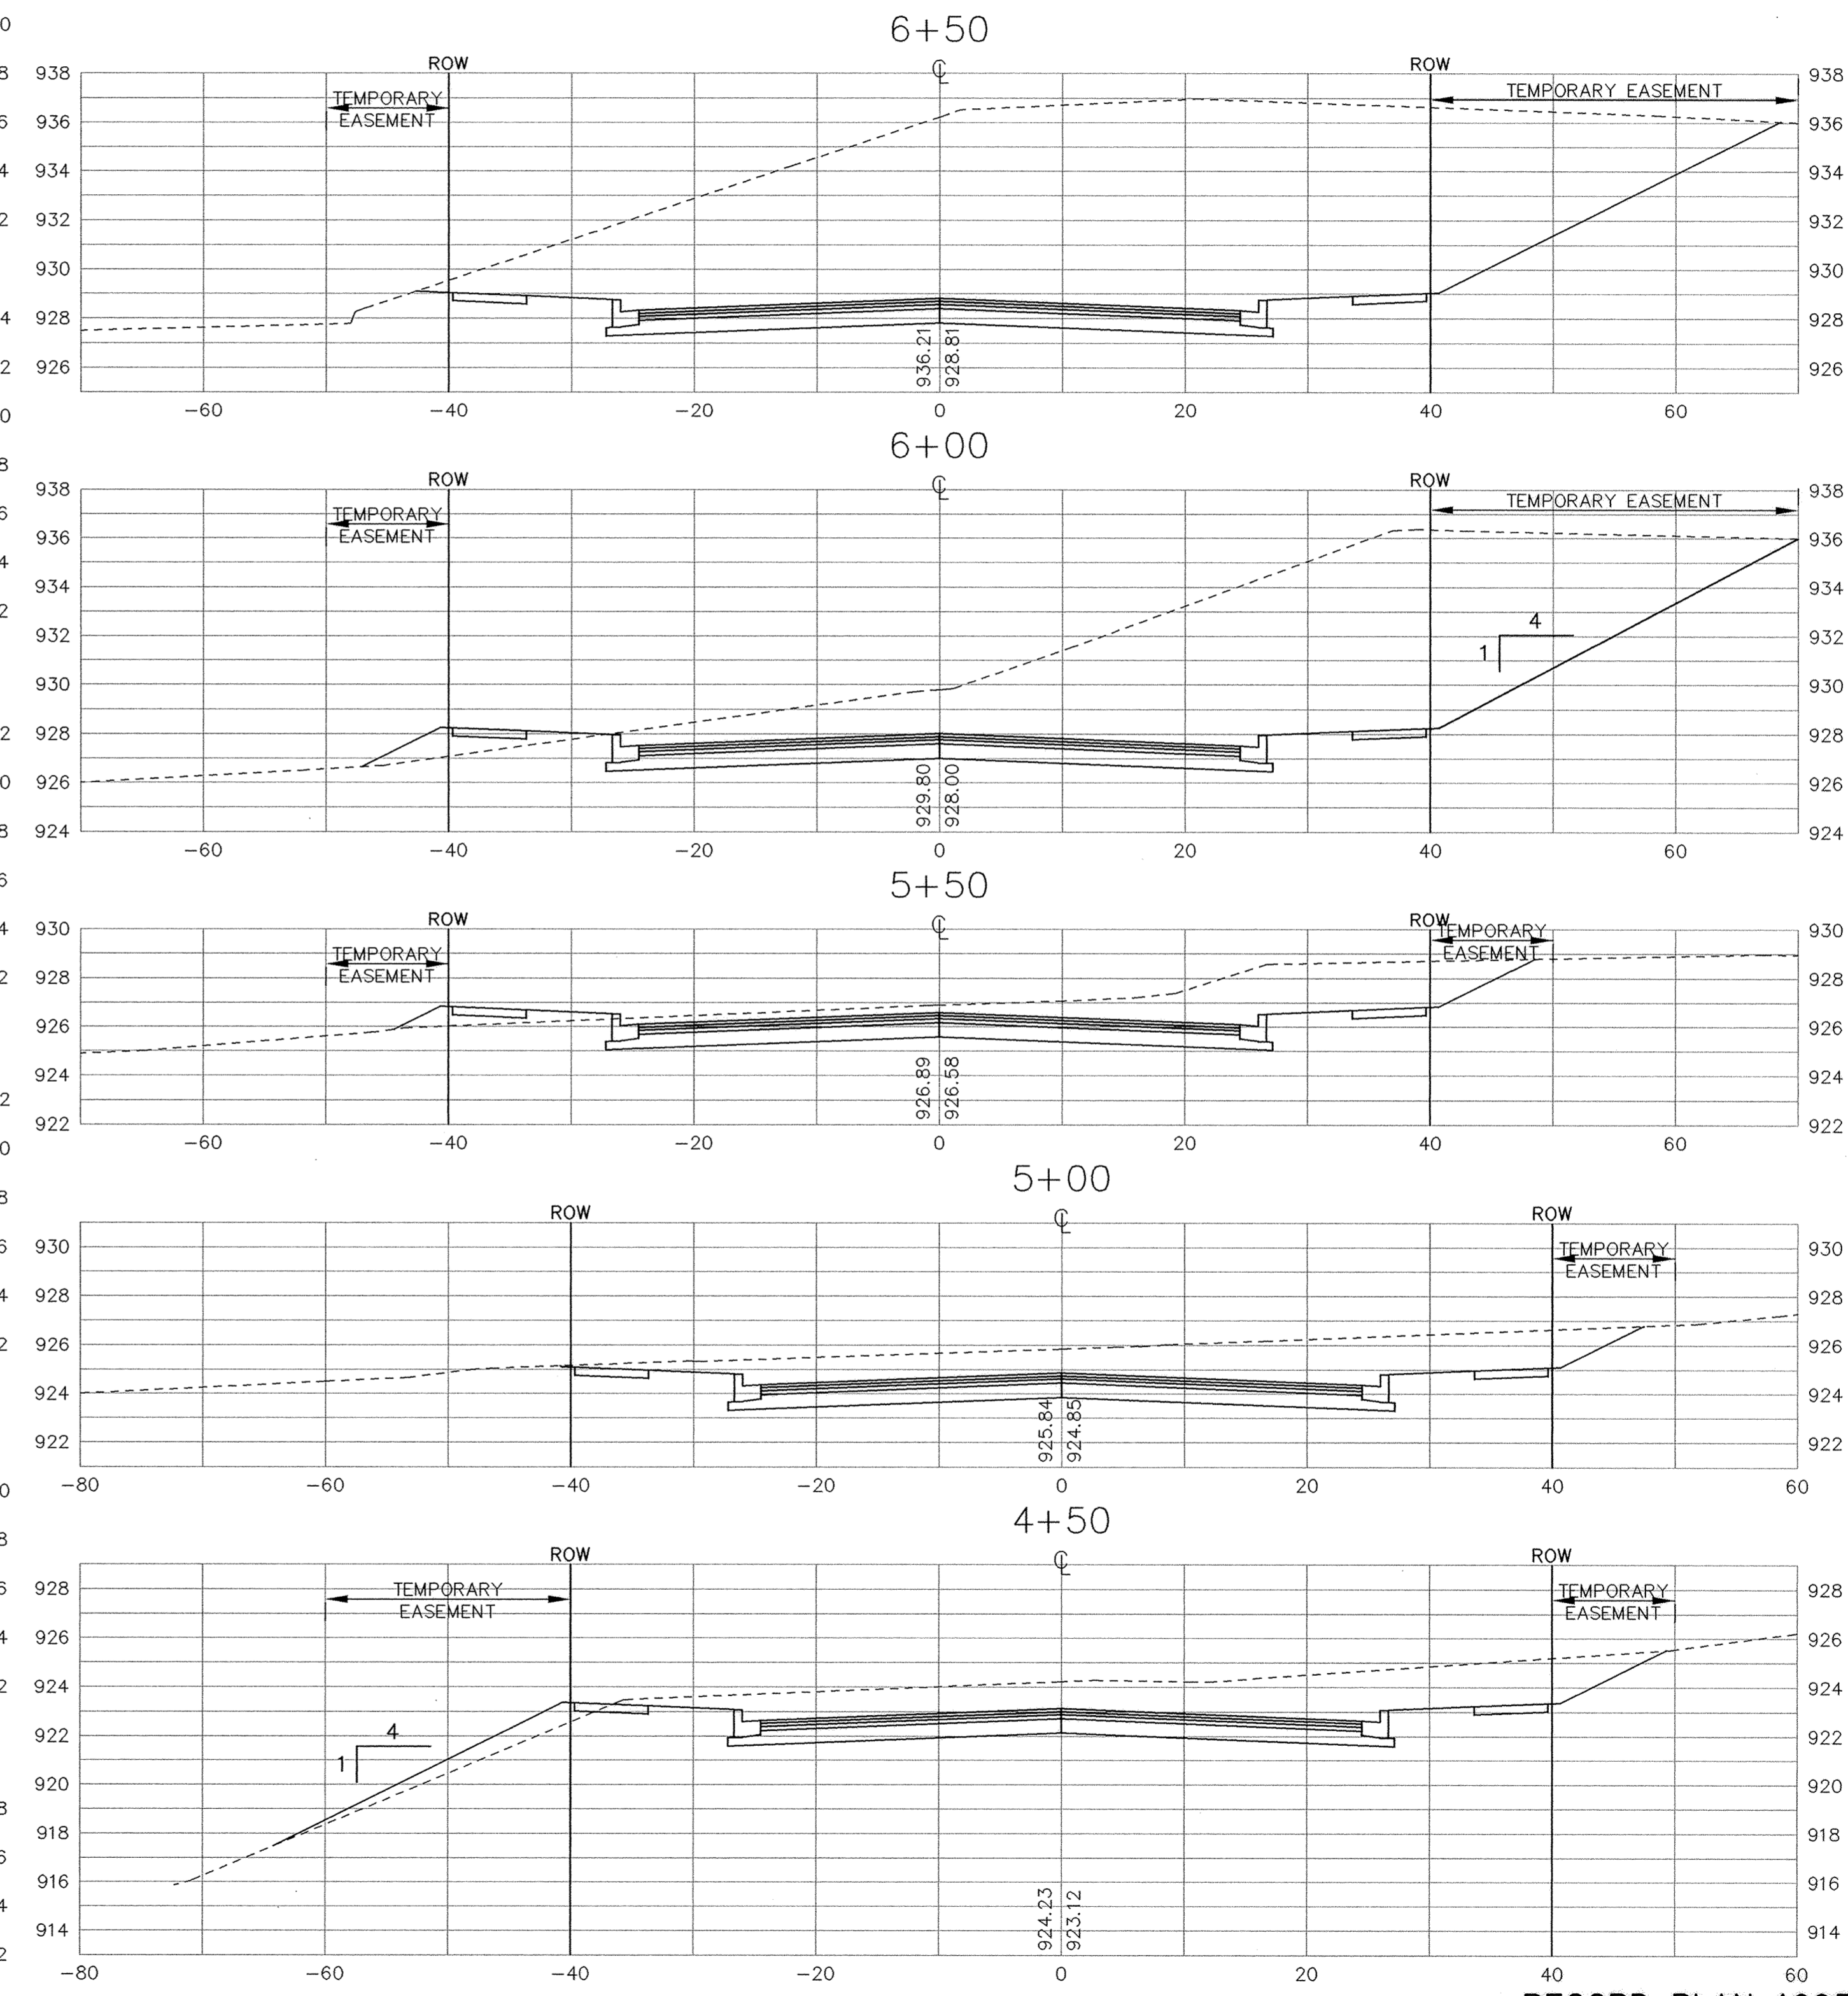



SARGO PRODUCTS • NEW HOPE, MINNESOTA  
PROJECT BY PART NUMBER 6582  
SARGO PRODUCTS • NEW HOPE, MINNESOTA  
PROJECT BY PART NUMBER 6582  
SARGO PRODUCTS • NEW HOPE, MINNESOTA  
PROJECT BY PART NUMBER 6582  
SARGO PRODUCTS • NEW HOPE, MINNESOTA  
PROJECT BY PART NUMBER 6582

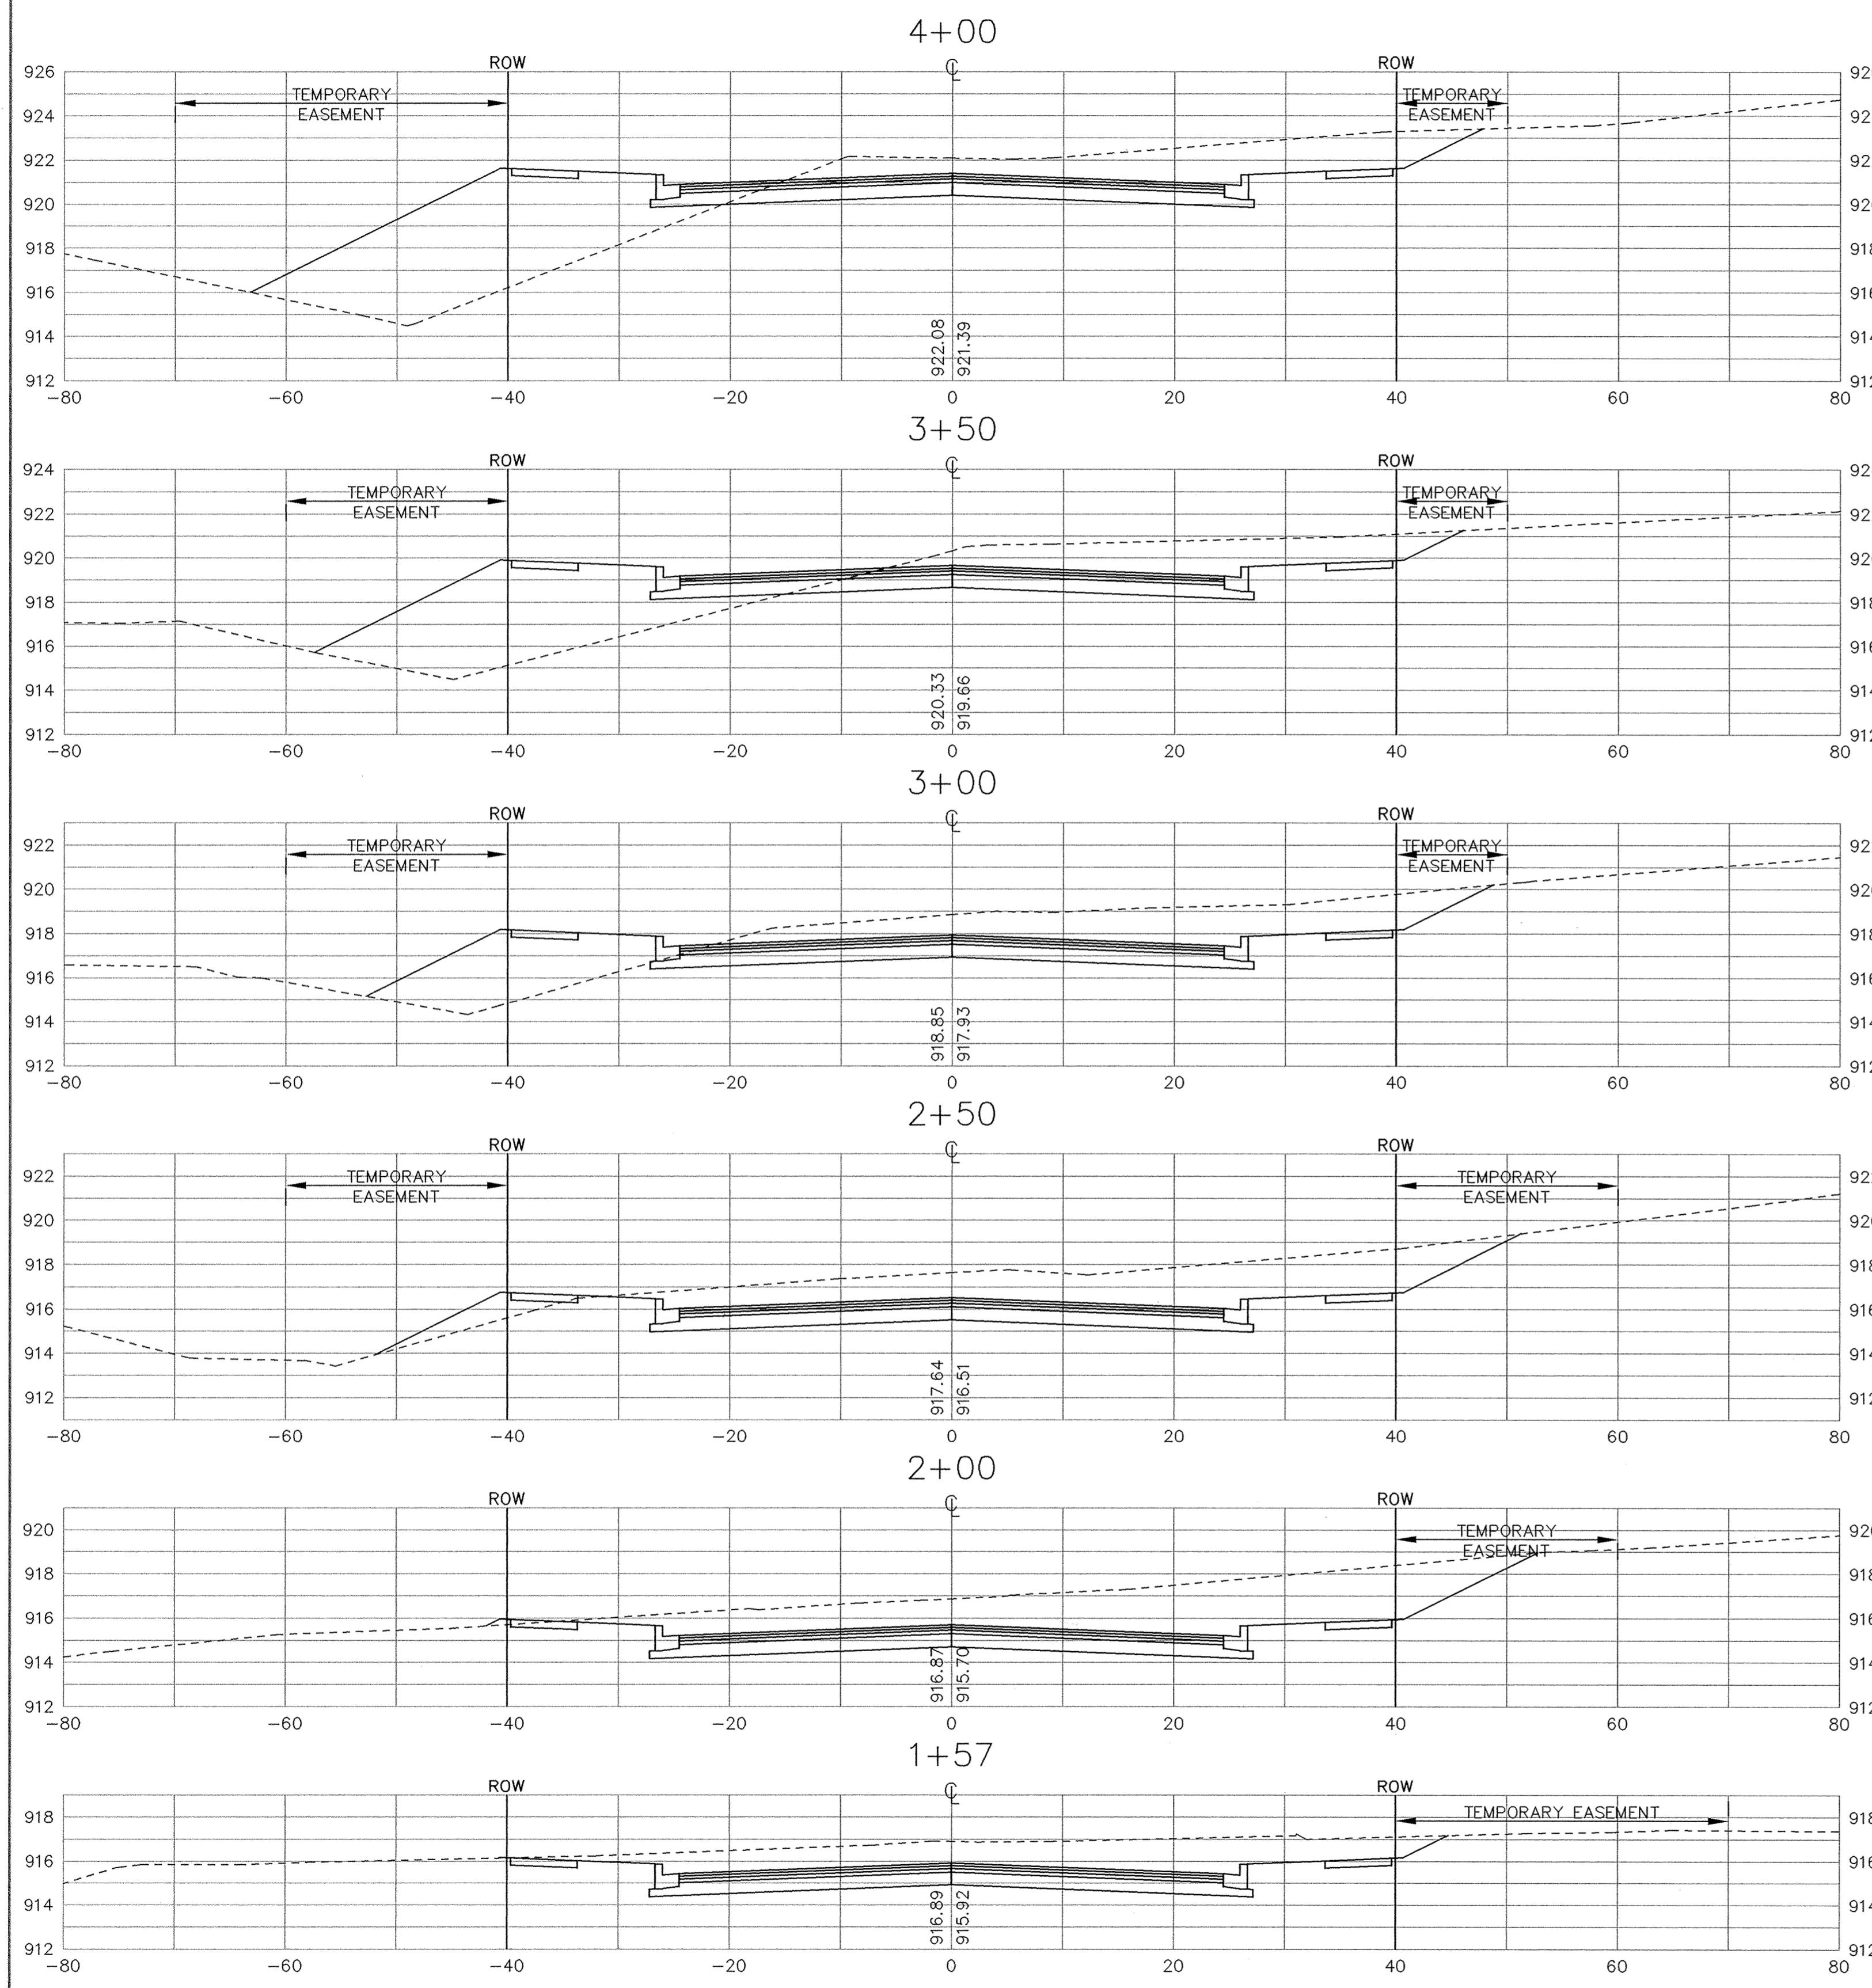

RECORD PLAN 1995

CITY OF ELK RIVER  
CROSS SECTIONS  
FREEPORT AVENUE  
STA.  
1+57 TO 6+50

I HEREBY CERTIFY THAT THIS PLAN, SPECIFICATION, OR REPORT WAS PREPARED BY ME OR UNDER MY DIRECT SUPERVISION AND THAT I AM A DULY REGISTERED PROFESSIONAL ENGINEER UNDER THE LAWS OF THE STATE OF MINNESOTA.  
*Paul Baeth*  
DATE 4-29-94 REG. NO. 13929

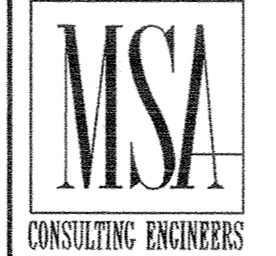

1326 ENERGY PARK DRIVE  
ST. PAUL, MINNESOTA 55108  
(612) 644-4389  
9800 SHELARD PARKWAY  
MINNEAPOLIS, MINNESOTA 55441  
(612) 546-0432

DATE	DESCRIPTION	DESIGNED	PEB

CHECKED *PP*  
DRAWN *CLS*

GRAPHIC SCALE  
0 1 2  
HORIZ. 20  
VERT. 5

DATE APRIL 1994 SHEET 51 OF 74 SHEETS PROJECT NO. 230-217