
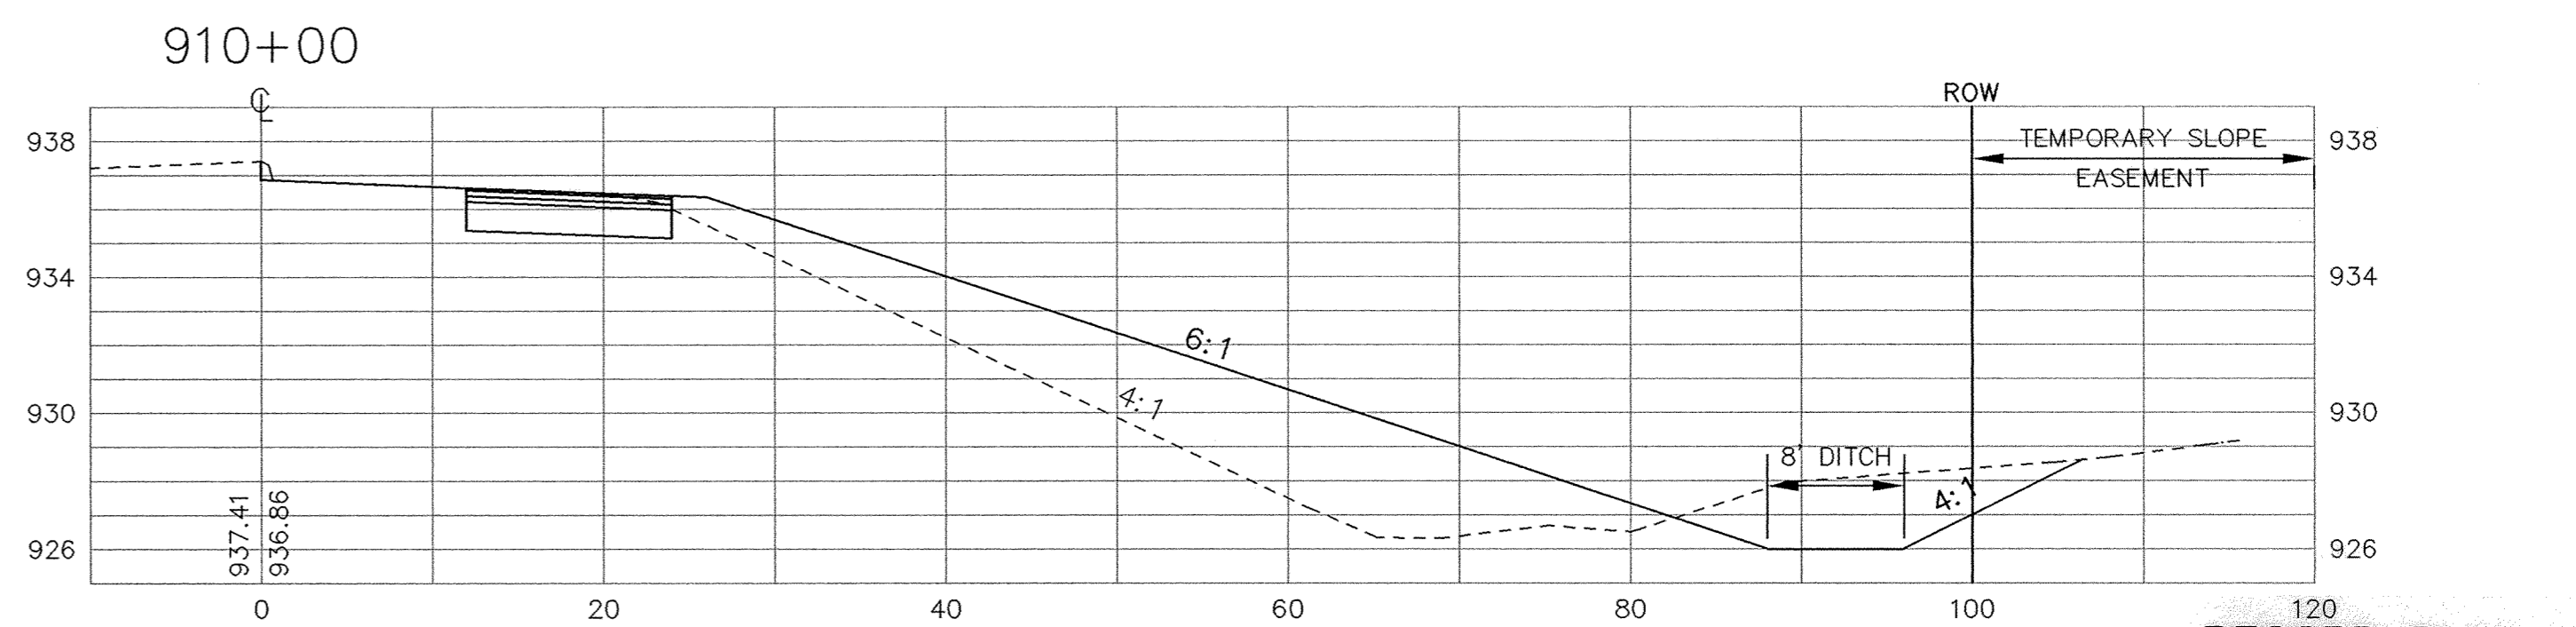
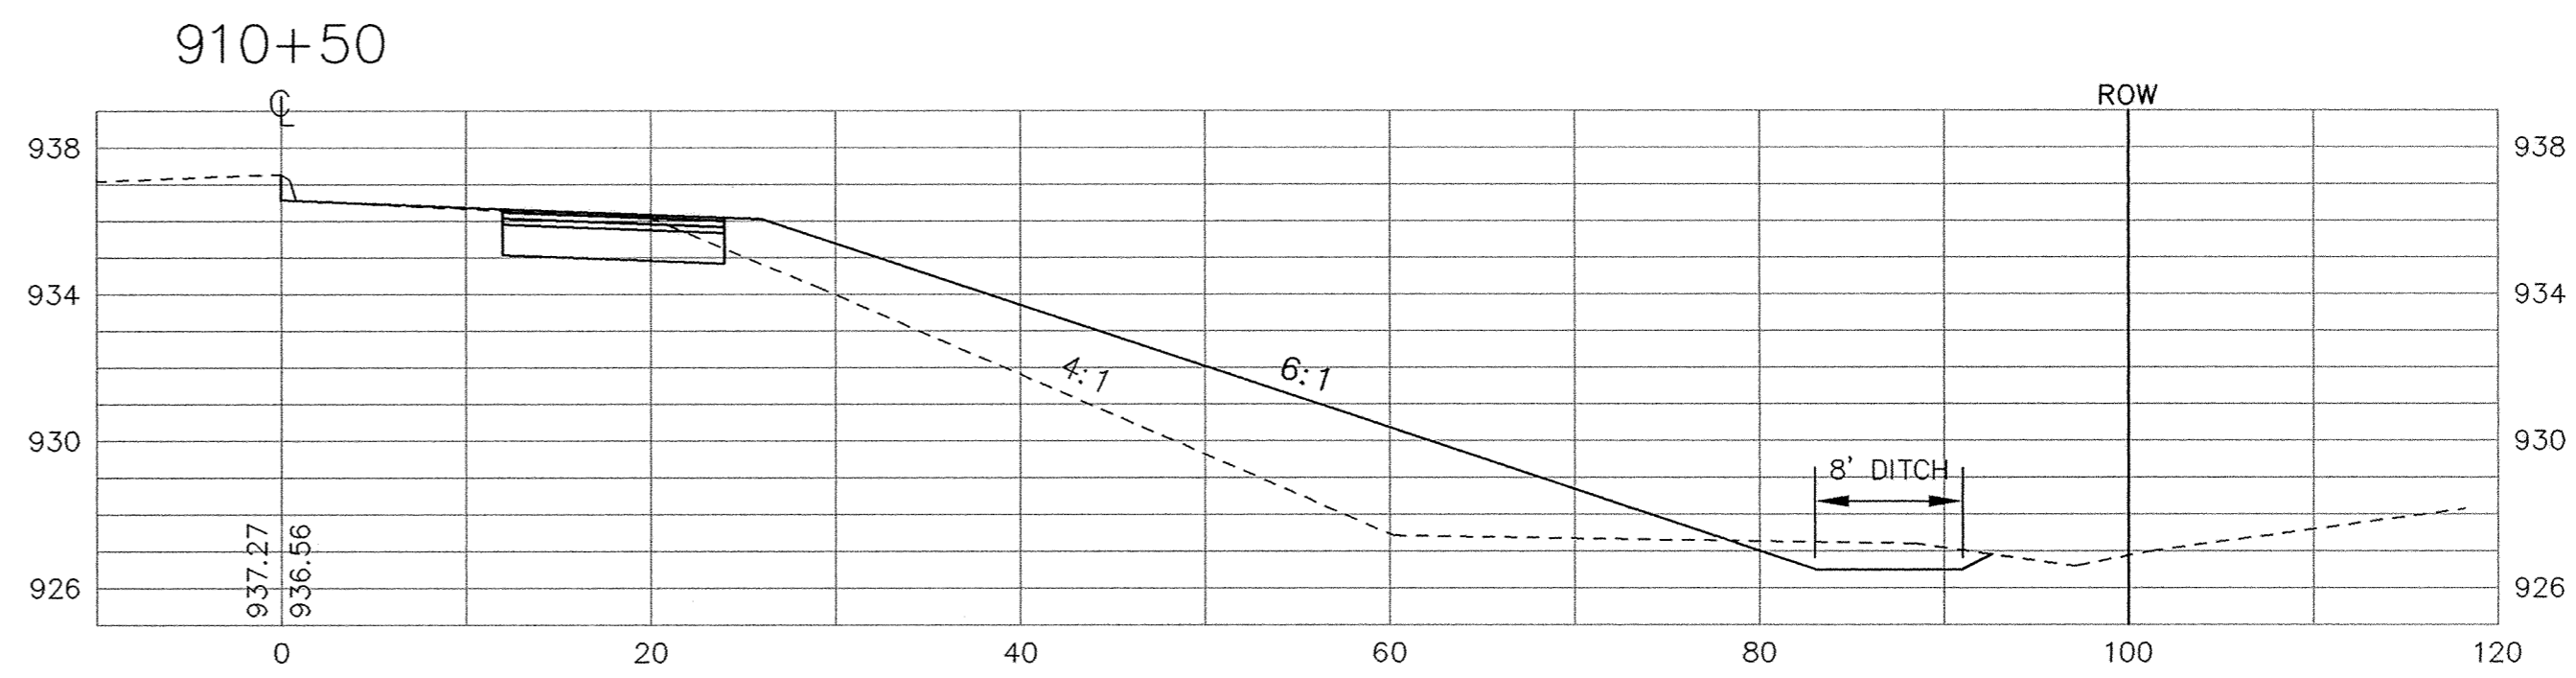
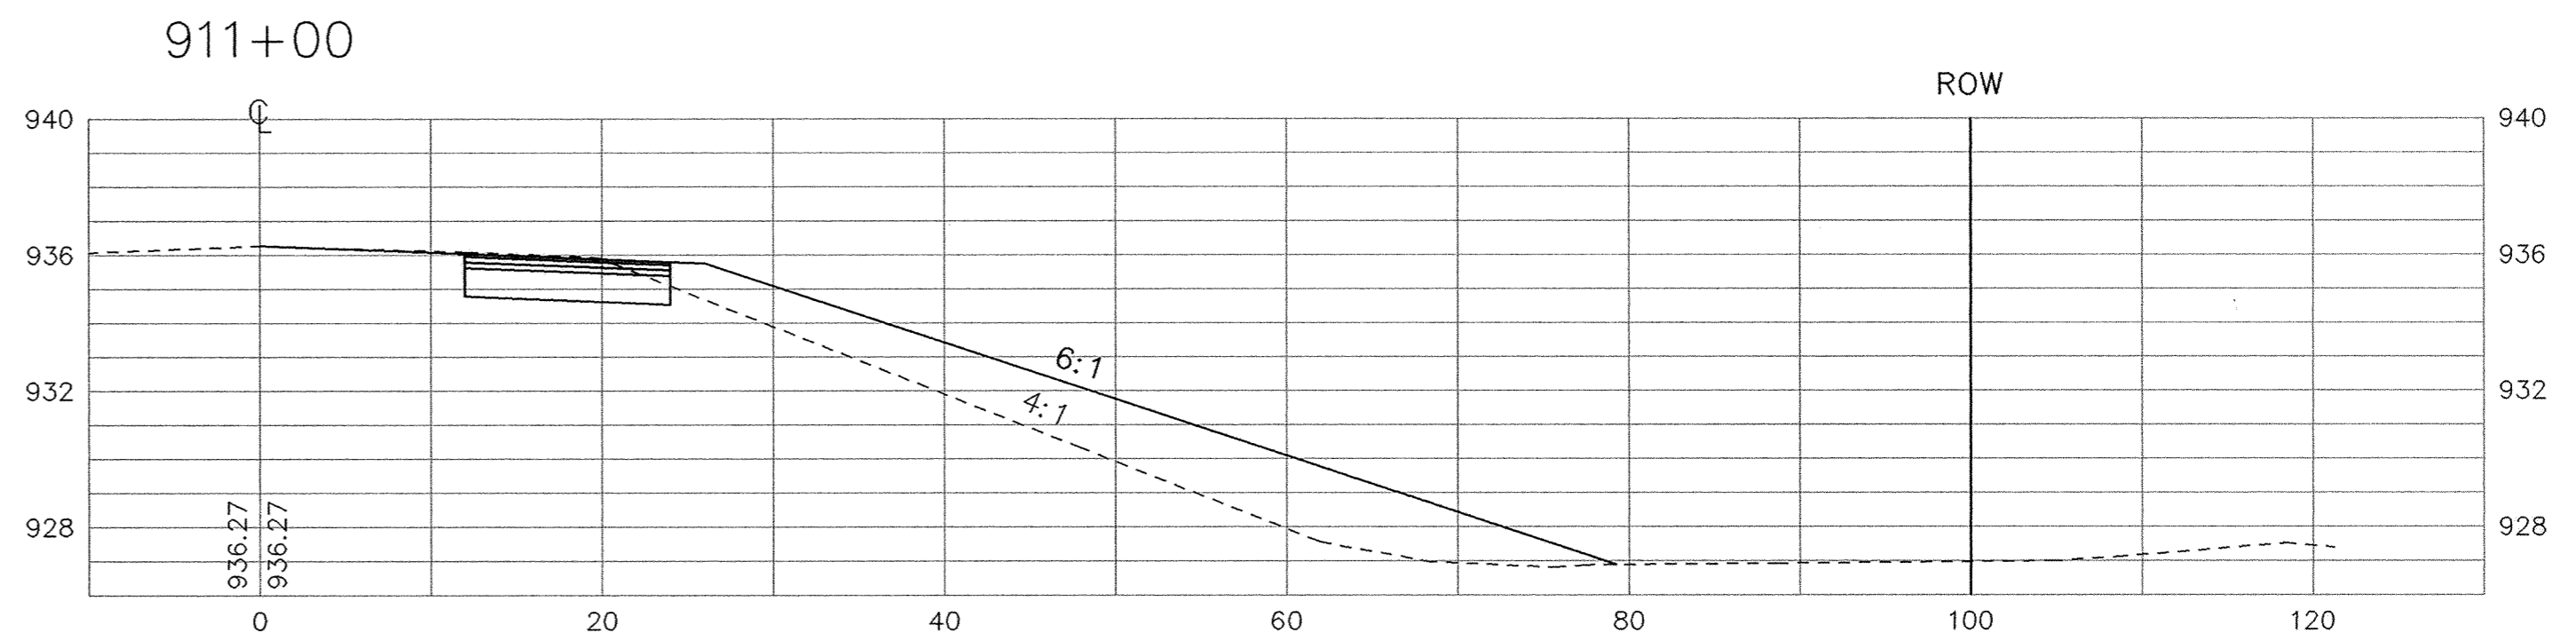
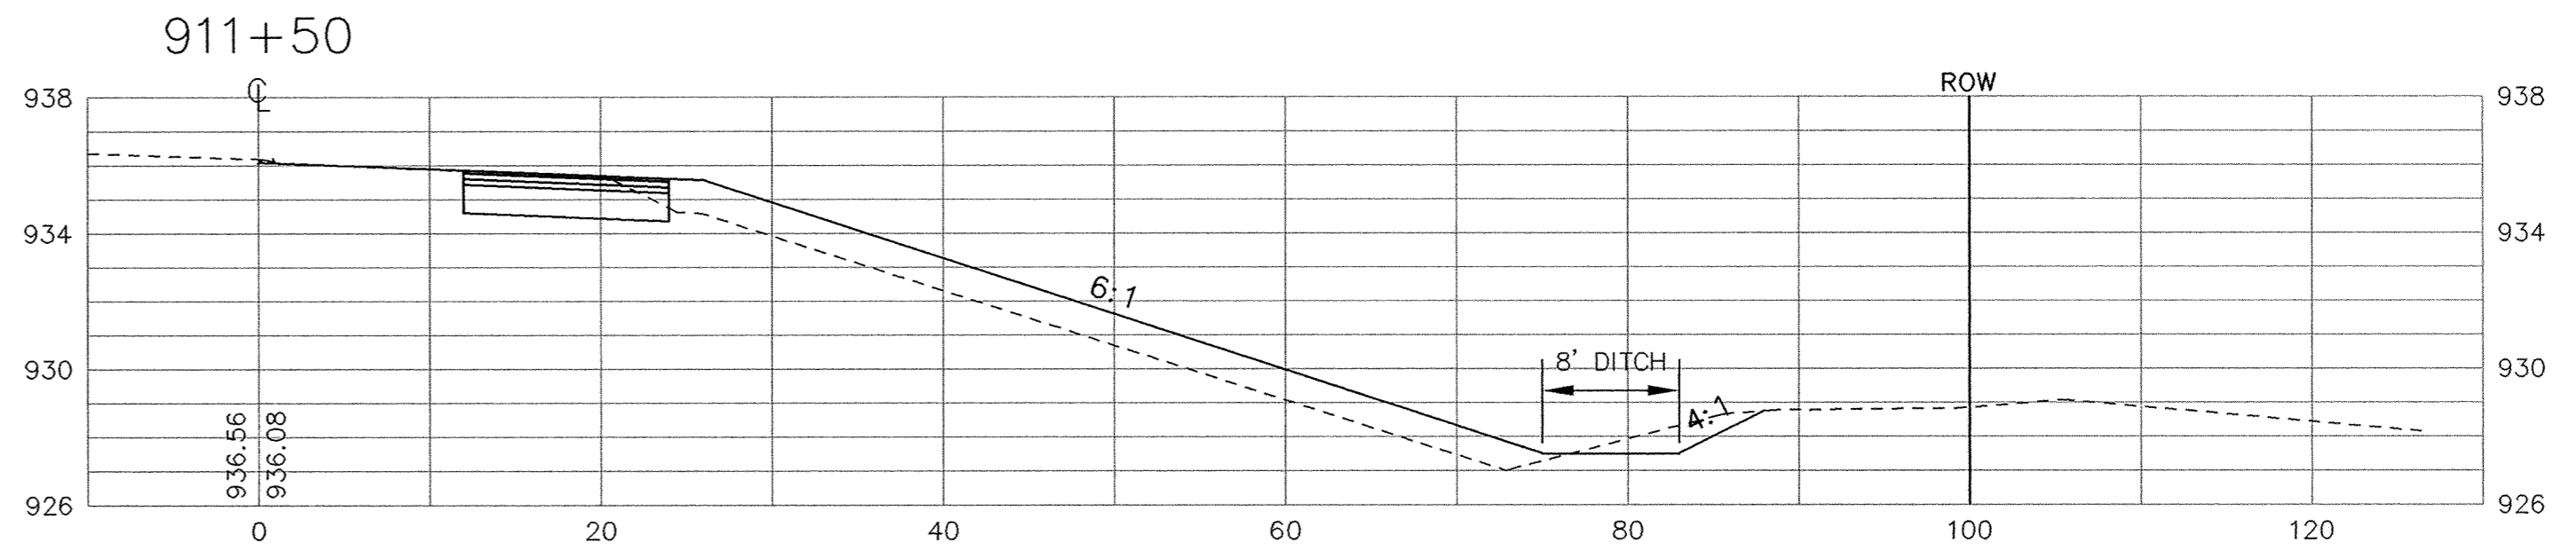
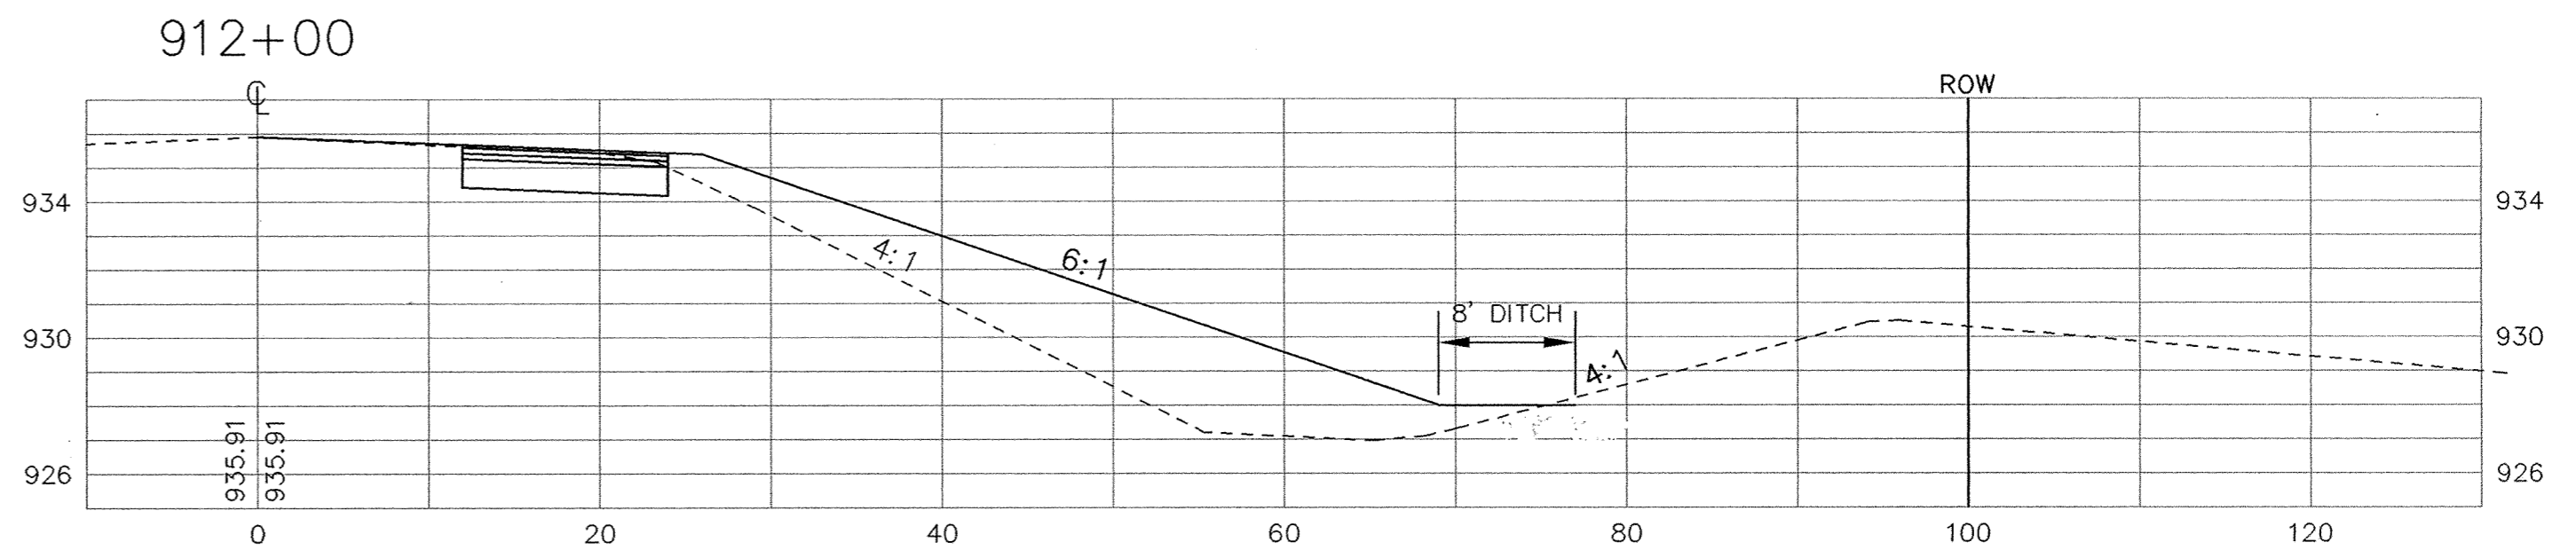
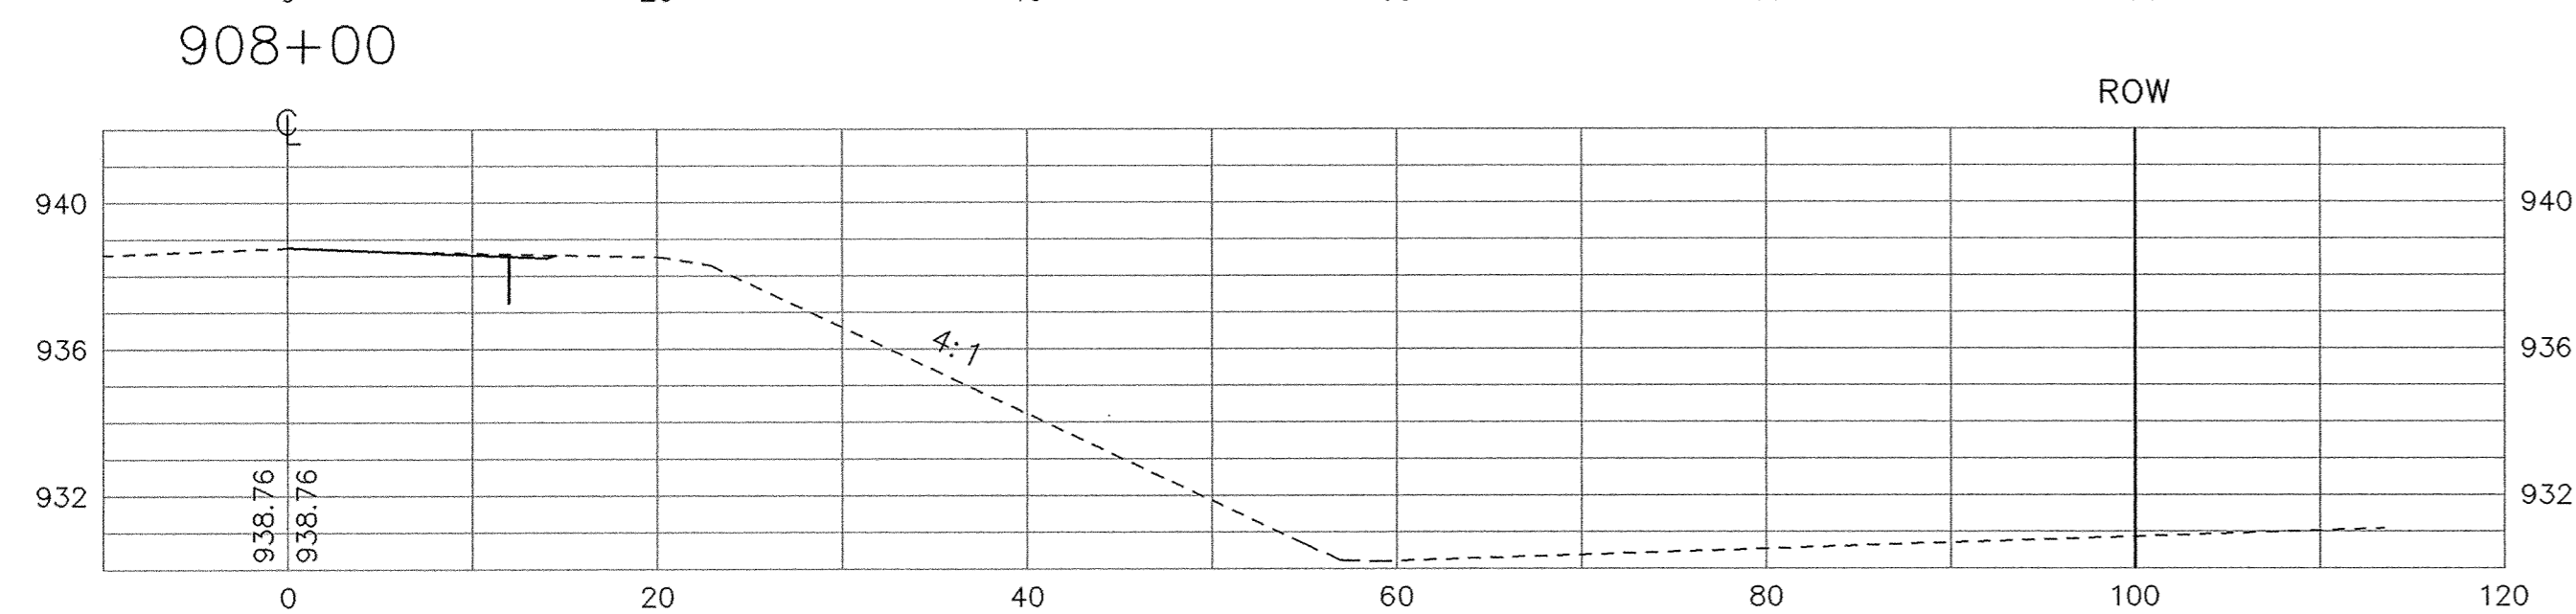
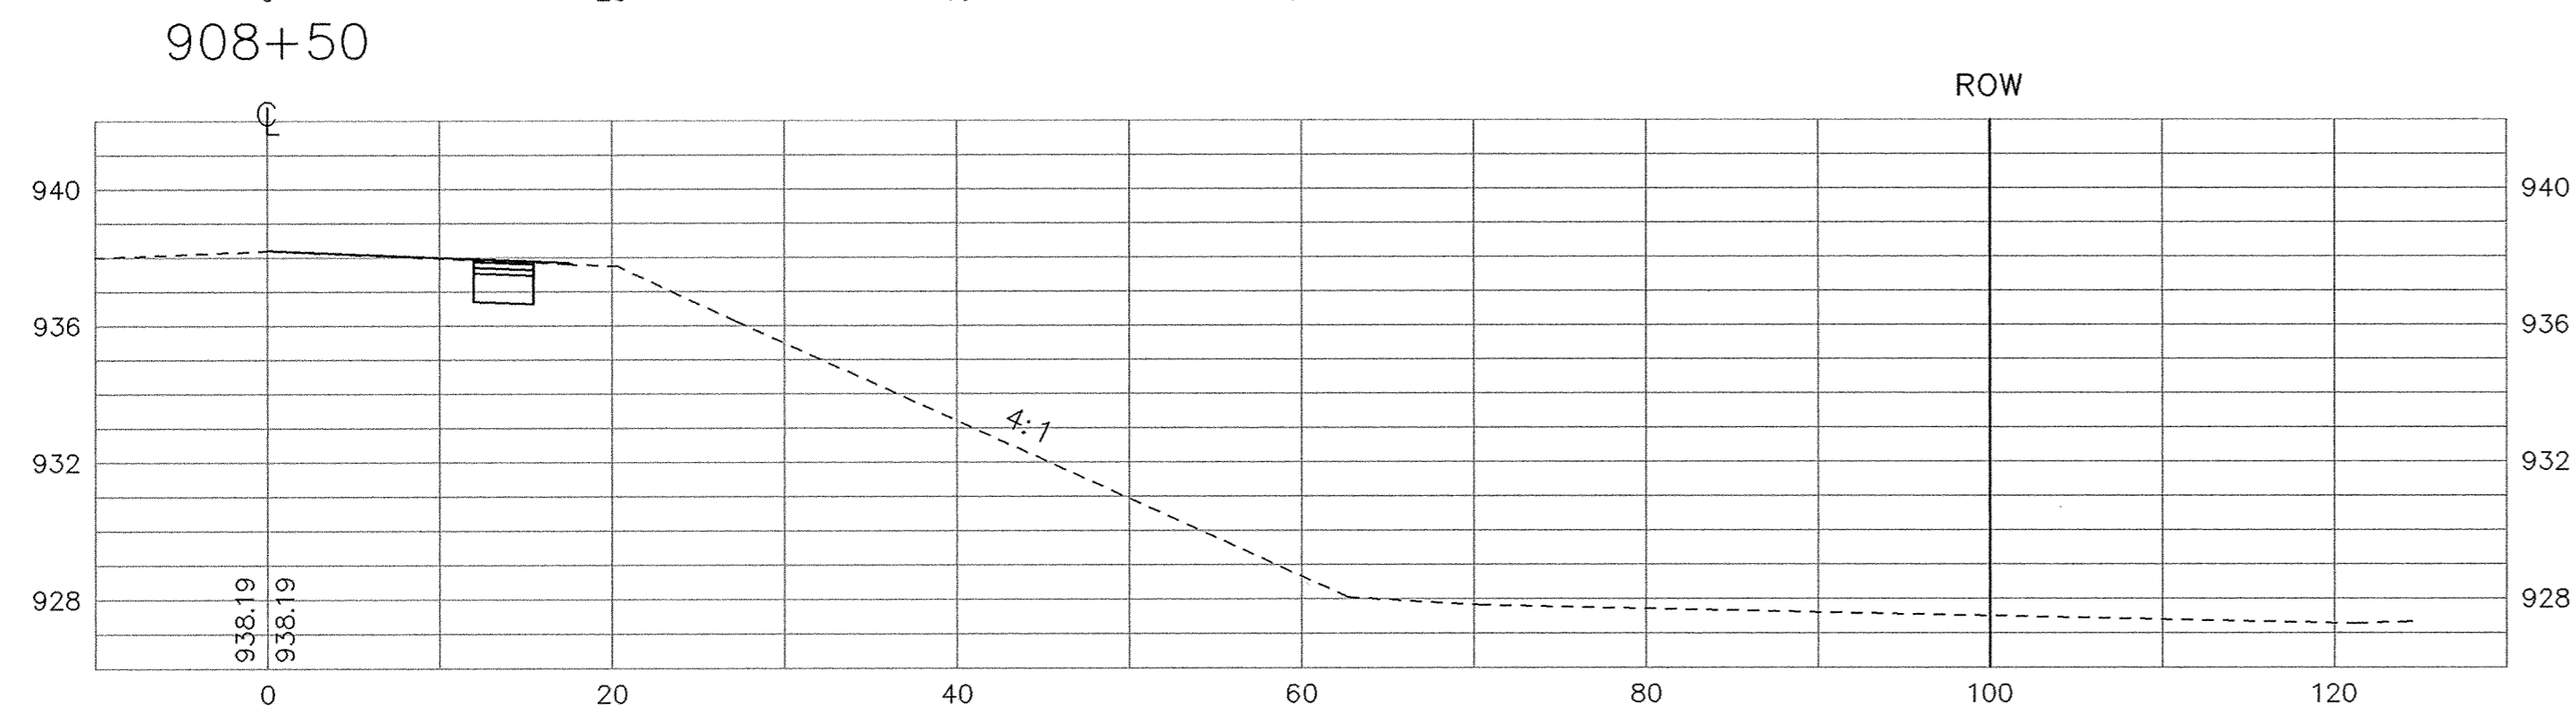
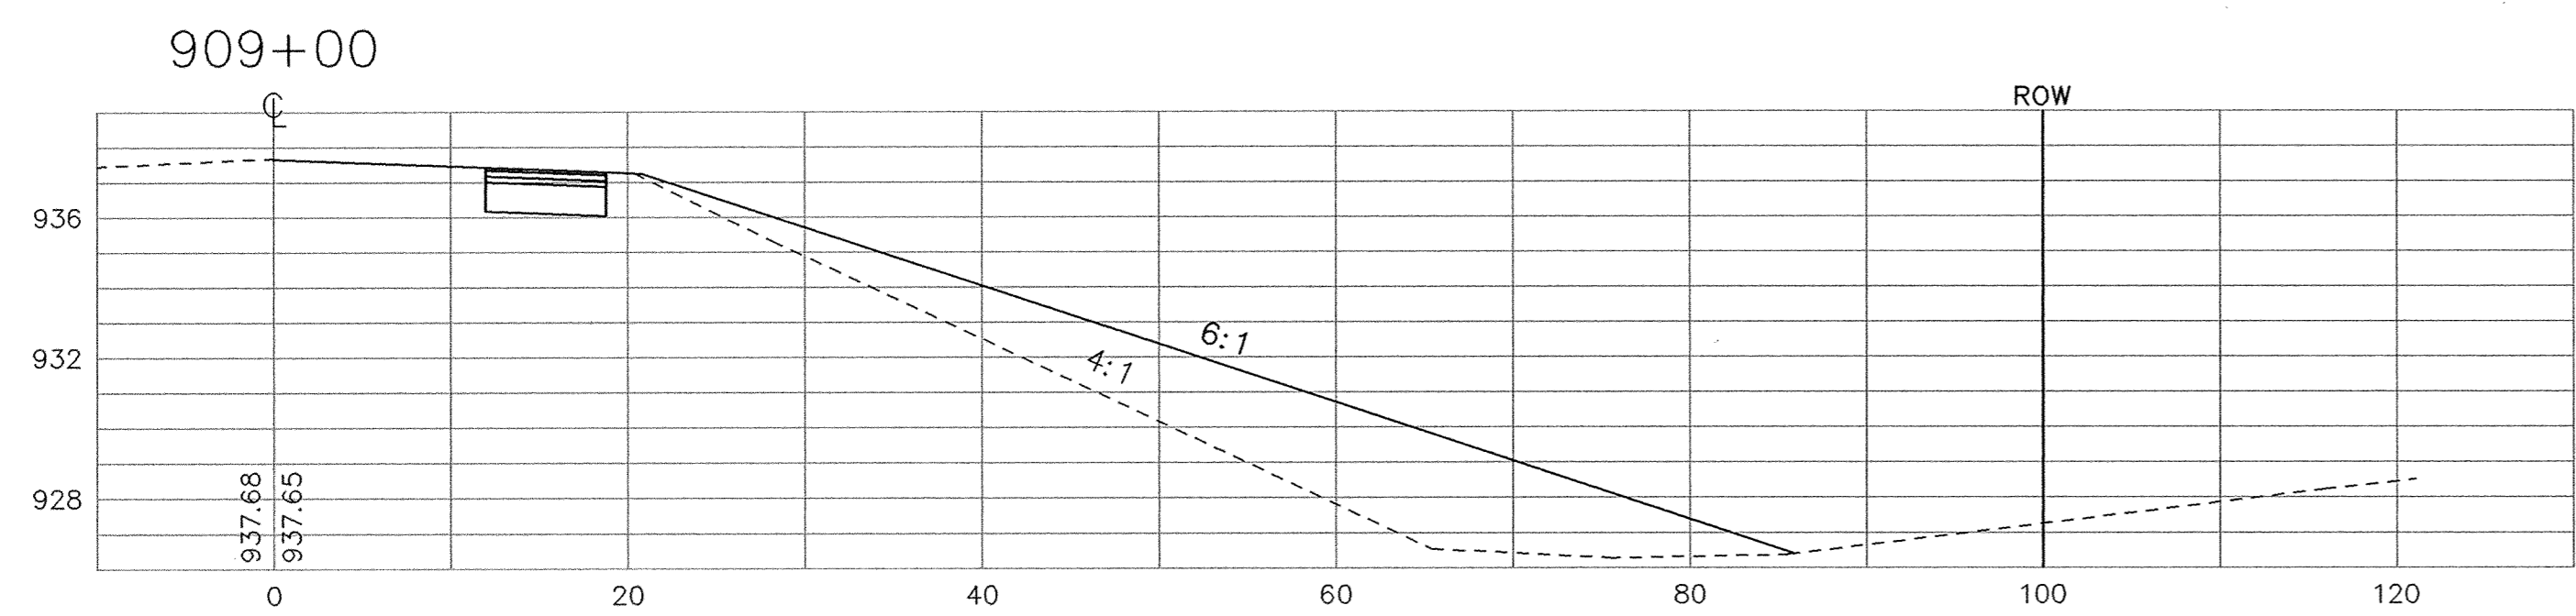
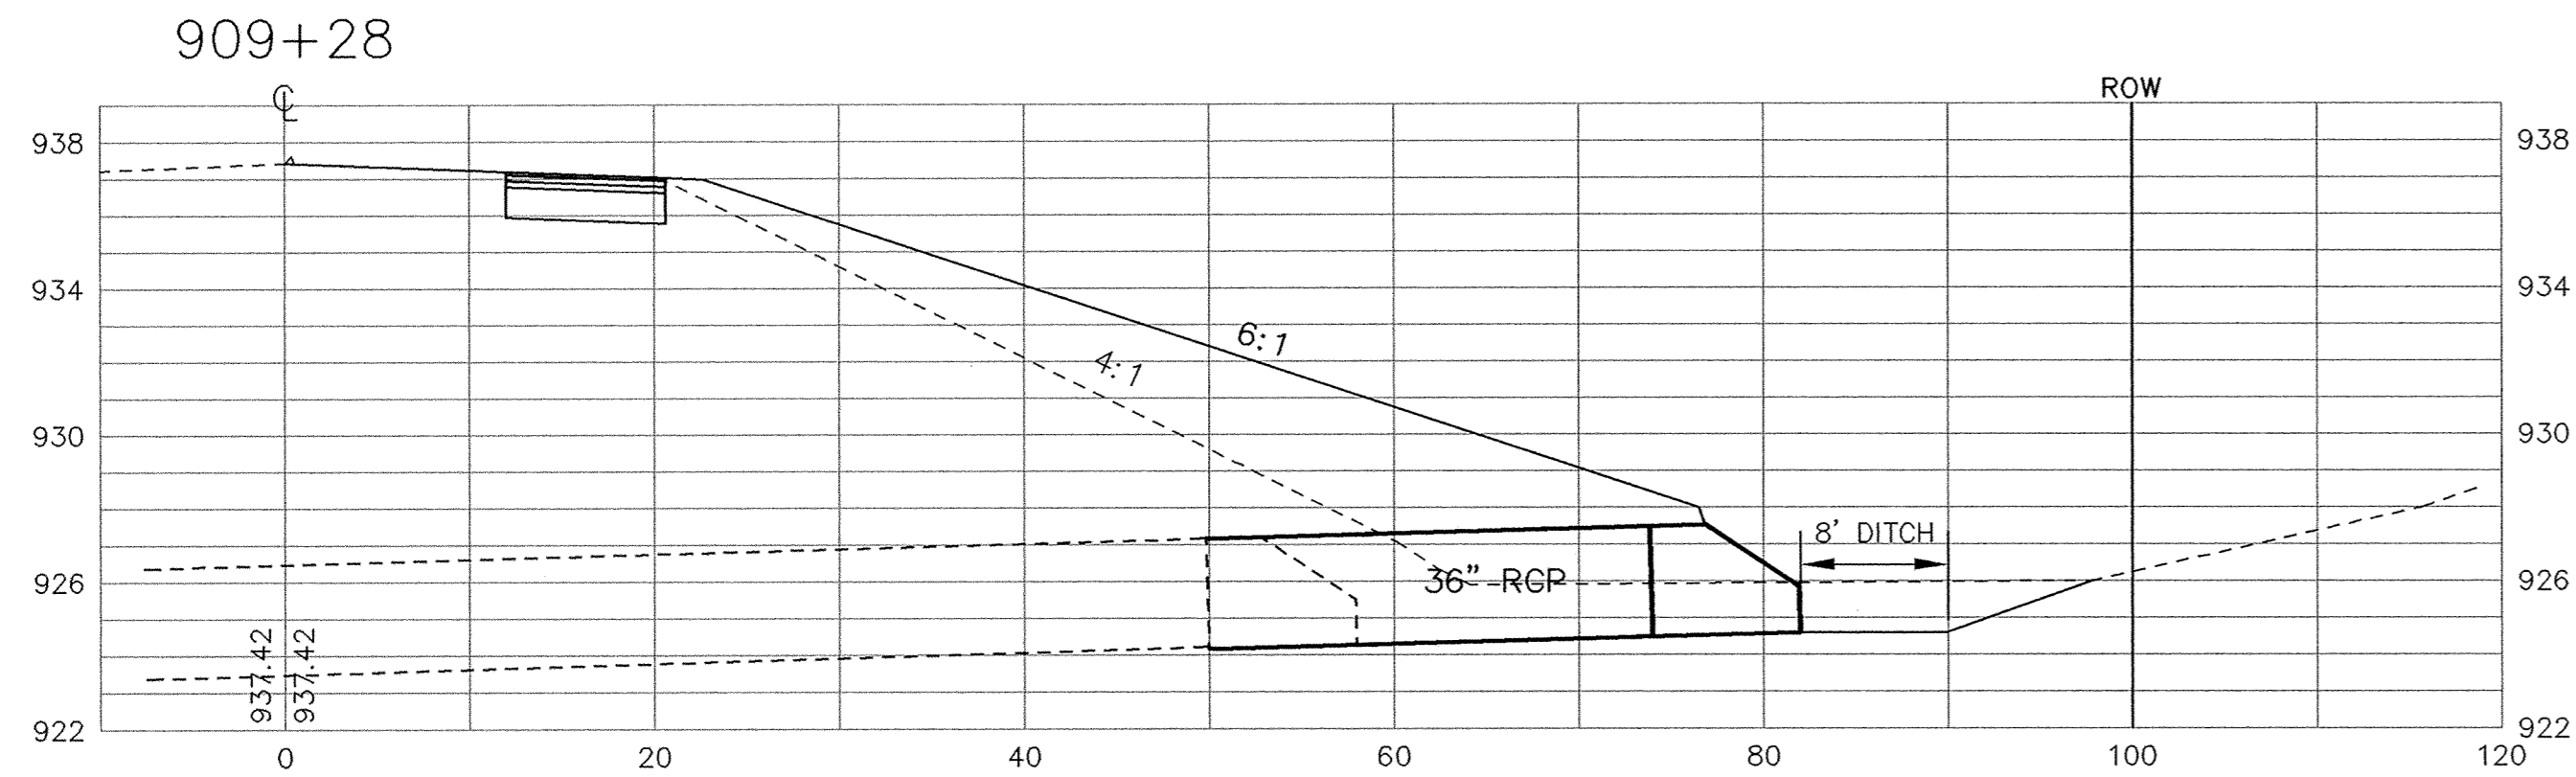


SAECO PRODUCTS - NEW HOPKIN, MINNESOTA
REORDER BY PART NUMBER 6532
SAECO PRODUCTS - NEW HOPKIN, MINNESOTA
REORDER BY PART NUMBER 6532
SAECO PRODUCTS - NEW HOPKIN, MINNESOTA
REORDER BY PART NUMBER 6532
SAECO PRODUCTS - NEW HOPKIN, MINNESOTA
REORDER BY PART NUMBER 6532

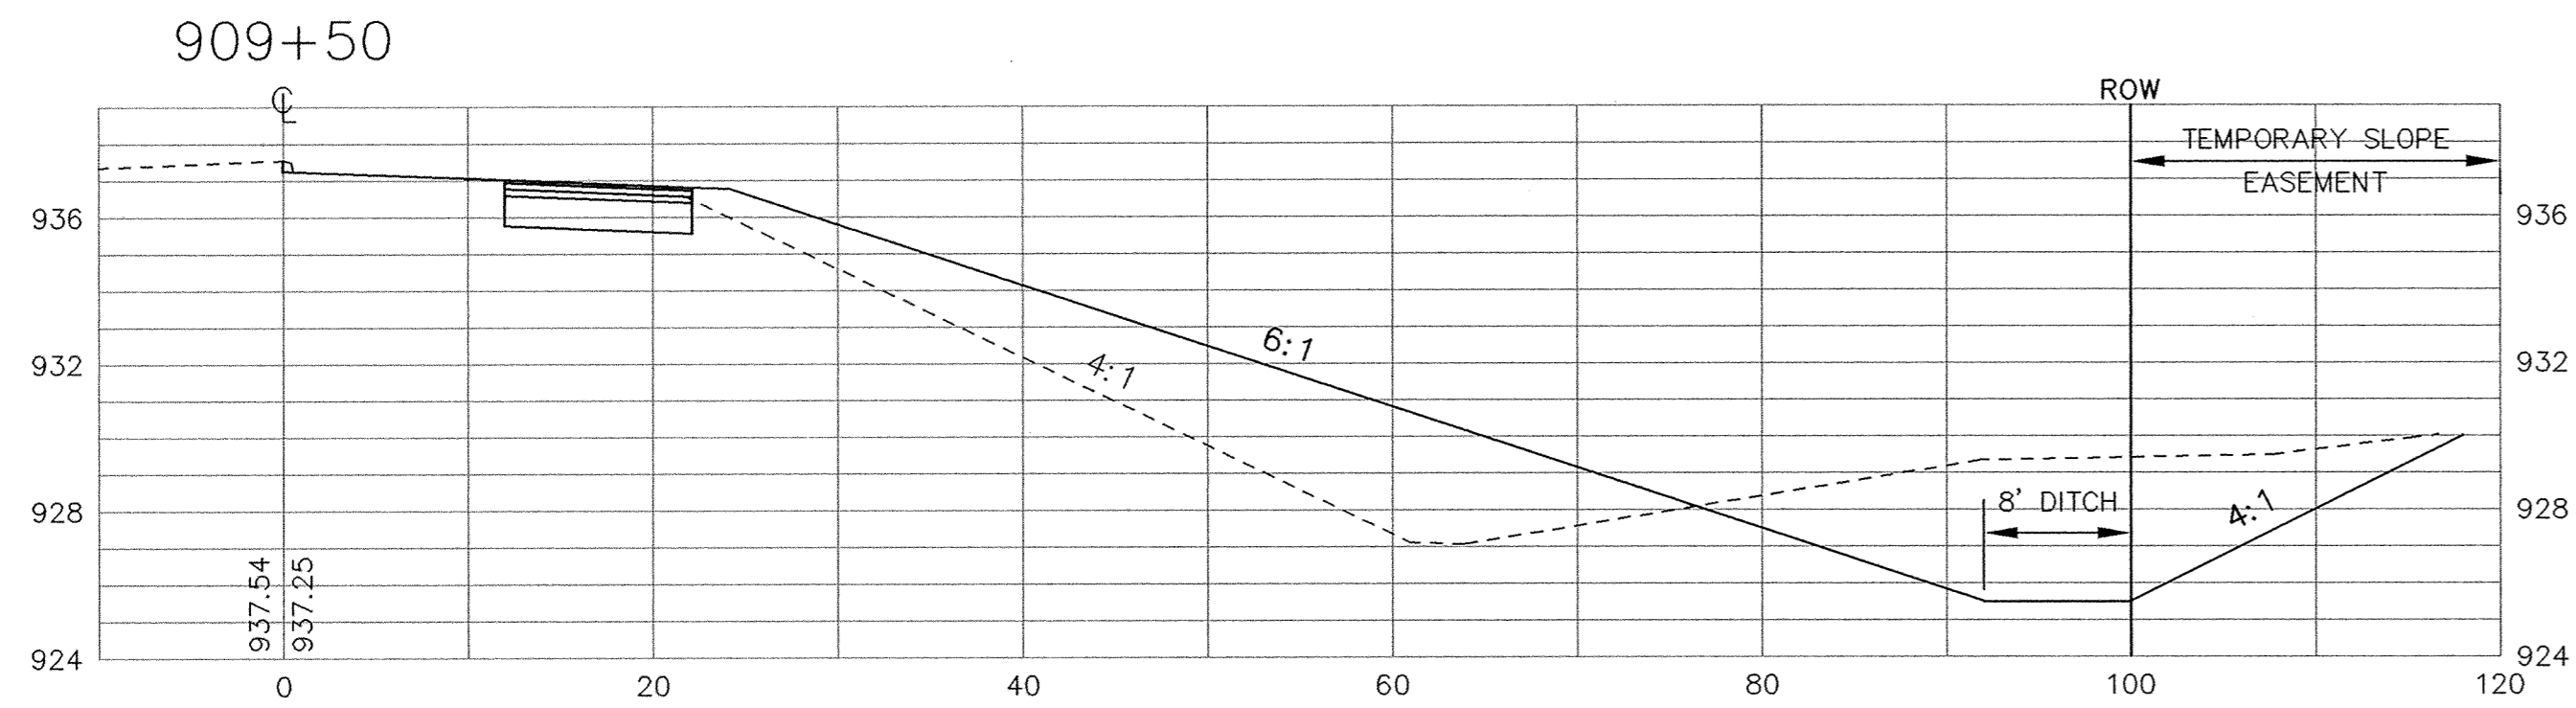


RECORD PLAN 1995

CITY OF ELK RIVER S.A.P. NO. 204-010-02
U.S. HWY NO. 169 AND 191ST AVENUE STA.
RIGHT IN/RIGHT OUT 908+00 TO 912+00

DATE	DESCRIPTION	DESIGNED	PEB
		CHECKED	JPB
		DRAWN	CLS
REVISIONS		GRAPHIC SCALE	
		HORIZ.	20
		VERT.	5

DATE APRIL 1994 SHEET 56 OF 74 SHEETS PROJECT NO. 230-217

I HEREBY CERTIFY THAT THIS PLAN, SPECIFICATION, OR REPORT WAS PREPARED BY ME OR UNDER MY DIRECT SUPERVISION AND THAT I AM A DULY REGISTERED PROFESSIONAL ENGINEER UNDER THE LAWS OF THE STATE OF MINNESOTA.
Paul Eretich
DATE 4-29-94 REG. NO. 12929

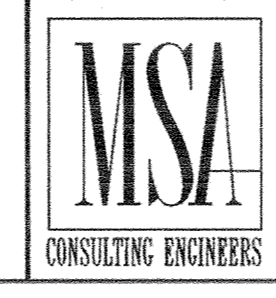

1326 ENERGY PARK DRIVE
ST. PAUL, MINNESOTA 55108
(612) 644-4389
9800 SHELARD PARKWAY
MINNEAPOLIS, MINNESOTA 55441
(612) 546-0432