

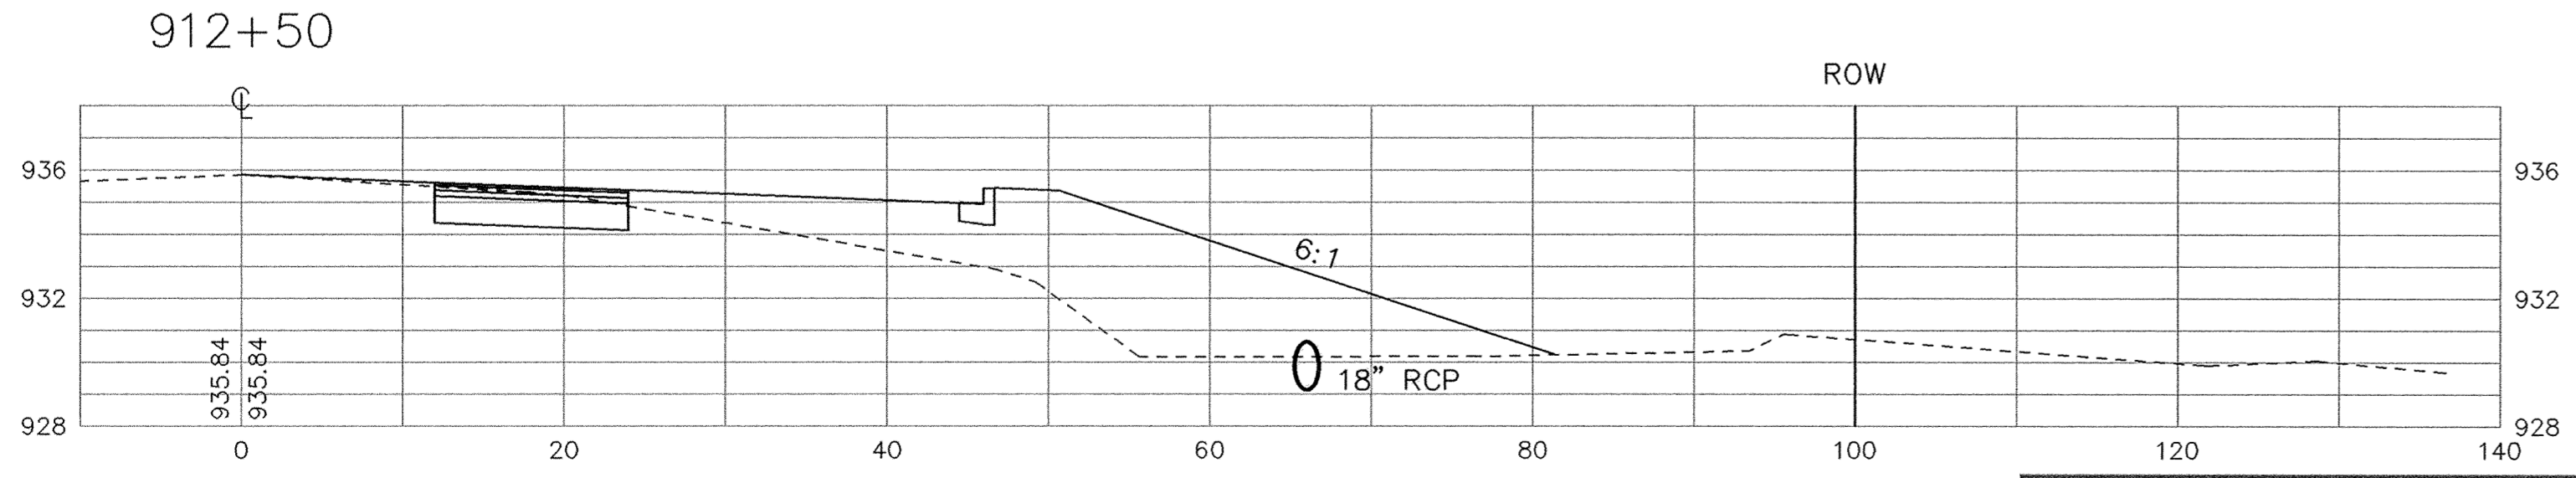
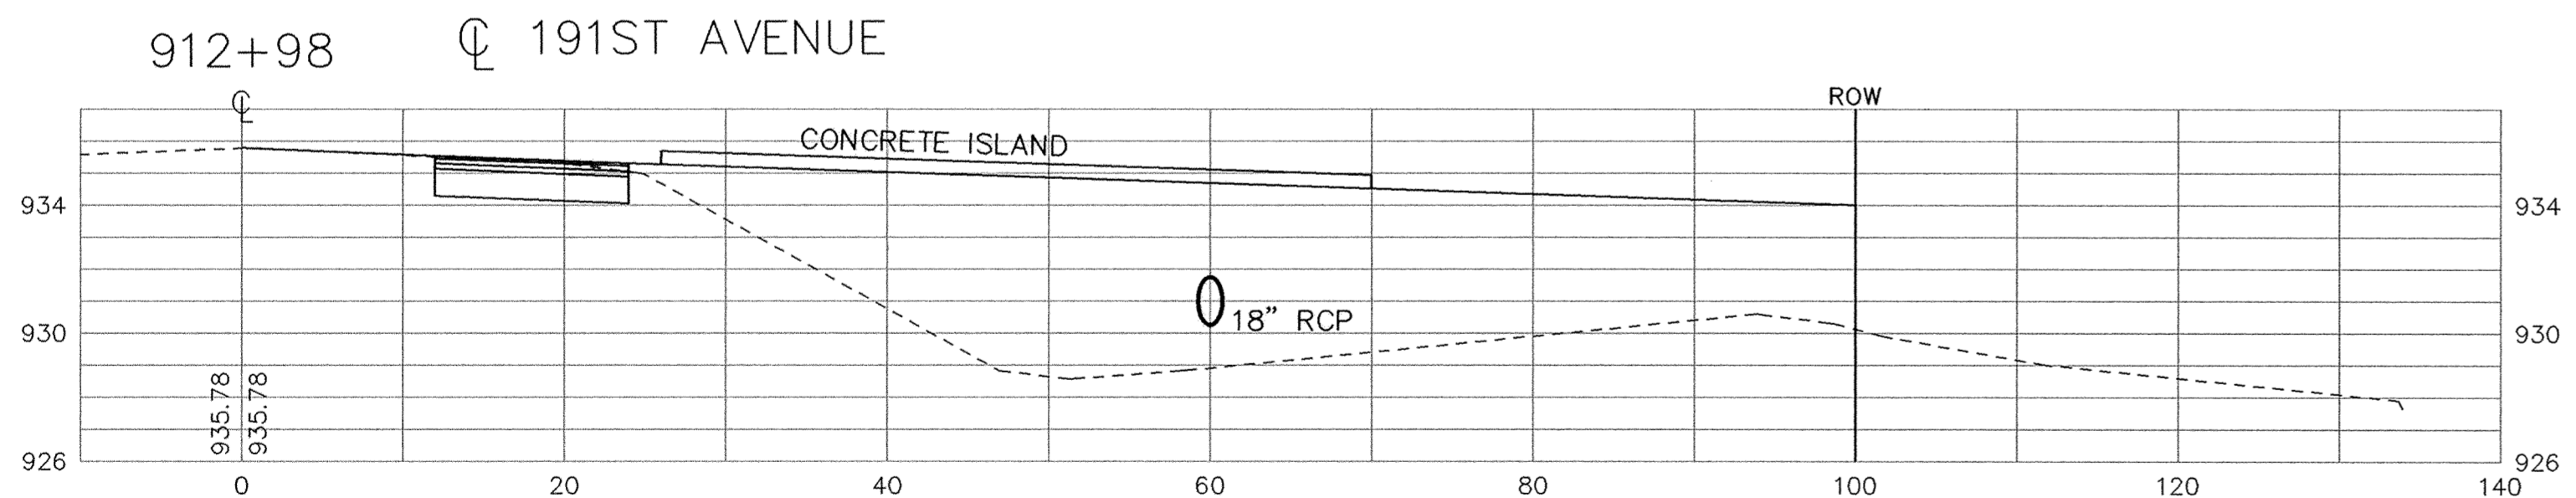
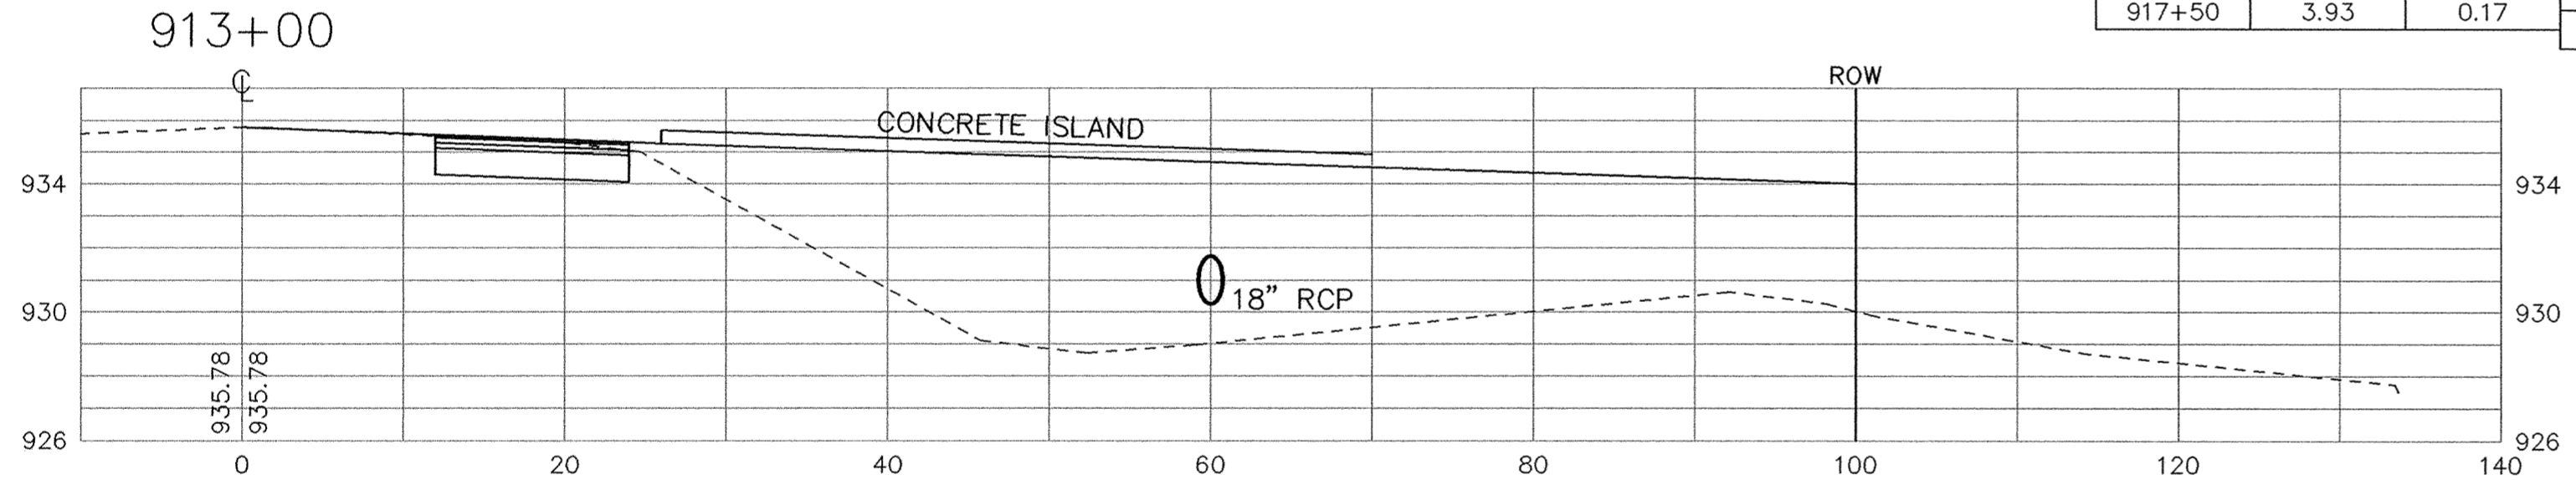
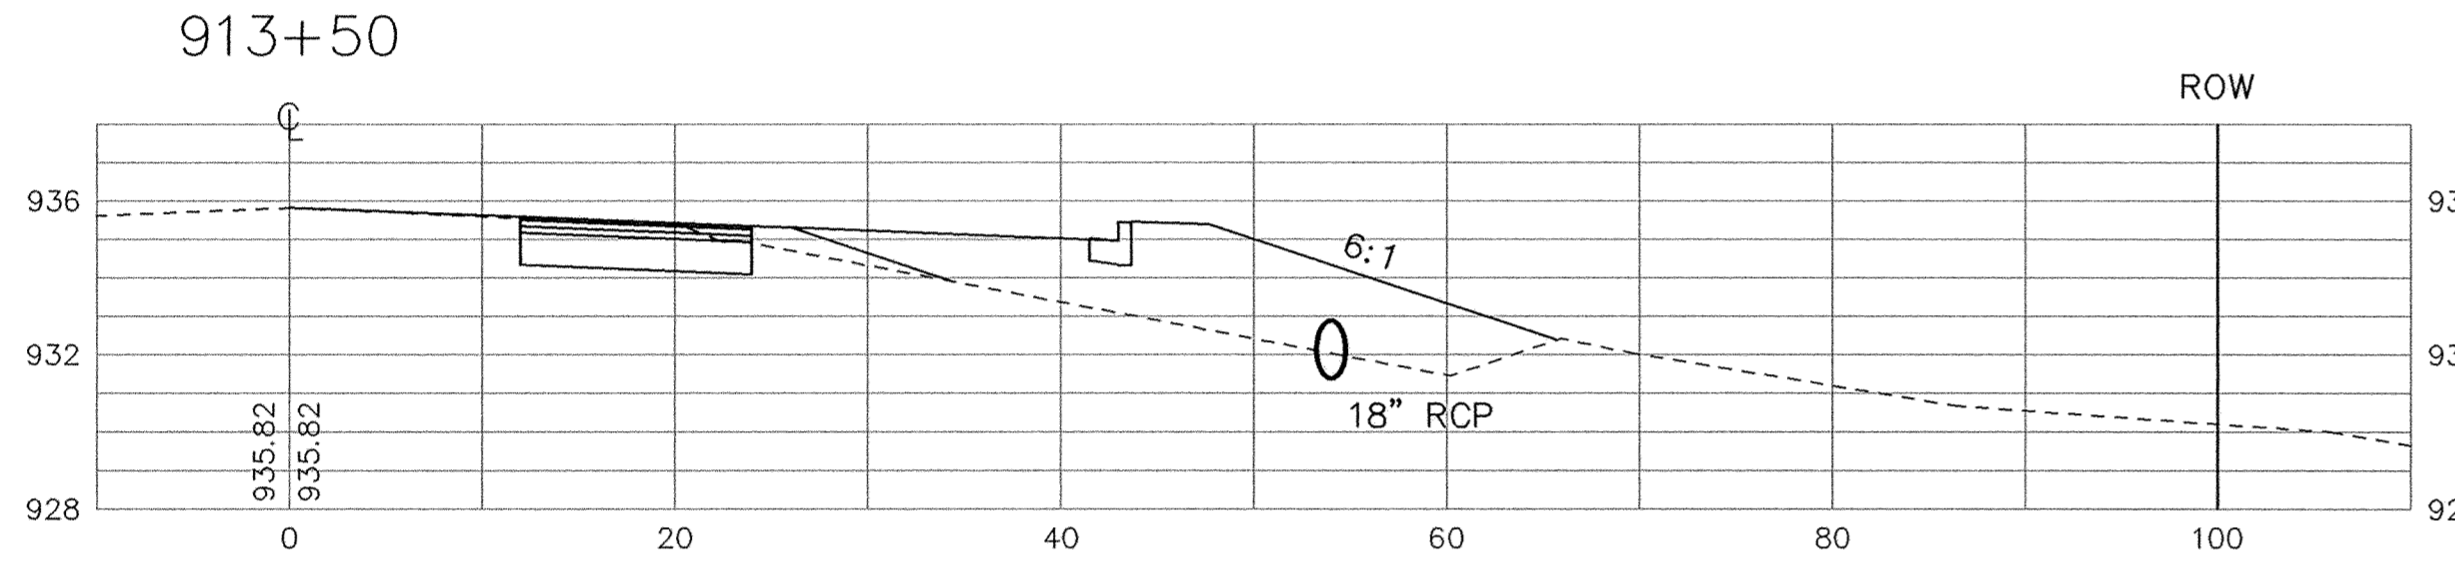
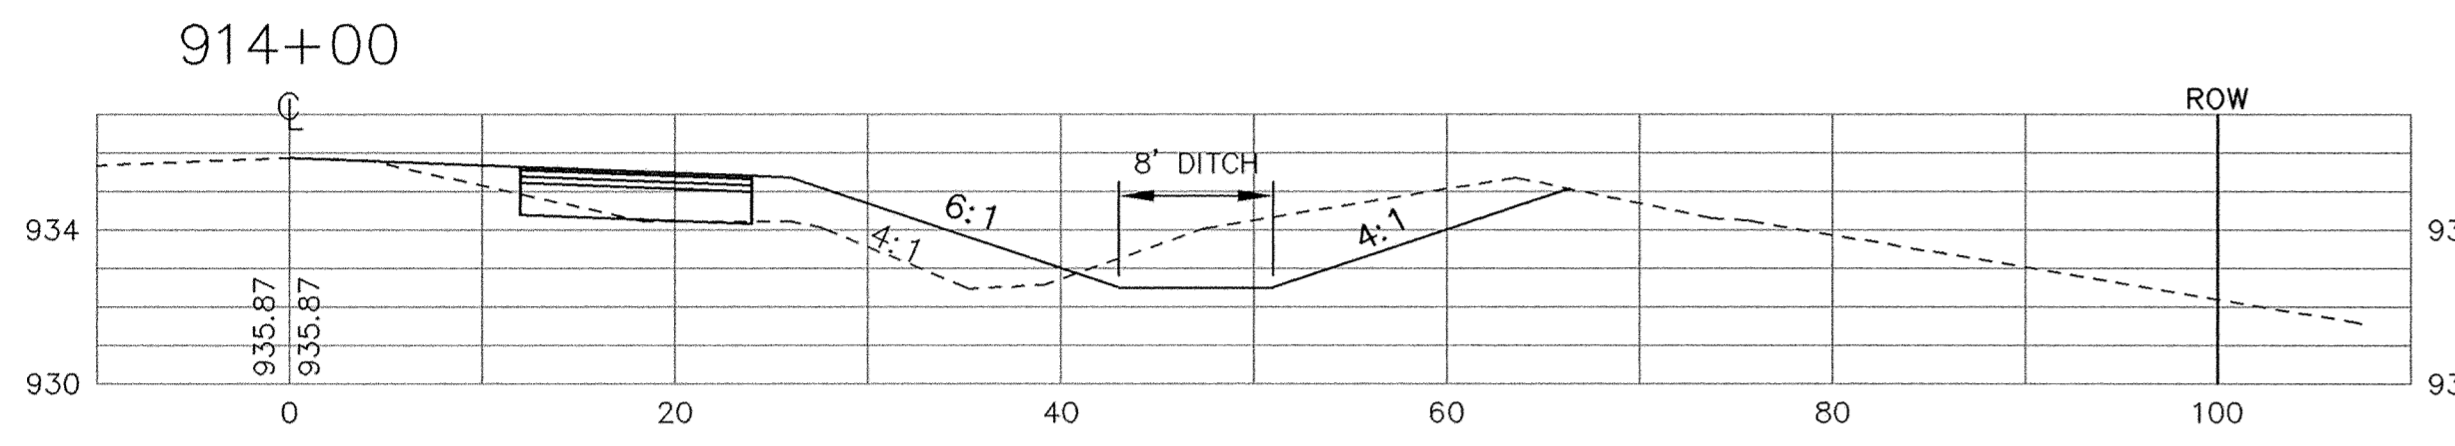
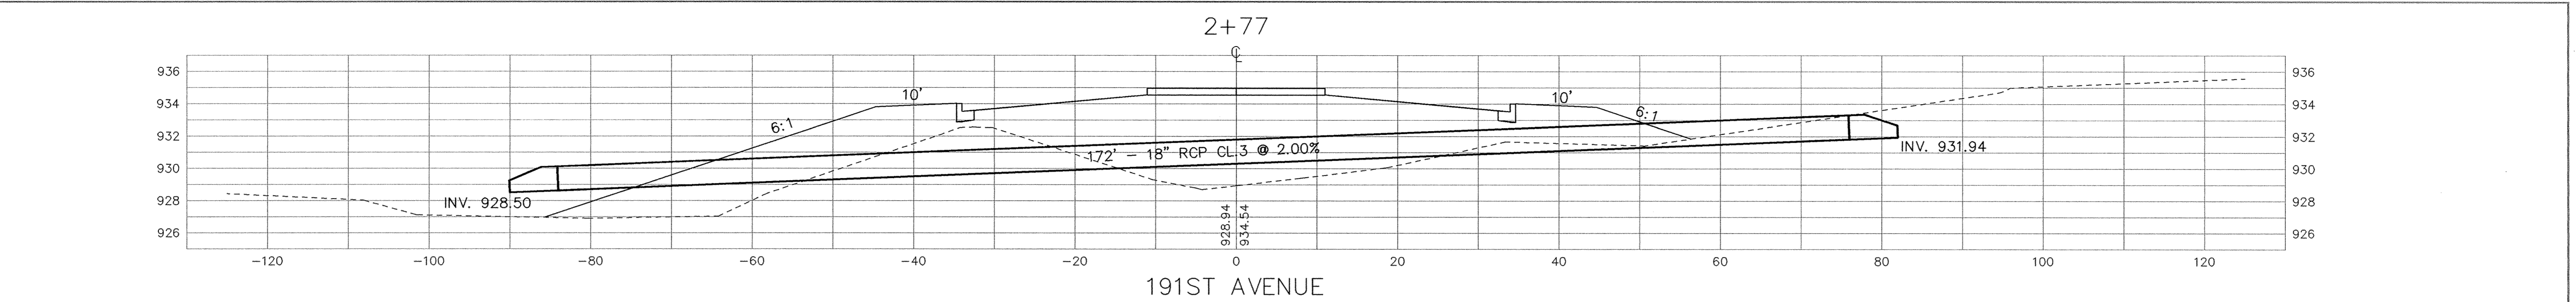
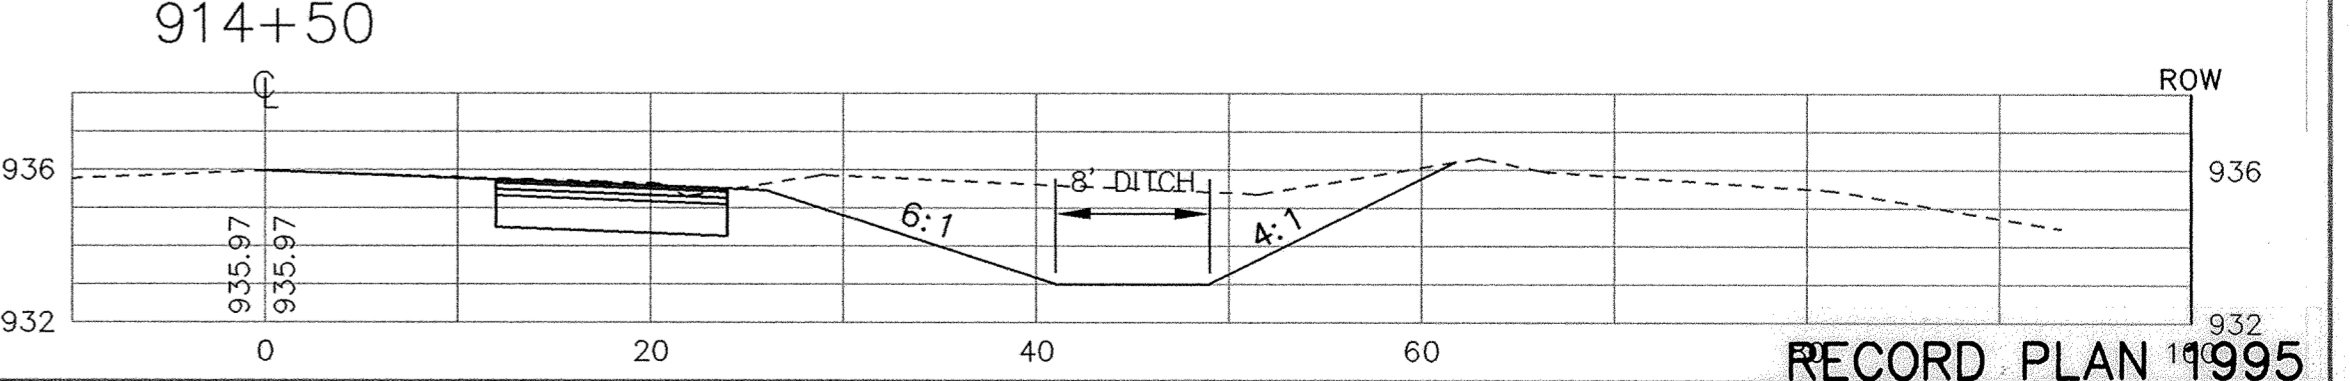
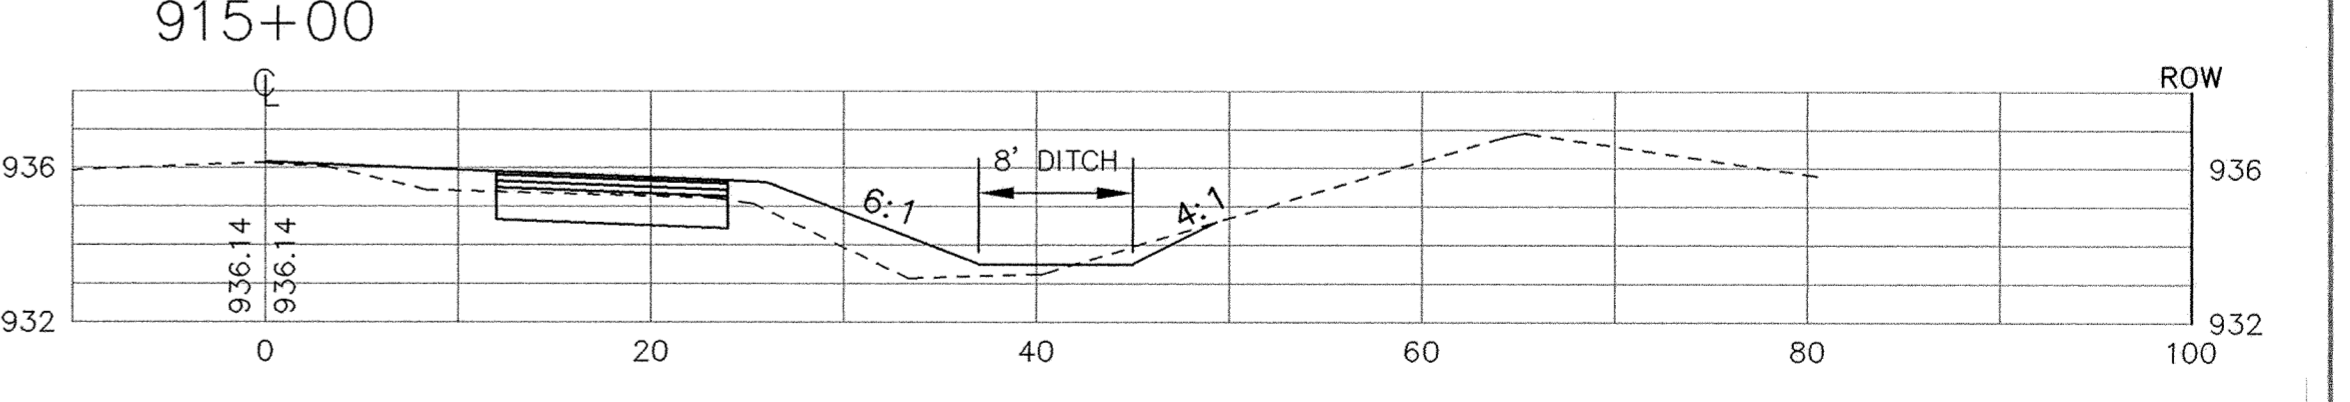
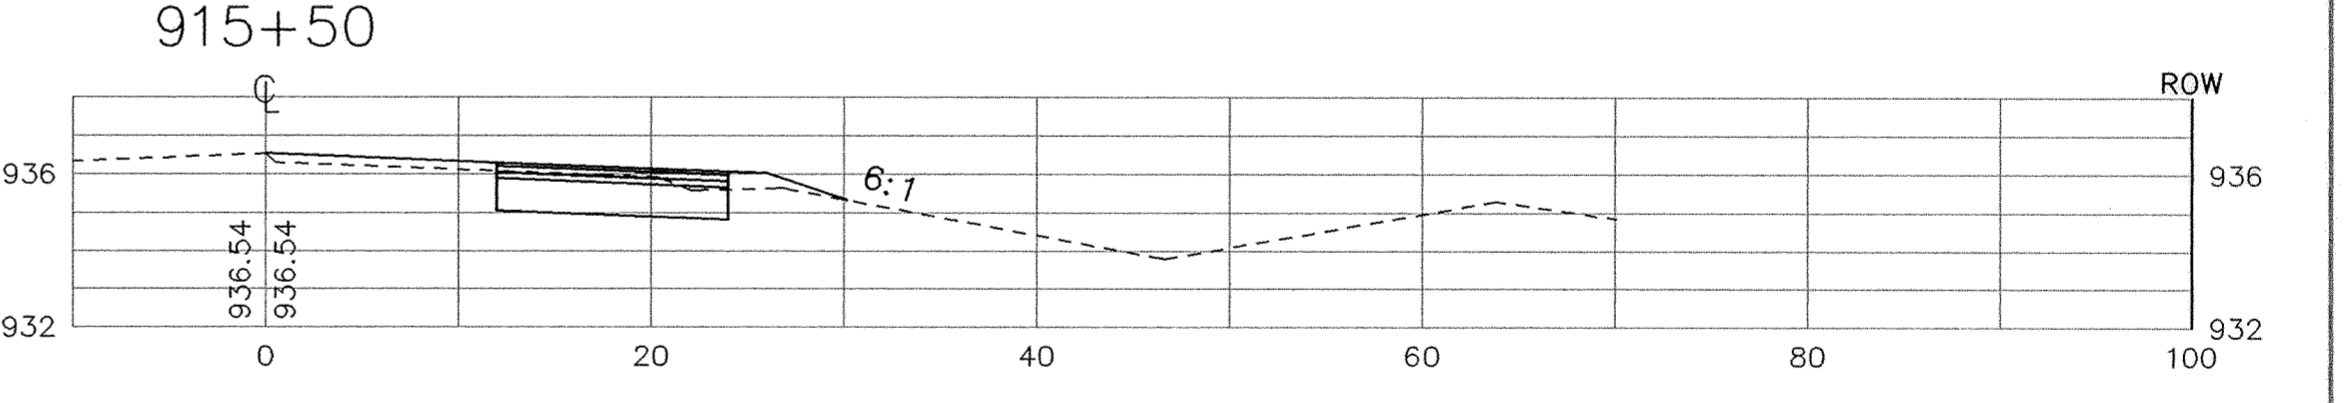
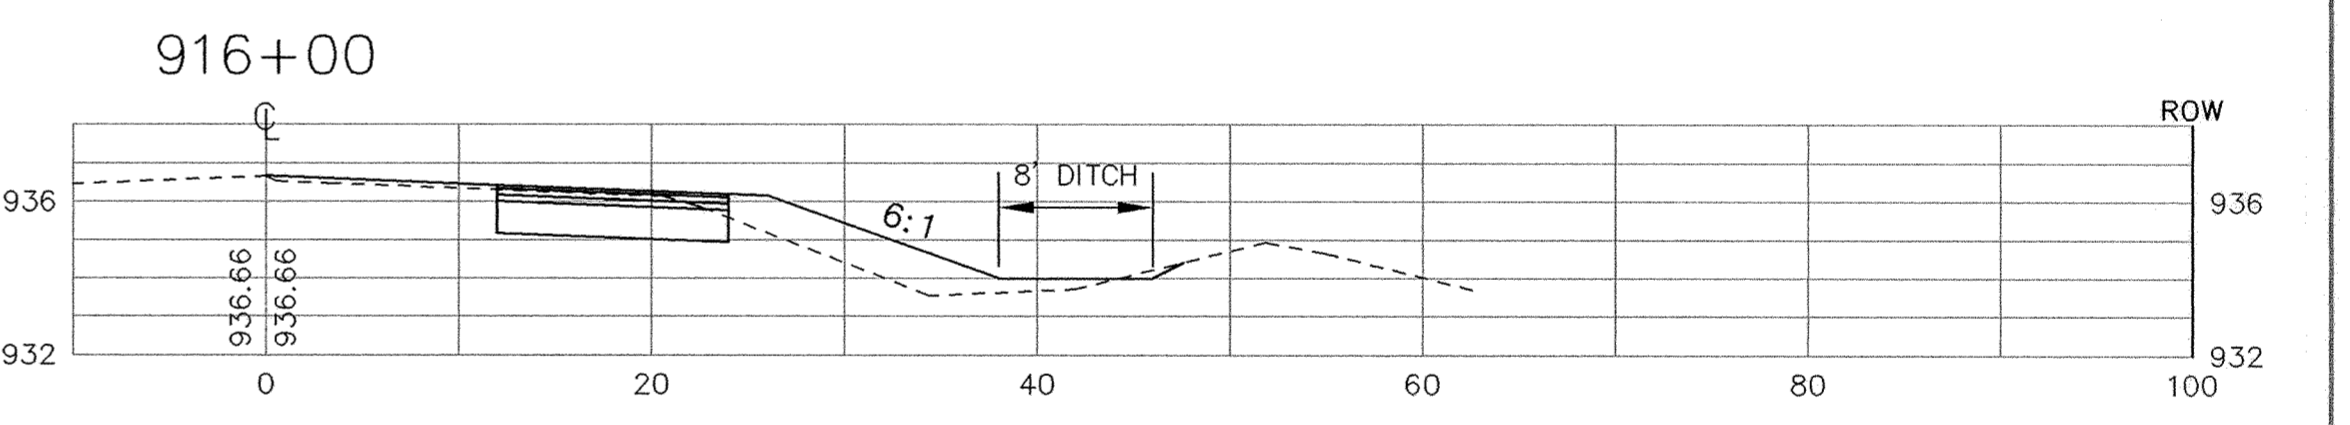
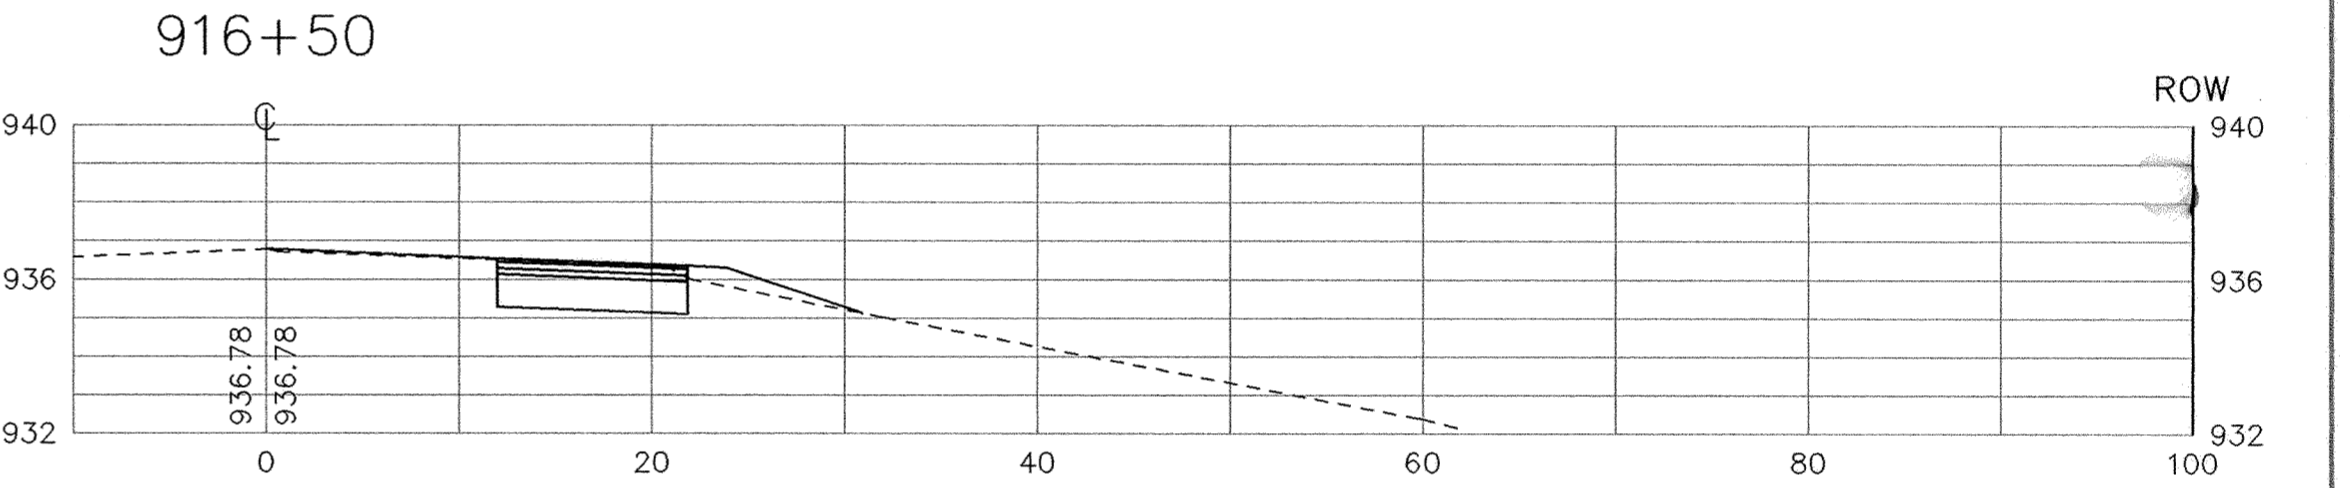


SAFCO PRODUCTS • NEW HOPE, MINNESOTA
REORDER BY PART NUMBER 8502
SAFCO PRODUCTS • NEW HOPE, MINNESOTA
REORDER BY PART NUMBER 8502
SAFCO PRODUCTS • NEW HOPE, MINNESOTA
REORDER BY PART NUMBER 8502
SAFCO PRODUCTS • NEW HOPE, MINNESOTA
REORDER BY PART NUMBER 8502

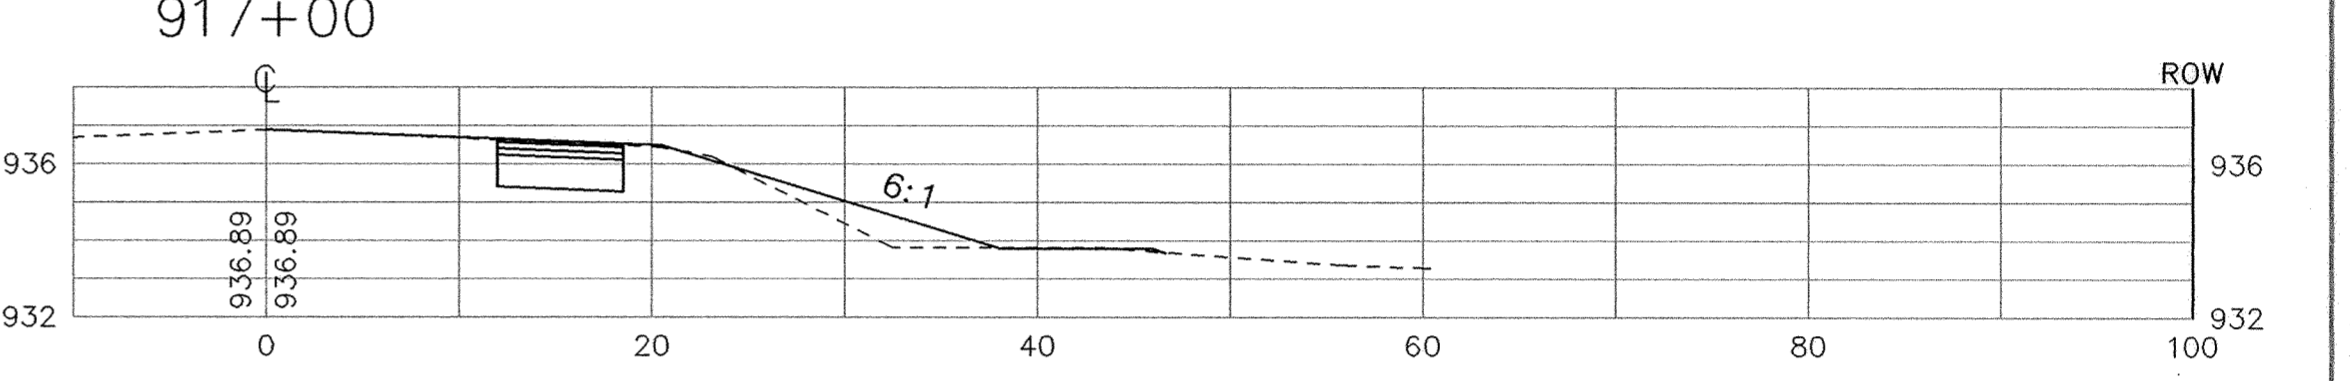

| STATION | AREAS Square Feet | | VOLUMES Cubic Yards | | CUMULATIVE VOLUMES Cubic Yards | |
|---------|----------------------|--------|------------------------|--------|-----------------------------------|---------|
| | CUT | FILL | CUT | FILL | CUT | FILL |
| 908+00 | 0.52 | 0.00 | 4.39 | 0.26 | 4.39 | 0.26 |
| 908+50 | 4.22 | 0.27 | 11.95 | 104.20 | 16.34 | 104.46 |
| 909+00 | 8.69 | 112.26 | 9.01 | 116.42 | 25.35 | 220.88 |
| 909+28 | 8.69 | 112.26 | 46.08 | 90.44 | 71.43 | 311.31 |
| 909+50 | 104.41 | 109.73 | 70.45 | 201.17 | 289.69 | 724.14 |
| 910+00 | 55.22 | 118.87 | 147.81 | 211.66 | 219.24 | 522.98 |
| 910+50 | 20.87 | 98.39 | 32.59 | 168.10 | 322.28 | 892.25 |
| 911+00 | 14.33 | 83.16 | 31.99 | 120.05 | 354.27 | 1012.29 |
| 911+50 | 20.22 | 46.49 | 32.13 | 126.92 | 386.40 | 1139.21 |
| 912+00 | 14.48 | 90.58 | 24.72 | 87.84 | 411.12 | 1227.05 |
| 912+50 | 12.22 | 4.28 | 23.39 | 357.30 | 434.51 | 1584.35 |
| 912+98 | 14.09 | 397.68 | 1.04 | 29.35 | 435.55 | 1613.70 |
| 913+00 | 14.07 | 394.84 | 25.46 | 369.05 | 461.02 | 1982.75 |
| 913+50 | 13.43 | 3.74 | 41.08 | 22.05 | 502.10 | 2004.80 |
| 914+00 | 30.94 | 20.07 | 104.41 | 18.59 | 606.51 | 2023.39 |
| 914+50 | 81.83 | 0.00 | 89.65 | 13.90 | 696.16 | 2037.29 |
| 915+00 | 14.99 | 15.01 | 24.69 | 17.69 | 720.85 | 2054.98 |
| 915+50 | 11.68 | 4.09 | 23.33 | 18.57 | 744.19 | 2073.54 |
| 916+00 | 13.52 | 15.96 | 23.57 | 17.55 | 767.76 | 2091.09 |
| 916+50 | 11.93 | 2.99 | 18.67 | 8.27 | 786.42 | 2099.36 |
| 917+00 | 8.22 | 5.94 | 11.25 | 5.66 | 797.68 | 2105.02 |
| 917+50 | 3.93 | 0.17 | 0.00 | 0.00 | 797.68 | 2105.02 |

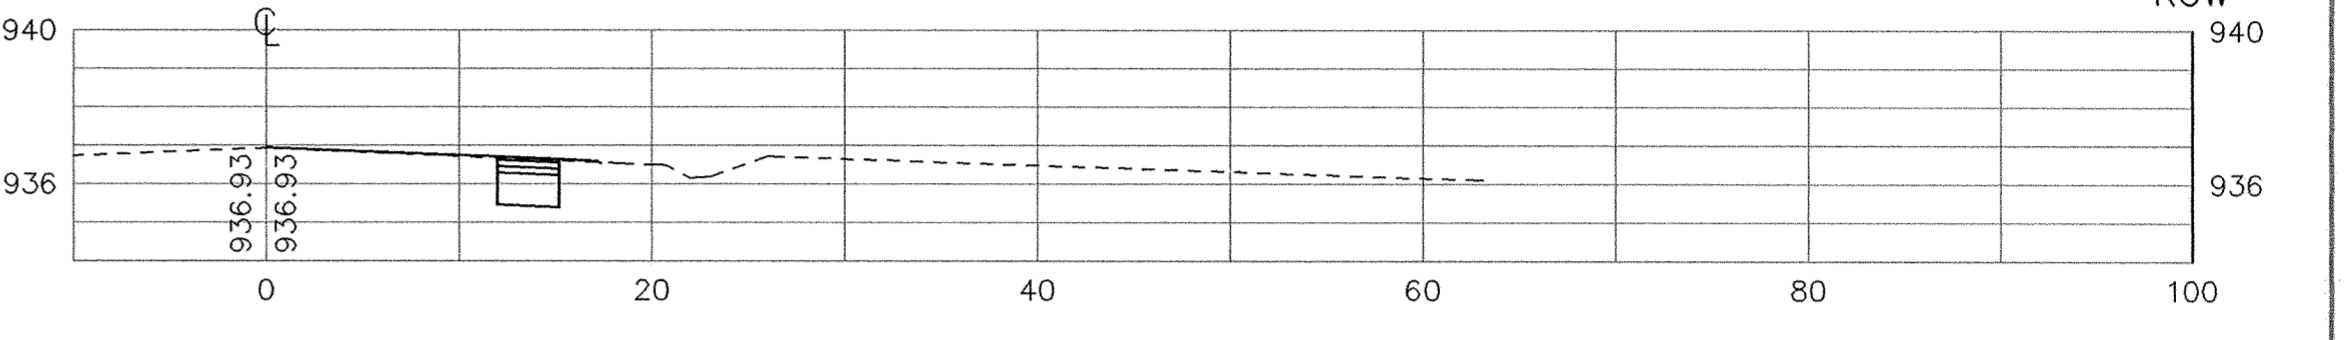

RECORD PLAN 1995

I HEREBY CERTIFY THAT THIS PLAN, SPECIFICATION, OR REPORT WAS PREPARED BY ME OR UNDER MY DIRECT SUPERVISION AND THAT I AM A DULY REGISTERED PROFESSIONAL ENGINEER UNDER THE LAWS OF THE STATE OF MINNESOTA.

Paul Proch
DATE 4-29-94 REG. NO. 13029



1326 ENERGY PARK DRIVE
ST. PAUL, MINNESOTA 55108
(612) 644-4389

9800 SHELARD PARKWAY
MINNEAPOLIS, MINNESOTA 55441
(612) 546-0432

| REVISIONS | DATE | DESCRIPTION | DESIGNED | CHECKED | DRAWN |
|-----------|------|-------------|----------|---------|-------|
| | | | | | |

CITY OF ELK RIVER S.A.P. NO. 204-010-02
U.S. HWY NO. 169 AND 191ST AVENUE STA. 912+50 TO 917+50
RIGHT IN/RIGHT OUT

DATE APRIL 1994 SHEET 57 OF 74 SHEETS PROJECT NO. 230-217